

REVISION HISTORY			
REV	DESCRIPTION	DATE	APPROVED
1	Drawing Created	8/29/17	cpv

- REVIEWED
- REVIEWED AND MODIFIED
- REVISE AND RESUBMIT
- NOT REVIEWED

The review by JRP Engineering is for the sole purpose of ascertaining conformance with the general design concept. This review shall not mean the detail design inherent in the shop drawings are approved, responsibility of which shall remain with the Contractor submitting same and review shall not relieve the Contractor of this responsibility for errors or omissions in the shop drawings or his responsibility for meeting all requirements of the Contract Documents. The Contractor is responsible for dimensions to be confirmed and correlated at the job site, for information that pertains solely to fabrication processes or to techniques of construction and installation and for co-ordination of the work of all sub-trades.

JRP Engineering

M.G

DATE: Aug 30, 2017

- NOT REVIEWED
- REVIEWED
- REVIEWED AS NOTED
- REVISE AND RE-SUBMIT


 


This review is for the sole purpose of ascertaining conformance with the general design concept of the contract documents. The Contractor shall retain all responsibility for the detailed design, fabrication or construction techniques, conformance with dimensions and job site conditions, and any errors or omissions in the shop drawings.

Date: Sep 1, 2017 By: JK

Christopher Simmonds Architect
 The Annex, 45 Eccles Street
 Ottawa, ON K1R6S3
 Ph: 613-567-7888 Fax: 613-567-7528

FROVIDE FIXTURE WITH WHITE FINISH

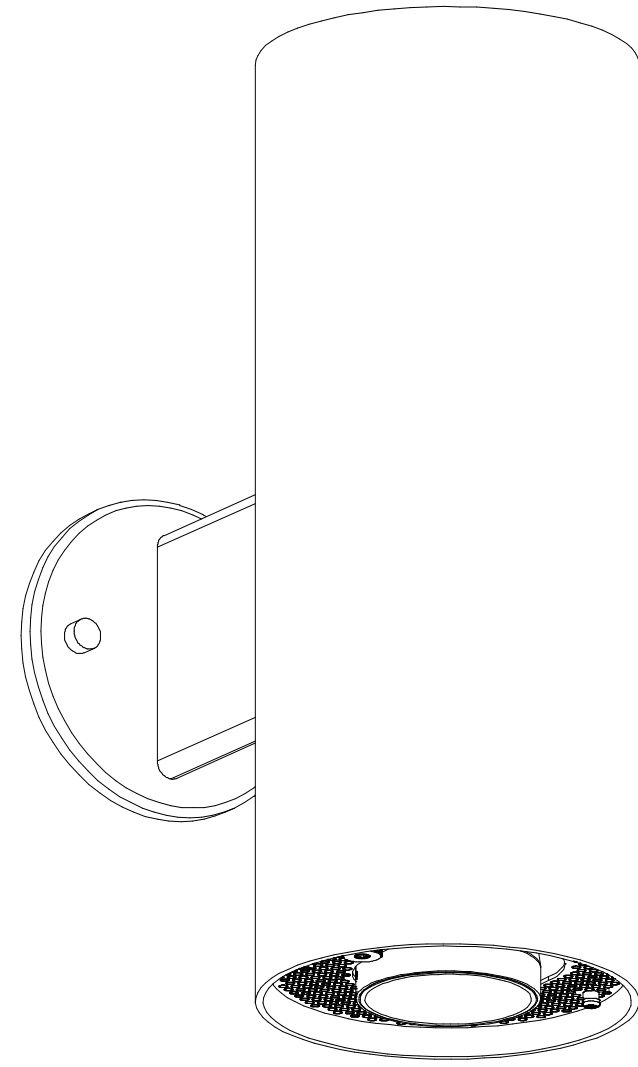

APPROVAL


Signature: _____

Title: _____

Date: _____



UNLESS OTHERWISE SPECIFIED
 DIM ARE MM [INCHES]
 <=5.0 +/- 0.1
 >5.0 & <= 20.0 +/- 0.2
 >20.0 +/- 0.5
 ANGLES +/- 0.5°
 DO NOT SCALE
 INTERPRET DIM AND TOL PER
 ASME Y14.5M-1994

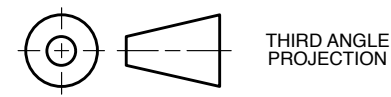

DESIGNED BY cpv	v2 Lighting Group, Inc. 276 East Gish Road San Jose, CA 95112 T 707 383 4600 F 707 383 4686 www.v2LightingGroup.com
DRAWN BY cpv	
CHECKED BY	TITLE TOMLINSON HEAD OFFICE L4LS WITH 4.75" ARM
APPROVED BY	CAD FILE NAME Tomlinson L4LS.vwx
OTHER APPROVALS	SCALE 1:4 SIZE T SHEET 1 OF 1

THIS DOCUMENT CONTAINS CONFIDENTIAL AND PROPRIETARY INFORMATION OF V2 LIGHTING GROUP, INC. AND IS GIVEN TO THE RECEIVER IN CONFIDENCE. THE RECEIVER ACCEPTS AND AGREES THAT, EXCEPT AS AUTHORIZED BY V2 LIGHTING GROUP, INC. THE RECEIVER WILL NOT PERMIT THE USE OF THE DOCUMENT OR ANY COPY THEREOF OR THE INFORMATION THEREIN. WILL NOT COPY OR PERMIT THE COPYING OF THE DOCUMENT, WILL NOT DISCLOSE TO OTHERS EITHER THE DOCUMENT OR THE INFORMATION THEREIN, AND WILL UPON COMPLETION OF THE NEED TO RETAIN THE DOCUMENT, OR UPON DEMAND, RETURN THE DOCUMENT WITHOUT RETAINING ANY OF THE INFORMATION CONTAINED THEREIN IN ANY FORM WHATSOEVER.