

# Continental-Price Electrical Contractors Inc.

PO Box 462, Stittsville, ON K2S 1A6

Phone (613) 836-8242

Fax (613) 836-8241

## TRANSMITTAL

Date:

TO:

ATTN:

Project:

- REVIEWED  
 REVIEWED AND MODIFIED  
 REVISE AND RESUBMIT  
 NOT REVIEWED

Received from

Attached we are sending you copies of the following items:

Drawings

Prints

Plans

The review by JRP Engineering is for the sole purpose of ascertaining conformance with the general design concept. This review shall not mean the detail design inherent in the shop drawings are approved, responsibility of which shall remain with the Contractor submitting same and review shall not relieve the Contractor of this responsibility for errors or omissions in the shop drawings or his responsibility for meeting all requirements of the Contract Documents. The Contractor is responsible for dimensions to be confirmed and correlated at the job site, for information that pertains solely to fabrication processes or to techniques of construction and installation and for co-ordination of the work of all sub-trades.

Specifications

Other

Information

Submittals

These are Transmitted for:

Prior Approval

Approval

Approval as Submitted

Approved as Noted

Resubmit for Approval

For your Record

JRP Engineering

Corrections

C.McGuire

Your Serv.

DATE: MAY 17th, 2017

Review and Comment

# of Copies

Title, Desc

### \* MODIFICATIONS:

1. Provide more information on the GLA-PWS50 for contractors.
2. Contractor to coordinate installation on site with reference to slab conduits that are currently installed.
3. If changes are required to the network layout shown in this shop drawing, the changes are to be marked up or drawings updated for the final As-Built submission for this project.
4. Electrical to coordinate with system supplier to ensure a complete and operational system is achieved.
5. Coordinate changes to drawings with contractors comments provided to you on May 9th, 2017.



**TOMLINSON**  
CITIGATE, OTTAWA

ORDER/PROJECT #: 1841941

# SUBMITTALS FOR APPROVAL

### NOTE:

SUBMITTALS GENERATED FROM THE FOLLOWING PROJECT DOCUMENTATION:  
CRESTRON QUOTATION #: 1048528 QUOTE REVISION: 3 QUOTE DATE: 4/24/17

PROJECT SPECIFICATIONS: 26 09 43.13  
PROJECT DRAWINGS: E-101, E-102, E-103, E-104

**ENGINEER:** JRP ENGINEERING      **REVISION:** PRICING      **DATE:** 8/29/16  
IF THIS DOCUMENTATION IS NOT CURRENT IT IS THE RESPONSIBILITY OF THE APPROVER TO  
PROVIDE THE LATEST REVISION OF THE PROJECT DRAWINGS TO CRESTRON LIGHTING PROJECTS.

THIS COVER PAGE MUST BE  
SIGNED & RETURNED TO  
CLCOrders@CRESTRON.COM  
TO APPROVE THIS PROJECT FOR  
MANUFACTURING.

IN ADDITION TO THIS APPROVAL,  
THE ELECTRICAL DISTRIBUTOR'S  
RELEASE INTENT (EMAIL OR  
RELEASE PO) IS REQUIRED.  
APPROVED & RELEASED  
PROJECTS SHIP WITHIN 15  
BUSINESS DAYS.

<input type="checkbox"/> Accepted <input type="checkbox"/> Accepted with Notations <input type="checkbox"/> Revise & Resubmit <input type="checkbox"/> Rejected	
_____ SIGNATURE	_____ DATE
_____ TYPED / PRINTED NAME	
_____ COMPANY	



PLEASE ENSURE THAT YOU  
HAVE THE LATEST VERSION OF  
DRAWINGS FOR THIS PROJECT  
  
SCAN THE QR CODE ABOVE TO  
DOWNLOAD THE CURRENT  
CRESTRON DRAWING SET

### CONTACT INFORMATION:

THE CRESTRON PROJECT MANAGER WILL BE YOUR CONTACT THROUGHOUT THIS PROJECT FOR ALL INFORMATION REGARDING YOUR ORDER, SHIPMENT, PROGRAMMING, OR SCHEDULING.

THE CRESTRON FIELD ENGINEER IS RESPONSIBLE FOR ADVISING THE CONTRACTOR REGARDING THE INSTALLATION OF THE SYSTEM, AND SHOULD BE THE PRIMARY CONTACT AFTER THE ORDER HAS BEEN RELEASED FOR PRODUCTION, AND WHEN YOU HAVE QUESTIONS REGARDING WIRING OR EQUIPMENT INSTALLATION.

FOR QUESTIONS SPECIFICALLY RELATING TO THESE SUBMITTALS, PLEASE CONTACT CLCSUBS@CRESTRON.COM

IF YOU ARE UNSURE OF WHOM TO CONTACT, PLEASE SPEAK WITH YOUR PROJECT MANAGER.

PROJECT MANAGER: PEGGIE DEVANEY  
EMAIL: PDEVANEY@CRESTRON.COM  
PHONE: 800.237.2041 X10847

FIELD ENGINEER: TBD  
EMAIL: TBD  
PHONE: TBD

ALL CRESTRON PROJECT MANAGERS AND PROJECT ENGINEERS ARE BASED IN ROCKLEIGH, NJ, USA.  
CRESTRON FIELD ENGINEERS ARE BASED ACROSS THE COUNTRY  
OUR NORMAL BUSINESS HOURS ARE M-F 9AM-5:30PM LOCAL TIME

DRAWING#	REV	TITLE
01.0	00	COVER PAGE AND DRAWING INDEX
02.0	00	GENERAL SYSTEM NOTES
02.1	00	SYSTEM ELECTRONIC COMMISSIONING REQUEST FORM
02.2	00	CRESNET WIRING INSTRUCTIONS
02.3	00	CRESNET POWER CALCULATIONS
03.0	03	BILL OF MATERIALS
03.1	03	GROUND FLOOR RISER DIAGRAM
03.2	03	FIRST FLOOR RISER DIAGRAM
04.2	03	SECOND FLOOR RISER DIAGRAM
04.3	03	THIRD FLOOR RISER DIAGRAM
04.4	03	FOURTH FLOOR RISER DIAGRAM
04.5	03	FIFTH FLOOR RISER DIAGRAM
05.0	03	CPP DETAIL DRAWING
06.1	01	GLPP LOAD SCHEDULES
06.2	01	GLPP LOAD SCHEDULES CONT'D
07.0	00	CAMERAS
08.0	00	DIN-AP CONTROL SYSTEM PROCESSOR
09.0	00	GL-IPAC-SW8
10.0	00	GL-IPAC-SW8 DETAIL DRAWING
11.0	00	GLPAC-DIMFLVX
12.0	00	GLPAC-DIMFLV4 & 8 DETAIL DRAWING
13.0	00	GLPP-DIMFLVCN-PM
14.0	00	GLPP-DIMFLVCN-PM DETAIL DRAWING
15.0	00	GLS-LOL
16.0	00	GLS-LOL OPEN-LOOP PHOTOCELL
17.0	00	GLS-ODT-NS
18.0	00	GLS-ODT-NS TECHNIQUES
19.0	00	GLS-PART-CN
20.0	00	PARTITION SENSOR
21.0	00	GLS-SIM
22.0	00	GLS-SIM WITH SENSOR WIRING DETAILS
23.0	00	SURFACE MOUNT ETHERNET TOUCH SCREEN

The review by JRP Engineering is for the sole purpose of ascertaining conformance with the general design concept. This review shall not mean the detail design inherent in the shop drawings are approved, responsibility of which shall remain with the Contractor submitting same and review shall not relieve the Contractor of this responsibility for errors or omissions in the shop drawings or his responsibility for meeting all requirements of the Contract Documents. The Contractor is responsible for dimensions to be confirmed and controlled at the job site for information that pertains solely to fabrication processes as to techniques of construction and installation and for coordination of the work of all sub-trades.

JRP Engineering

C.McGuire

DATE: MAY 17th, 2017

### \* MODIFICATIONS:

1. Provide more information on the GLA-PWS50 for contractors.
2. Contractor to coordinate installation on site with reference to slab conduits that are currently installed.
3. If changes are required to the network layout shown in this shop drawing, the changes are to be marked up or drawings updated for the final As-Built submission for this project.
4. Electrical to coordinate with system supplier to ensure a complete and operational system is achieved.
5. Coordinate changes to drawings with contractors comments provided to you on May 9th, 2017.

### DRAWING SET REVISION HISTORY

REV	DATE	ENG	REVISION DESCRIPTION
0	1-24-17	SDL	INITIAL SUBMITTAL
1	3-29-17	SDL	REVISED
2	4-13-17	SDL	REVISED
3	4-21-17	SDL	REVISED

THE DRAWINGS CONTAINED WITHIN THIS SET ARE NOT TO SCALE.

THIS DRAWING SET IS FORMATTED FOR PRINTING AT 11"X17" (B-SIZE/TABLOID). IF THIS DRAWING SET HAS BEEN PRINTED AT A SMALLER SIZE AND IS ILLEGIBLE, CONTACT YOUR PROJECT MANAGER.



PROJECT: TOMLINSON  
LOCATION: CITIGATE, OTTAWA  
QUOTE #: 1048528  
SALES REP: BDA LIGHTING GROUP  
DISTRIBUTOR: DISTRIBUTOR

**CRESTRON**  
15 Volvo Drive  
Rockleigh NJ 07647  
Tel: 888-273-7876  
Fax: 201-767-6011  
www.crestron.com

TITLE:  
COVER PAGE AND  
DRAWING INDEX  
  
DRAWING:  
01.0  
REV:03  
DATE:4/21/17  
DRAWN BY:SDL



# Crestron General System Notes

Not all notes will be pertinent to all projects. The installing contractor should review these notes and determine their applicability to the project.

### Submittal Approval

- One copy of this submittal package must be stamped and/or signed and approved by the responsible architect/engineer. It should then be forwarded to: [CLCLighting@crestron.com](mailto:CLCLighting@crestron.com)
- Email is the best method for returning the submittal, but if it must be mailed it should be addressed to: Crestron Electronics, Inc. 6 Volvo Drive Rockleigh, NJ 07647 ATTN: Commercial Lighting
- Please clearly indicate whether this package is accepted as is, accepted with notations, or rejected.
- In the case of "accepted with notations", if the notations are extensive or require substantial changes, Crestron reserves the right to require re-approval of the submittal package after the incorporation of those notations. Additional charges may apply for added equipment or services.
- An order for the dimming system described by this submittal package will be accepted after receipt of the stamped submittal and a valid PO matching the latest revision of the Crestron quotation. After receipt of these items, shipment will be scheduled within 10-15 days. In the case of custom products fabrication may take slightly longer.
- Any changes to this system will result in rescheduling, longer manufacturing time, and/or additional engineering charges.
- Orders canceled after 3 days from Crestron's acceptance of the order or after submittals have been provided will result in cancellation charges.

### Color Choices

- Please carefully examine these submittals for notations regarding the color or finish of devices and confirm that all choices are correct. Restocking fees will apply for changing device colors after shipment.

### System Programming

- Programming charges include 'Standard' & 'Modified' default keypad and touch screen templates. Additional design fees are required for certain custom graphics. Contact your Crestron Project MANAGER for details and charges.

### Control System Power

- It is recommended that the system processor and all control signal distribution equipment be supplied by a dedicated, backed up, clean power source with surge & spike protection, furnished by others unless specifically noted otherwise in this submittal.

**NOTICE:**  
THIS DRAWING PACKAGE IS THE PROPERTY OF AND CONTAINS INTELLECTUAL PROPERTY BELONGING TO CRESTRON ELECTRONICS, INC. THIS PACKAGE SHALL NOT BE REPRODUCED, USED, OR DISCLOSED WITHOUT PRIOR WRITTEN CONSENT. NO PORTION MAY BE INCORPORATED INTO ANY OTHER DESIGN OR SYSTEM LAYOUT.

### WARNING

THIS DOCUMENT SET DOES NOT DESCRIBE AN INSTALLABLE SYSTEM UNTIL IT HAS BEEN REVIEWED FOR CODE COMPLIANCE BY THE PROJECT ELECTRICAL ENGINEER OR OTHER CODE-COMPLIANCE AUTHORITY. ALTHOUGH EVERY EFFORT HAS BEEN MADE TO PRODUCE A COMPLETE AND CODE-COMPLIANT DESIGN, CRESTRON INC. SPECIFICALLY DISCLAIMS ANY RESPONSIBILITY FOR CODE COMPLIANCE, WHICH IS THE RESPONSIBILITY OF THE PROJECT ELECTRICAL ENGINEER OR CODE AUTHORITY.

### System Wiring & Electrical

- Crestron's Extended 8 Year Limited Warranty requires the use of Crestron Certified wire. Please visit [www.crestron.com/Products/Information](http://www.crestron.com/Products/Information).
- All installation and termination labor is furnished by the project electrical contractor.
- All Ethernet wiring must be terminated to the appropriate ANSI/EIA wiring specification. All other wiring must be terminated per the Contractor's specification shown in this document.
- All line voltage conductors of the same circuit shall be contained in the same conduit, raceway, auxiliary gutter, cable tray, or cable.
- All low voltage control wire shall be separated appropriately to eliminate any possibility of secondary induced voltage due to line voltage wires in close proximity.
- Load circuit wiring shall have individual neutrals for any circuit with phase control dimming.
- Line feeds are to be determined by others.
- Phase-balancing of loads is to be determined by others. If this requires modification of Crestron panels, Crestron must be notified immediately and submittals shall be revised to ensure accurate programming of system.
- Replacement hardware shall be installed by licensed Electrical Contractors only.
- All Crestron control devices have an associated serial number. The Electrical Contractor must identify each SN for each device, and their location of installation on the plans. This information is required to program the system.

### System Start-up

- Three weeks prior to the start of the electrical contractor must fill out and submit the System Commissioning Forms on the following pages.
- In order to accomplish the system commissioning, the Crestron field engineer must have full access to the normal business hours, 8am-5pm local time. An additional premium rate will apply if work must be performed outside of normal business hours or at night, on weekends, or on ratio.
- In order to commission the system, the Crestron field engineer must be able to access all equipment contractor's res required for pro

### 4-Wire 0-10v Dimmi

- Crestron product compliant with This standard is source. Ballasts components to l
- Crestron recom AWG wire. Twi

### Fluorescent Lamps

- If fluorescent lamp spares, should l improve lamp lif recommendatio

### Ethernet

- Ethernet infrastr submittal, excep configured by ol
- Crestron Ethern Crestron should
- An Ethernet connection to allow contact between the processor and an Internet time server is the most reliable way to update the system astronomical time clocks to keep the system time accurate in a multiple processor system.
- Even when not specifically required by the project, Crestron strongly recommends providing an Ethernet connection to the Crestron processor(s) to allow for remote system updates and troubleshooting. If an Ethernet connection cannot be provided Crestron will request a signed waiver noting the understanding that remote access is not being given and additional troubleshooting trips may be required.
- Static IP addresses or other system-specific configuration that must be implemented on Crestron-provided equipment must be provided to Crestron prior to the technician's arrival onsite.

REVIEWED  
 REVIEWED AND MODIFIED  
 REVIEWED AND RE-SUBMIT  
 NOT REVIEWED  
 The review by JRP Engineering is for the sole purpose of ascertaining conformance with the general design concept. This review shall not mean the detail design inherent in the shop drawings are approved, responsibility of which shall remain with the Contractor submitting same and review shall not relieve the Contractor of this responsibility for errors or omissions in the shop drawings or his responsibility for meeting all requirements of the Contract Documents. The Contractor is responsible for dimensions to be confirmed and coordinated at the job site, for information that pertains solely to fabrication processes or to techniques of construction and installation and for co-ordination of the work of all subcontractors.  
 JRP Engineering  
 C. McGuire  
 DATE: MAY 17th, 2017

### \* MODIFICATIONS:

- Provide more information on the GLA-PWS50 for contractors.
- Contractor to coordinate installation on site with reference to slab conduits that are currently installed.
- If changes are required to the network layout shown in this shop drawing, the changes are to be marked up or drawings updated for the final As-Built submission for this project.
- Electrical to coordinate with system supplier to ensure a complete and operational system is achieved.
- Coordinate changes to drawings with contractors comments provided to you on May 9th, 2017.

### Shades & Drapes

- Crestron programming of third-party shades, drapes, or shade controllers is limited to master up/down or open/close & stop commands only. Any addressing, identification, grouping, or other manufacturer-specific programming is outside of Crestron's scope of work and must be provided by others. Any changes made by a third-party provider after system commissioning that requires a matching change by Crestron will be subject to additional programming and on-site fees.

### BMS Integration

- Unless a Crestron "GLA-BMS" interface or DIN-AP3 processor is provided with this system, BMS integration is assumed to be via contact closures within the limits of the Crestron system processor. See processor specifications for the quantity of contact closures available.
- If a GLA-BMS interface is provided, the following programming is provided:
  - Crestron GA-BMS is a protocol translator only, and is not the head-end control for any BMS equipment
  - Standard configuration of the GLA-BMS is for the BMS system as "client"
  - Standard configuration of the GLA-BMS is for the Crestron system as "Server" to the BMS Client.
  - Note: Server gives Client access to control of circuits or presets, status of circuits or presets, status of occupancy sensors, and status of photocells. Server does not control individual BMS device programming and control is the responsibility of the BMS manufacturer/integrator. Any deviation from this BMS standard requires additional configuration, programming, and onsite fees.
- The DIN-AP3 (and certain other "Series 3" processors) has the same capabilities, but only communicates via BACnet over IP, and is limited to 50 points/objects unless an upgraded version is included & shown on the Bill of Materials. ("SW-3SERIES-BACNET-50+")

### DMX Integration

- If included, a GLA-DMX512 or DIN-DMX Interface quote is based upon the following standards:
  - DMX device will be used to interface Crestron lighting control processors to DMX lighting fixtures.
  - Crestron is not a show controller and is not responsible for programming DMX light shows, i.e. chases, color fades, etc.
  - Crestron will only provide DMX fixture presets that may be accessed by a Crestron User Interface.
  - Crestron is not responsible for setting up addresses (ID's) or channels on DMX lighting fixtures. Both addresses and channels are required to be given to Crestron prior to the On-Site Startup Request.
  - If a DMX console is being used to control lighting on the Crestron control system, additional programming and onsite fees will be required. The processor in this case must be a Crestron 256mps processor or greater (ie. PAC2 or DIN-AP3). Only the GLA-DMX512 may accept external DMX to "snapshot". The DIN-DMX will pass DMX from a console through to DMX devices, but may not record the signal as a preset.

### ALI Systems

If DALI is provided as a part of the Crestron system, the contractor must supply one authorized representative to the Crestron Field Engineer during System Commissioning to assist with fixture identification, fixture locations, and addressing.

The DALI Standard does not require shielded wire. However, unshielded wire may be subject to induced voltage due to improper installation. If unshielded DALI cable is used & improperly installed causing induced voltage on the cable, the Electrical Contractor will be charged for Crestron's time to troubleshoot the system.

- DALI wire gauge shall be sized appropriately based upon voltage drop. Crestron recommends 14-20 AWG based upon run length.
- The DALI protocol can communicate up to 300m.
- Per the NEC, Class 1 DALI cable may be run in the same conduit as line voltage wire.

### Touch Screens

- Certain touch screens (noted in Bill of Materials) are quoted with Crestron backboxes designed for drywall mounting applications. All other backboxes are standard electrical boxes and should be furnished by the installing contractor. Contact Crestron for additional mounting options if necessary.



PROJECT: TOMLINSON		ORDER #: 1841941
LOCATION: CITIGATE, OTTAWA		PO #: PURCHASE ORDER
QUOTE #: 1048528	SALES REP: BDA LIGHTING GROUP	
DISTRIBUTOR: DISTRIBUTOR		

**CRESTRON**  
 15 Volvo Drive  
 Rockleigh NJ 07647  
 Tel: 888-273-7876  
 Fax: 201-767-6011  
[www.crestron.com](http://www.crestron.com)

TITLE:  
 GENERAL SYSTEM  
 NOTES

DRAWING:  
 02.0  
 REV:00  
 DATE:1-26-17  
 DRAWN BY:SDL



# Crestron Commercial Lighting Control Systems Electronic System Commissioning Request

- REVIEWED
- REVIEWED AND MODIFIED
- REVISE AND RESUBMIT
- NOT REVIEWED

CLCS Commissioning Requests must be received three weeks prior to the time Crestron is to arrive on site. The 3 week lead time is necessary to review all system documentation, ensure that documentation is complete and accurate, obtain any missing information, as well as program the system prior to arriving on-site.

Crestron will not schedule on-site visits, until all information below is verified as being complete by a Crestron Project MANAGER. Please contact your CLCS Project MANAGER to help you complete these forms if you have ANY questions.

CANCELLATION POLICY: If a Start-Up Request Form has been submitted and confirmed, and appropriate travel arrangements have been made (ie. flight, train, car rental, hotel, etc.) requestee will be held responsible for all associated cancellation fees. Crestron will invoice purchasee all associated cancellation fees. Failure of back-charge payment will void all system warranty.

All Start-Up requests are now completed electronically. Follow the instructions below to download the "Canvas Plus" application for your iOS and Droid devices.

## Instructions

### STEP1: Download the Canvas Plus App

For iPhone & iPad users, Click on this link: <https://itunes.apple.com/us/app/canvas-plus/id482034211?mt=8>

Or scan this QR Code:




For Android users, open the Android Marketplace, search for canvas, click and download the canvas plus app created by Canvas Solutions Inc. DATE: MAY 17th, 2017

Or scan this QR Code:



For other PC & Mobile Operating Systems: go to this link <http://www.gocanvas.com/m> and select the mobile operatio

Or scan this QR Code:

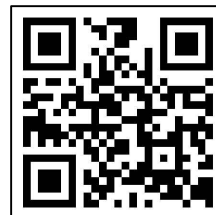

### STEP 2: Log on

- User Name: electrical.contractor@crestron.com
- Password: crestron07647

### STEP 3:

Select "Commissioning Form" and click START

Project #: 1841941 Project Name: TOMLINSON

The review by JRP Engineering is for the sole purpose of ascertaining conformance with the general design concept. This review shall not mean the detail design inherent in the shop drawings are approved, responsibility of which shall remain with the Contractor submitting same and review shall not relieve the Contractor of this responsibility for errors or omissions in the shop drawings or his responsibility for meeting all requirements of the Contract Documents. The Contractor is responsible for dimensions to be confirmed and correlated at the job site, for information that pertains solely to fabrication processes or to techniques of construction and installation and for co-ordination of the work of all sub-trades.

JRP Engineering

C.McGuire

### \* MODIFICATIONS:

1. Provide more infor ont he GLA-PWS50 for contractors.
2. Contractor to coordinate installation on site with reference to slab conduits that are currently installed.
3. If changes are required to the network layout shown in this shop drawing, the changes are to be marked up or drawings updated for the final As-Built submission for this project.
4. Electrical to coordinate with system supplier to ensure a complete and operational system is achieved.
5. Coordinate changes to drawings with contractors comments provided to you on May 9th, 2017.



PROJECT: TOMLINSON	ORDER #: 1841941
LOCATION: CITIGATE, OTTAWA	PO #: PURCHASE ORDER
QUOTE #: 1048528	SALES REP: BDA LIGHTING GROUP
DISTRIBUTOR: DISTRIBUTOR	

**CRESTRON**  
 15 Volvo Drive  
 Rockleigh NJ 07647  
 Tel: 888-273-7876  
 Fax: 201-767-6011  
 www.crestron.com

TITLE:  
 SYSTEM  
 ELECTRONIC  
 COMMISSIONING  
 REQUEST FORM  
 DRAWING:  
 02.1  
 REV:00  
 DATE:1-26-17  
 DRAWN BY:SDL

# CRESNET WIRING DETAILS

**CAUTION: POSSIBLE EQUIPMENT DAMAGE IF MISWIRED**

- REVIEWED
- 1 TO 1 PINOUT REFERENCE
- REVIEWED AND MODIFIED
- REVISE AND RESUBMIT
- NOT REVIEWED

The review by JRP Engineering is for the sole purpose of ascertaining conformance with the general design concept. This review shall not mean the detail design inherent in the shop drawings are approved, responsibility of which shall remain with the Contractor submitting same and review shall not relieve the Contractor of this responsibility for errors or omissions in the shop drawings or his responsibility for meeting all requirements of the Contract Documents. The Contractor is responsible for dimensions to be confirmed and correlated at the job site, for information that pertains solely to fabrication processes or to techniques of construction and installation and for coordination of the work of all sub-trades.

JRP Engineering

C.McGuire

### COLOR CODE - CRESNET CABLE

GND = BLACK  
 Z = BLUE  
 Y = WHITE  
 24 = RED

DATA PAIR (#22 AWG TWISTED)

POWER PAIR

(#18 AWG PARALLEL-STANDARD CABLE)  
 (#12 AWG PARALLEL-HIGH POWER CABLE)

### CONNECTION TO CONTROL PROCESSOR

(BLACK) G  
 (BLUE) Z  
 (WHITE) Y  
 (RED) 24

TWISTED PAIR A (BLUE/ WHITE)  
 PARALLEL PAIR B (RED/BLACK)

SHIELD / DRAIN  
 CAP-OFF AT END POINT OF CABLE


SHIELD / DRAIN  
 (TERMINATE AT CONTROL/ PROCESSOR END ONLY)  
 DRAIN WIRES MUST BE SPLICED AT ALL CONNECTIONS

### TO EACH NETWORK DEVICE ALONG THE CABLE

24 (RED)  
 Y (WHITE)  
 Z (BLUE)  
 G (BLACK)

### TO LAST NETWORK DEVICE AT END-OF-LINE

24 (RED)  
 Y (WHITE)  
 Z (BLUE)  
 G (BLACK)

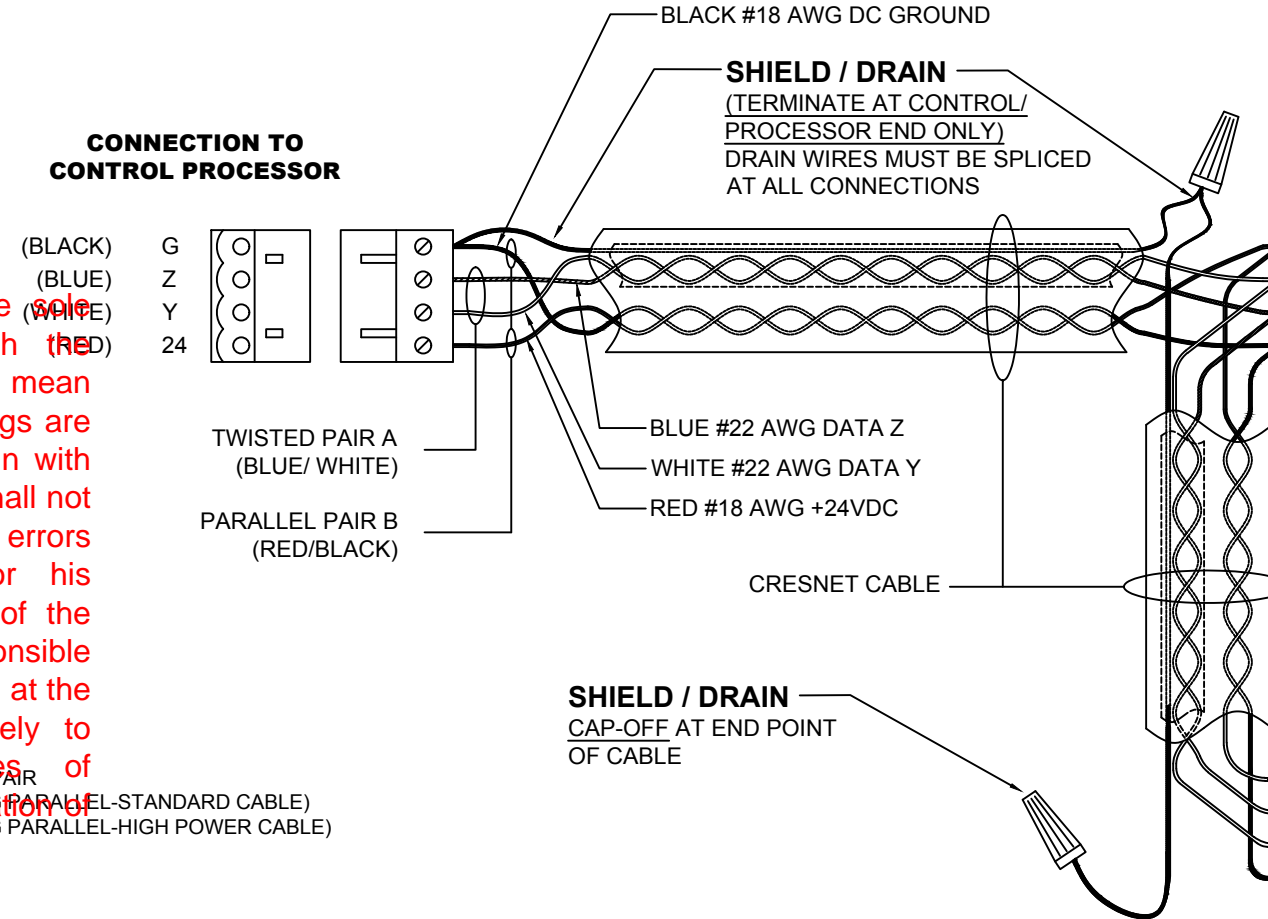

DATE: MAY 17th, 2017

## WIRING NOTES

### DO NOT DO THIS:

GENUINE CRESN COMMERCIAL LIC

STRIP ONLY THE EXPOSED CONDUCTORS AT ELECTRICAL TAP

GROUND SHIELD

SHIELD/DRAIN MUST NOT BE CONNECTED TO CONTROL PROCESSOR

SHIELD/DRAIN SHOULD NOT BE CONNECTED TO CONTROL BLOCKS BUT SHOULD BE CONNECTED TOGETHER AS DIRECTED

WHEN DAISY CHAINING AND THE OUTGOING CABLE USE A PIGTAIL FROM PHOENIX CONNECTION BLOCKS (HP) (HIGH-POWER CONDUCTORS).

MODEL "CNTBLOC" IS FOR TESTING PURPOSES AND CONVENIENCE OF WIRING.

#### \* MODIFICATIONS:

1. Provide more information on the GLA-PWS50 for contractors.
2. Contractor to coordinate installation on site with reference to slab conduits that are currently installed.
3. If changes are required to the network layout shown in this shop drawing, the changes are to be marked up or drawings updated for the final As-Built submission for this project.
4. Electrical to coordinate with system supplier to ensure a complete and operational system is achieved.
5. Coordinate changes to drawings with contractors comments provided to you on May 9th, 2017.

DO NOT POWER UP SYSTEM UNTIL ALL WIRING IS VERIFIED. CARE SHOULD BE TAKEN TO ENSURE DATA (Y,Z) AND POWER (24,G) CONNECTIONS ARE NOT CROSSED.

DO NOT CONNECT THE SHIELD/DRAIN WIRE OF ANY CRESNET CABLE TO GROUND AT ANY CONNECTION POINT EXCEPT THE CONTROL PROCESSOR.

DO NOT ALLOW ANY EXPOSED SHIELD/DRAIN WIRE TO MAKE CONTACT WITH ANY ELECTRICAL GROUND. IF ANY WIRE IS EXPOSED, IT MUST BE INSULATED- HEAT SHRINK TUBE IS RECOMMENDED, BUT AT A MINIMUM PVC ELECTRICAL TAPE CAN BE USED.

DO NOT EXCEED THE "MAXIMUM LENGTH" SHOWN IN THE CABLE IDENTIFICATION BLOCK OF ANY CABLE. 1000' IS THE NORMAL MAXIMUM LENGTH THAT WILL BE INDICATED. IN MOST SITUATIONS 1500' WILL BE POSSIBLE, BUT IS NOT RECOMMENDED DUE TO POSSIBLE INTERFERENCE & INDUCED VOLTAGE. LONGER CABLE RUNS WILL REQUIRE SIGNAL HUBS OR REPEATERS TO ENSURE SIGNAL RELIABILITY. (SEE NEXT SHEET FOR MORE INFO ON CRESNET POWER.)

DO NOT EXCEED 20 CRESNET "DEVICES" ON ANY ONE NETWORK SEGMENT WITHOUT DISCUSSING THE POSSIBLE IMPLICATIONS WITH YOUR CRESTRON PROJECT ENGINEER. (SEE NEXT SHEET FOR MORE INFO ON CRESNET DEVICES.)



PROJECT: TOMLINSON	ORDER #: 1841941
LOCATION: CITIGATE, OTTAWA	PO #: PURCHASE ORDER
QUOTE #: 1048528	SALES REP: BDA LIGHTING GROUP
DISTRIBUTOR: DISTRIBUTOR	

**CRESTRON**  
 15 Volvo Drive  
 Rockleigh NJ 07647  
 Tel: 888-273-7876  
 Fax: 201-767-6011  
 www.crestron.com

TITLE:  
 CRESNET WIRING INSTRUCTIONS

DRAWING: 02.2  
 REV:00  
 DATE:1-26-17  
 DRAWN BY:SDL

# CALCULATING POWER USED AND MAXIMUM CABLE LENGTH

IN MOST CASES, CRESTRON WILL CALCULATE THE CABLE REQUIREMENTS OF THE CRESTRON SYSTEM AS A PART OF THE SUBMITTAL PACKAGE. IN CASES WHERE CRESTRON HAS NOT BEEN PROVIDED WITH COMPLETE INFORMATION TO GENERATE THE SUBMITTAL THE INSTALLING CONTRACTOR MUST REVIEW & UNDERSTAND THE INFORMATION ON THIS PAGE IN ORDER TO PROPERLY INSTALL THE LIGHTING SYSTEM.

## CABLE IDENTIFICATION BLOCK

EACH CONTROL CABLE RUN ON THE CRESTRON RISER DRAWINGS SHOULD INCLUDE A BLOCK LIKE THE ONE SHOWN TO THE LEFT. THIS SHOWS THE NUMBER OF CRESNET DEVICES ATTACHED TO THE CABLE, THE MAXIMUM LENGTH THAT WILL ALLOW CORRECT FUNCTION, AND THE MINIMUM VOLTAGE THAT SHOULD BE MEASURED AT THE END OF THE CABLE MOST DISTANT FROM THE PROCESSOR OR MID-POINT POWER SUPPLY/DISTRIBUTION HUB. MAXIMUM LENGTH IS SHOWN FOR STANDARD CRESNET CABLE; USING CRESNET-HP (HIGH-POWER) CABLE ALLOWS YOU TO MULTIPLY THE LENGTH BY APPROXIMATELY 3.5 TIMES.

CRESNET CABLE 1	
DEVICES	12
WATTS USED	14
MAX LENGTH	476
MIN VOLTS	22V

THE CONTRACTOR SHOULD LABEL THE PROCESSOR END OF THE CABLE WITH THE APPROPRIATE CRESNET CABLE NUMBER. WHILE NOT STRICTLY REQUIRED, IT IS RECOMMENDED THAT THE CABLE BE LABELED AT EACH SPLICE POINT, IN THE EVENT TROUBLESHOOTING IS REQUIRED DURING SYSTEM COMMISSIONING.

THIS CABLE ID BLOCK MAY BE OMITTED ON SMALLER PROJECTS, OR PROJECTS WITH LIMITED POWER REQUIREMENTS.

### CRESNET DEVICES:

"DEVICES" INDICATES THE NUMBER OF LOGICAL CRESNET DEVICES ON THE CABLE. THIS NUMBER MAY NOT BE OBVIOUS WHEN EXAMINING THE RISER. FOR EXAMPLE, IN SOME DIMMING/SWITCHING PANELS EACH INTERNAL MODULE MAY COUNT AS A SEPARATE DEVICE. ALTERNATELY, IF TWO SENSORS ARE CONNECTED TO ONE GLS-SIM INTERFACE, ONLY THE INTERFACE COUNTS AS A CRESNET DEVICE. IN MOST CASES THE MAXIMUM NUMBER OF CRESNET DEVICES ON ANY ONE WIRING SEGMENT IS (20). A "SEGMENT" IS A GROUPING OF PORTS AS SHOWN ON THE PROCESSOR WIRING DETAIL SHEETS, AND OFTEN INCLUDES MORE THAN ONE CRESNET CABLE. CRESNET "HUBS" (i.e. DIN-HUB) MAY BE USED TO INCREASE THE NUMBER OF DEVICES ON ONE SEGMENT, BUT SHOULD NOT BE ADDED WITHOUT CONSULTING THE CRESTON PROJECT ENGINEER.

CRESTRON STRONGLY RECOMMENDS THAT THE EQUIPMENT IN THIS SYSTEM BE INSTALLED AS SHOWN ON THE RISERS. MINOR CHANGES ARE ACCEPTABLE- FOR EXAMPLE, ALTERING THE ORDER OF DEVICES ALONG A CABLE. HOWEVER, ADDING OR REMOVING DEVICES WILL HAVE AN IMPACT ON THE DEVICE COUNT AND POWER REQUIREMENTS.

FURTHER, THE INFORMATION AS PROVIDED IN THE CABLE IDENTIFICATION BLOCKS IS ALSO USED FOR THE PREPARATION OF THE PROCESSOR WIRING DETAIL SHEETS IN THIS PACKAGE. ALTERING THE DEVICE QUANTITY MAY HAVE SIGNIFICANT IMPACT ON THESE DRAWINGS.

IF THE WIRING AS SHOWN ON THE CRESTRON RISERS IS NOT POSSIBLE, THE INFORMATION BELOW MAY BE USED TO CALCULATE THE MAXIMUM POSSIBLE LENGTH OF A CABLE. NO CABLE SHOULD EXCEED 1000' WITHOUT DISCUSSION WITH YOUR PROJECT ENGINEER. MUCH LONGER DISTANCES ARE POSSIBLE, BUT MUST BE DISCUSSED WITH CRESTRON. USING CRESNET-HP HIGH POWER CABLE DOES NOT EXTEND THIS LIMIT. IF A LONGER CABLE IS REQUIRED A SIGNAL HUB OR REPEATER MAY BE ADDED ALONG THE CABLE.

PLEASE CONTACT YOUR CRESTRON PROJECT ENGINEER IF YOU HAVE ANY QUESTIONS REGARDING THE WIRING REQUIREMENTS OF THE SYSTEM, OR IF YOU NEED ASSISTANCE IN ALTERING THE RISERS. YOUR PROJECT ENGINEER IS AVAILABLE AS A RESOURCE TO HELP.

ANY CHANGES MADE TO THE WIRING AS SHOWN ON CRESTRON RISERS MUST BE COMMUNICATED TO CRESTRON NO LATER THAN WHEN YOU REQUEST SYSTEM COMMISSIONING.


ANY CHANGES MADE TO THE RISERS THAT ARE NOT COMMUNICATED TO CRESTRON THAT REQUIRE ALTERING SYSTEM PROGRAMMING AT THE TIME OF COMMISSIONING MAY RESULT IN ADDITIONAL CHARGES FOR REPROGRAMMING OR ADDITIONAL SERVICE VISITS.

## THE CRESNET POWER CALCULATION:

### MAXIMUM CRESNET CABLE LENGTH

$$L < \frac{40,000}{R \times P}$$

Where L = Maximum Length of run in feet from power source  
 R = 6 Ohms for Cresnet Certified wire or  
 1.6 Ohms for Cresnet High Power Certified wire  
 P = Cresnet Power usage of entire run

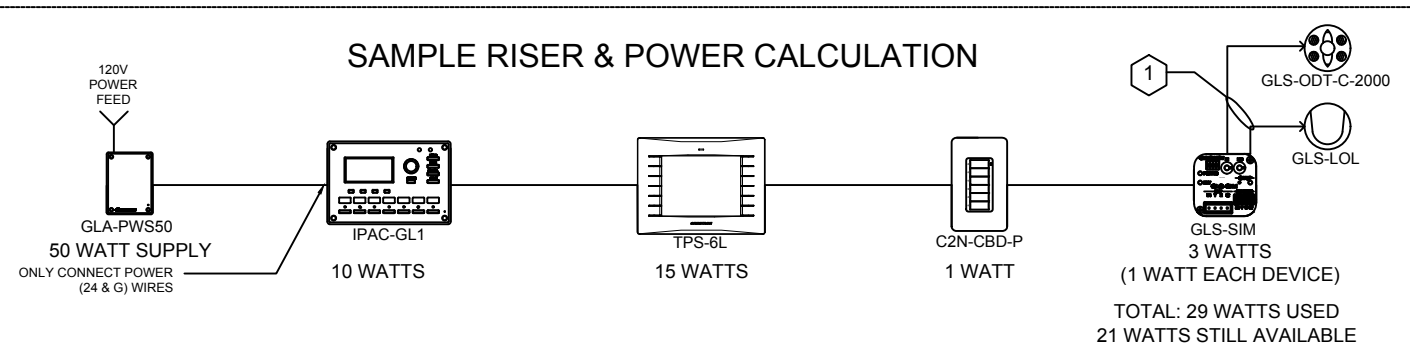

TO CALCULATE THE MAXIMUM LENGTH CABLE FOR THE ABOVE EXAMPLE TAKE THE TOTAL POWER USED (28 WATTS) AND MULTIPLY IT BY THE RESISTANCE OF THE WIRE, THEN DIVIDE 40,000 BY THAT NUMBER.

CRESNET STANDARD CABLE (CRESNET-NP OR CRESNET-P) HAS A RESISTANCE OF 6 OHMS.

29 WATTS X 6 OHMS = 174  
 40,000 DIVIDED BY 174 GIVES YOU A RESULT OF A MAXIMUM CABLE RUN OF 230 FEET.

CRESNET HIGH-POWER (CRESNET-HP-NP) CABLE HAS A LOWER RESISTANCE OF 1.6 OHMS.

29 WATTS x 1.6 OHMS = 46.4  
 40,000 DIVIDED BY 46.4 GIVES YOU A MAXIMUM LENGTH OF 862 FEET.

POWER DRAW OF COMMON CRESTRON DEVICES				
CATEGORY	DESCRIPTION	POWER DRAW	NOTES	
PROCESSOR	PRO-PROCESSOR	25W	CONTAINS 75W POWER SUPPLY; CAN POWER 50W OF EXTERNAL DEVICES	
PAC2M-DIN-HUB	PAC2M PROCESSOR	5W		
PAC2M-DIN-HUB	DIN RAIL MOUNT PROCESSOR	8W		
PAC2M-DIN-HUB	INTEGRATED PROCESSOR	10W		
GLPAC-DIMFLV	INTEGRATED DIMMING/SWITCHING PANEL	0W	DOES NOT DRAW ANY CRESNET POWER; SUPPLIES 10W TO LOCAL DEVICES	
GLPP (SWCN OR SWNLV)	POWER PACK WITH INTEGRATED DIMMING/SWITCHING PANEL	0W	DOES NOT DRAW ANY CRESNET POWER; SUPPLIES 2.5W TO LOCAL DEVICES	
KEYPADS	C2N-CBD-P CAMEO KEYPAD	1W		
	C2N-CBD-E CAMEO EXPRESS KEYPAD	1W		
	CHRONER 4770	3W		
SENSORS & ACCESSORIES	GLS-SIM SENSOR INTEGRATION MODULE	1W		
	GLS-ODT-X DUAL TECHNOLOGY OCCUPANCY SENSORS	1W		
	GLS-ODT-C-CN CRESNET DUAL TECH OCCUPANCY SENSORS	1W		
	GLS-OIR INFRARED OCCUPANCY SENSORS	1W		
	GLS-LOL, LOL PHOTOCELLS	1W		
	GLS-EXT EXTERIOR PHOTOCELL	1W		
	GLS-PART PARTITION SENSOR	1W		
	C2N-SDC SHADORAFC CONTROLLER	3W		
	PORT EXPANDER RS232 & RELAY	3W	REQUIRES DEDICATED GLA-PWS50 OR GREATER POWER SUPPLY	
DIN RAIL UNITS	DIN-DIM2 DIMMER CONTROLLER	9W	MAY USE POWER OVER ETHERNET; DEFAULTS TO CRESNET POWER IF BOTH ARE PRESENT	
	DIN-HUB CRESNET DISTRIBUTION HUB	6W		
	DIN-1DIM4 DIMMER MODULES	6W	SAME FOR DIN-1DIMU4	
	DIN-8SW8-1	6W	SAME FOR DIN-8SW8-1	

The review by JRP Engineering is for the sole purpose of ascertaining conformance with the general design concept. No review shall mean the detail design inherent in the shop drawings are approved, responsibility which shall remain with the Contractor submitting same and review shall not relieve the Contractor of this responsibility for errors or omissions in the shop drawings or his responsibility for meeting all requirements of the Contract Documents. The Contractor is responsible for dimensions to be confirmed and correlated at the job site for information that pertains solely to fabrication processes or to techniques of construction and installation and for coordination of the work of all sub-trades.

## PROPER SEPARATION OF POWER & DATA

C.McGuire

DATE: MAY 17th, 2017

### \* MODIFICATIONS:

1. Provide more information on the GLA-PWS50 for contractors.
2. Contractor to coordinate installation on site with reference to slab conduits that are currently installed.
3. If changes are required to the network layout shown in this shop drawing, the changes are to be marked up or drawings updated for the final As-Built submission for this project.
4. Electrical to coordinate with system supplier to ensure a complete and operational system is achieved.
5. Coordinate changes to drawings with contractors comments provided to you on May 9th, 2017.



TAKEN FROM ANSI/NECA/BICSI 568-2001			
PROTECTION	POWER <2KVA	POWER 2-5KVA	POWER >5KVA
NONE- POWER & DATA CABLE OPEN AIR	5" (127MM)	10" (305MM)	24" (610MM)
DATA IN CONDUIT, POWER OPEN AIR	2.5" (64MM)	6" (152MM)	12" (305MM)
BOTH POWER & DATA IN CONDUIT	0	0	6" (152MM)
SPECIAL CASE: MOTORS OR TRANSFORMERS NEAR DATA CABLE IN CONDUIT	0	0	48" (1220MM)

SEPARATION SHOWN IS THE MINIMUM ALLOWABLE BY THIS STANDARD. GREATER SEPARATION IS PREFERABLE



PROJECT: TOMLINSON  
 LOCATION: CITIGATE, OTTAWA  
 QUOTE #: 1048528  
 SALES REP: BDA LIGHTING GROUP  
 ORDER #: 1841941  
 PO #: PURCHASE ORDER  
 DISTRIBUTOR: DISTRIBUTOR

**CRESTRON**  
 15 Volvo Drive  
 Rockleigh NJ 07647  
 Tel: 888-273-7876  
 Fax: 201-767-6011  
 www.crestron.com

TITLE:  
 CRESNET POWER CALCULATIONS

DRAWING:  
 02.3  
 REV:00  
 DATE:1-26-17  
 DRAWN BY:SDL

**Bill of Materials**

Project: TOMLINSON  
 Creator: SDL  
 Date: 4/21/2017

Rev: 3

Panel ID: CONTROL PROCESSOR (TYPICAL OF 4)

QTY	PART #	DESCRIPTION
1	DIN-EN-6X	ENCLOSURE FOR DIN RAIL DEVICES, 6 DIN RAILS, 18 UNITS WIDE
1	DIN-AP3	DIN RAIL 3-SERIES CONTROL PROCESSOR
3	CEN-SW-POE-5	4 PORT NETWORK SWITCH WITH UPLINK
1	DIN-PWS50	DIN RAIL MOUNT CRESNET DISTRIBUTION HUB 50 WATT
2	DIN-HUB	DIN RAIL MOUNT CRESNET DISTRIBUTION HUB
1	XPANEL-CL	PC e-CONTROL INTERFACE (NATIVE TO PROCESSOR-NOTHING TO SHIP)
1	SW-3SERIES-BACNET-50+	BACNET IP SUPPORT FOR 3-SERIES, FULL LICENSE FOR MORE THAN 50 OBJECTS

Panel ID: DIMMING CONTROL

QTY	PART #	DESCRIPTION
1	GLPAC-DIMFLV8	GREENLIGHT AUTOMATION PROCESSOR, 8 CHANNELS 0-10V DIMMING OR SWITCHING
19	GLPAC-DIMFLV4	GREENLIGHT AUTOMATION PROCESSOR, 4 CHANNELS 0-10V DIMMING OR SWITCHING
6	GLPP-DIMFLV2CN-PM	GREENLIGHT POWERPACK, ONE FEED, TWO SWITCHED OR 4-WIRE DIMMED LOADS
70	GLPP-DIMFLV1CN-PM	GREENLIGHT POWERPACK, ONE FEED, ONE SWITCHED OR 4-WIRE DIMMED LOAD

Panel ID: EXTERIOR LIGHTING

QTY	PART #	DESCRIPTION
1	GL-IPAC-SW8	GREENLIGHT INTEGRATED SWITCHING SYSTEM
1	GLS-LEXT	EXTERIOR OPEN LOOP PHOTOCELL
1	GLS-SIM	SENSOR INTEGRATION MODULE

Interfaces:

QTY	PART #	DESCRIPTION	COLOR
161	GLS-ODT-C-1		
36	GLS-LOL		
2	C2N-CBD-P		WHITE, SMOOTH
7	GLA-PWS50		
68	GLPPA-KP		WHITE, SMOOTH
1	GLS-PART-CI		
2	TSW-750		WHITE, SMOOTH

\* MODIFICATIONS:

1. Provide more information on the GLA-PWS50 for contractors.
2. Contractor to coordinate installation on site with reference to slab conduits that are currently installed.
3. If changes are required to the network layout shown in this shop drawing, the changes are to be marked up or drawings updated for the final As-Built submission for this project.
4. Electrical to coordinate with system supplier to ensure a complete and operational system is achieved.
5. Coordinate changes to drawings with contractors comments provided to you on May 9th, 2017.

**PROJECT SPECIFIC SYSTEM NOTES:**

- This proposal is based on drawings E-101 - E-104 dated June 15, 2016 and an email from Francois Bertrand dated September 2, 2016
1. Please note that the lighting panels on this proposal do not include circuit breakers. An external breaker box, with associated circuit breakers, must be provided by others.
  2. It is assumed that all fixtures are compatible with 0-10V dimming. Please contact Crestron should an alternate type of dimming be needed.
  3. Cameo keypads are compatible with standard decora faceplates, which are to be provided by others.
  4. Crestron BACnet/IP is a protocol translator only and is not the head end control for any BMS equipment
  5. Standard configuration of the BACnet/IP is for the BMS system as 'Client'
  6. Standard configuration of the BACnet/IP is for the Crestron system as 'Server' to the BMS Client
  7. Note: Server gives Client access to control of circuits or presets, status of circuits or presets, status of occupancy sensors, and status of photocells. Server does not control individual BMS devices on the network (i.e. thermostats, security systems, fire systems, etc.) Individual BMS device programming and control is the responsibility of the BMS Manufacturer/Integrator. Any deviation from this BMS standard requires additional configuration, programming, and onsite fees. Core 3 processors natively support BACnet/IP. A full BACnet/IP license has been provided and is available to support up to 500 objects. For systems with more than 500 objects you must purchase an additional Core 3 processor and full license. For more information on BACnet and the maximum number of objects that each processor can support, please visit [WWW.crestron.com/bacnet](http://WWW.crestron.com/bacnet)
  8. All emergency power provision including battery backup ballasts, generators, inverter systems and switching/transfer equipment including shunt relays are F.B.O.
  9. Proposal includes X-Panel software as a user interface. Server/workstation, keyboard, pointer device, and monitor required for X-Panel F.B.O.
  10. All network infrastructure, including routers, switches and wireless access points, to be provided by others.
  11. Crestron also offers support and maintenance plans for Commercial Lighting Systems. Contact Crestron for details and pricing about these service contracts.
  12. Important: All commissioning to be done during normal business hours of Monday-Friday 7am-6pm. Contact Crestron for a revised quote if project requires commissioning outside of these hours
  13. Important: Crestron products with 4-wire 0-10V dimming comply with IEC 60929 Annex E. This is the most common standard in use in the U.S. This standard is for current sinking dimmers, with the dimming ballast being the voltage source. Ballasts requiring the dimmer to be the voltage source will require additional components to be added to the quote. Please contact Crestron for a revised quote if voltage source dimmers for 4-wire 0-10V ballasts are required for this project.
  14. PLEASE NOTE - All line-voltage sensor / switch solutions are to be F.B.O. If a networked low-voltage solution is desired please contact Crestron for a revised quote.
  15. It is the responsibility of the installing contractor to ensure that all Electrical and Energy codes are in compliance with the code requirements of the Authority Having Jurisdiction. In the event a Crestron lighting solution doesn't meet these code requirements, please contact your local Crestron sales representative for a revised solution.
  16. PLEASE NOTE: The specifications provided did not have the correct design for the project as per conversation with Francois Bertrand on September 7, 2016. This proposal included a distributed design instead of a centralized design. Please contact Crestron for a revised quote if the design requirements change.

**STANDARD LIGHTING CONTROL SYSTEM NOTES:**

- Crestron equipment requires programming, commissioning, and support. All Crestron factory system quotations for Commercial Lighting Systems include the services of Standard Programming and Standard Commissioning.
- Standard Programming - Crestron offers both Standard Programming Templates as well as Custom Programming for their Lighting Control Systems. This quote includes programming using Crestron's Standard Design Templates for items such as Keypads, Touch Screens, BMS interfaces, and DMX Interfaces. You can review these standard templates on the Crestron website, [www.crestron.com](http://www.crestron.com). Please contact Crestron to request a quote for additional design fees related to Custom Programming for products.
  - Standard Commissioning - Crestron's Standard Commissioning for Commercial Lighting Systems includes three (3) on-site visits: (1) for submittal review with the EC, (1) for system startup, and (1) for end user training. Please contact Crestron to request a quote for any additional on-site services or support. Crestron Commercial Lighting System Quotations also include charges for custom factory engineering, configuration, documentation and UL Approval. (Smaller projects may be limited to a single visit. This will be noted in the Project Specific Note section.)
- All Crestron Commercial Lighting system purchases that use "MLO" style cabinets must also include Crestron Circuit Breakers.

Our pricing is as the attached Crestron Bill of Materials only, and may vary from equipment and systems detailed in the contract documents.

Actual cost and BOM may vary once additional information is provided. Orders for this project shall be "as per the Crestron Bill of Materials" only.

This is a preliminary quote subject to submittal/review of complete/final lighting system load schedule, functional specifications, and drawings.

No Cresnet wiring/cable is included on this proposal. Cresnet cable is required, and is to be purchased on an additional PO once appropriate types and required lengths are identified based on site conditions. Please contact Crestron for all cable options and pricing

**Notes:**

1. Please ensure all colors shown on this bill of materials are correct prior to releasing the order for shipment.
2. The addition of hardware to this order may result in additional programming charges.
3. If there are any corrections please make sure to notify your Crestron Project Engineer, listed on the cover page of this submittal.




PROJECT: TOMLINSON  
 LOCATION: CITIGATE, OTTAWA  
 QUOTE #: 1048528  
 ORDER #: 1841941  
 PO #: PURCHASE ORDER  
 SALES REP: BDA LIGHTING GROUP  
 DISTRIBUTOR: DISTRIBUTOR



TITLE: BILL OF MATERIALS  
 DRAWING: 03.0  
 REV: 03  
 DATE: 4-21-17  
 DRAWN BY: SDL

**NOTES:**  
 THESE NOTES MAY PERTAIN TO ANY ONE-LINE RISER IN THIS SET. THEY WILL NOT BE REPEATED ON OTHER SHEETS.  
 1. THE ORDER OF DEVICES ALONG A CRESNET CABLE MAY BE ALTERED AS REQUIRED FOR EASE OF INSTALLATION. MOVING OF DEVICES FROM ONE CRESNET CABLE TO ANOTHER MAY BE POSSIBLE, BUT PLEASE DO NOT MAKE SUCH ALTERATIONS WITHOUT DISCUSSIONS WITH YOUR CRESTRON PROJECT ENGINEER.

2. PLEASE PROVIDE LOCATIONS FOR ALL PANELS & CONTROL DEVICES SHOWN WITH A LOCATION CONTAINING "TBD".

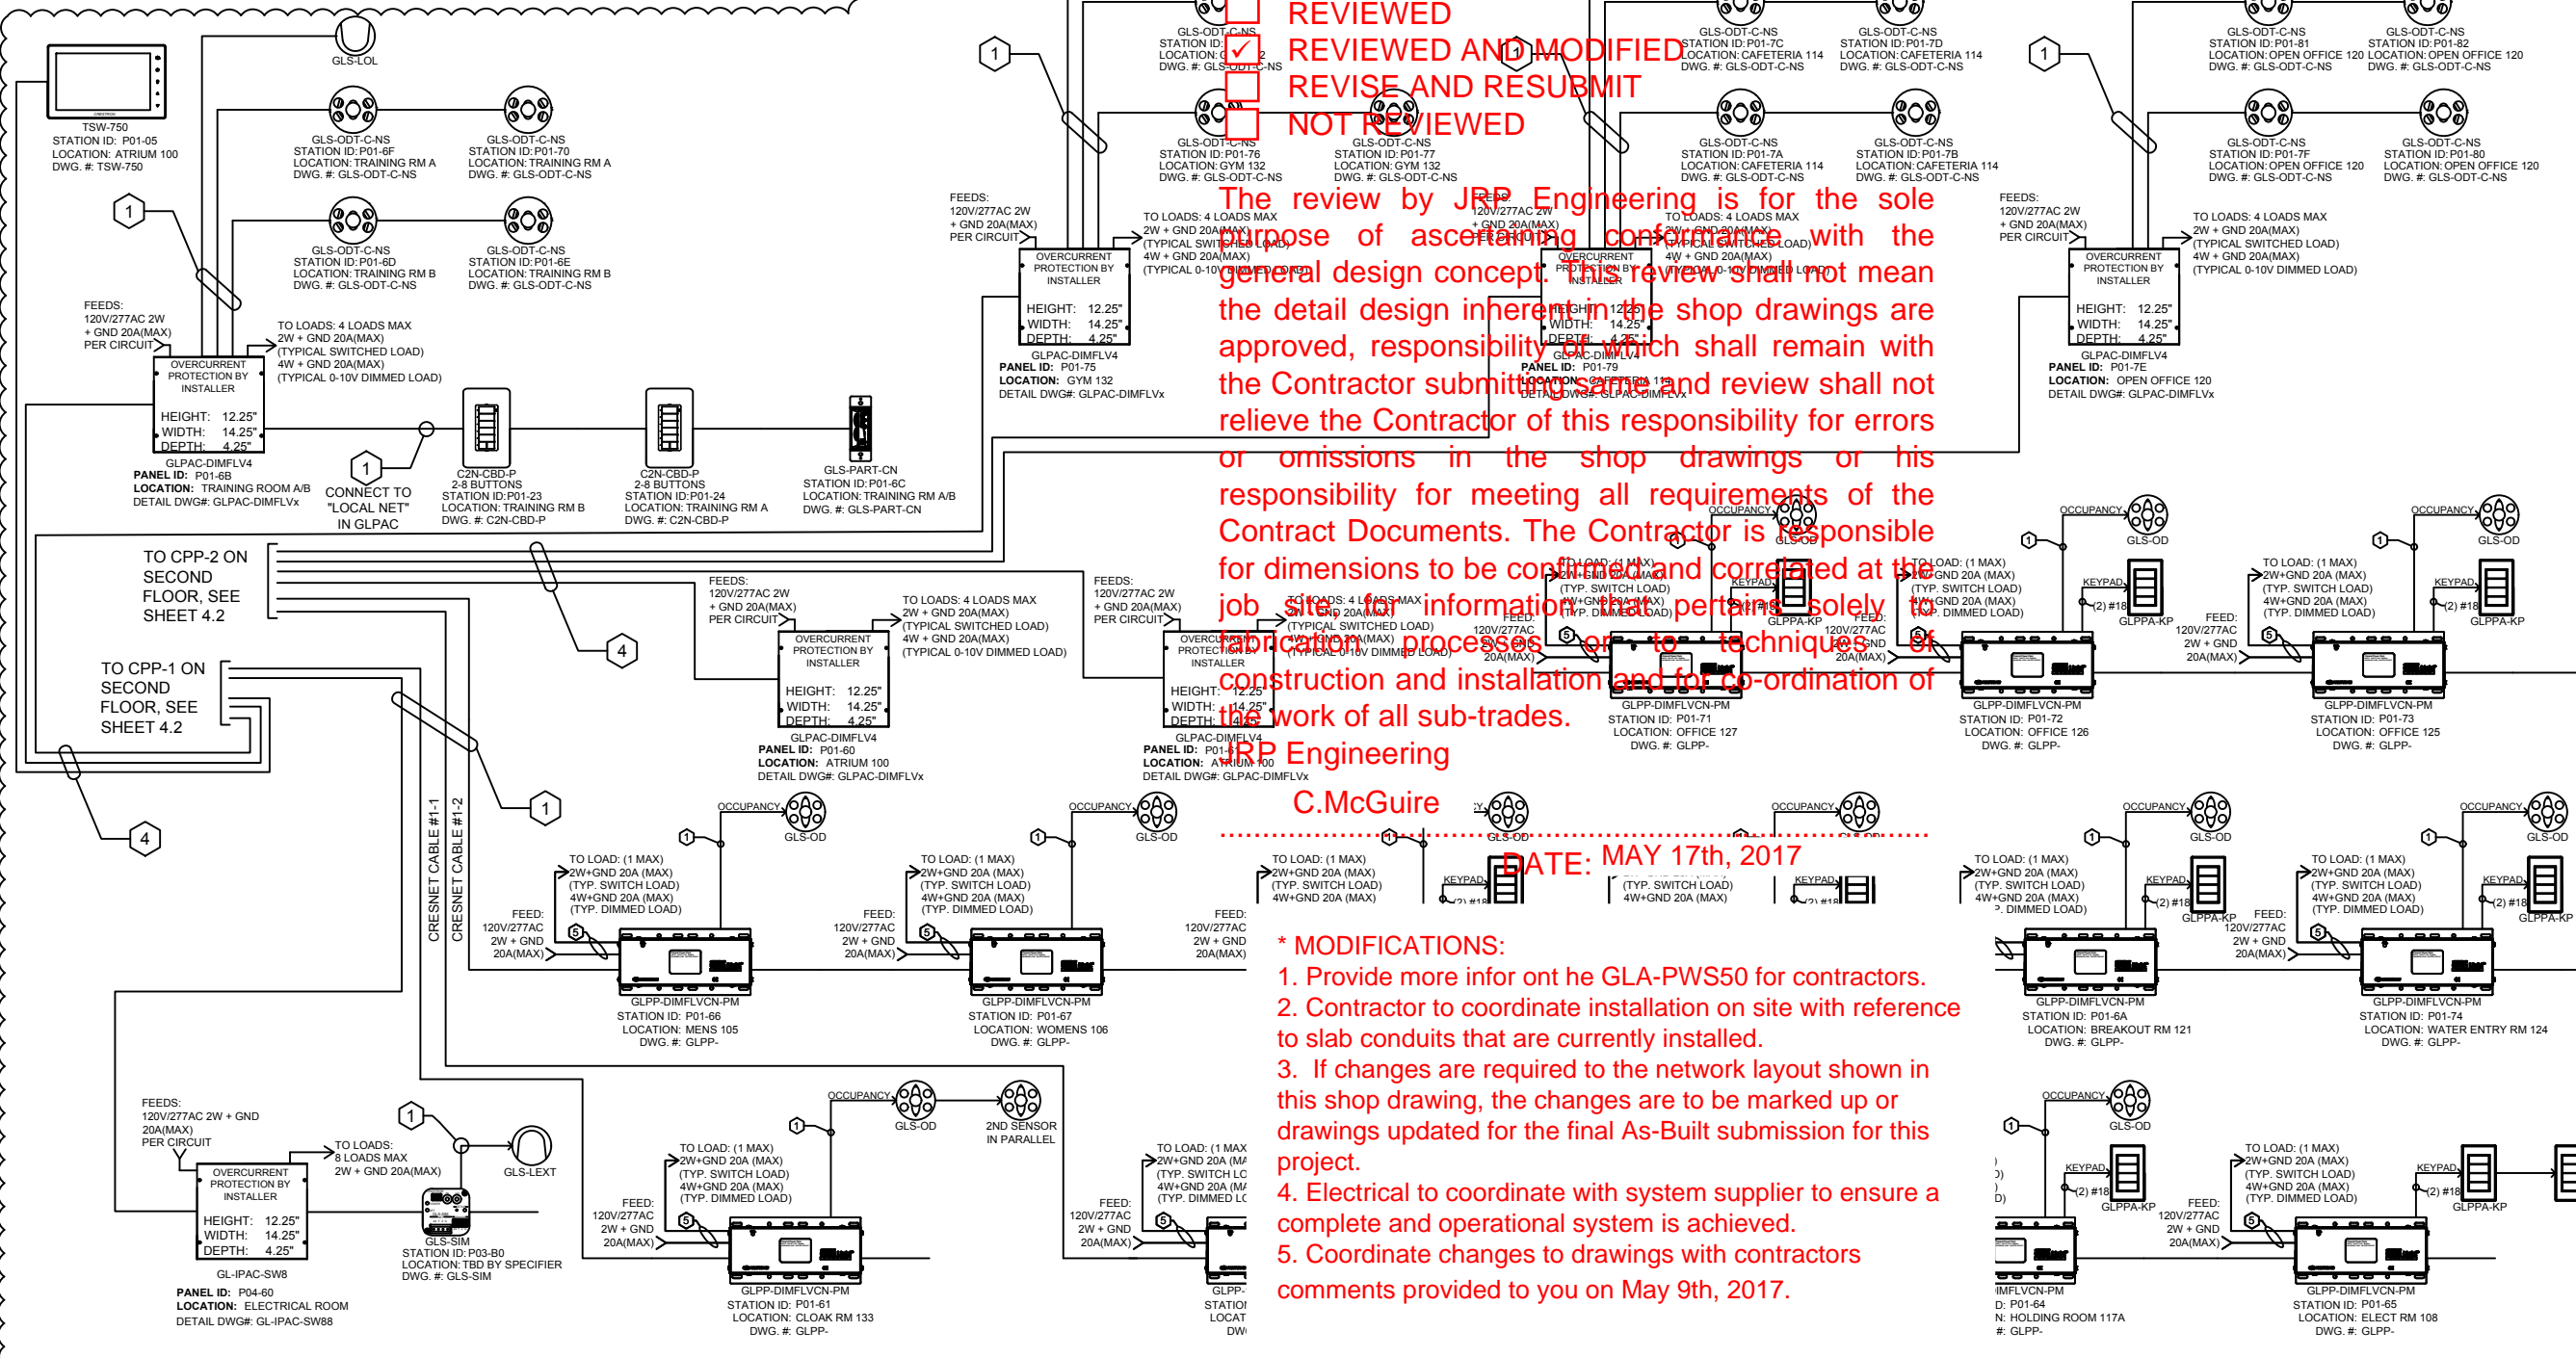

REVIEWED  
 REVIEWED AND MODIFIED  
 REVISE AND RESUBMIT  
 NOT REVIEWED

The review by J&P Engineering is for the sole purpose of ascertaining conformance with the general design concept. This review shall not mean the detail design inherent in the shop drawings are approved, responsibility of which shall remain with the Contractor submitting same, and review shall not relieve the Contractor of this responsibility for errors or omissions in the shop drawings or his responsibility for meeting all requirements of the Contract Documents. The Contractor is responsible for dimensions to be confirmed and correlated at the job site for information that pertains solely to application processes or techniques of construction and installation and for co-ordination of the work of all sub-trades.

J&P Engineering  
 C.McGuire  
 DATE: MAY 17th, 2017

- \* MODIFICATIONS:
1. Provide more info on the GLA-PWS50 for contractors.
  2. Contractor to coordinate installation on site with reference to slab conduits that are currently installed.
  3. If changes are required to the network layout shown in this shop drawing, the changes are to be marked up or drawings updated for the final As-Built submission for this project.
  4. Electrical to coordinate with system supplier to ensure a complete and operational system is achieved.
  5. Coordinate changes to drawings with contractors comments provided to you on May 9th, 2017.

CRESNET CABLE 1-2	
DEVICES	25
WATTS USED	0
MAX LENGTH*	1000
MIN VOLTS**	22V

CRESNET CABLE 1-1	
DEVICES	13
WATTS USED	0
MAX LENGTH*	1000
MIN VOLTS**	22V

**WIRE TYPES:** (NOT ALL TYPES ARE USED ON ALL PROJECTS)

① "CRESNET" CABLE:  
 (1) PAIR #18AWG,  
 (1) TWISTED PAIR 22AWG W/SHIELD (BY E.C.)  
 NON-PLENUM PN: CRESNET-NP-TL  
 PLENUM PN: CRESNET-P-TL

② RS-232 CABLE:  
 (1) TWISTED PAIR 22AWG  
 (1) SHIELD  
 DB-9 CONNECTOR (BY E.C.)

③ CABLE:  
 (1) TWISTED PAIR 18AWG  
 (1) SHIELD (BY E.C.)

④ CABLE:  
 CAT5E (OR GREATER) ETHERNET

⑤ SUITABLE GAUGE WIRE TO MEET LOAD REQUIREMENTS

ALL WIRE RUNS ARE TYPE 1, CRESNET, UNLESS OTHERWISE NOTED.

P = Cresnet Power usage of entire run

SEE CRESNET WIRING INSTRUCTIONS, DWG. 02.3, FOR FULL DETAILS.  
 LENGTH OF CRESNET WIRING RUNS ARE LIMITED TO # OF DEVICES AND CRESNET POWER DRAW. DAISY CHAIN AND OR STAR TOPOLOGIES ARE PERMITTED TO SUIT INSTALLATION NEEDS. EACH HOME RUN NOT TO EXCEED 20 CRESNET DEVICES. USE THE CALCULATOR SHOWN TO DETERMINE MAXIMUM WIRE RUN LENGTH. POWER SUPPLIES CAN BE ADDED TO INCREASE LENGTH OF HOME RUNS.

\*"MAX LENGTH" IS THE LENGTH, IN FEET, THAT MAY NOT BE EXCEEDED WITH CRESNET CABLE. USING CRESNET "HIGH-POWER" CABLE INCREASES THIS DISTANCE BY APPROXIMATELY 3.5 TIMES. DO NOT EXCEED 1000' WITHOUT DISCUSSING WITH THE PROJECT ENGINEER.

\*\*"MIN VOLTS" IS THE MINIMUM ALLOWABLE VOLTAGE WHEN MEASURED AT THE MOST DISTANT END OF THE CONTROL CABLE RUN.

ALL PHYSICAL DEVICE LOCATIONS TO BE COORDINATED WITH ARCHITECT.



PROJECT: TOMLINSON  
 LOCATION: CITIGATE, OTTAWA  
 ORDER #: 1841941  
 QUOTE #: 1048528  
 PO #: PURCHASE ORDER  
 SALES REP: BDA LIGHTING GROUP  
 DISTRIBUTOR: DISTRIBUTOR

**CRESTRON**  
 15 Volvo Drive  
 Rockleigh NJ 07647  
 Tel: 888-273-7876  
 Fax: 201-767-6011  
 www.crestron.com

TITLE:  
 GROUND FLOOR RISER DIAGRAM

DRAWING:  
 04.0

REV:03  
 DATE:4-21-17  
 DRAWN BY:SDL

NOTES:  
PLEASE SEE ALL ONE-LINE RISER NOTES ON SHEET 04.0

- REVIEWED
- REVIEWED AND MODIFIED
- REVISE AND RESUBMIT
- NOT REVIEWED


The review by JRP Engineering is for the sole purpose of ascertaining conformance with the general design concept. This review shall not mean the detail design inherent in the shop drawings are approved, responsibility of which shall remain with the Contractor submitting same and review shall not relieve the Contractor of this responsibility for errors or omissions in the shop drawings or his responsibility for meeting all requirements of the Contract Documents. The Contractor is responsible for dimensions to be confirmed and correlated at the job site, for information that pertains solely to fabrication processes or to techniques of construction and installation and for co-ordination of the work of all sub-trades.

JRP Engineering  
C.McGuire

DATE: MAY 17th, 2017

**\* MODIFICATIONS:**

1. Provide more info on the GLA-PWS50 for contractors.
2. Contractor to coordinate installation on site with reference to slab conduits that are currently installed.
3. If changes are required to the network layout shown in this shop drawing, the changes are to be marked up or drawings updated for the final As-Built submission for this project.
4. Electrical to coordinate with system supplier to ensure a complete and operational system is achieved.
5. Coordinate changes to drawings with contractors comments provided to you on May 9th, 2017.

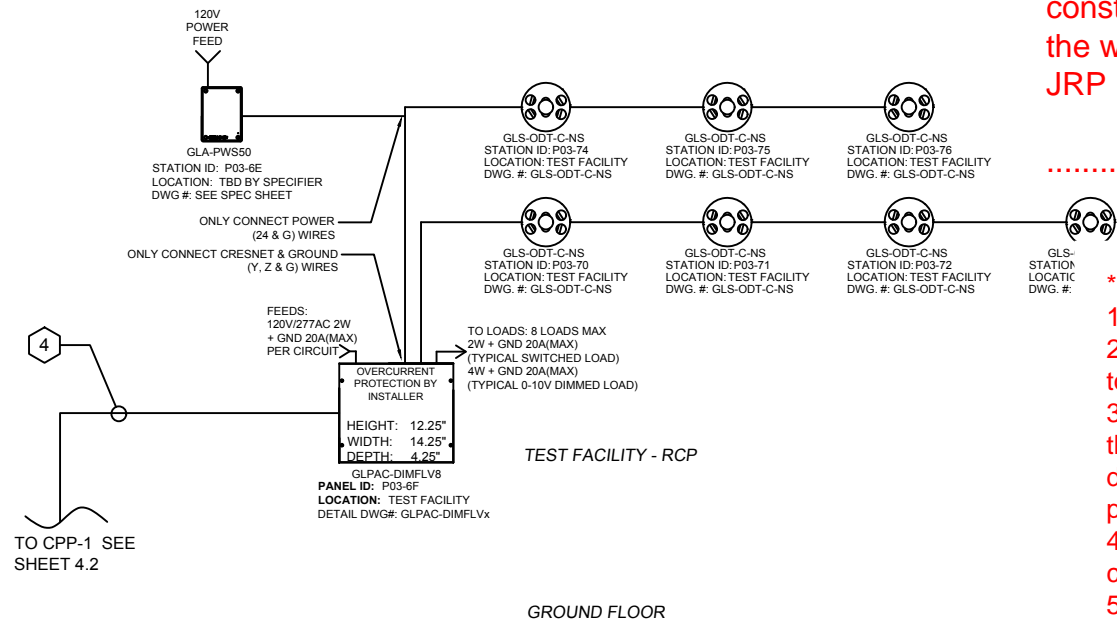

**WIRE TYPES:** (NOT ALL TYPES ARE USED ON ALL PROJECTS)

- |   |  |
|---|--|
| <p>1 "CRESNET" CABLE:<br/>(1) PAIR #18AWG,<br/>(1) TWISTED PAIR 22AWG<br/>W/SHIELD (BY E.C.)<br/>NON-PLENUM PN: CRESNET-NP-TL<br/>PLENUM PN: CRESNET-P-TL</p> | <p>3 CABLE:<br/>(1) TWISTED PAIR 18AWG<br/>(1) SHIELD<br/>(BY E.C.)</p>  |
| <p>2 RS-232 CABLE:<br/>(1) TWISTED PAIR 22AWG<br/>(1) SHIELD<br/>DB-9 CONNECTOR<br/>(BY E.C.)</p>   | <p>4 CABLE:<br/>CAT5E (OR GREATER)<br/>ETHERNET</p> <p>5 SUITABLE GAUGE WIRE<br/>TO MEET LOAD<br/>REQUIREMENTS</p> |

ALL WIRE RUNS ARE TYPE 1, CRESNET, UNLESS OTHERWISE NOTED.

**MAXIMUM CABLE LENGTH EQUATION:**

$$L < \frac{40,000}{R \times P}$$

Where L = Maximum Length of run in feet from power source  
R = 6 Ohms for Cresnet Certified wire or  
1.6 Ohms for Cresnet High Power Certified wire  
P = Cresnet Power usage of entire run

SEE CRESNET WIRING INSTRUCTIONS, DWG. 02.3, FOR FULL DETAILS.  
LENGTH OF CRESNET WIRING RUNS ARE LIMITED TO # OF DEVICES AND CRESNET POWER DRAW. DAISY CHAIN AND OR STAR TOPOLOGIES ARE PERMITTED TO SUIT INSTALLATION NEEDS. EACH HOME RUN NOT TO EXCEED 20 CRESNET DEVICES. USE THE CALCULATOR SHOWN TO DETERMINE MAXIMUM WIRE RUN LENGTH. POWER SUPPLIES CAN BE ADDED TO INCREASE LENGTH OF HOME RUNS.

\*"MAX LENGTH" IS THE LENGTH, IN FEET, THAT MAY NOT BE EXCEEDED WITH CRESNET CABLE. USING CRESNET "HIGH-POWER" CABLE INCREASES THIS DISTANCE BY APPROXIMATELY 3.5 TIMES. DO NOT EXCEED 1000' WITHOUT DISCUSSING WITH THE PROJECT ENGINEER.

\*\*"MIN VOLTS" IS THE MINIMUM ALLOWABLE VOLTAGE WHEN MEASURED AT THE MOST DISTANT END OF THE CONTROL CABLE RUN.

ALL PHYSICAL DEVICE LOCATIONS TO BE COORDINATED WITH ARCHITECT.




PROJECT: TOMLINSON	
LOCATION: CITIGATE, OTTAWA	ORDER #: 1841941
QUOTE #: 1048528	PO #: PURCHASE ORDER
SALES REP: BDA LIGHTING GROUP	
DISTRIBUTOR: DISTRIBUTOR	

**CRESTRON**  
15 Volvo Drive  
Rockleigh NJ 07647  
Tel: 888-273-7876  
Fax: 201-767-6011  
www.crestron.com

TITLE:  
TEST FACILITY  
RISER DIAGRAM

DRAWING:  
04.1  
REV:03  
DATE:4-21-17  
DRAWN BY:SDL

**NOTES:**  
PLEASE SEE ALL ONE-LINE RISER NOTES ON SHEET 04.0

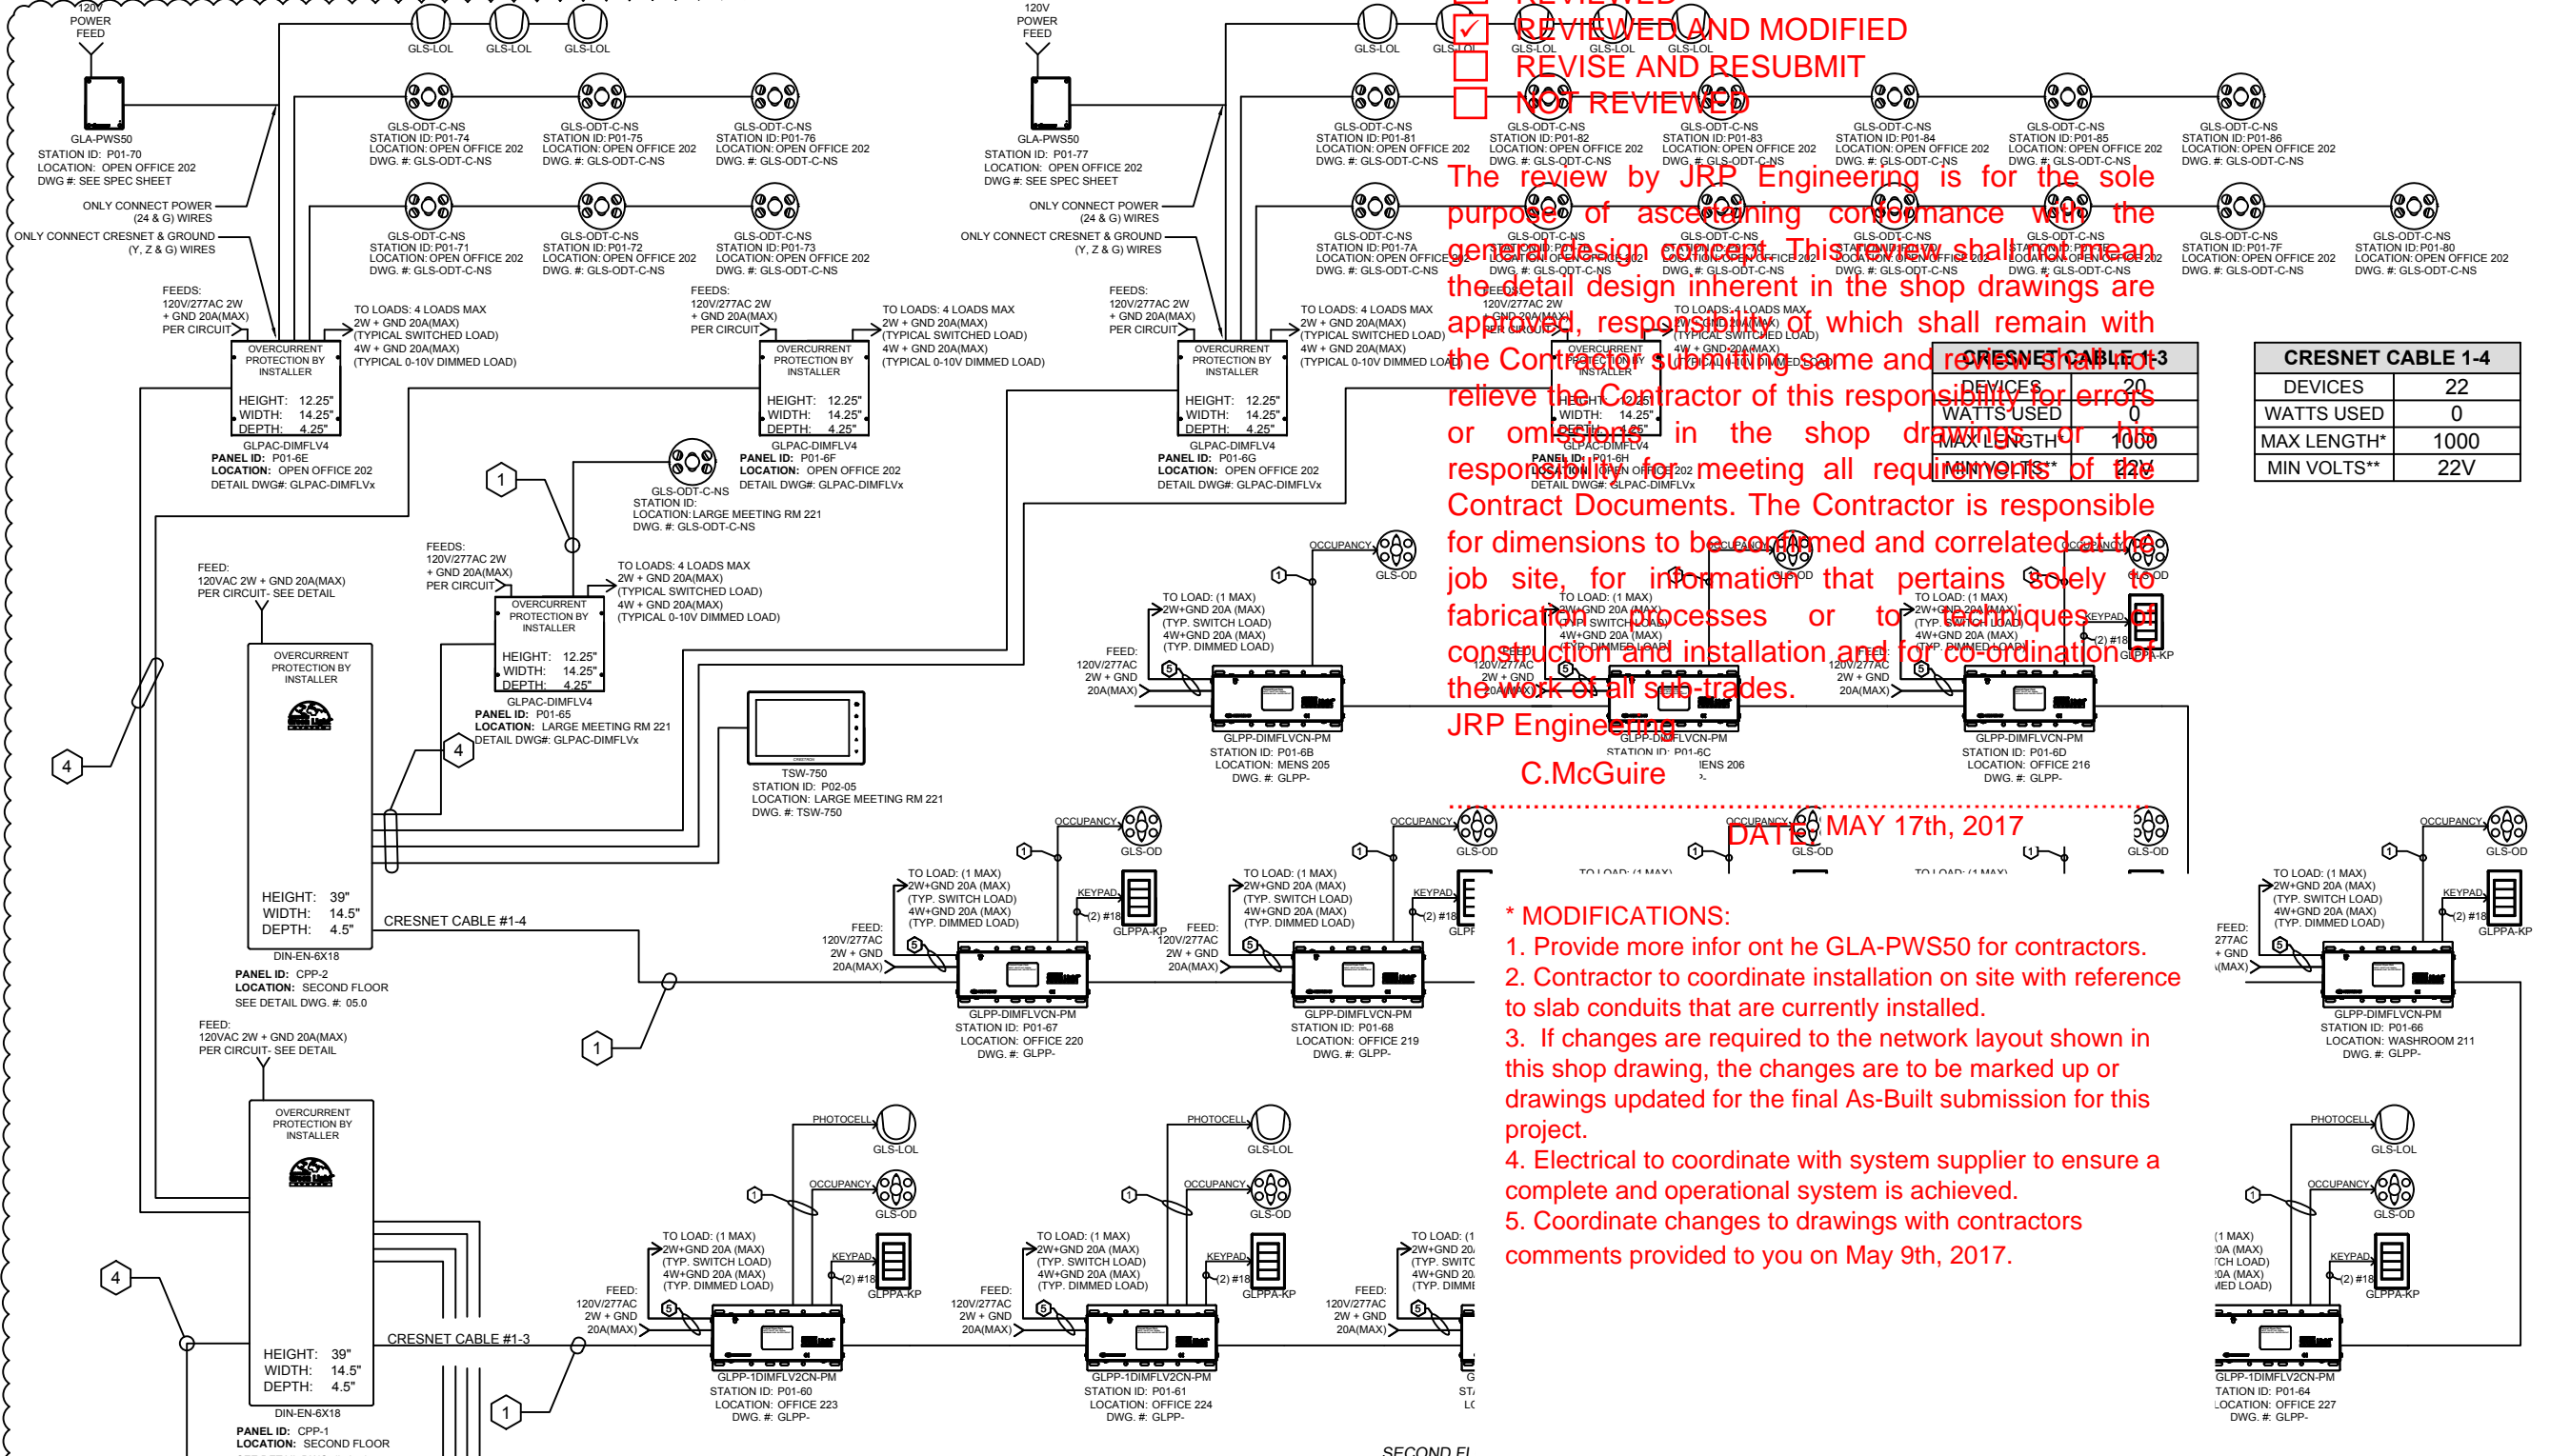

REVIEWED  
REVIEWED AND MODIFIED  
REVISE AND RESUBMIT  
NOT REVIEWED

The review by JRP Engineering is for the sole purpose of ascertaining conformance with the general design concept. This review shall not mean the detail design inherent in the shop drawings are approved, responsibility of which shall remain with the Contractor submitting same and review shall not relieve the Contractor of this responsibility for errors or omissions in the shop drawings or the responsibility of meeting all requirements of the Contract Documents. The Contractor is responsible for dimensions to be confirmed and correlated at the job site, for information that pertains solely to fabrication processes or to techniques of construction and installation and for coordination with the work of all sub-trades.

JRP Engineering  
C.McGuire  
DATE: MAY 17th, 2017

- \* MODIFICATIONS:
1. Provide more info on the GLA-PWS50 for contractors.
  2. Contractor to coordinate installation on site with reference to slab conduits that are currently installed.
  3. If changes are required to the network layout shown in this shop drawing, the changes are to be marked up or drawings updated for the final As-Built submission for this project.
  4. Electrical to coordinate with system supplier to ensure a complete and operational system is achieved.
  5. Coordinate changes to drawings with contractors comments provided to you on May 9th, 2017.

DEVICES	20
WATTS USED	0
MAX LENGTH*	1000
MIN VOLTS**	22V

DEVICES	22
WATTS USED	0
MAX LENGTH*	1000
MIN VOLTS**	22V

**WIRE TYPES:** (NOT ALL TYPES ARE USED ON ALL PROJECTS)

- 1 "CRESNET" CABLE:  
(1) PAIR #18AWG,  
(1) TWISTED PAIR 22AWG  
W/SHIELD (BY E.C.)  
NON-PLENUM PN: CRESNET-NP-TL  
PLENUM PN: CRESNET-P-TL
- 2 RS-232 CABLE:  
(1) TWISTED PAIR 22AWG  
(1) SHIELD  
DB-9 CONNECTOR  
(BY E.C.)
- 3 CABLE:  
(1) TWISTED PAIR 18AWG  
(1) SHIELD  
(BY E.C.)
- 4 CABLE:  
CAT5E (OR GREATER)  
ETHERNET
- 5 SUITABLE GAUGE WIRE  
TO MEET LOAD  
REQUIREMENTS

**MAXIMUM CABLE LENGTH EQUATION:**

$$L < \frac{40,000}{R \times P}$$

Where L = Maximum Length of run in feet from power source  
R = 6 Ohms for Cresnet Certified wire or 1.6 Ohms for Cresnet High Power Certified wire  
P = Cresnet Power usage of entire run

SEE CRESNET WIRING INSTRUCTIONS, DWG. 02.3, FOR FULL DETAILS.  
LENGTH OF CRESNET WIRING RUNS ARE LIMITED TO # OF DEVICES AND CRESNET POWER DRAW. DAISY CHAIN AND OR STAR TOPOLOGIES ARE PERMITTED TO SUIT INSTALLATION NEEDS. EACH HOME RUN NOT TO EXCEED 20 CRESNET DEVICES. USE THE CALCULATOR SHOWN TO DETERMINE MAXIMUM WIRE RUN LENGTH. POWER SUPPLIES CAN BE ADDED TO INCREASE LENGTH OF HOME RUNS.

\*LENGTH IS THE LENGTH, IN FEET, THAT MAY NOT BE EXCEEDED WITH CRESNET CABLE. USING CRESNET "HIGH-POWER" CABLE INCREASES THIS DISTANCE BY APPROXIMATELY 3.5 TIMES. DO NOT EXCEED 1000' WITHOUT DISCUSSING WITH THE PROJECT ENGINEER.

\*\*"MIN VOLTS" IS THE MINIMUM ALLOWABLE VOLTAGE WHEN MEASURED AT THE MOST DISTANT END OF THE CONTROL CABLE RUN.

ALL PHYSICAL DEVICE LOCATIONS TO BE COORDINATED WITH ARCHITECT.




PROJECT: TOMLINSON  
LOCATION: CITIGATE, OTTAWA  
QUOTE #: 1048528  
SALES REP: BDA LIGHTING GROUP  
DISTRIBUTOR: DISTRIBUTOR

**CRESTRON**  
15 Volvo Drive  
Rockleigh NJ 07647  
Tel: 888-273-7876  
Fax: 201-767-6011  
www.crestron.com

TITLE:  
SECOND FLOOR  
RISER DIAGRAM  
DRAWING:  
04.2  
REV:03  
DATE:4-21-17  
DRAWN BY:SDL

**NOTES:**  
PLEASE SEE ALL ONE-LINE RISER NOTES ON SHEET 04.0

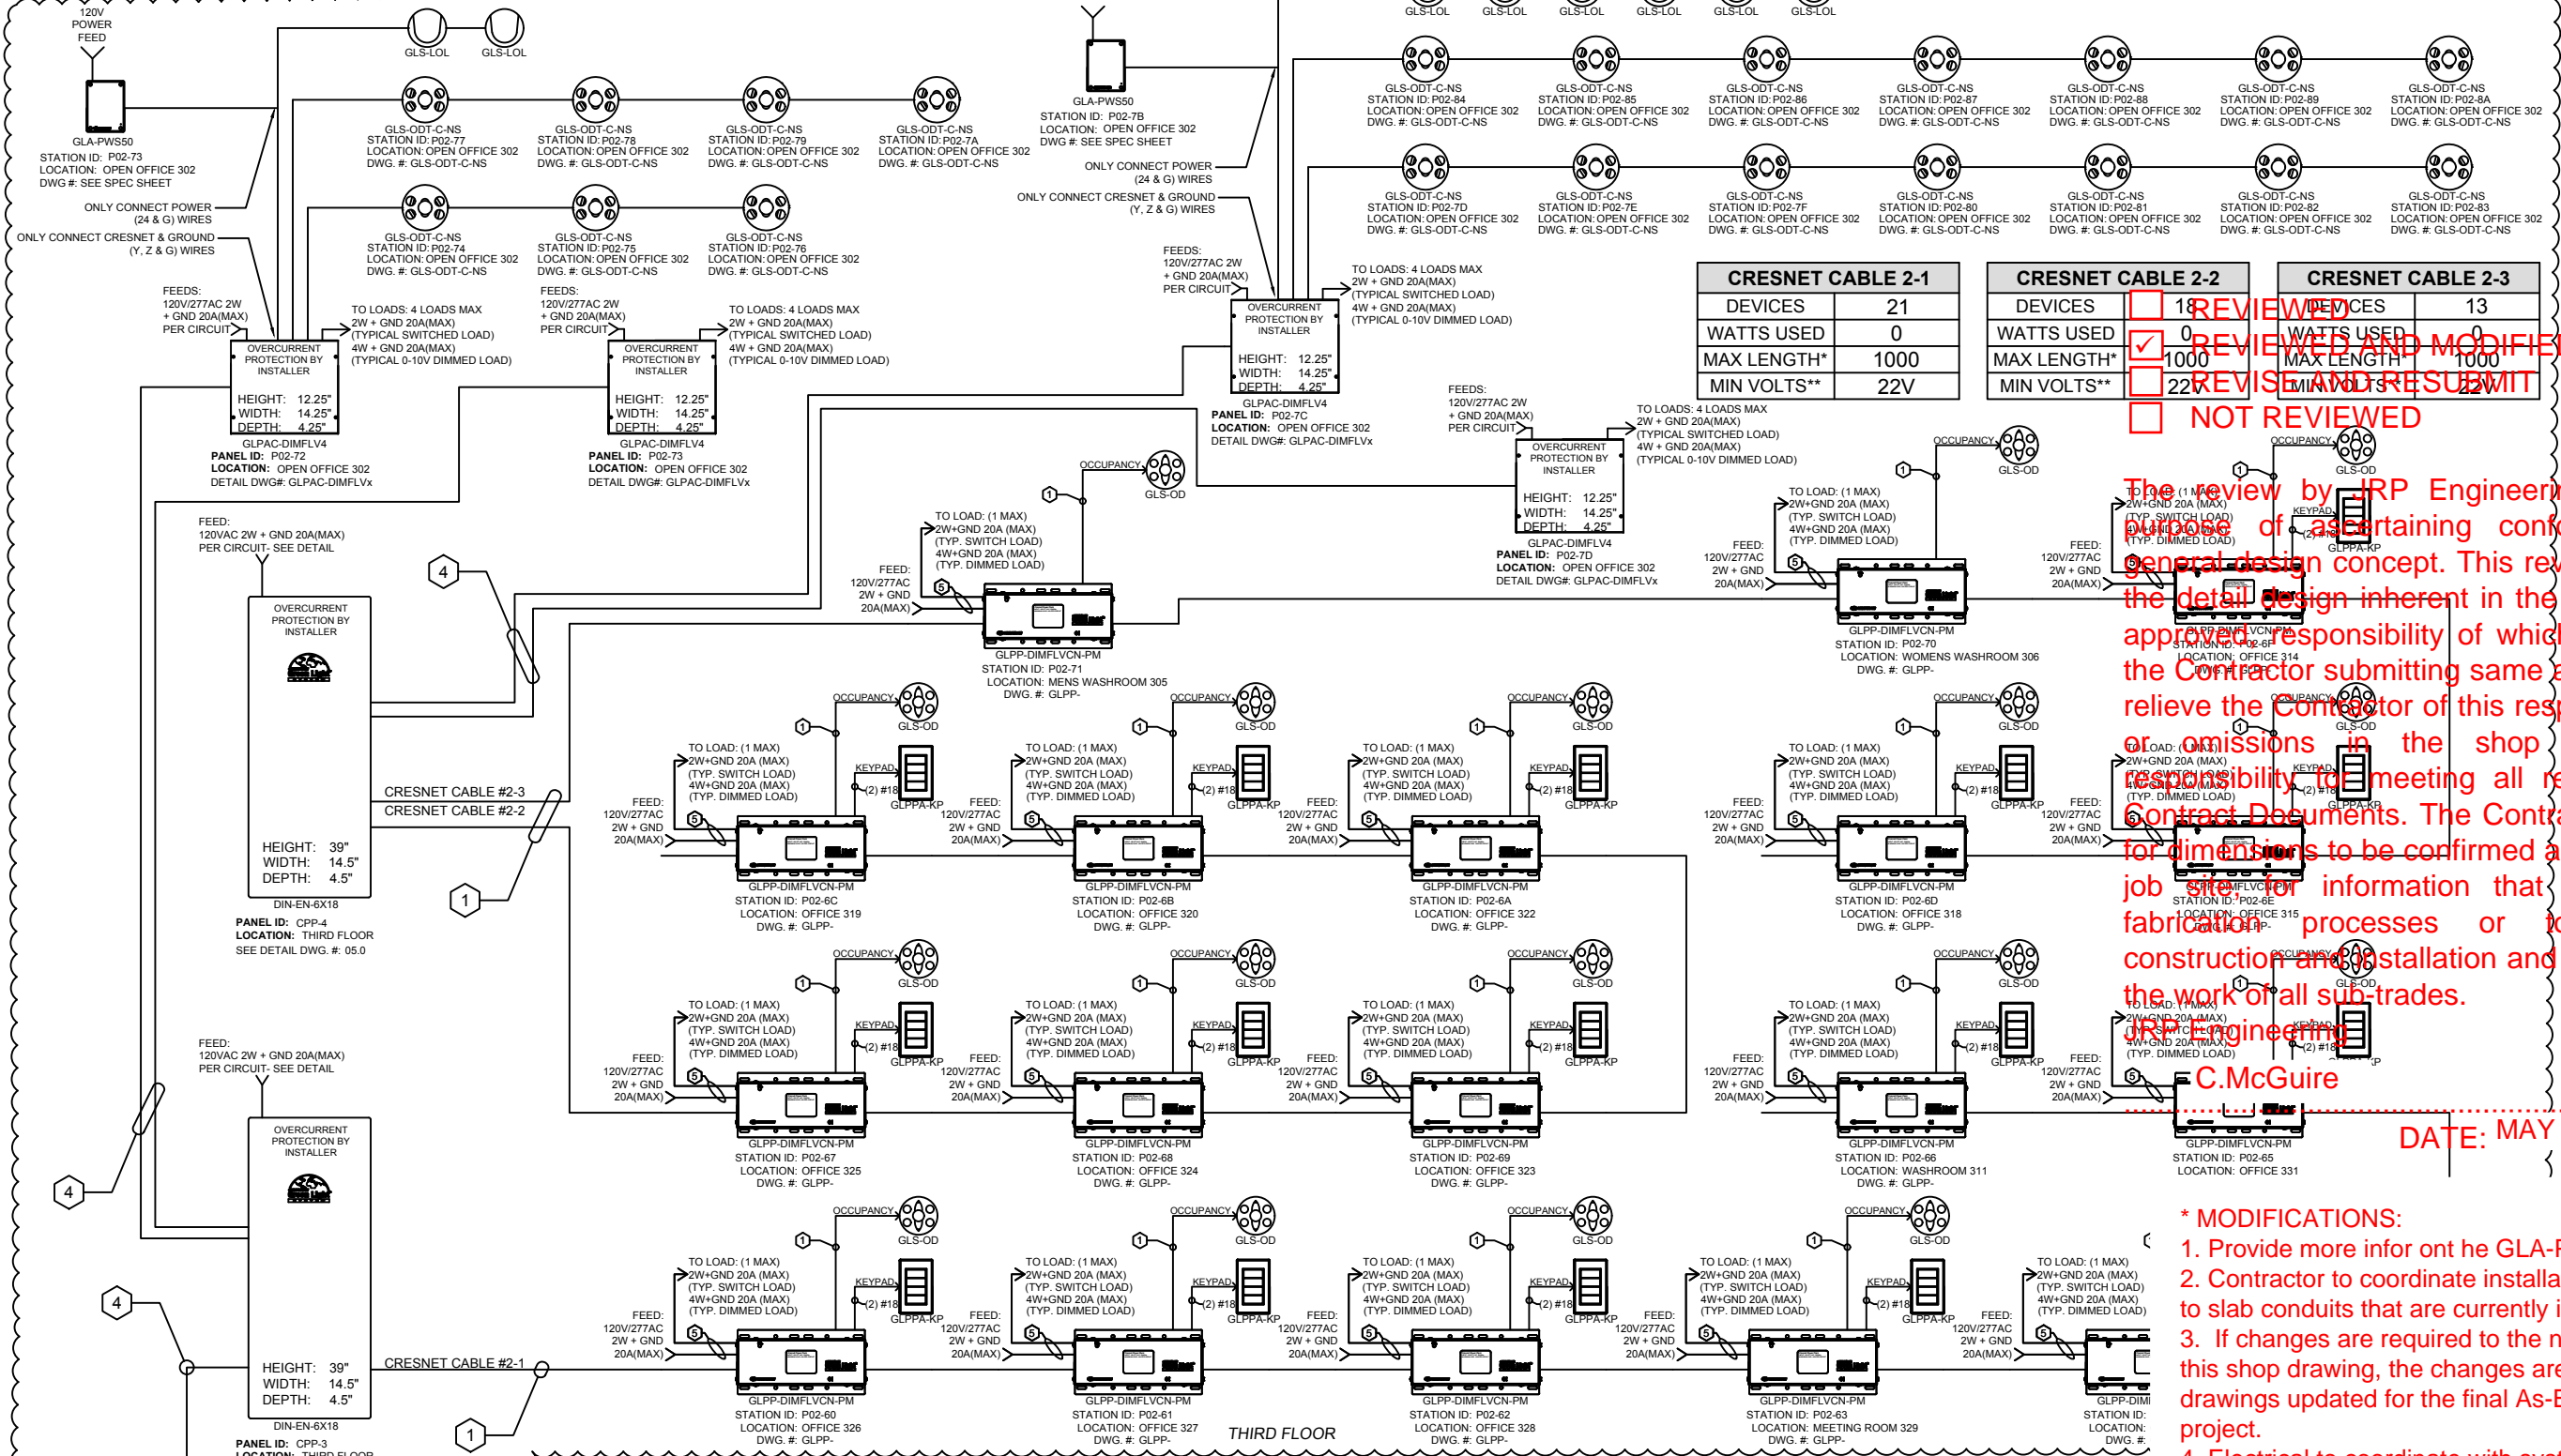

CRESNET CABLE 2-1		CRESNET CABLE 2-2		CRESNET CABLE 2-3	
DEVICES	21	DEVICES	18	DEVICES	13
WATTS USED	0	WATTS USED	0	WATTS USED	0
MAX LENGTH*	1000	MAX LENGTH*	1000	MAX LENGTH*	1000
MIN VOLTS**	22V	MIN VOLTS**	22V	MIN VOLTS**	22V

The review by JRP Engineering is for the sole purpose of ascertaining conformance with the general design concept. This review shall not mean the detail design inherent in the shop drawings are appropriate responsibility of which shall remain with the Contractor submitting same and review shall not relieve the Contractor of this responsibility or errors or omissions in the shop drawings or no responsibility to meeting all requirements of the Contract Documents. The Contractor is responsible for dimensions to be confirmed and correlated at the job site for information that pertains solely to fabrication processes or to techniques of construction and installation and for coordination of the work of all sub-trades.

JRP Engineering  
C.McGuire

DATE: MAY 17th, 2017

- WIRE TYPES:** (NOT ALL TYPES ARE USED ON ALL PROJECTS)
- 1 "CRESNET" CABLE:  
(1) PAIR #18AWG,  
(1) TWISTED PAIR 22AWG  
W/SHIELD (BY E.C.)  
NON-PLENUM PN: CRESNET-NP-TL  
PLENUM PN: CRESNET-P-TL
  - 2 RS-232 CABLE:  
(1) TWISTED PAIR 22AWG  
(1) SHIELD  
DB-9 CONNECTOR  
(BY E.C.)
  - 3 CABLE:  
(1) TWISTED PAIR 18AWG  
(1) SHIELD  
(BY E.C.)
  - 4 CABLE:  
CAT5E (OR GREATER)  
ETHERNET
  - 5 SUITABLE GAUGE WIRE  
TO MEET LOAD  
REQUIREMENTS

**MAXIMUM CABLE LENGTH EQUATION:**

$$L < \frac{40,000}{R \times P}$$

Where L = Maximum Length of run in feet from power source  
R = 6 Ohms for Cresnet Certified wire or 1.6 Ohms for Cresnet High Power Certified wire  
P = Cresnet Power usage of entire run

SEE CRESNET WIRING INSTRUCTIONS, DWG. 02.3, FOR FULL DETAILS.

LENGTH OF CRESNET WIRING RUNS ARE LIMITED TO # OF DEVICES AND CRESNET POWER DRAW. DAISY CHAIN AND OR STAR TOPOLOGIES ARE PERMITTED TO SUIT INSTALLATION NEEDS. EACH HOME RUN NOT TO EXCEED 20 CRESNET DEVICES. USE THE CALCULATOR SHOWN TO DETERMINE MAXIMUM WIRE RUN LENGTH. POWER SUPPLIES CAN BE ADDED TO INCREASE LENGTH OF HOME RUNS.

- \* MODIFICATIONS:
1. Provide more info on the GLA-PWS50 for contractors.
  2. Contractor to coordinate installation on site with reference to slab conduits that are currently installed.
  3. If changes are required to the network layout shown in this shop drawing, the changes are to be marked up or drawings updated for the final As-Built submission for this project.
  4. Electrical to coordinate with system supplier to ensure a complete and operational system is achieved.
  5. Coordinate changes to drawings with contractors comments provided to you on May 9th, 2017.

\*\*MAX  
MAY N  
USING  
INCRE  
3.5 TI  
DISCU

\*\*MIN  
VOLT/  
DISTA




PROJECT: TOLLISON  
LOCATION: DIGITAL CENTER  
QUOTE # 18220  
SALES REP: BAILEY GIBBS  
DISTRIBUTOR: TIBBETTS

ORDER #: 1841941  
PRC: PRC/IAE/ORDER

TO BUILDING LAN FOR  
ETHERNET COMMUNICATION  
(FBO)  
FOR INTERSYSTEM COMMUNICATIONS  
REMOTE & LOCAL PROGRAM UPLOADS  
& BMS INTEGRATION

ALL WIRE RUNS ARE TYPE 1, CRESNET, UNLESS OTHERWISE NOTED.

NOTES:  
PLEASE SEE ALL ONE-LINE RISER NOTES ON SHEET 04.0

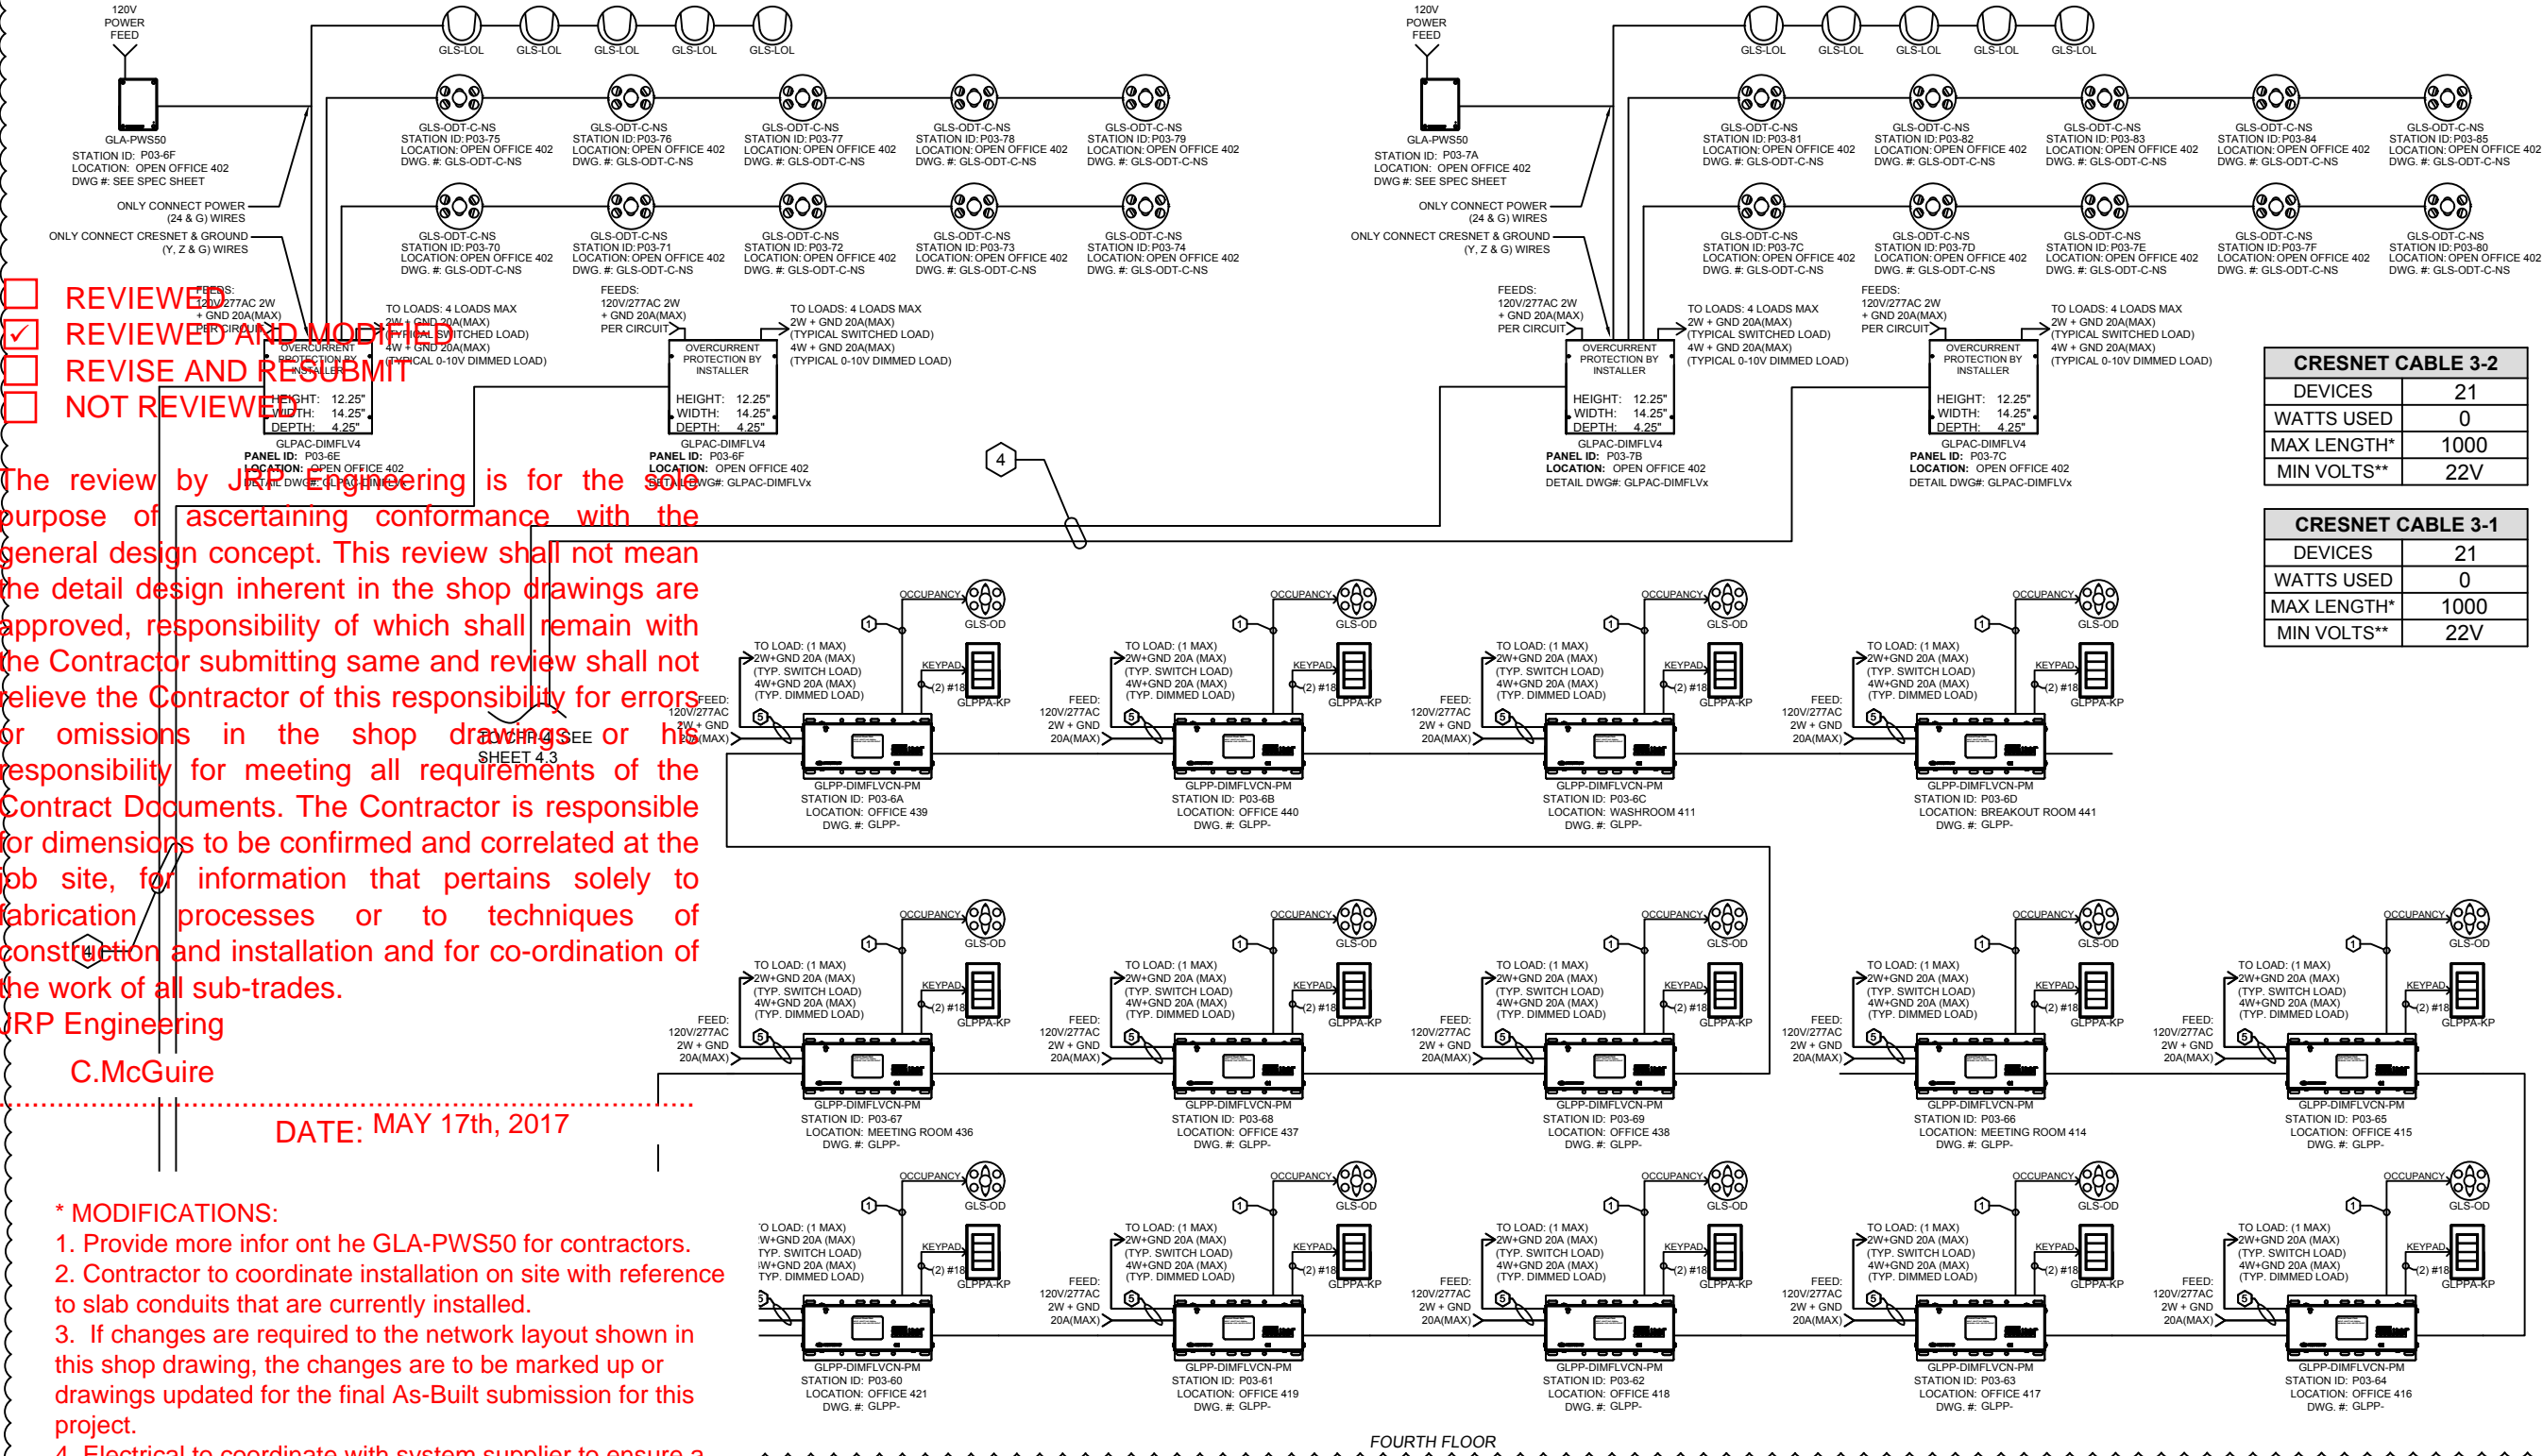

- REVIEWED
- REVIEWED AND MODIFIED
- REVISE AND RESUBMIT
- NOT REVIEWED

The review by JRP Engineering is for the sole purpose of ascertaining conformance with the general design concept. This review shall not mean the detail design inherent in the shop drawings are approved, responsibility of which shall remain with the Contractor submitting same and review shall not relieve the Contractor of this responsibility for errors or omissions in the shop drawings or his responsibility for meeting all requirements of the Contract Documents. The Contractor is responsible for dimensions to be confirmed and correlated at the job site, for information that pertains solely to fabrication processes or to techniques of construction and installation and for co-ordination of the work of all sub-trades.

JRP Engineering  
C.McGuire

DATE: MAY 17th, 2017

\* MODIFICATIONS:

1. Provide more information on the GLA-PWS50 for contractors.
2. Contractor to coordinate installation on site with reference to slab conduits that are currently installed.
3. If changes are required to the network layout shown in this shop drawing, the changes are to be marked up or drawings updated for the final As-Built submission for this project.
4. Electrical to coordinate with system supplier to ensure a complete and operational system is achieved.
5. Coordinate changes to drawings with contractors comments provided to you on May 9th, 2017.

(NOT ALL TYPES ARE USED ON ALL PROJECTS)

- ABLE: WG, PAIR 22AWG (E.C.) LPN: CRESNET-NP-TL CRESNET-P-TL
- 3 CABLE: (1) TWISTED PAIR 18AWG (1) SHIELD (BY E.C.)
- 4 CABLE: CAT5E (OR GREATER) ETHERNET
- 5 SUITABLE GAUGE WIRE TO MEET LOAD REQUIREMENTS

**MAXIMUM CABLE LENGTH EQUATION:**

$$L < \frac{40,000}{R \times P}$$

Where L = Maximum Length of run in feet from power source  
R = 6 Ohms for Cresnet Certified wire or 1.6 Ohms for Cresnet High Power Certified wire  
P = Cresnet Power usage of entire run

SEE CRESNET WIRING INSTRUCTIONS, DWG. 02.3, FOR FULL DETAILS. LENGTH OF CRESNET WIRING RUNS ARE LIMITED TO # OF DEVICES AND CRESNET POWER DRAW. DAISY CHAIN AND OR STAR TOPOLOGIES ARE PERMITTED TO SUIT INSTALLATION NEEDS. EACH HOME RUN NOT TO EXCEED 20 CRESNET DEVICES. USE THE CALCULATOR SHOWN TO DETERMINE MAXIMUM WIRE RUN LENGTH. POWER SUPPLIES CAN BE ADDED TO INCREASE LENGTH OF HOME RUNS.

CRESNET CABLE 3-2	
DEVICES	21
WATTS USED	0
MAX LENGTH*	1000
MIN VOLTS**	22V

CRESNET CABLE 3-1	
DEVICES	21
WATTS USED	0
MAX LENGTH*	1000
MIN VOLTS**	22V

FOURTH FLOOR



PROJECT: TOMLINSON  
LOCATION: CITIGATE, OTTAWA  
QUOTE #: 1048528  
SALES REP: BDA LIGHTING GROUP  
DISTRIBUTOR: DISTRIBUTOR

**CRESTRON**  
15 Volvo Drive  
Rockleigh NJ 07647  
Tel: 888-273-7876  
Fax: 201-767-6011  
www.crestron.com

TITLE:  
FOURTH FLOOR  
RISER DIAGRAM  
DRAWING:  
04.4  
REV:03  
DATE:4-21-17  
DRAWN BY:SDL

\*"MAX LENGTH" IS THE LENGTH, IN FEET, THAT MAY NOT BE EXCEEDED WITH CRESNET CABLE. USING CRESNET "HIGH-POWER" CABLE INCREASES THIS DISTANCE BY APPROXIMATELY 3.5 TIMES. DO NOT EXCEED 1000' WITHOUT DISCUSSING WITH THE PROJECT ENGINEER.

\*\*"MIN VOLTS" IS THE MINIMUM ALLOWABLE VOLTAGE WHEN MEASURED AT THE MOST DISTANT END OF THE CONTROL CABLE RUN.

ALL PHYSICAL DEVICE LOCATIONS TO BE COORDINATED WITH ARCHITECT.

NOTES:  
PLEASE SEE ALL ONE-LINE RISER NOTES ON SHEET 04.0

CRESNET CABLE 3-3		CRESNET CABLE 3-4		CRESNET CABLE 3-5	
DEVICES	21	DEVICES	21	DEVICES	7
WATTS USED	0	WATTS USED	0	WATTS USED	0
MAX LENGTH*	1000	MAX LENGTH*	1000	MAX LENGTH*	1000
MIN VOLTS**	22V	MIN VOLTS**	22V	MIN VOLTS**	22V

- REVIEWED
- REVIEWED AND MODIFIED
- REVISE AND RESUBMIT
- NOT REVIEWED


The review by JRP Engineering is for the sole purpose of ascertaining conformance with the general design concept. This review shall not mean the detail design inherent in the shop drawings are approved, responsibility of which shall remain with the Contractor submitting same and review shall not relieve the Contractor of this responsibility for errors or omissions in the shop drawings or his responsibility for meeting all requirements of the Contract Documents. The Contractor is responsible for dimensions to be confirmed and correlated at the job site, for information that pertains solely to fabrication processes or to techniques of construction and installation and for co-ordination of the work of all sub-trades.

JRP Engineering  
C.McGuire

DATE: MAY 17th, 2017

\* MODIFICATIONS:

1. Provide more info on the GLA-PWS50 for contractors.
2. Contractor to coordinate installation on site with reference to slab conduits that are currently installed.
3. If changes are required to the network layout shown in this shop drawing, the changes are to be marked up or drawings updated for the final As-Built submission for this project.
4. Electrical to coordinate with system supplier to ensure a complete and operational system is achieved.
5. Coordinate changes to drawings with contractors comments provided to you on May 9th, 2017.

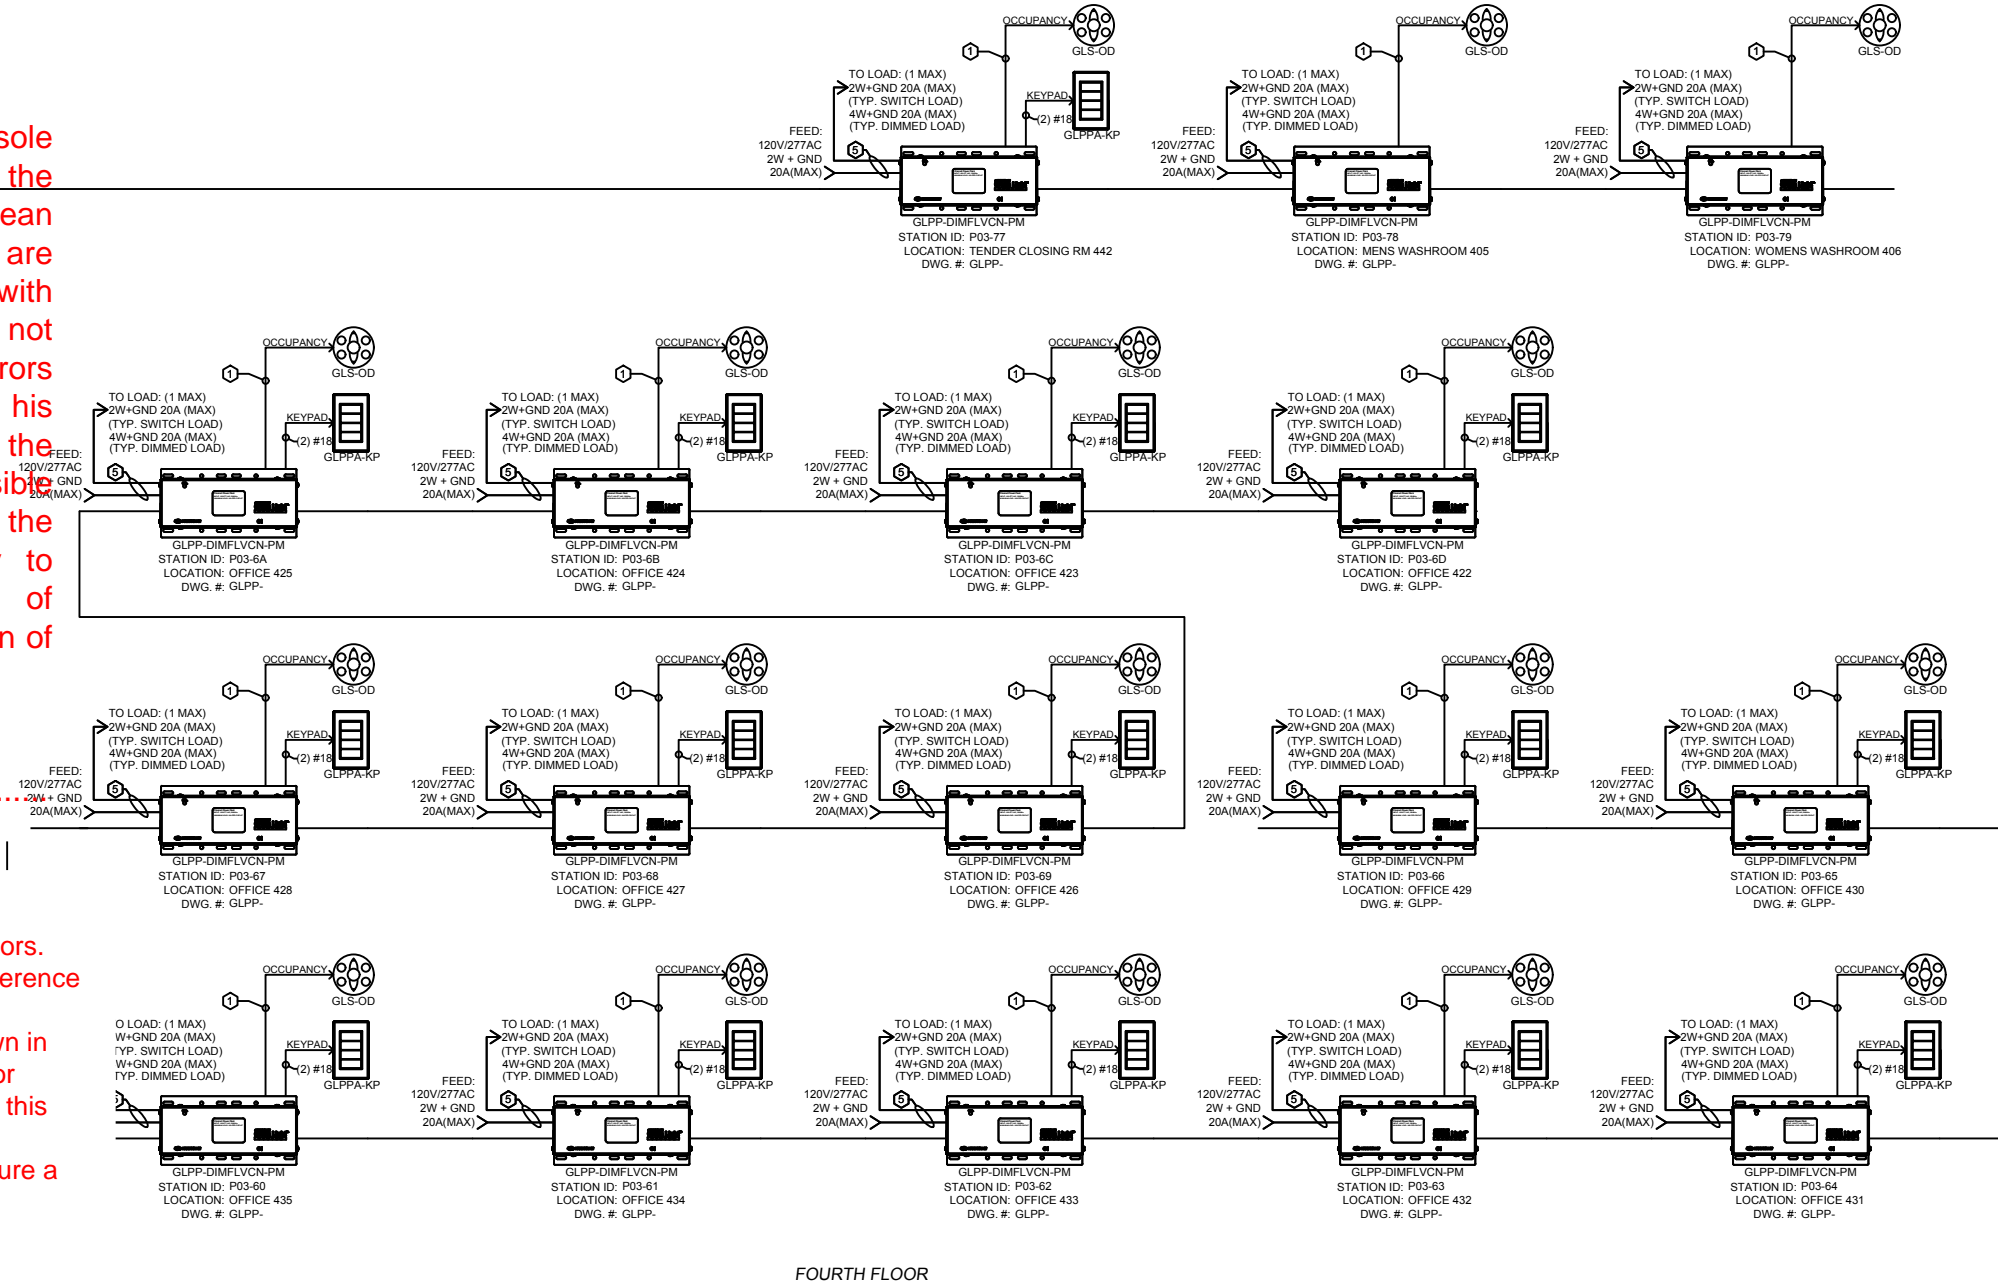

FOURTH FLOOR

S: (NOT ALL TYPES ARE USED ON ALL PROJECTS)

T\* CABLE:  
#18AWG,  
ED PAIR 22AWG  
(BY E.C.)  
NUM.PN: CRESNET-NP-TL  
PN: CRESNET-P-TL

2 (1) TWISTED PAIR 22AWG  
(1) SHIELD  
DB-9 CONNECTOR  
(BY E.C.)

ALL WIRE RUNS ARE TYPE 1, CRESNET, UNLESS OTHERWISE NOTED.

3 CABLE:  
(1) TWISTED PAIR 18AWG  
(1) SHIELD  
(BY E.C.)

4 CABLE:  
CAT5E (OR GREATER)  
ETHERNET

5 SUITABLE GAUGE WIRE  
TO MEET LOAD  
REQUIREMENTS

MAXIMUM CABLE LENGTH EQUATION:

$$L < \frac{40,000}{R \times P}$$

Where L = Maximum Length of run in feet from power source  
R = 6 Ohms for Cresnet Certified wire or  
1.6 Ohms for Cresnet High Power Certified wire  
P = Cnesnet Power usage of entire run

SEE CRESNET WIRING INSTRUCTIONS, DWG. 02.3, FOR FULL DETAILS.

LENGTH OF CRESNET WIRING RUNS ARE LIMITED TO # OF DEVICES AND CRESNET POWER DRAW. DAISY CHAIN AND OR STAR TOPOLOGIES ARE PERMITTED TO SUIT INSTALLATION NEEDS. EACH HOME RUN NOT TO EXCEED 20 CRESNET DEVICES. USE THE CALCULATOR SHOWN TO DETERMINE MAXIMUM WIRE RUN LENGTH. POWER SUPPLIES CAN BE ADDED TO INCREASE LENGTH OF HOME RUNS.

\*\*"MAX LENGTH" IS THE LENGTH, IN FEET, THAT MAY NOT BE EXCEEDED WITH CRESNET CABLE. USING CRESNET "HIGH-POWER" CABLE INCREASES THIS DISTANCE BY APPROXIMATELY 3.5 TIMES. DO NOT EXCEED 1000' WITHOUT DISCUSSING WITH THE PROJECT ENGINEER.

\*\*\*"MIN VOLTS" IS THE MINIMUM ALLOWABLE VOLTAGE WHEN MEASURED AT THE MOST DISTANT END OF THE CONTROL CABLE RUN.

ALL PHYSICAL DEVICE LOCATIONS TO BE COORDINATED WITH ARCHITECT.



PROJECT: TOMLINSON  
LOCATION: CITIGATE, OTTAWA  
QUOTE #: 1048528  
SALES REP: BDA LIGHTING GROUP  
DISTRIBUTOR: DISTRIBUTOR


15 Volvo Drive  
Rockleigh NJ 07647  
Tel: 888-273-7876  
Fax: 201-767-6011  
www.crestron.com

TITLE:  
FOURTH FLOOR  
RISER DIAGRAM  
CONT'D  
DRAWING:  
04.5  
REV:03  
DATE:4-21-17  
DRAWN BY:SDL

**CRESNET CONTROL WIRING**

TO LAST CONTROL STATION, PROCESSOR, OR CRESNET DEVICE. (SEE CONTROL RISER) ←

→ TO NEXT CONTROL STATION, PROCESSOR, OR CRESNET DEVICE. (SEE CONTROL RISER)

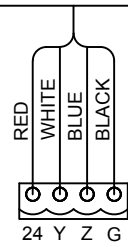

**GENERAL NOTES**

- DO NOT POWER UP SYSTEM UNTIL ALL WIRING IS VERIFIED. CARE SHOULD BE TAKEN TO ENSURE DATA (Y,Z) AND POWER (24,G) CONNECTIONS ARE NOT CROSSED.
- GROUND SHIELD AT CONTROL SYSTEM END ONLY.
- GENUINE CRESNET CONTROL CABLE IS RECOMMENDED FOR CONNECTION OF CRESTRON COMMERCIAL LIGHTING SYSTEMS.
- KEEP ALL CLASS 1 POWER WIRING SEPERATED FROM ALL CLASS 2 CONTROL WIRING WITHIN THE CABINET
- THIS PANEL REQUIRES POWER & OVERCURRENT PROTECTION FROM AN EXTERNAL BREAKER PANEL (F.B.O.). IT IS RECOMMENDED THAT A DUPLEX OR QUAD OUTLET BOX BE INSTALLED INSIDE THIS PANEL TO ALLOW FOR POWER CONNECTIONS.

**NOTES KEY**

- ① MOUNTING KEYHOLES IN BACK PANEL OF DIN-EN-2X18 ENCLOSURE FOR SURFACE MOUNTING OF ASSEMBLY.
- ② KNOCKOUTS FOR CABINET WIRING
- ③ #DIN-EN-6X18 AUTOMATION ENCLOSURE DIMENSIONS: 39-5/8" H x 16-1/8" W X 4 3/8" D

LIGHTING CONTROL CABINET				
PANEL ID	CPP-1, 2, 3, 4			
MODEL	DIN-EN-6X18			
TYPE	NORMAL			
CABINET MODULE SCHEDULE				
DIN RAIL	MODULES	VOLTAGE	# OF FEEDS	# OF CKTS
1	DIN-PWS50	120-240	1	N/A
	DIN-AP3	N/A	N/A	N/A
2	(2) DIN-HUB	N/A	N/A	N/A
5	CEN-SW-POE-5	120V (POWER BRICK)		N/A
6	(2) CEN-SW-POE-5	120V (POWER BRICK)		N/A

- REVIEWED
- REVIEWED AND MODIFIED
- REVISE AND RESUBMIT
- NOT REVIEWED

The review by JRP Engineering is for the sole purpose of ascertaining conformance with the general design concept. This review shall not mean the detail design inherent in the shop drawings are approved, responsibility of which shall remain with the Contractor submitting same and review shall not relieve the Contractor of this responsibility for errors or omissions in the shop drawings or his responsibility for meeting all requirements of the Contract Documents. The Contractor is responsible for dimensions to be confirmed and correlated at the job site, for information that pertains solely to fabrication processes or to techniques of construction and installation and for co-ordination of the work of all sub-trades.

JRP Engineering


C.McGuire : AUTOMATION & CONTROL PROCESSOR

DATE: MAY 17th, 2017


**\* MODIFICATIONS:**

- Provide more infor ont he GLA-PWS50 for contractors.
- Contractor to coordinate installation on site with reference to slab conduits that are currently installed.
- If changes are required to the network layout shown in this shop drawing, the changes are to be marked up or drawings updated for the final As-Built submission for this project.
- Electrical to coordinate with system supplier to ensure a complete and operational system is achieved.
- Coordinate changes to drawings with contractors comments provided to you on May 9th, 2017.


POWER (CLASS 1) WIRING ENTRY

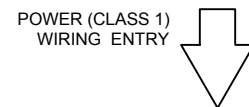


CONTROL (CLASS 2) WIRING ENTRY

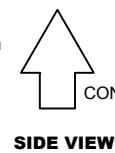


③

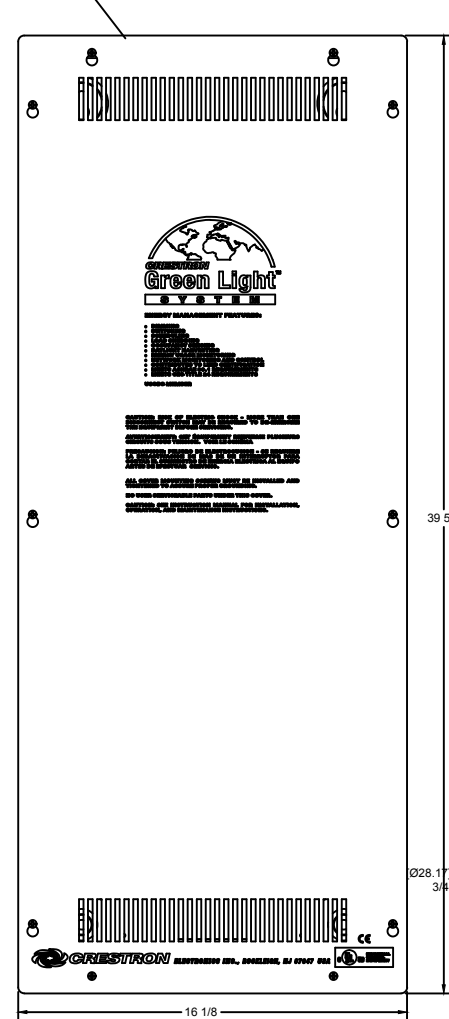


**FRONT VIEW (WITH COVER)**

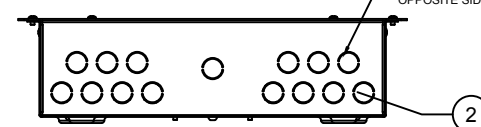

**BOTTOM VIEW**

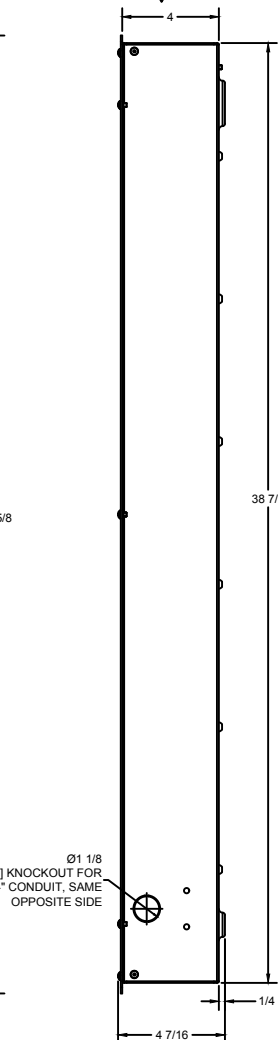

**SIDE VIEW**

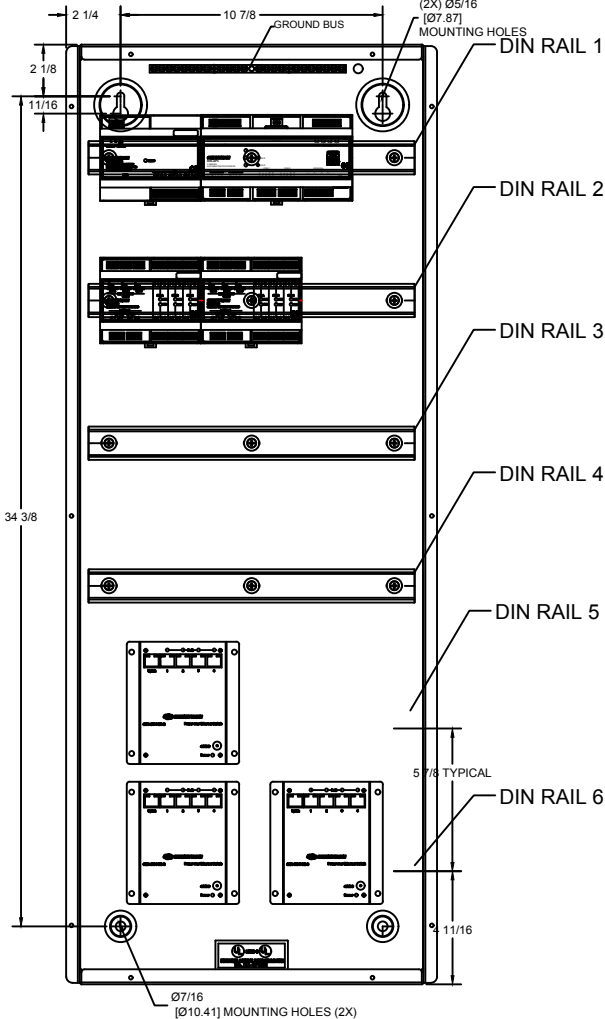

**FRONT VIEW (WITHOUT COVER)**

**DIN-EN-6X18 LIGHTING PANEL**



PROJECT: TOMLINSON	ORDER #: 1841941
LOCATION: CITIGATE, OTTAWA	PO #: PURCHASE ORDER
QUOTE #: 1048528	SALES REP: BDA LIGHTING GROUP
DISTRIBUTOR: DISTRIBUTOR	

**CRESTRON**  
 15 Volvo Drive  
 Rockleigh NJ 07647  
 Tel: 888-273-7876  
 Fax: 201-767-6011  
 www.crestron.com

TITLE:  
 CPP DETAIL  
 DRAWING

DRAWING:  
 05.0  
 REV:03  
 DATE:4-21-17  
 DRAWN BY:SDL

**GLPAC Load Schedule w/ Detailed Panel Terminations**

Project: TOMLINSON  
 Creator: SDL  
 Date: 4/21/2017 Revision: 03

Mounting Location:

Panel	Area / Room	Room #	Description	Zone #	Circuit #	Voltage	GLPAC Type	GLPAC ID	Output #	Fixture Designation	Load Type	Dim (Y/N)	Fixture Watts	Qty	Total Watts
	TRAINING ROOM A & B	128A & 128A	LINEAR	a	B-1.03	120V	GLPAC-DIMFLV4	1	1	A	0-10V DIMMED	Y	36.8	6	232.8
			LINEAR	b	B-1.03	120V			2	A	0-10V DIMMED	Y	36.8	12	465.6
			LINEAR	c	B-1.03	120V			3	A	0-10V DIMMED	Y	36.8	6	232.8
			LINEAR	d	B-1.03	120V			4	A	0-10V DIMMED	Y	36.8	12	465.6
	GYM	132	LINEAR	a	B-1.49	120V	GLPAC-DIMFLV4	2	1	A	0-10V DIMMED	Y	36.8	6	232.8
			LINEAR	b	B-1.49	120V			2	A	0-10V DIMMED	Y	36.8	6	232.8
			LINEAR	c	B-1.51	120V			3	A	0-10V DIMMED	Y	36.8	12	465.6
			LINEAR	d	B-1.51	120V			4	A	0-10V DIMMED	Y	36.8	8	310.4
	OPEN OFFICE	120	LINEAR	a	A-1.03	120V	GLPAC-DIMFLV4	3	1	A	0-10V DIMMED	Y	36.8	9	349.2
			LINEAR	b	A-1.03	120V			2	A	0-10V DIMMED	Y	36.8	17	659.4
			LINEAR	c	A-1.03	120V			3	A	0-10V DIMMED	Y	36.8	10	388
			LINEAR	d	A-1.03	120V			4	A	0-10V DIMMED	Y	36.8	19	737.2
	CAFETERIA	114	LINEAR	a	A-1.05	120V	GLPAC-DIMFLV4	4	1	A	0-10V DIMMED	Y	36.8	10	620.8
			LINEAR	b	A-1.05	120V			2	A	0-10V DIMMED	Y	36.8	14	543.2
			LINEAR	c	A-1.05	120V			3	A	0-10V DIMMED	Y	36.8	5	194
			LINEAR	d	A-1.05	120V			4	A	0-10V DIMMED	Y	36.8	6	232.8
	LARGE MEETING ROOM	221	DOWNLIGHT	a	A-2.57	120V	GLPAC-DIMFLV4	5	1	M1	0-10V DIMMED	Y	20	4	80
			DOWNLIGHT	b	A-2.57	120V			2	M1	0-10V DIMMED	Y	20	6	120
			DECORATIVE	c	A-2.57	120V			3	DB	0-10V DIMMED	Y			MAX. 16A
			SPACE			120V			4		SWITCHED OR 0-10V DIMMED	Y/N			MAX. 16A
	OPEN OFFICE	202	LINEAR	a	B-2.35	120V	GLPAC-DIMFLV4	5	1	A	0-10V DIMMED	Y	36.8	3	116.4
			LINEAR	b	B-2.35	120V			2	A	0-10V DIMMED	Y	36.8	18	698.4
			LINEAR	c	B-2.37	120V			3	A	0-10V DIMMED	Y	36.8	4	156.2
			LINEAR	d	B-2.37	120V			4	A	0-10V DIMMED	Y	36.8	3	116.4
	OPEN OFFICE	202	LINEAR	e	B-2.37	120V	GLPAC-DIMFLV4	5	1	A	0-10V DIMMED	Y	36.8	6	232.8
			LINEAR	f	B-2.41	120V			2	A	0-10V DIMMED	Y	36.8	3	116.4
			LINEAR	g	B-2.41	120V			3	A	0-10V DIMMED	Y	36.8	6	232.8
			LINEAR	h	B-2.41	120V			4	A	0-10V DIMMED	Y	36.8	10	388
	ATRIUM	100	DOWNLIGHTS	a	B-1.05	120V	GLPAC-DIMFLV4	5	1	M	SWITCHED	N	32.2	8	257.6
			DOWNLIGHTS	b	B-1.05	120V			2	M	SWITCHED	N	32.2	8	257.6
			CUSTOM LIGHT FIXTURE	c		120V			3	A	SWITCHED OR 0-10V DIMMED	Y/N			MAX. 16A
			CUSTOM LIGHT FIXTURE	d		120V			4	A	SWITCHED OR 0-10V DIMMED	Y/N			MAX. 16A
	ATRIUM	100	CUSTOM LIGHT FIXTURE	e		120V	GLPAC-DIMFLV4	5	1		SWITCHED OR 0-10V DIMMED	Y/N			MAX. 16A
			CUSTOM LIGHT FIXTURE	f		120V			2		SWITCHED OR 0-10V DIMMED	Y/N			MAX. 16A
			CUSTOM LIGHT FIXTURE	g		120V			3		SWITCHED OR 0-10V DIMMED	Y/N			MAX. 16A
			CUSTOM LIGHT FIXTURE	h		120V			4		SWITCHED OR 0-10V DIMMED	Y/N			MAX. 16A
	OPEN OFFICE	202	LINEAR	a	A-2.05	120V	GLPAC-DIMFLV4	5	1	A	0-10V DIMMED	Y	36.8	7	271.6
			LINEAR	b	A-2.05	120V			2	A	0-10V DIMMED	Y	36.8	33	1280.4
			LINEAR	c	A-2.07	120V			3	A	0-10V DIMMED	Y	36.8	17	659.6
			LINEAR	d	A-2.07	120V			4	A	0-10V DIMMED	Y	36.8	5	194
	OPEN OFFICE	202	LINEAR	e	A-2.09	120V	GLPAC-DIMFLV4	5	1	A	0-10V DIMMED	Y	36.8	6	232.8
			LINEAR	f	A-2.09	120V			2	A	0-10V DIMMED	Y	36.8	18	698.4
			LINEAR	g	A-2.09	120V			3	A	0-10V DIMMED	Y	36.8	12	465.6
			LINEAR	h	A-2.07	120V			4	A	0-10V DIMMED	Y	36.8	4	156.2
	OPEN OFFICE	302	LINEAR	a	B-3.49	120V	GLPAC-DIMFLV4	5	1	A	0-10V DIMMED	Y	36.8	5	194
			LINEAR	b	B-3.49	120V			2	A	0-10V DIMMED	Y	36.8	23	892.4
			LINEAR	c	B-3.51	120V			3	A	0-10V DIMMED	Y	36.8	20	776
			LINEAR	d	B-3.51	120V			4	A	0-10V DIMMED	Y	36.8	8	310.4
	OPEN OFFICE	302	LINEAR	e	B-3.03	120V	GLPAC-DIMFLV4	5	1	A	0-10V DIMMED	Y	36.8	5	194
			LINEAR	f	B-3.03	120V			2	A	0-10V DIMMED	Y	36.8	25	970
			SPACE			120V			3		SWITCHED OR 0-10V DIMMED	Y/N			MAX. 16A
			SPACE			120V			4		SWITCHED OR 0-10V DIMMED	Y/N			MAX. 16A
	OPEN OFFICE	302	LINEAR	a	A-3.79	120V	GLPAC-DIMFLV4	5	1	A	0-10V DIMMED	Y	36.8	8	310.4
			LINEAR	b	A-3.79	120V			2	A	0-10V DIMMED	Y	36.8	28	1088.4
			LINEAR	c	A-3.81	120V			3	A	0-10V DIMMED	Y	36.8	6	232.8
			LINEAR	d	A-3.77	120V			4	A	0-10V DIMMED	Y	36.8	19	737.2
	OPEN OFFICE	302	LINEAR	e	A-3.77	120V	GLPAC-DIMFLV4	5	1	A	0-10V DIMMED	Y	36.8	12	465.6
			LINEAR	f	A-3.83	120V			2	A	0-10V DIMMED	Y	36.8	8	310.4
			LINEAR	g	A-3.83	120V			3	A	0-10V DIMMED	Y	36.8	11	428.8
			LINEAR	h	A-3.83	120V			4	A	0-10V DIMMED	Y	36.8	30	1154
	OPEN OFFICE	402	LINEAR	a	B-4.09	120V	GLPAC-DIMFLV4	5	1	A	0-10V DIMMED	Y	36.8	10	620.8
			LINEAR	b	B-4.09	120V			2	A	0-10V DIMMED	Y	36.8	10	388
			LINEAR	c	B-4.03	120V			3	A	0-10V DIMMED	Y	36.8	6	232.8
			LINEAR	d	A-4.81	120V			4	A	0-10V DIMMED	Y	36.8	10	388
	OPEN OFFICE	402	LINEAR	e	A-4.83	120V	GLPAC-DIMFLV4	5	1	A	0-10V DIMMED	Y	36.8	7	271.6
			LINEAR	f	B-4.09	120V			2	A	0-10V DIMMED	Y	36.8	20	776
			LINEAR	g	A-4.81	120V			3	A	0-10V DIMMED	Y	36.8	20	776
			LINEAR	h	A-4.81	120V			4	A	0-10V DIMMED	Y	36.8	20	799
	OPEN OFFICE	402	LINEAR	a	A-4.77	120V	GLPAC-DIMFLV4	5	1	A	0-10V DIMMED	Y	36.8	16	620.8
			LINEAR	b	B-4.05	120V			2	A	0-10V DIMMED	Y	36.8	9	349.2
			LINEAR	c	A-4.83	120V			3	A	0-10V DIMMED	Y	36.8	9	349.2
			LINEAR	d	A-4.79	120V			4	A	0-10V DIMMED	Y	36.8	4	156.2
	OPEN OFFICE	402	LINEAR	e	A-4.79	120V	GLPAC-DIMFLV4	5	1	A	0-10V DIMMED	Y	36.8	7	271.6
			LINEAR	f	A-4.77	120V			2	A	0-10V DIMMED	Y	36.8	15	582
			LINEAR	g	A-4.77	120V			3	A	0-10V DIMMED	Y	36.8	13	504.4
			LINEAR	h	B-4.05	120V			4	A	0-10V DIMMED	Y	36.8	27	1047.6
	TEST FACILITY		INDUSTRIALS	a	A-1F-55	120V	GLPAC-DIMFLV8	13	1	L	SWITCHED	N	149	7	1043
			INDUSTRIALS	b	A-1F-55	120V			2	L	SWITCHED	N	149	8	1192
			INDUSTRIALS	c	A-1F-53	120V			3	L	SWITCHED	N	149	8	1192
			INDUSTRIALS	d	A-1F-53	120V			4	L	SWITCHED	N	149	3	447
			INDUSTRIALS	e	A-1F-51	120V			5	L	SWITCHED	N	149	5	745
			INDUSTRIALS	f	A-1F-51	120V			6	L	SWITCHED	N	149	5	745
			SPACE			120V			7		SWITCHED OR 0-10V DIMMED	Y/N			MAX. 16A
			SPACE			120V			8		SWITCHED OR 0-10V DIMMED	Y/N			MAX. 16A
	EXTERIOR					120V	GL-PAC-SW8	14	1		SWITCHED	N			MAX. 16A
						120V			2		SWITCHED	N			MAX. 16A
						120V			3		SWITCHED	N			MAX. 16A
						120V			4		SWITCHED	N			MAX. 16A
						120V			5		SWITCHED	N			MAX. 16A
						120V			6		SWITCHED	N			MAX. 16A
						120V			7		SWITCHED	N			MAX. 16A
						120V			8		SWITCHED	N			MAX. 16A

3

**NOTES:**

- LOAD SCHEDULE IS TO BE VERIFIED BY THE ELECTRICAL CONTRACTOR UPON COMPLETION OF INSTALLATION.
- AS BUILT REDLINE MARKUPS OF THE LOAD SCHEDULE MUST BE PROVIDED TO CRESTRON BEFORE SYSTEM PROGRAMMING CAN BE COMPLETED.
  - REVIEWED
  - REVIEWED AND MODIFIED
  - REVISE AND RESUBMIT
  - NOT REVIEWED
- THE ELECTRICAL CONTRACTOR, DISTRIBUTOR, OR ELECTRICAL ENGINEER MUST CONFIRM THAT THE FIXTURES SHOWN ARE CORRECT TYPE OF SWITCH OR DIMMER SHOWN ON THIS SCHEDULE. DIMMING A FIXTURE WITH AN INCOMPATIBLE BALLAST MAY CAUSE DAMAGE THAT IS NOT COVERED BY WARRANTY.
 

The review by JRP Engineering is for the sole purpose of ascertaining conformance with the general design concept. This review shall not mean the detail design inherent in the shop drawings are approved, responsibility of which shall remain with the Contractor submitting same and review shall not relieve the Contractor of this responsibility for errors or omissions in the shop drawings or his responsibility for meeting all requirements of the Contract Documents. The Contractor is responsible for dimensions to be confirmed and correlated at the job site, for information that pertains solely to fabrication processes or to techniques of construction and installation and for co-ordination of the work of all sub-trades.

JRP Engineering

C.McGuire

DATE: MAY 17th, 2017

- \* MODIFICATIONS:
- Provide more info on the GLA-PWS50 for contractors.
  - Contractor to coordinate installation on site with reference to slab conduits that are currently installed.
  - If changes are required to the network layout shown in this shop drawing, the changes are to be marked up or drawings updated for the final As-Built submission for this project.
  - Electrical to coordinate with system supplier to ensure a complete and operational system is achieved.
  - Coordinate changes to drawings with contractors comments provided to you on May 9th, 2017.



PROJECT: TOMLINSON  
 LOCATION: CITIGATE, OTTAWA  
 QUOTE #: 1048528  
 SALES REP: BDA LIGHTING GROUP  
 ORDER #: 1841941  
 PO #: PURCHASE ORDER  
 DISTRIBUTOR: DISTRIBUTOR

**CRESTRON**  
 15 Volvo Drive  
 Rockleigh NJ 07647  
 Tel: 888-273-7876  
 Fax: 201-767-6011  
 www.crestron.com

TITLE:  
 GLPAC LOAD SCHEDULES  
 DRAWING: 06.0  
 REV:03  
 DATE:4-21-17  
 DRAWN BY:SDL

**Load Schedule w/ Panel Terminations**

Project: TOMLINSON

Creator: SDL

Date: 3/28/2017 Revision: 01

Panel	Area / Room	Room #	Description	Zone #	Circuit #	Voltage	GLPP Type	GLPP ID	Output #	Fixture Designation	Load Type	Dim (Y/N)	Fixture Watts	Qty	Total Watts
GLPP	CLOAK ROOM	133	LINEAR		B-1.49	120V	GLPP-DIMFLVQI-FM	1	1	A	0-10V DIMMED	Y	38.8	14	543.2
GLPP	MENS	105	FIXTURES		A-1.57	120V	GLPP-DIMFLVQI-FM	1	1	F, E	SWITCHED	N	20	5	100
GLPP	WOMENS	106	FIXTURES		A-1.57	120V	GLPP-DIMFLVQI-FM	1	1	F, E	SWITCHED	N	20	5	100
GLPP	ELECT ROOM	108	FIXTURES		A-1.57	120V	GLPP-DIMFLVQI-FM	1	1	D	SWITCHED	N	52.5	1	52.5
GLPP	ELECTRICAL ROOM	116	LINEAR		A-1.55	120V	GLPP-DIMFLVQI-FM	1	1	D	0-10V DIMMED	Y	52.5	2	105
GLPP	HOLDING ROOM	117A	LINEAR		A-1.57	120V	GLPP-DIMFLVQI-FM	1	1	D	0-10V DIMMED	Y	52.5	6	315
GLPP	OFFICE	123	LINEAR		A-1.57	120V	GLPP-DIMFLVQI-FM	1	1	A	0-10V DIMMED	Y	38.8	3	116.4
GLPP	OFFICE	122	LINEAR		A-1.57	120V	GLPP-DIMFLVQI-FM	1	1	A	0-10V DIMMED	Y	38.8	2	77.6
GLPP	BREAKOUT ROOM	121	LINEAR		A-1.57	120V	GLPP-DIMFLVQI-FM	1	1	A	0-10V DIMMED	Y	38.8	1	38.8
GLPP	WATER ENTRY ROOM	124	LINEAR		A-1.63	120V	GLPP-DIMFLVQI-FM	1	1	D	0-10V DIMMED	Y	52.5	2	105
GLPP	OFFICE	125	LINEAR		A-1.63	120V	GLPP-DIMFLVQI-FM	1	1	A	0-10V DIMMED	Y	38.8	2	77.6
GLPP	OFFICE	126	LINEAR		A-1.63	120V	GLPP-DIMFLVQI-FM	1	1	A	0-10V DIMMED	Y	38.8	2	77.6
GLPP	OFFICE	127	LINEAR		A-1.63	120V	GLPP-DIMFLVQI-FM	1	1	A	0-10V DIMMED	Y	38.8	3	116.4
GLPP	WASHROOM	211	FIXTURE			120V	GLPP-DIMFLVQI-FM	1	1	H	0-10V DIMMED	Y	16.37	1	16.37
GLPP	MENS WASHROOM	205	FIXTURES		A-2.57	120V	GLPP-DIMFLVQI-FM	1	1	E, F	SWITCHED	N	71.7	1	71.7
GLPP	WOMENS WASHROOM	206	FIXTURES		A-2.57	120V	GLPP-DIMFLVQI-FM	1	1	E, F	SWITCHED	N	71.7	1	71.7
GLPP	OFFICE	216	LINEAR		A-2.57	120V	GLPP-DIMFLVQI-FM	1	1	A	0-10V DIMMED	Y	38.8	2	77.6
GLPP	OFFICE	217	LINEAR		A-2.57	120V	GLPP-DIMFLVQI-FM	1	1	A	0-10V DIMMED	Y	38.8	2	77.6
GLPP	BREAKOUT ROOM	216	LINEAR		A-2.57	120V	GLPP-DIMFLVQI-FM	1	1	A	0-10V DIMMED	Y	38.8	2	77.6
GLPP	OFFICE	219	LINEAR		A-2.57	120V	GLPP-DIMFLVQI-FM	1	1	A	0-10V DIMMED	Y	38.8	2	77.6
GLPP	OFFICE	220	LINEAR		A-2.57	120V	GLPP-DIMFLVQI-FM	1	1	A	0-10V DIMMED	Y	38.8	2	77.6
GLPP	OFFICE	326	LINEAR		B-3.53	120V	GLPP-DIMFLVQI-FM	1	1	A	0-10V DIMMED	Y	38.8	3	116.4
GLPP	OFFICE	327	LINEAR		B-3.51	120V	GLPP-DIMFLVQI-FM	1	1	A	0-10V DIMMED	Y	38.8	3	116.4
GLPP	OFFICE	328	LINEAR		B-3.51	120V	GLPP-DIMFLVQI-FM	1	1	A	0-10V DIMMED	Y	38.8	2	77.6
GLPP	MEETING ROOM	329	LINEAR		B-3.51	120V	GLPP-DIMFLVQI-FM	1	1	A	0-10V DIMMED	Y	38.8	4	155.2
GLPP	OFFICE	330	LINEAR		B-3.49	120V	GLPP-DIMFLVQI-FM	1	1	A	0-10V DIMMED	Y	38.8	2	77.8
GLPP	OFFICE	331	LINEAR		B-3.49	120V	GLPP-DIMFLVQI-FM	1	1	A	0-10V DIMMED	Y	38.8	3	116.4
GLPP	WASHROOM	311	FIXTURES			120V	GLPP-DIMFLVQI-FM	1	1	E, F	SWITCHED	N	71.7	1	71.7
GLPP	MENS WASHROOM	305	FIXTURES		A-3.81	120V	GLPP-DIMFLVQI-FM	1	1	E, F	SWITCHED	N	71.7	1	71.7
GLPP	WOMENS WASHROOM	306	FIXTURES		A-3.81	120V	GLPP-DIMFLVQI-FM	1	1	E, F	SWITCHED	N	71.7	1	71.7
GLPP	OFFICE	314	LINEAR		A-3.81	120V	GLPP-DIMFLVQI-FM	1	1	A	0-10V DIMMED	Y	38.8	3	116.4
GLPP	OFFICE	315	LINEAR		A-3.81	120V	GLPP-DIMFLVQI-FM	1	1	A	0-10V DIMMED	Y	38.8	2	77.8
GLPP	OFFICE	318	LINEAR		A-3.81	120V	GLPP-DIMFLVQI-FM	1	1	A	0-10V DIMMED	Y	38.8	2	77.8
GLPP	OFFICE	319	LINEAR		A-3.77	120V	GLPP-DIMFLVQI-FM	1	1	A	0-10V DIMMED	Y	38.8	2	77.8
GLPP	OFFICE	320	LINEAR		A-3.77	120V	GLPP-DIMFLVQI-FM	1	1	A	0-10V DIMMED	Y	38.8	3	116.4
GLPP	MEETING ROOM	322	LINEAR		A-3.83	120V	GLPP-DIMFLVQI-FM	1	1	A	0-10V DIMMED	Y	38.8	3	116.4
GLPP	OFFICE	323	LINEAR		A-3.83	120V	GLPP-DIMFLVQI-FM	1	1	A	0-10V DIMMED	Y	38.8	2	77.8
GLPP	OFFICE	324	LINEAR		A-3.83	120V	GLPP-DIMFLVQI-FM	1	1	A	0-10V DIMMED	Y	38.8	2	77.8

**NOTES:**

- LOAD SCHEDULE IS TO BE VERIFIED BY THE ELECTRICAL CONTRACTOR UPON COMPLETION OF INSTALLATION.
  - AS BUILT REDLINE MARKUPS OF THE LOAD SCHEDULE MUST BE PROVIDED TO CRESTRON BEFORE SYSTEM PROGRAMMING CAN BE COMPLETED.
    - REVIEWED
    - REVIEWED AND MODIFIED
    - REVISION AND COMMENTS
    - NOT REVIEWED
- The review by JRP Engineering is for the sole purpose of ascertaining conformance with the general design concept. This review shall not mean the detail design inherent in the shop drawings are approved, responsibility of which shall remain with the Contractor submitting same and review shall not relieve the Contractor of this responsibility for errors or omissions in the shop drawings or his responsibility for meeting all requirements of the Contract Documents. The Contractor is responsible for dimensions to be confirmed and correlated at the job site, for information that pertains solely to fabrication processes or to techniques of construction and installation and for co-ordination of the work of all sub-trades.
- JRP Engineering  
C.McGuire

DATE: MAY 17th, 2017

- \* MODIFICATIONS:
- Provide more information on the GLA-PWS50 for contractors.
  - Contractor to coordinate installation on site with reference to slab conduits that are currently installed.
  - If changes are required to the network layout shown in this shop drawing, the changes are to be marked up or drawings updated for the final As-Built submission for this project.
  - Electrical to coordinate with system supplier to ensure a complete and operational system is achieved.
  - Coordinate changes to drawings with contractors comments provided to you on May 9th, 2017.



PROJECT: TOMLINSON  
 LOCATION: CITIGATE, OTTAWA  
 QUOTE #: 1048528  
 SALES REP: BDA LIGHTING GROUP  
 ORDER #: 1841941  
 PO #: PURCHASE ORDER  
 DISTRIBUTOR: DISTRIBUTOR

**CRESTRON**  
 15 Volvo Drive  
 Rockleigh NJ 07647  
 Tel: 888-273-7876  
 Fax: 201-767-6011  
 www.crestron.com

TITLE:  
 GLPP LOAD SCHEDULES  
 DRAWING:  
 06.1  
 REV:01  
 DATE:3-29-17  
 DRAWN BY:SDL

GLPP- OFFICE	325	LINEAR	A-3.83	120V	GLPP-DIMFLV2CN-PM	1	1	A	0-10V DIMMED	Y	38.8	2	77.8
GLPP- OFFICE	435	LINEAR	B-4.63	120V	GLPP-DIMFLV2CN-PM	1	1	A	0-10V DIMMED	Y	38.8	2	77.8
GLPP- OFFICE	434	LINEAR	B-4.63	120V	GLPP-DIMFLV2CN-PM	1	1	A	0-10V DIMMED	Y	38.8	2	77.8
GLPP- OFFICE	433	LINEAR	B-4.59	120V	GLPP-DIMFLV2CN-PM	1	1	A	0-10V DIMMED	Y	38.8	2	77.8
GLPP- OFFICE	437	LINEAR	B-4.63	120V	GLPP-DIMFLV2CN-PM	1	1	A	0-10V DIMMED	Y	38.8	2	77.8
GLPP- MEETING ROOM	436	LINEAR	B-4.63	120V	GLPP-DIMFLV2CN-PM	1	1	A	0-10V DIMMED	Y	38.8	2	77.8
GLPP- OFFICE	438	LINEAR	B-4.65	120V	GLPP-DIMFLV2CN-PM	1	1	A	0-10V DIMMED	Y	38.8	2	77.8
GLPP- OFFICE	439	LINEAR	B-4.65	120V	GLPP-DIMFLV2CN-PM	1	1	A	0-10V DIMMED	Y	38.8	2	77.8
GLPP- OFFICE	440	LINEAR	B-4.65	120V	GLPP-DIMFLV2CN-PM	1	1	A	0-10V DIMMED	Y	38.8	2	77.8
GLPP- WASHROOM	411	FXTURES		120V	GLPP-DIMFLV2CN-PM	1	1	E H	SWITCHED	N	22.37	1	23.5
GLPP- BREAKOUT ROOM	441	LINEAR	B-4.65	120V	GLPP-DIMFLV2CN-PM	1	1	A	0-10V DIMMED	Y	38.8	2	77.8
GLPP- OFFICE	432	LINEAR	B-4.59	120V	GLPP-DIMFLV2CN-PM	1	1	A	0-10V DIMMED	Y	38.8	2	77.8
GLPP- OFFICE	431	LINEAR	B-4.59	120V	GLPP-DIMFLV2CN-PM	1	1	A	0-10V DIMMED	Y	38.8	2	77.8
GLPP- OFFICE	430	LINEAR	A-4.81	120V	GLPP-DIMFLV2CN-PM	1	1	A	0-10V DIMMED	Y	38.8	2	77.8
GLPP- BREAKOUT ROOM	429	LINEAR	A-4.81	120V	GLPP-DIMFLV2CN-PM	1	1	A	0-10V DIMMED	Y	38.8	2	77.8
GLPP- OFFICE	428	LINEAR	A-4.83	120V	GLPP-DIMFLV2CN-PM	1	1	A	0-10V DIMMED	Y	38.8	2	77.8
GLPP- OFFICE	427	LINEAR	A-4.83	120V	GLPP-DIMFLV2CN-PM	1	1	A	0-10V DIMMED	Y	38.8	2	77.8
GLPP- OFFICE	415	LINEAR	A-4.79	120V	GLPP-DIMFLV2CN-PM	1	1	A	0-10V DIMMED	Y	38.8	2	77.8
GLPP- MEETING ROOM	414	LINEAR	A-4.79	120V	GLPP-DIMFLV2CN-PM	1	1	A	0-10V DIMMED	Y	38.8	3	116.4
GLPP- WOMENS WASHROOM	406	FXTURES	A-4.79	120V	GLPP-DIMFLV2CN-PM	1	1	E F	SWITCHED	N	71.7	1	71.7
GLPP- MENS WASHROOM	405	FXTURES	A-4.79	120V	GLPP-DIMFLV2CN-PM	1	1	E F	SWITCHED	N	71.7	1	71.7
GLPP- TENDER CLOSING ROOM	442	LINEAR	A-4.77	120V	GLPP-DIMFLV2CN-PM	1	1	A	0-10V DIMMED	Y	38.8	9	389.2
GLPP- KITCHEN	115	LINEAR	A-1.55	120V	GLPP-1DIMFLV2CN-PM	1	1	K	0-10V DIMMED	Y	54	8	432
		LINEAR				2		K	0-10V DIMMED	Y	54	1	54
GLPP- OFFICE	223	LINEAR	B-2.41	120V	GLPP-1DIMFLV2CN-PM	1	1	A	0-10V DIMMED	Y	38.8	2	77.8
		LINEAR				2		A	0-10V DIMMED	Y	38.8	2	77.8
GLPP- OFFICE	224	LINEAR	B-2.37	120V	GLPP-1DIMFLV2CN-PM	1	1	A	0-10V DIMMED	Y	38.8	4	155.2
		LINEAR				2		A	0-10V DIMMED	Y	38.8	4	155.2
GLPP- OFFICE	225	LINEAR	B-2.35	120V	GLPP-1DIMFLV2CN-PM	1	1	A	0-10V DIMMED	Y	38.8	4	155.2
		LINEAR				2		A	0-10V DIMMED	Y	38.8	4	155.2
GLPP- OFFICE	226	LINEAR	B-2.35	120V	GLPP-1DIMFLV2CN-PM	1	1	A	0-10V DIMMED	Y	38.8	2	77.8
		LINEAR				2		A	0-10V DIMMED	Y	38.8	2	77.8
GLPP- OFFICE	227	LINEAR	B-2.35	120V	GLPP-1DIMFLV2CN-PM	1	1	A	0-10V DIMMED	Y	38.8	2	77.8
		LINEAR				2		A	0-10V DIMMED	Y	38.8	2	77.8

1

**NOTES:**

- 1.) LOAD SCHEDULE IS TO BE VERIFIED BY THE ELECTRICAL CONTRACTOR UPON COMPLETION OF INSTALLATION.
- 2.) AS BUILT REDLINE MARKUPS OF THE LOAD SCHEDULE MUST BE PROVIDED TO CRESTRON BEFORE SYSTEM PROGRAMMING CAN BE COMPLETED.
- 3.) THE ELECTRICAL CONTRACTOR, DISTRIBUTOR, OR ELECTRICAL ENGINEER MUST CONFIRM THAT THE FIXTURES SHOWN ARE COMPATIBLE WITH THE TYPE OF SWITCH OR DIMMER SHOWN ON THIS SCHEDULE. DIMMING A FIXTURE WITH AN INCOMPATIBLE BALLAST MAY CAUSE DAMAGE THAT IS NOT COVERED BY WARRANTY.

The review by JRP Engineering is for the sole purpose of ascertaining conformance with the general design concept. This review shall not mean the detail design inherent in the shop drawings are approved, responsibility of which shall remain with the Contractor submitting same and review shall not relieve the Contractor of this responsibility for errors or omissions in the shop drawings or his responsibility for meeting all requirements of the Contract Documents. The Contractor is responsible for dimensions to be confirmed and correlated at the job site, for information that pertains solely to fabrication processes or to techniques of construction and installation and for co-ordination of the work of all sub-trades.

JRP Engineering  
C.McGuire

DATE: MAY 17th, 2017

**\* MODIFICATIONS:**

1. Provide more info on the GLA-PWS50 for contractors.
2. Contractor to coordinate installation on site with reference to slab conduits that are currently installed.
3. If changes are required to the network layout shown in this shop drawing, the changes are to be marked up or drawings updated for the final As-Built submission for this project.
4. Electrical to coordinate with system supplier to ensure a complete and operational system is achieved.
5. Coordinate changes to drawings with contractors comments provided to you on May 9th, 2017.



PROJECT: TOMLINSON  
LOCATION: CITIGATE, OTTAWA  
QUOTE #: 1048528  
SALES REP: BDA LIGHTING GROUP  
DISTRIBUTOR: DISTRIBUTOR  
ORDER #: 1841941  
PO #: PURCHASE ORDER

**CRESTRON**  
15 Volvo Drive  
Rockleigh NJ 07647  
Tel: 888-273-7876  
Fax: 201-767-6011  
www.crestron.com

TITLE:  
GLPP LOAD  
SCHEDULES  
CONT'D

DRAWING:  
06.2  
REV:01  
DATE:3-29-17  
DRAWN BY:SDL


## DIN Rail 3-Series® Automation Processor

- > Enterprise-class control system
- > 3-Series® Control Engine — substantially faster and more powerful than other control systems
- > Exclusive modular programming architecture
- > Programmable astronomical time clock for scheduled events
- > Onboard 256MB RAM & 4GB Flash memory
- > Memory card slot
- > Industry-standard Ethernet and Crestron® wired communications
- > XPanel with Smart Graphics™ computer and web based control
- > iPhone®, iPad®, and Android™ control app support
- > Crestron Fusion® Cloud Enterprise Management Service support
- > SNMP remote management support
- > Two RS-232/422/485 COM ports with hardware and software handshaking
- > Four IR/serial, four relay, and eight Versiport I/O ports
- > Native BACnet™/IP support<sup>[2]</sup>
- > Installer setup via Crestron Toolbox™ software or web browser
- > C#, symbol based, and drag-and-drop programming environments
- > Full Unicode (multi-language) support
- > Increased network throughput and security
- > Secure access through full user/group management or Active Directory integration
- > Hardware level security using 802.1X authentication
- > TLS, SSL, SSH, and SFTP network security protocols
- > FIPS 140-2 compliant encryption
- > IIS v.6.0 Web Server
- > IPv6 ready
- > Front panel USB computer console port
- > 9M wide DIN rail mountable

The Crestron® DIN-AP3 is a 3-Series Control System® designed for rail mounting applications. Featuring the 3-Series® control engine, DIN-AP3 forms the core of any modern networked home or commercial building, managing and integrating all the disparate technologies throughout the facility to make life easier, greener, more productive and more enjoyable.

### DIN Rail Mounting

The DIN-AP3 is designed to snap onto a standard DIN rail for installation in a wall mount enclosure (Crestron DIN-EN series<sup>[1]</sup> or similar) or on a panel. DIN rail mounting affords a very space-efficient, cost-effective modular solution for configuring complete automation systems using DIN-AP3 along with additional Crestron and third-party DIN rail mountable devices.

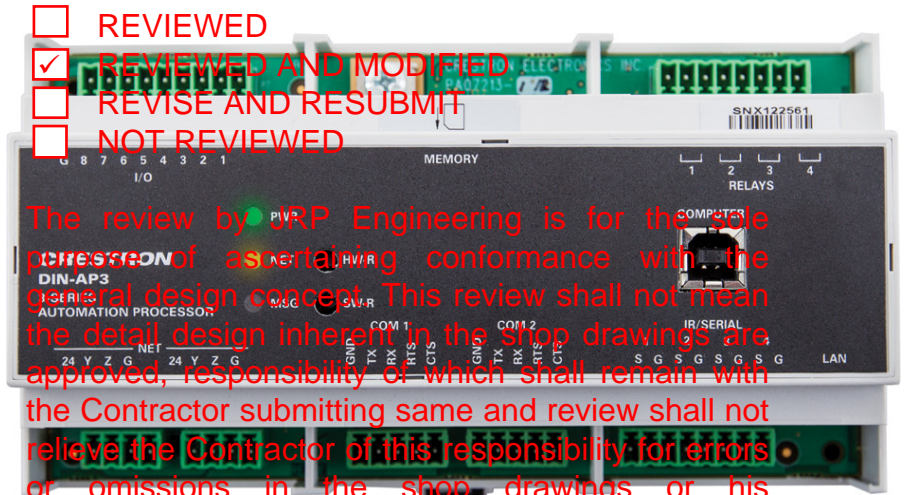

- REVIEWED
- REVIEWED AND MODIFIED
- REVISE AND RESUBMIT
- NOT REVIEWED

The review by JRP Engineering is for the sole purpose of ascertaining conformance with the original design concept. This review shall not mean the detail design inherent in the shop drawings are approved, responsibility of which shall remain with the Contractor submitting same and review shall not relieve the Contractor of this responsibility for errors or omissions in the shop drawings or his responsibility for meeting all requirements of the Contract Documents. The Contractor is responsible for dimensions to be confirmed and coordinated on the job site, for installation, that comply with the fabrication processes and to be a network of construction capable of faithfully handling everything from lighting and AV system control to total building management.

JRP Engineering  
C. McGuire

3-Series® Control Systems  
Today's commercial buildings and custom homes comprise more technology than ever before, and all these systems need to be networked, managed, and controlled in fundamentally new ways. The IP-based 3-Series platform is engineered from the ground up to deliver a high-grade server appliance capable of faithfully handling everything from lighting and AV system control to total building management.

3-Series embodies a distinctively robust, dynamic, and secure platform for your system designs to higher levels of performance and reliability. In other control systems, Crestron 3-Series provides a pronounced increase in processing power, a more powerful network, rock solid networking and IP control, and a unique modular programming architecture.

DATE: MAY 17th, 2017

### \* MODIFICATIONS:

1. Provide more information on the GLA-PWS50 for contractors.
2. Contractor to coordinate installation on site with reference to slab conduits that are currently installed.
3. If changes are required to the network layout shown in this shop drawing, the changes are to be marked up on drawings updated for the final As-Built submission for this project.
4. Electrical to coordinate with system supplier to ensure a complete and operational system is achieved.
5. Coordinate changes to drawings with contractors comments provided to you on May 9th, 2017.

media servers, security systems, lighting, HVAC, and other equipment — whether on premises or across the globe.

# DIN-AP3 DIN Rail 3-Series® Automation Processor

## Control Apps & XPanel

Years ago, Crestron pioneered the world's first IP-based control system, unleashing vast new possibilities for controlling, monitoring, and managing integrated systems over a LAN, WAN, and the internet. Today, Crestron offers more ways than ever to control your world the way you want. Using a computer, smartphone, or tablet device, Crestron lets you control anything in your home or workplace from anywhere in the world.

Native to every 3-Series control system, Crestron XPanel technology transforms any laptop or desktop computer into a virtual Crestron touch screen. Crestron control apps deliver the Crestron touch screen experience to iPhone®, iPad®, and Android™ devices, letting you safely monitor and control your entire residence or commercial facility using the one device that goes with you everywhere.

## Crestron Fusion® Cloud

Crestron Fusion Cloud provides an integrated platform for creating truly smart buildings that save energy, enhance worker productivity, and prolong the life span of building equipment. As part of a complete managed network in a corporate enterprise, college campus, convention center, or any other facility, the DIN-AP3 works integrally with Crestron Fusion Cloud to enable remote scheduling, monitoring, and control of rooms and technology from a central help desk. It also enables organizations to reduce energy costs by monitoring real-time usage and automating control of lighting, shades, and HVAC.

## SNMP Support

Built-in SNMP support enables integration with third-party IT management software, allowing network administrators to manage and control Crestron systems on the network in an IT-friendly format.

## Astronomical Time Clock Feature

Scheduled events may be programmed to an astronomical time clock. As a result, events occur at sunrise or sunset times or at an offset from sunrise or sunset.

## Cresnet®

Cresnet provides a dependable network for keypads, lighting controls, shade motors and other devices that don't require the power of a standard Ethernet. The Cresnet bus offers easy wiring and configuration, communication and 24VDC power to each device. To assist with troubleshooting, the optional Network Analyzer which continues to expand the Cresnet network for wiring faults, margin

The DIN-AP3 includes a pair of Cresnet ports for supporting approximately 20 typical devices. More than 20 devices can be handled by adding a Cresnet Distribution Hub or DIN-CENCN-2 Ethernet Connectivity for multiple homeruns can be supported by DIN-BLOCK Cresnet Distribution Blocks<sup>[1]</sup> and DIN-PWS50 Cresnet Power Supply<sup>[1]</sup> is required to power the DIN-AP3 and any connected Cresnet devices.

REVIEWED

REVIEWED AND MODIFIED

REVISE AND RESUBMIT

NOT REVIEWED

The review by JEP Engineering is for the sole purpose of ascertaining conformance with the general design concept. This review shall not mean the detail design is inherent in the shop drawings are approved, responsibility of which shall remain with the Contractor submitting same and review shall not relieve the Contractor of this responsibility for errors or omissions in the shop drawings or his responsibility for meeting all requirements of the Contract Documents. The Contractor is responsible for dimensions to be confirmed at the job site, for information that pertains solely to fabrication processes or to techniques of construction and installation and for co-ordination of the works of all subtrades.

C.McGuire

## Onboard Control Ports

In addition to Ethernet, the DIN-AP3 includes a variety of control ports for interfacing with third-party equipment. Its two bidirectional COM ports and four IR ports allow for interfacing with security systems, small appliances, and AV devices. Four programmable relay ports are provided for controlling projection screens, lifts, power controllers, and other contact-closure actuated equipment. Eight "Versiport" I/O ports enable the integration of power sensors, motion detectors, door switches, alarms, or anything else that provides a dry contact closure, low-voltage logic, or 0-10 Volt DC signal.

Additional control ports, lighting and motor controls, and other types of interfaces can be added easily using Crestron DIN Rail series lighting and automation modules.

## BACnet™/IP

Native support for the BACnet/IP communication protocol provides a direct interface to third-party building management systems over Ethernet, simplifying integration with HVAC, security, fire & life safety, video, lighting, shades, and other systems. Using BACnet/IP each system works independently with the ability to communicate together on one platform for a truly smart building.<sup>[2]</sup>



## SPECIFICATIONS

### Control Engine

Crestron 3-Series real-time, preemptive multi-threaded/multitasking  
 DATE: MAY 17th, 2017  
 FAT file system; supports up to 10 simultaneously running programs

### \* MODIFICATIONS:

1. Provide more information on the GLA-PWS50 for contractors.
2. Contractor to coordinate installation on site with reference to slab conduits that are currently installed.
3. If changes are required to the network layout shown in this shop drawing, the changes are to be marked up on drawings updated for the final As-Built submission for this project.
4. Electrical to coordinate with system supplier to ensure a complete and operational system is achieved.
5. Coordinate changes to drawings with contractors comments provided to you on May 9th, 2017.

ports up to 32 GB

auto-negotiating, auto-discovery, stack, UDP/IP, CIP, DHCP, SSL, (S), FIPS 140-2 compliant<sup>[2]</sup>, IPv4 or IPv6, Active Directory, e-mail client

front panel USB 2.0 device port for control and monitoring, supports baud rate with hardware and

infrared up to 1.2 MHz or 1000 baud

### CONNECTORS & CARD SLOTS

I/O 1 – 8: (1) 9-pin 3.5 mm detachable terminal block; Comprises (8) "Versiport" digital input/output or analog input ports (referenced to GND);

# DIN-AP3 DIN Rail 3-Series® Automation Processor

Digital Input: Rated for 0-24 Volts DC, input impedance 20k Ohms, logic threshold >3.125V low/0 and <1.875V high/1;  
Digital Output: 250 mA sink from maximum 24 Volts DC, latch modes to use with "real world" loads;  
Analog Input: Rated for 0-10 Volts DC, protected to 24 Volts DC maximum, input impedance 21k Ohms with pull-up resistor disabled;  
Programmable 5 Volts, 2k Ohms pull-up resistor per pin

**Ground:** (1) Captive screw terminal;  
Chassis ground lug

**MEMORY:** (1) SD memory card slot;  
Accepts one SD or SDHC card up to 32 GB for memory expansion

**RELAYS 1 – 4:** (1) 8-pin 3.5 mm detachable terminal block;  
Comprises (4) normally open, isolated relays;  
Rated 1 Amp, 30 Volts AC/DC;  
MOV arc suppression across contacts

**COMPUTER:** (1) USB Type B female;  
USB 2.0 computer console port (6 ft cable included);  
For setup only

**NET:** (2) 4-pin 3.5 mm detachable terminal blocks, parallel;  
Cresnet master port and 24 Volt DC power port

**COM 1 – 2:** (2) 5-pin 3.5 mm detachable terminal blocks;  
Bidirectional RS-232/422/485 ports;  
Up to 115.2k baud; hardware and software handshaking support

**IR/SERIAL 1 – 4:** (1) 8-pin 3.5 mm detachable terminal block;  
Comprises (4) IR/Serial output ports;  
IR output up to 1.2 MHz;  
1-way serial TTL/RS-232 (0-5 Volts) u

**LAN:** (1) 8-pin RJ45 jack;  
10Base-T/100Base-TX Ethernet port

## Controls & Indicators

**PWR:** (1) Dual-color green/amber LEI from Cresnet network or power supply green when operating

**NET:** (1) Amber LED, indicates comm

**MSG:** (1) Red LED, indicates process

**HW-R:** (1) Recessed miniature pushb

**SW-R:** (1) Recessed miniature pushb

**LAN:** (2) LEDs, green LED indicates E indicates Ethernet activity

## Power

Cresnet Power Usage: 8 Watts (0.33

## Environmental

**Temperature:** 32° to 104° F (0° to 40° C)

**Humidity:** 10% to 90% RH (non-condensing)

**Heat Dissipation:** 26 BTU/hr

## Enclosure

Light gray polycarbonate housing with polycarbonate label overlay, UL94 V-0 rated, 35 mm DIN EN 60715 rail mount, DIN 43880 form factor for enclosures with 45 mm front panel cutout, occupies 9 DIN module spaces (162 mm)

## Dimensions

Height: 6.73 in (171 mm)

Width: 6.28 in (160 mm)

Depth: 2.29 in (59 mm)

## Weight

9.8 oz (277 g)

## MODELS & ACCESSORIES

### Available Models

DIN-AP3: DIN Rail 3-Series® Automation Processor

### Available Accessories

DIN-EN Series: Enclosures for DIN Rail Devices

DIN-PWS50: DIN Rail 50 Watt Cresnet Power Supply

DIN-PWS30-277: DIN Rail 30 Watt Cresnet Power Supply, 277V

DIN-BLOCK: DIN Rail Cresnet Distribution Block

DIN-DHUB: DIN Rail Cresnet Distribution Hub

DIN-ETHERNET: Ethernet to Cresnet Bridge

DIN-ETHERNET-POE: Ethernet to Cresnet Bridge w/PoE

**REVIEWED**  
**REVIEWED AND MODIFIED**  
**REVISE AND RESUBMIT**  
**NOT REVIEWED**

The review by JRP Engineering is for the sole purpose of ascertaining conformance with the general design concept. This review shall not mean the detail design inherent in the shop drawings are approved, responsibility of which shall remain with the Contractor submitting same and review shall not relieve the Contractor of this responsibility for errors or omissions in the shop drawings or his responsibility for meeting all requirements of the Contract Documents. The Contractor is responsible for dimensions to be confirmed and correlated at the job site, for information that pertains solely to fabrication, processes or to techniques of construction and installation and for coordination of the work of all sub-trades.

JRP Engineering  
C.McGuire

DATE: MAY 17th, 2017

### \* MODIFICATIONS:

1. Provide more information on the GLA-PWS50 for contractors.
2. Contractor to coordinate installation on site with reference to slab conduits that are currently installed.
3. If changes are required to the network layout shown in this shop drawing, the changes are to be marked up or drawings updated for the final As-Built submission for this project.
4. Electrical to coordinate with system supplier to ensure a complete and operational system is achieved.
5. Coordinate changes to drawings with contractors comments provided to you on May 9th, 2017.

channels  
er, 1 feed, 4 channels  
cent Dimmer, 4 feeds, 4 channels  
ch, 8 feeds, 8 channels  
itch with Digital Inputs  
eds, 2 channels  
ile  
terface  
le  
k Connector  
iOS® and Android™  
rs  
nent Platform  
port for 3-Series®

# DIN-AP3 DIN Rail 3-Series® Automation Processor

- REVIEWED
- REVIEWED AND MODIFIED
- REVISE AND RESUBMIT
- NOT REVIEWED

Notes:

- Item(s) sold separately.
- License required. The DIN-AP3 supports a maximum of 500 BACnet objects when dedicated for BACnet use only. Actual capabilities are contingent upon the overall program size and complexity.

This product may be purchased from an authorized Crestron dealer. To find a dealer, please contact the Crestron sales representative for your area. A list of sales representatives is available online at [www.crestron.com/salesreps](http://www.crestron.com/salesreps) or by calling 800-237-2041.

The specific patents that cover Crestron products are listed online at: [patents.crestron.com](http://patents.crestron.com)

Certain Crestron products contain publicly available source code. For specific information please refer to [www.crestron.com/opensource](http://www.crestron.com/opensource).

Crestron, the Crestron logo, 3-Series, 3-Series Control System, Cresnet, Crestron Control, Crestron Fusion, Crestron Toolbox, and Smart Graphics are either trademarks or registered trademarks of Crestron Electronics, Inc. in the United States and/or other countries. BACnet and the BACnet logo are either trademarks or registered trademarks of American Society of Heating, Refrigerating and Air-Conditioning Engineers, Inc. in the United States and/or other countries. iPad, iPhone, and iPod are either trademarks or registered trademarks of Apple Inc. in the United States and/or other countries. IOS is either a trademark or registered trademark of Cisco Technology, Inc. in the United States and/or other countries. Android is either a trademark or registered trademark of Google, Inc. in the United States and/or other countries. Other trademarks, registered trademarks, and trade names may be used in this document to refer to either the entities claiming the marks and names or their products. Crestron disclaims any proprietary interest in the marks and names of others. Crestron is not responsible for errors in typography or photography. Specifications are subject to change without notice.  
©2016 Crestron Electronics, Inc.


The review by JRP Engineering is for the sole purpose of ascertaining conformance with the general design concept. This review shall not mean the detail design inherent in the shop drawings are approved, responsibility of which shall remain with the Contractor submitting same and review shall not relieve the Contractor of his responsibility for errors or omissions in the shop drawings or his responsibility for meeting all requirements of the Contract Documents. The Contractor is responsible for dimensions to be confirmed and correlated at the job site, for information that pertains solely to fabrication processes or to techniques of construction and installation and for co-ordination of the work of all sub-trades.

JRP Engineering  
C.McGuire

DATE: MAY 17th, 2017

\* MODIFICATIONS:

- Provide more info on the GLA-PWS50 for contractors.
- Contractor to coordinate installation on site with reference to slab conduits that are currently installed.
- If changes are required to the network layout shown in this shop drawing, the changes are to be marked up or drawings updated for the final As-Built submission for this project.
- Electrical to coordinate with system supplier to ensure a complete and operational system is achieved.
- Coordinate changes to drawings with contractors comments provided to you on May 9th, 2017.

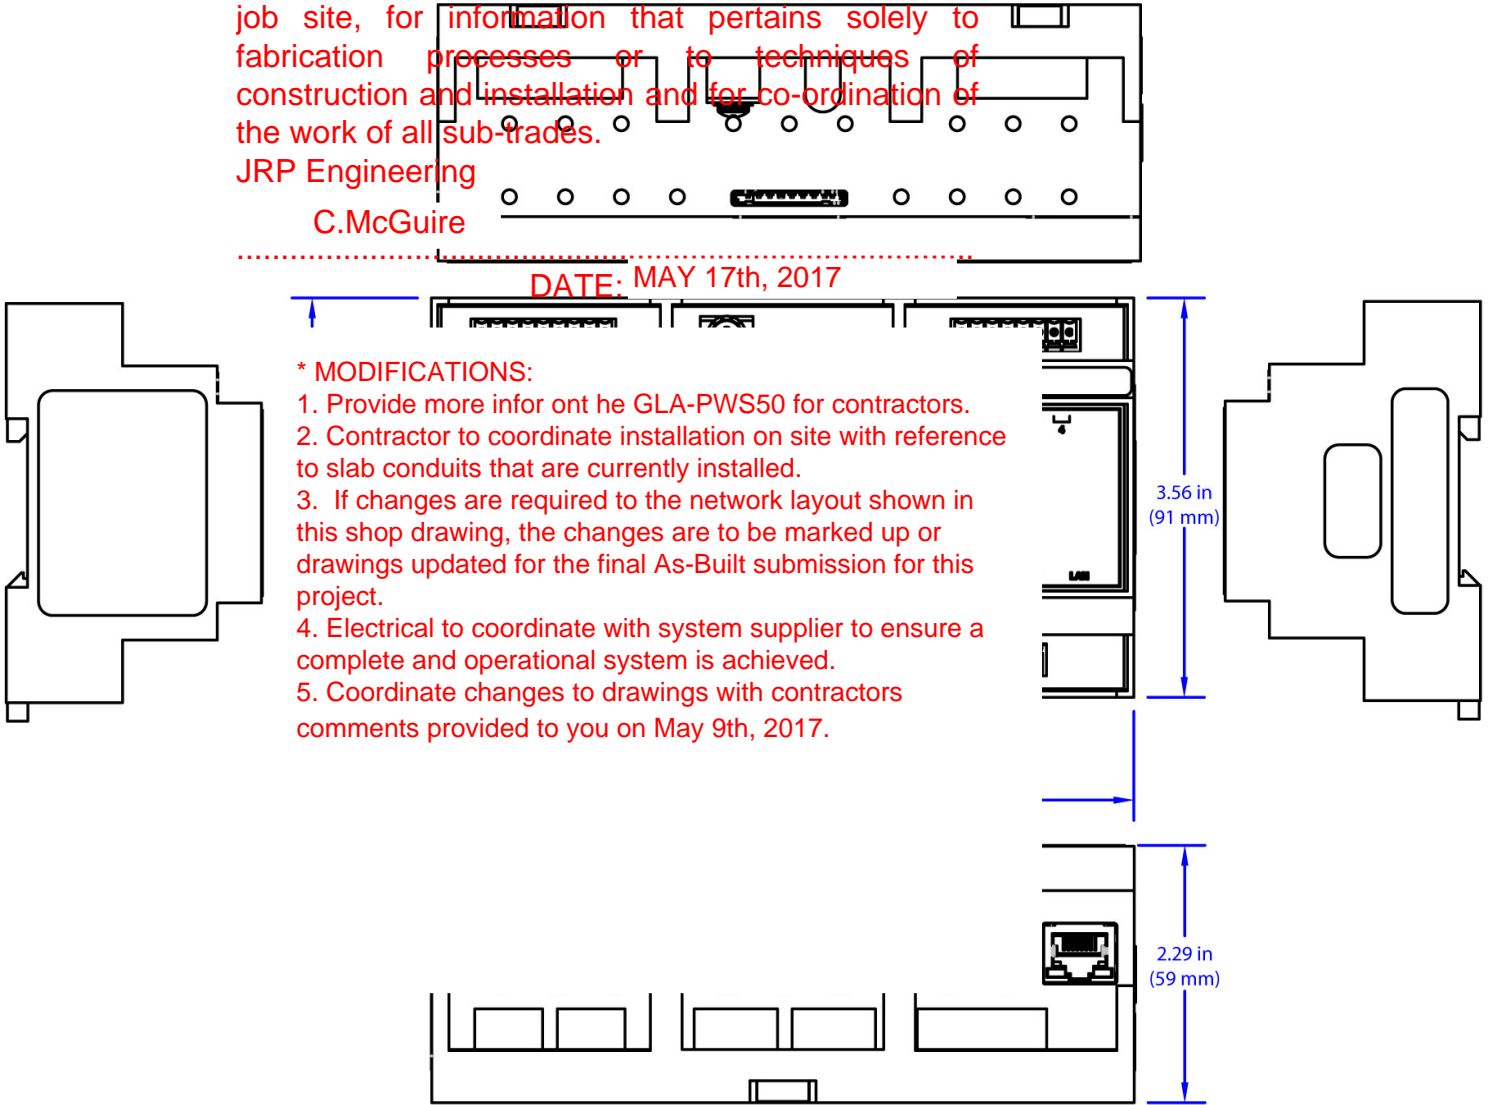

# CEN-SW-POE-5

## 5-Port PoE Switch

REVIEWED

REVIEWED AND MODIFIED

REVISE AND RESUBMIT

NOT REVIEWED

- > 5-port unmanaged Ethernet switch
- > All ports support 1000Base-T Gigabit Ethernet
- > Provides PoE (802.3af) on 4 ports
- > Auto-negotiating and auto MDI/MDIX
- > Rugged metal enclosure
- > Surface or rack-rail mountable

The review by JRP Engineering is for the sole purpose of ascertaining conformance with the general design concept. This review shall not mean the detail design inherent in the shop drawings are approved, responsibility of which shall remain with the Contractor submitting same and review shall not relieve the Contractor of this responsibility for errors or omissions in the shop drawings or his responsibility for meeting all requirements of the Contract Documents. The Contractor is responsible for dimensions to be confirmed and correlated at the job site for information that pertains solely to fabrication, processes or to techniques of construction and installation and for co-ordination of the work of all sub-trades.

The CEN-SW-POE-5 is a 5-port unmanaged Gigabit Ethernet switch that provides Power over Ethernet (PoE) from four of its ports. Power over Ethernet affords a one-wire solution for connecting Crestron touch screens, gateways, and other devices, delivering power and data over a single CAT5/6 network cable. All 5 ports are Gigabit capable to ensure maximum bandwidth for multimedia and critical control data.

Using the CEN-SW-POE-5, there is no need to install a separate power supply at each network device location. The CEN-SW-POE-5 can simply be mounted at a convenient location on a wall or in an equipment rack, providing a single power source for four separate 802.3af compliant PoE powered devices. Non-PoE devices may also be connected to any port on the CEN-SW-POE-5 without risk of damage to either component.



### SPECIFICATIONS

#### Ethernet

C. McGuire

48VDC: (1) 4-pin (2x2) rectangular connector;  
48 Volt DC power input (power pack included)

Ports: (5) 10Base-T/100Base-TX/1000Base-T Ethernet

DATE: MAY 17th, 2017

Network Standards: IEEE 802.3, 802.3u, 802.3ab, 802.3a, & 802.3ai

Transmission Method: Store and Forward

#### Power requirements

#### Indicators

##### \* MODIFICATIONS:

1. Provide more information on the GLA-PWS50 for contractors.
2. Contractor to coordinate installation on site with reference to slab conduits that are currently installed.
3. If changes are required to the network layout shown in this shop drawing, the changes are to be marked up or drawings updated for the final As-Built submission for this project.
4. Electrical to coordinate with system supplier to ensure a complete and operational system is achieved.
5. Coordinate changes to drawings with contractors comments provided to you on May 9th, 2017.

1.5Amps @ 48 Volts DC;  
/60 Hz power pack included

PoE 1 – 4: (4) green LEDs each corresponding to port

Uplink: (1) green LED for speed, and activity

1 – 4: (1) green LED indicate Ethernet link on corresponding port

Power: (1) yellow LED indicates power pack

Operating Temperature: 32 to 104°F (0° to 40°C)  
Relative Humidity: 5 to 95% RH (non-condensing)  
Air Flow: 100 CFM BTU/hour

#### Connectors

Uplink: (1) 8-wire RJ45 10Base-T/100Base-TX

1 – 4: (4) 8-wire RJ45 10Base-T/100Base-TX Sourcing Equipment

Finish: Powder coat black finish, with (2) integral mounting flanges, vented top for surface mounting, surface mount, or attach to a single rack rail

G: (1) 6-32 screw, chassis ground lug

13.5 oz (381 g)

# CEN-SW-POE-5 5-Port PoE Switch

## MODELS & ACCESSORIES

### Available Models

CEN-SW-POE-5: 5-Port PoE Switch

Notes:

This product may be purchased from an authorized Crestron dealer. To find a dealer, please contact the Crestron sales representative for your area. A list of sales representatives is available online at [www.crestron.com/salesreps](http://www.crestron.com/salesreps) or by calling 800-237-2041.

The specific patents that cover Crestron products are listed online at: [patents.crestron.com](http://patents.crestron.com).

Crestron and the Crestron logo are either trademarks or registered trademarks of Crestron Electronics, Inc. in the United States and/or other countries. Other trademarks, registered trademarks, and trade names may be used in this document to refer to either the entities claiming the marks and names or their products. Crestron disclaims any proprietary interest in the marks and names of others. Crestron is not responsible for errors in typography or photography. Specifications are subject to change without notice. ©2014 Crestron Electronics, Inc.

- REVIEWED
- REVIEWED AND MODIFIED
- REVISE AND RESUBMIT
- NOT REVIEWED

The review by JRP Engineering is for the sole purpose of ascertaining conformance with the general design concept. This review shall not mean the detail design inherent in the shop drawings are approved, responsibility of which shall remain with the Contractor submitting same and review shall not relieve the Contractor of this responsibility for errors or omissions in the shop drawings or his responsibility for meeting all requirements of the Contract Documents. The Contractor is responsible for dimensions to be confirmed and correlated at the job site, for information that pertains solely to fabrication processes or to techniques of construction and installation and for co-ordination of the work of all sub-trades.

JRP Engineering

C.McGuire RON


CEN-SW-POE-5

Power over Ethernet

DATE: MAY 17th, 2017

#### \* MODIFICATIONS:

1. Provide more information on the GLA-PWS50 for contractors.
2. Contractor to coordinate installation on site with reference to slab conduits that are currently installed.
3. If changes are required to the network layout shown in this shop drawing, the changes are to be marked up or drawings updated for the final As-Built submission for this project.
4. Electrical to coordinate with system supplier to ensure a complete and operational system is achieved.
5. Coordinate changes to drawings with contractor comments provided to you on May 9th, 2017.

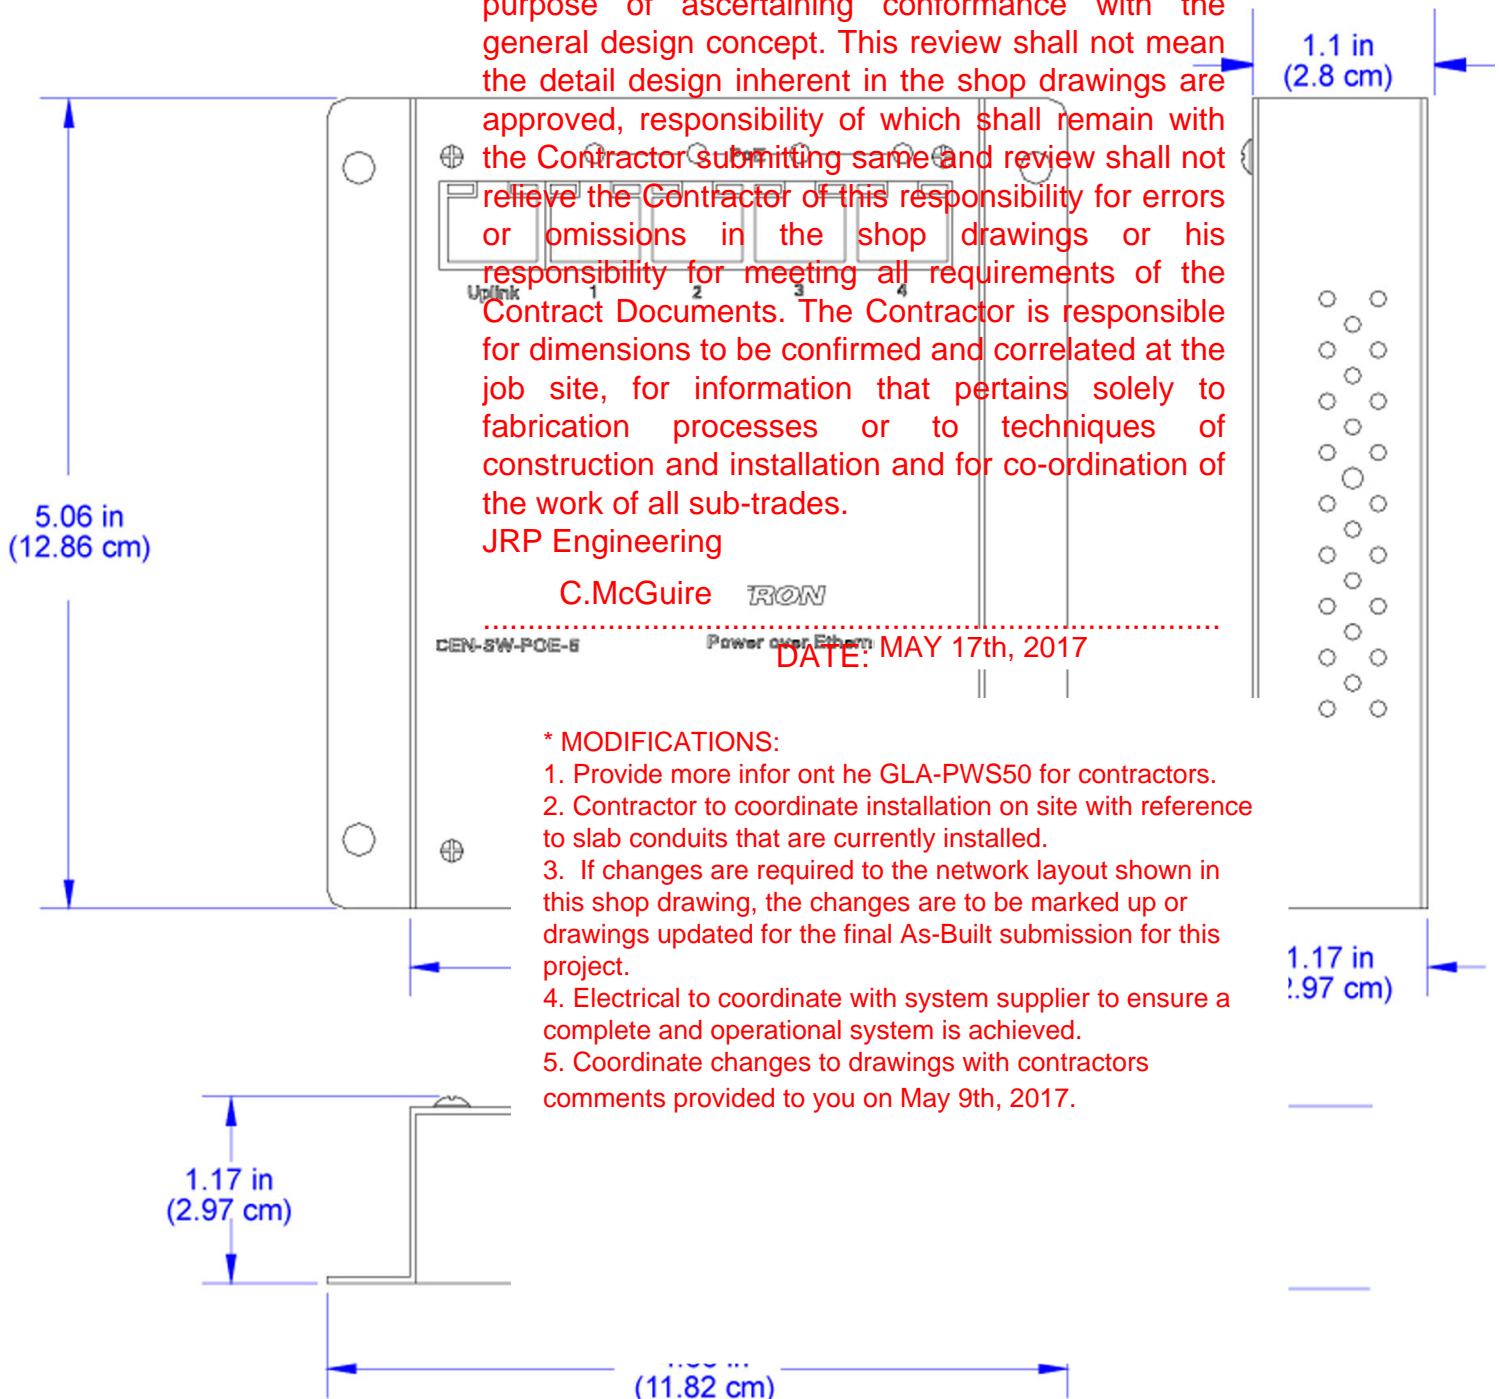

# DIN-PWS50

## DIN Rail 50 Watt Cresnet Power Supply

The DIN-PWS50 is a 50 Watt Cresnet Power Supply module designed to snap onto a standard DIN rail for installation in a wall mount enclosure. DIN rail mounting enables modular installation alongside Crestron DIN Rail lighting and automation control modules and other third-party DIN rail mountable devices. All wiring connections are made using screw terminals positioned along the top and bottom, clearly accessible from the front for easy installation and servicing. Three (3) Cresnet power ports are provided.

> 50 Watt Cresnet power supply module  
> Powers the DIN-AP2 Automation Processor and other Cresnet devices

> Includes 3 Cresnet power ports  
> Cresnet data passes through unaffected  
> Dual line power input terminals for easy daisy-chaining  
> 6M wide DIN rail mounting

### SPECIFICATIONS

#### Output Power

Per Output Port: 50 Watts (2.08 Amps @ 24 Volts DC, Regulated), limited power source

**Module Total:** 50 Watts (2.08 Amps @ 24 Volts DC, Regulated)

**Ripple/Noise:** <1%

#### Power Requirements

**Line Power:** 60 Watts @ 100-240 Volts AC, 50/60 Hz

#### Connections

**100-240V~50/60 Hz:** (1) set of (3) captive screw terminals; Line power input, neutral, and ground with pass-through; Maximum Wire Size: 12 AWG (2.5 mm<sup>2</sup>)

**NET:** (3) 4-pin 3.5mm detachable terminal blocks, paralleled; Cresnet power output ports with data pass-through

**FUSE:** DC output fuse, T3.15AH;

(5x20mm, 250V, 3.15A, time-lag, ceramic cartridge)

#### LED Indicators

**24VDC:** (1) green LED, indicates 24 Volts DC output at all NET ports; Remains lit when fuse is blown

#### Enclosure

Light gray polycarbonate housing with polycarbonate label overlay, UL94 V-0 rated, 35mm DIN EN 60715 rail mount, DIN 43880 form factor for enclosures with 45mm front panel cutout, occupies 6 DIN module spaces (108mm)

#### Environmental

**Temperature:** 32° to 104°F (0° to 40°C)

**Humidity:** 10% to 90% RH (non-condensing)

**Heat Dissipation:** 26 BTU/hr

- REVIEWED
- REVIEWED AND MODIFIED
- REVISE AND RESUBMIT
- NOT REVIEWED

The review by JRP Engineering is for the sole purpose of ascertaining conformance with the general design concept. This review shall not mean the detail design inherent in the shop drawings are approved, responsibility of which shall remain with the Contractor submitting same and review shall not relieve the Contractor of this responsibility for errors or omissions in the shop drawings or his responsibility for meeting all requirements of the Contract Documents. The Contractor is responsible for dimensions to be confirmed and correlated at the job site, for information that pertains solely to fabrication processes or to techniques of construction and installation and for co-ordination of the work of all sub-trades.

JRP Engineering

Available Models  
DIN-PWS50 (6501742): DIN Rail 50 Watt Cresnet Power Supply

C.McGuire


DATE: MAY 17th, 2017

#### \* MODIFICATIONS:

1. Provide more information on the GLA-PWS50 for contractors.
2. Contractor to coordinate installation on site with reference to slab conduits that are currently installed.
3. If changes are required to the network layout shown in this shop drawing, the changes are to be marked up on drawings updated for the final As-Built submission for this project.
4. Electrical to coordinate with system supplier to ensure a complete and operational system is achieved.
5. Coordinate changes to drawings with contractor comments provided to you on May 9th, 2017.

# DIN-PWS50DIN Rail 50 Watt Cresnet Power Supply

## DIN Rail Automation System

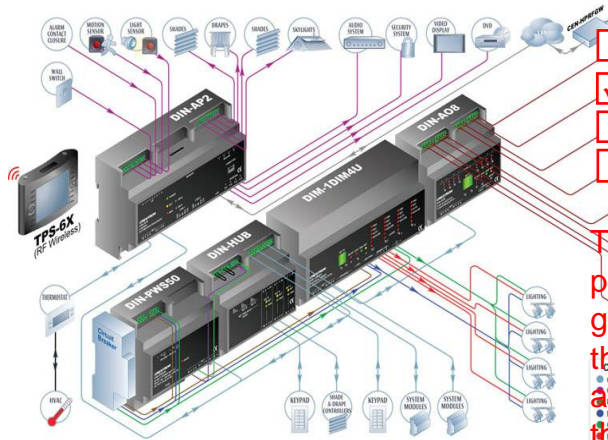

REVIEWED  
 REVIEWED AND MODIFIED  
 REVISE AND RESUBMIT  
 NOT REVIEWED

The review by JRP Engineering is for the sole purpose of ascertaining conformance with the general design concept. This review shall not mean the detail design inherent in the shop drawings are approved, responsibility of which shall remain with the Contractor submitting same and review shall not relieve the Contractor of this responsibility for errors or omissions in the shop drawings or his responsibility for meeting all requirements of the Contract Documents. The Contractor is responsible for dimensions to be confirmed and correlated at the job site, for information that pertains solely to fabrication processes or to techniques of construction and installation and for co-ordination of the work of all sub-trades.

JRP Engineering


C.McGuire

DATE: MAY 17th, 2017

### \* MODIFICATIONS:

1. Provide more information on the GLA-PWS50 for contractors.
2. Contractor to coordinate installation on site with reference to slab conduits that are currently installed.
3. If changes are required to the network layout shown in this shop drawing, the changes are to be marked up or drawings updated for the final As-Built submission for this project.
4. Electrical to coordinate with system supplier to ensure a complete and operational system is achieved.
5. Coordinate changes to drawings with contractors comments provided to you on May 9th, 2017.

# DIN-PWS50DIN Rail 50 Watt Cresnet Power Supply

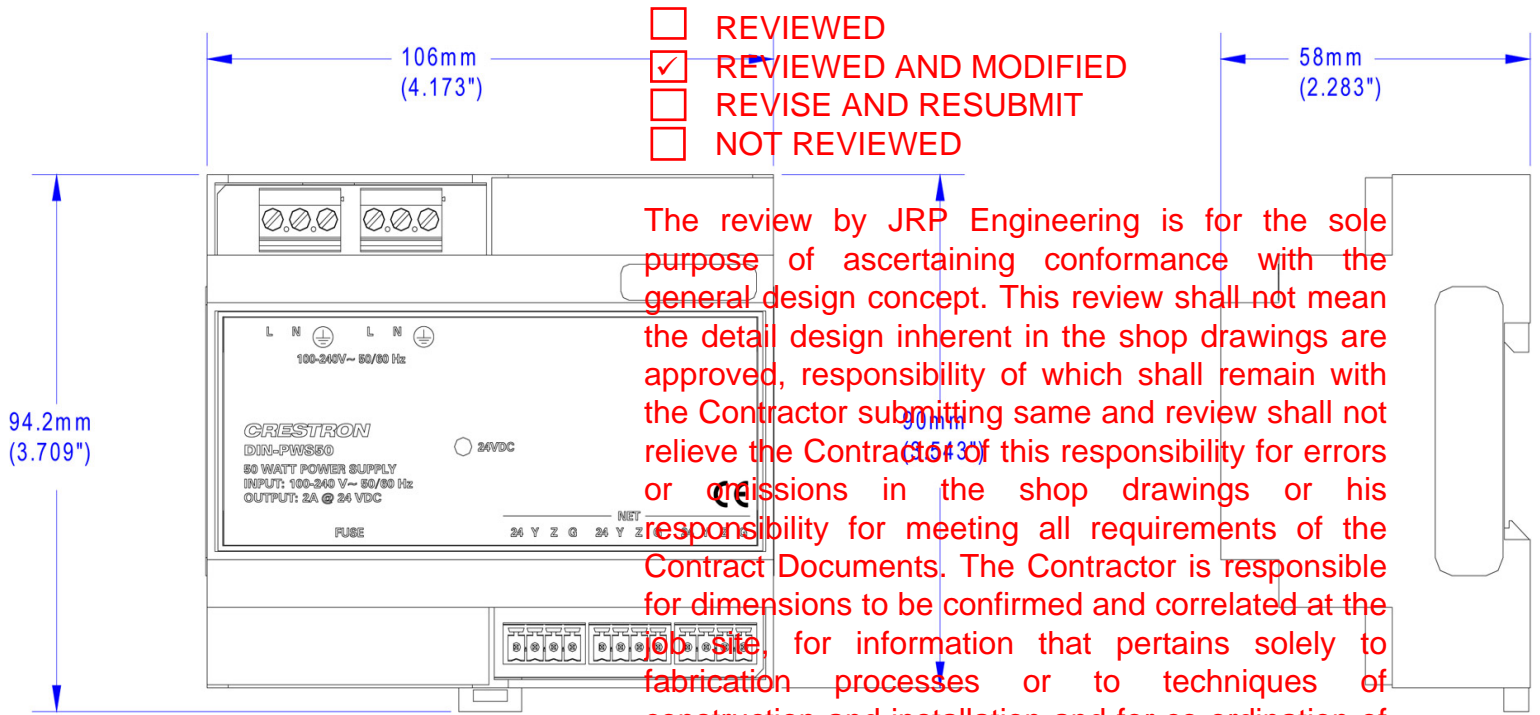


The review by JRP Engineering is for the sole purpose of ascertaining conformance with the general design concept. This review shall not mean the detail design inherent in the shop drawings are approved, responsibility of which shall remain with the Contractor submitting same and review shall not relieve the Contractor of this responsibility for errors or omissions in the shop drawings or his responsibility for meeting all requirements of the Contract Documents. The Contractor is responsible for dimensions to be confirmed and correlated at the job site, for information that pertains solely to fabrication processes or to techniques of construction and installation and for co-ordination of the work of all sub-trades.

JRP Engineering

C.McGuire

DATE: MAY 17th, 2017

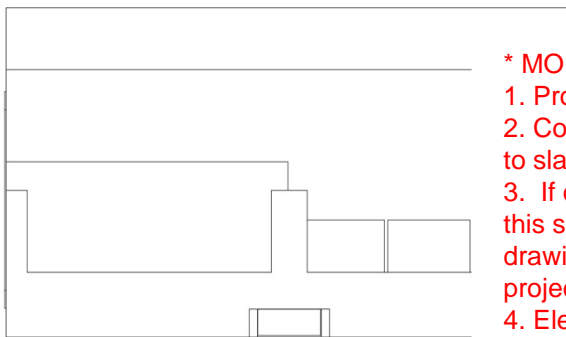

\* MODIFICATIONS:

1. Provide more information on the GLA-PWS50 for contractors.
2. Contractor to coordinate installation on site with reference to slab conduits that are currently installed.
3. If changes are required to the network layout shown in this shop drawing, the changes are to be marked up or drawings updated for the final As-Built submission for this project.
4. Electrical to coordinate with system supplier to ensure a complete and operational system is achieved.
5. Coordinate changes to drawings with contractors comments provided to you on May 9th, 2017.

## DIN Rail Cresnet® Distribution Hub

REVIEWED

REVIEWED AND MODIFIED

REVISE AND RESUBMIT

NOT REVIEWED

- > 3-segment Cresnet® Hub
- > For Cresnet networks with more than 120 devices
- > Configurable for 1, 2, or 3 segments
- > No programming required
- > 6M wide DIN rail mounting

The review by JRP Engineering is for the sole purpose of ascertaining conformance with the general design concept. This review shall not mean the detail design inherent in the shop drawings are approved, the responsibility of which shall remain with the Contractor submitting same and review shall not relieve the Contractor of this responsibility for errors or omissions in the shop drawings or his responsibility for meeting all requirements of the Contract Documents. The Contractor is responsible for dimensions to be confirmed and correlated at the job site for information that pertains solely to construction and installation and for co-ordination of the work of all sub-trades.

### 3-Segment Cresnet® Hub

Cresnet is the communications backbone for Crestron lighting modules, wall box dimmers, shade controllers, thermostats, keypads, touchpanels, and many other devices. This flexible wiring normally supports approximately 20 Cresnet devices without requiring a hub. Larger systems are easily enabled by adding the DIN-HUB. The DIN-HUB features 3 isolated Cresnet segments, each supporting an additional 20 devices, allowing for systems of approximately 80 devices total (including the "host" segment). Multiple hubs may be added to allow up to a maximum potential of 252 devices.\*

### Cresnet Power Distribution

In addition to data, Cresnet carries 24 Volts DC for powering the devices connected to it. The DIN-HUB provides an easy way to manage the distribution of power in a Cresnet network. Each segment can be configured to receive its power from the "host" segment, or from another power supply. Separate power supplies may be dedicated to each segment, or a single supply can be shared amongst multiple segments as needed. Each

### DIN Rail Installation

The DIN-HUB is designed to be installed in a wall mount or a panel mount. The DIN-HUB is made using a clear polycarbonate housing with a polycarbonate label overlay, 35mm DIN EN 60715 rail mount, DIN 43880 form factor with 45mm front panel cutout, occupies 6 DIN module units.

### SPECIFICATIONS

#### Connectivity

**NET HOST:** (2)

Connects to 1 or 2 external Cresnet power supplies, or to host power source via jumpers, to power Cresnet devices connected to the NET A-C ports;

**NET PWR IN:** (1)

Connects to 1 external Cresnet power supply, or to host power source via jumpers, to power Cresnet devices connected to the NET A-C ports;

**NET A-C:** (6)

Connects to 6 external Cresnet power supplies, or to host power source via jumpers, to power Cresnet devices connected to the NET A-C ports;

**NET HOST, PWR:** (1 Green)


Indicates Cresnet power is supplied to unit via either NET HOST port

**NET HOST, NET:** (1 Yellow)

Indicates Cresnet bus activity at either NET HOST port

#### \* MODIFICATIONS:

1. Provide more information on the GLA-PWS50 for contractors.
  2. Contractor to coordinate installation on site with reference to slab conduits that are currently installed.
  3. If changes are required to the network layout shown in this shop drawing, the changes are to be marked up or drawings updated for the final As-Built submission for this project.
  4. Electrical to coordinate with system supplier to ensure a complete and operational system is achieved.
  5. Coordinate changes to drawings with contractors
- Comments provided to you on May 9th, 2017.

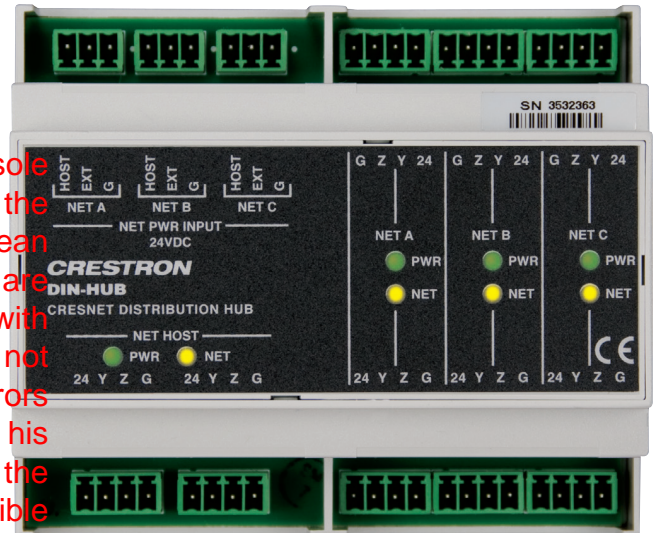

**NET A – C:** (6) 4-pin 3.5mm detachable terminal blocks comprising (2) Cresnet ports (paralleled) per each of (3) segments

#### LED Indicators

**NET HOST, PWR:** (1 Green) Indicates Cresnet power is supplied to unit via either NET HOST port

**NET HOST, NET:** (1 Yellow) Indicates Cresnet bus activity at either NET HOST port

**NET A – C, PWR:** (3 Green) Indicate Cresnet power is available at NET ports of corresponding hub segment

**NET A – C, NET:** (3 Yellow) Indicate Cresnet bus activity at NET ports of hub segment

#### Requirements

Usage: 0.6 Watts (0.03 Amps @ 24 Volts DC)

#### Installation

Temperature: 32° to 104° F (0° to 40° C)

Humidity: up to 90% RH (non-condensing)

Power: 2 BTU/hr

carbonate housing with polycarbonate label overlay, 35mm DIN EN 60715 rail mount, DIN 43880 form factor with 45mm front panel cutout, occupies 6 DIN module units.

#### Dimensions

Height: 1.50 in (3.81 cm)

Width: 4.10 in (10.60 cm)

Depth: 2.28 in (5.80 cm)

## Weight

6.0 oz (169 g)

\* The actual number of possible devices per segment and per network may vary depending upon the length and geometry of network wiring, and the power requirements of every device. A general rule of thumb suggests approximately 20 devices, an aggregate of 3000 feet of cable, and up to a 75 Watt load per segment (wiring and devices permitting). In case, 25 is the maximum number of possible devices on a complete Cresnet network. Contact Crestron True Blue Support for further design assistance.

REVIEWED  
 REVIEWED AND MODIFIED  
 REVISE AND RESUBMIT  
 NOT REVIEWED

## MODELS & ACCESSORIES

### Available Models

DIN-HUB: DIN-Rail Cresnet® Distribution Hub

The review by JRP Engineering is for the sole purpose of ascertaining conformance with the general design concept. This review shall not mean the detail design inherent in the shop drawings are approved, responsibility of which shall remain with the Contractor submitting same and review shall not relieve the Contractor of this responsibility for errors or omissions in the shop drawings or his responsibility for meeting all requirements of the Contract Documents. The Contractor is responsible for dimensions to be confirmed and correlated at the job site, for information that pertains solely to fabrication processes or to techniques of construction and installation and for co-ordination of the work of all sub-trades.

JRP Engineering

C.McGuire


.....  
DATE: MAY 17th, 2017

### \* MODIFICATIONS:

1. Provide more information on the GLA-PWS50 for contractors.
2. Contractor to coordinate installation on site with reference to slab conduits that are currently installed.
3. If changes are required to the network layout shown in this shop drawing, the changes are to be marked up or drawings updated for the final As-Built submission for this project.
4. Electrical to coordinate with system supplier to ensure a complete and operational system is achieved.
5. Coordinate changes to drawings with contractors comments provided to you on May 9th, 2017.

# DIN-HUB DIN Rail Cresnet® Distribution Hub

## APPLICATION DIAGRAM

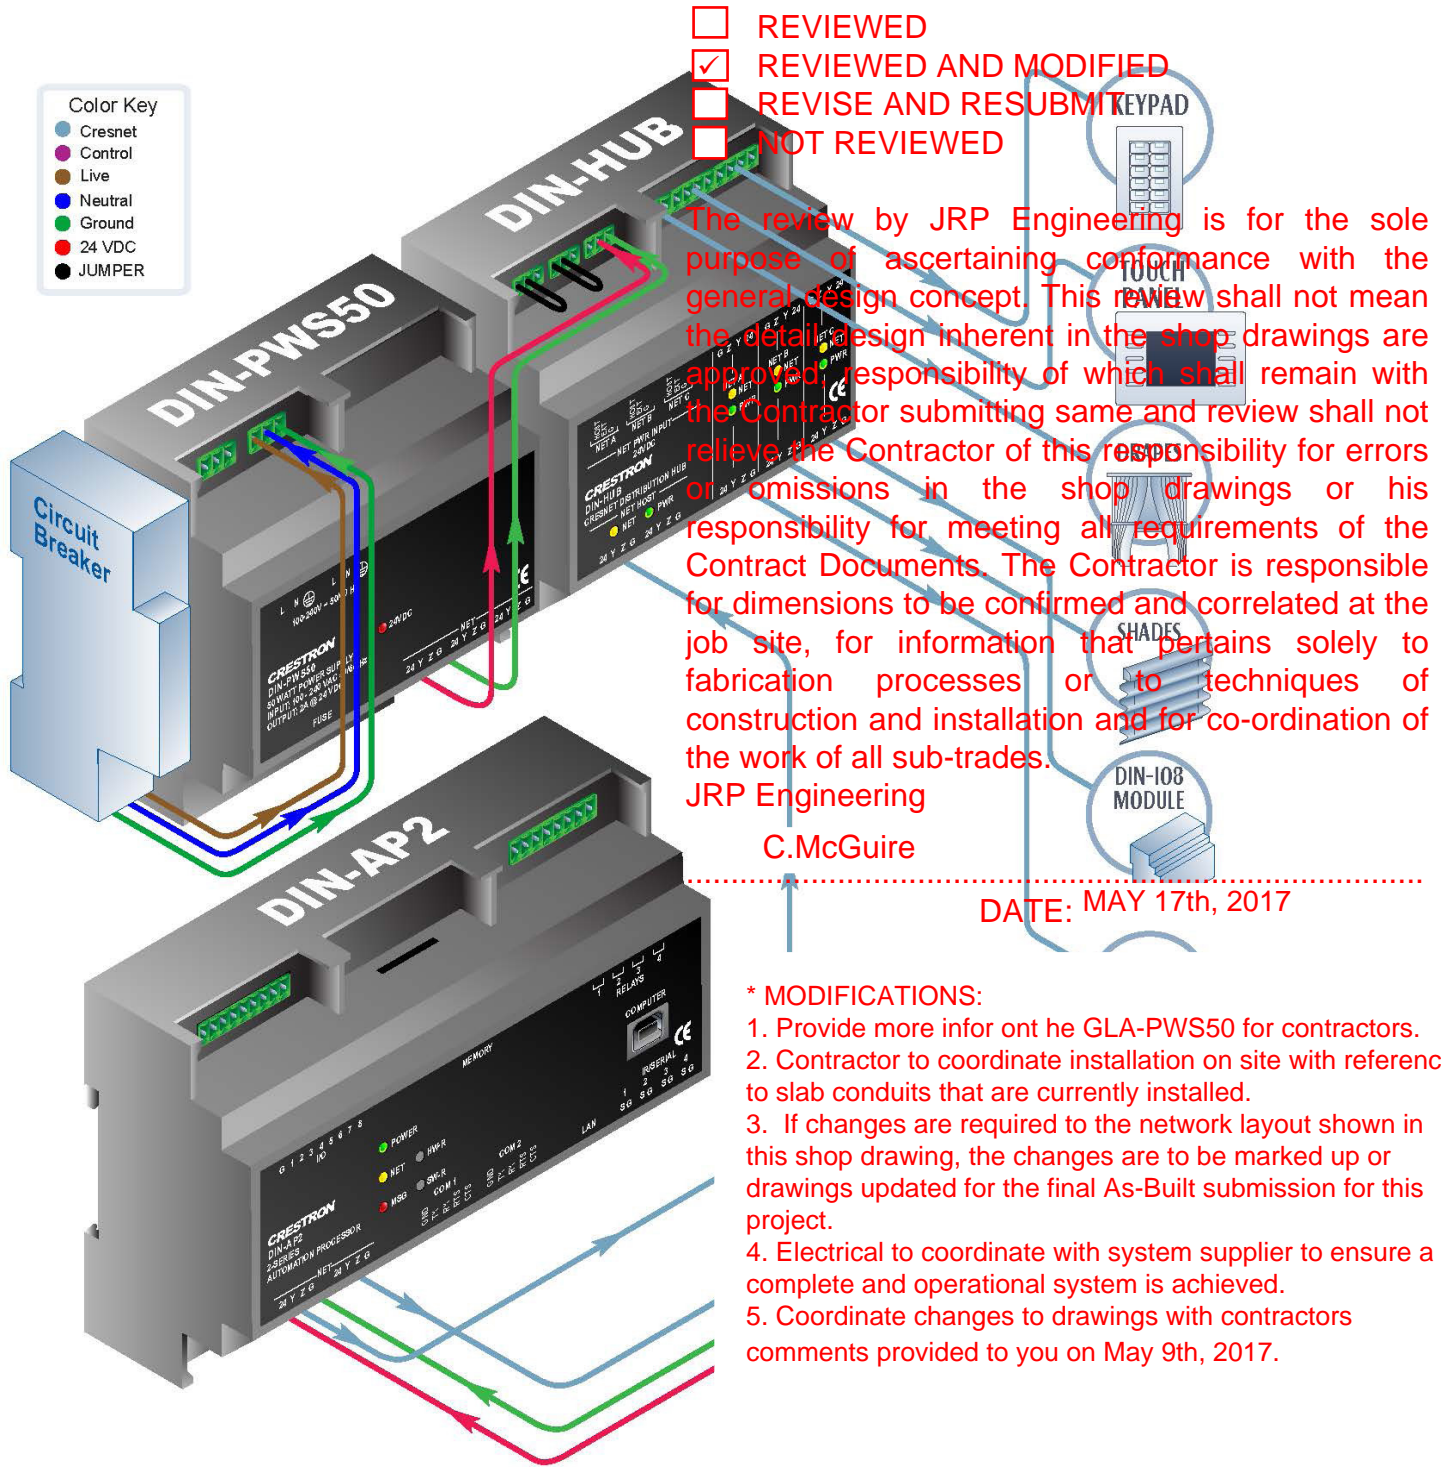

## Crestron Control® for Computers

- > Enables virtual Crestron® touch screen control on a computer
- > Compatible with Windows® and Mac® platforms
- > Runs as a desktop application or in a Web browser
- > Supports Smart Graphics™
- > Programmed just like a Crestron touch screen or mobile app
- > Can be generated instantly from an existing touch screen or mobile project
- > Communicates directly over IP with a Crestron control system
- > No special servers or service fees required



REVIEWED  
 REVIEWED AND MODIFIED  
 REVISE AND RESUBMIT  
 NOT REVIEWED

The review by JRP Engineering is for the sole purpose of ascertaining conformance with the general design concept. This review shall not mean the detail design inherent in the shop drawings are approved, responsibility of which shall remain with the contractor submitting same and review shall not relieve the Contractor of his responsibility for errors or omissions in the shop drawings or his responsibility for meeting all requirements of the Control System Documents. The Contractor is responsible for dimensions to be confirmed and correlated at the job site for information that pertains solely to construction and installation and for coordination of the work of all sub-trades.

Transform any computer into a virtual Crestron® touch screen with XPanel.

Crestron XPanel lets you control anything in your home, office or classroom using a laptop or desktop computer running Windows® or Mac®. XPanel works on any computer platform and any screen size using a mouse, touch screen monitor, or other pointing device. It can be installed and run as a desktop application or you can launch it in a Web browser. Use XPanel as a low-cost control solution for a small classroom AV system, to monitor your home from the office, as an interactive kiosk in a lobby or museum exhibit, or to enable centralized control of lighting and climate control in an office building or conference center. For virtually any application, XPanel provides a robust and scalable IP based control solution.

Programming for XPanel is the same as for a Crestron touch screen, smartphone, or tablet, allowing a computer-based user interface with the same look and feel as any other touch screen or mobile device in your system. XPanel supports touch screen experience to your computer using buttons, sliders, dynamic text, scrolling lists, and customizable themes. A touch screen project developed using Smart Graphics can be instantly transformed into an XPanel project, drag projects using Smart Graphics by simply changing the programmers to test to screen present.

Every Crestron control system is affordable to add to your computer communication system over Ethernet or serial. No special hardware are required. Establishing a control system is enabled.

Whether you just want to add a projector, or add full room control to a commercial building, XPanel is an effective option.

### Control System Compatibility

XPanel is supported on all Ethernet-enabled Crestron® control systems.

XPanel with Smart Graphics™ is supported on all 3-Series® control systems.

XPanel with Smart Graphics is supported on the following 2-Series control systems: AV2, CB2E, DMPS-100-C, DMPS-200-C, DMPS-300-C, DMPS-300-C-AEC, PAC2, PRO2, RACK2.

Please note: Smart Graphics “Applications” such as Media Player, Weather, and EnergyMonitor require a 3-Series control system.

For additional information about Smart Graphics, please refer to Crestron Help Answer ID 5188.

### \* MODIFICATIONS:

1. Provide more information on the GLA-PWS50 for contractors.
2. Contractor to coordinate installation on site with reference to slab conduits that are currently installed.
3. If changes are required to the network layout shown in this shop drawing, the changes are to be marked up or drawings updated for the final As-Built submission for this project.
4. Electrical to coordinate with system supplier to ensure a complete and operational system is achieved.
5. Coordinate changes to drawings with contractors comments provided to you on May 9th, 2017.

control system compatibility.

Programming, and other Crestron products must be purchased from an authorized dealer, please contact the Crestron sales representative for your area. Information on product availability is available online at [www.crestron.com/salesreps](http://www.crestron.com/salesreps) or by contacting your local Crestron representative.

Crestron products are listed online at: [patents.crestron.com](http://patents.crestron.com).

Crestron, Crestron Control, and Smart Graphics are either trademarks or registered trademarks of Crestron Electronics, Inc. in the United States and/or other countries. Apple, the Apple logo, and Mac OS are either trademarks or registered trademarks of Apple Inc. in the United States and/or other countries. Microsoft, Windows, and Windows Vista are either trademarks or registered trademarks of Microsoft Corporation in the United States and/or other countries. Other trademarks, registered trademarks, and trade names used herein refer to either the entities claiming the marks and names or their proprietary interest in the marks and names of others. Crestron Control is a registered trademark of Crestron Electronics, Inc. Crestron Control logo, photography or photography. Specifications are subject to change without notice. © 2015 Crestron Electronics, Inc.

## 3-Series® Native BACnet™ /IP Support



- REVIEWED
- REVIEWED AND MODIFIED
- REVISION AND RESUBMIT
- NOT REVIEWED

### One platform, complete control and automation

Crestron 3-Series® Control Systems bring all technology and devices together onto a single platform so they work together seamlessly and intelligently. Anything and everything connected to a Crestron control system can be monitored, managed, and controlled — anytime, anywhere from a touch screen, laptop, or smart device.

### License

A free BACnet/IP license is available to support up to 50 objects. For systems with more than 50 objects you must purchase the full license. For details on obtaining a license and implementing BACnet/IP support, please refer to Crestron True Blue Online Help [Answer ID 5283](#).

### 3-Series® Control Systems Native BACnet™ /IP Interface

The ability for all 3-Series Control Systems to natively talk BACnet/IP is now available. This exciting feature enables you to connect all local devices to the Building Management System (BMS), as well as to control all BMS devices from a touch screen.

The 3-Series Control System® with native BACnet/IP support provides a scalable, IP-based platform for implementing fully integrated building management and automation. Integrated control of lighting, shades, HVAC, AV, BMS, security, voice & data, and other connected systems is now faster, simpler and more efficient than ever. Built-in BACnet/IP support enables seamless integration with existing building management systems. All systems run independently and communicate with each other on the same platform, creating a truly smart building.

**BACnet/IP support is NOW AVAILABLE for the following 3-Series control systems:**

- AV3
- CP3
- CP3N
- DIN-AP3
- DIN-AP3MEX
- DMPSB-4K-150-C
- DMPS2-800-C
- DMPS3-300-C
- FT-TSC600
- MC3
- PRO3
- BMC3
- TPCS-4SM
- TPCS-4SMD
- TSCW-730

The review by JRP Engineering is for the sole purpose of ascertaining conformance with the general design concept. This review shall not mean the detail design inherent in the shop drawings are approved, responsibility of which shall remain with the Contractor submitting same and review shall not relieve the Contractor of this responsibility for errors or omissions in the shop drawings or his responsibility for meeting all requirements of the Contract Documents. The Contractor is responsible for dimensions to be confirmed and correlated at the job site for information that pertains solely to fabrication processes or to techniques of construction and installation and for co-ordination of the work of all sub-trades.


JRP Engineering

C.McGuire

DATE: MAY 17th, 2017

#### \* MODIFICATIONS:

1. Provide more info on the GLA-PWS50 for contractors.
2. Contractor to coordinate installation on site with reference to slab conduits that are currently installed.
3. If changes are required to the network layout shown in this shop drawing, the changes are to be marked up or drawings updated for the final As-Built submission for this project.
4. Electrical to coordinate with system supplier to ensure a complete and operational system is achieved.
5. Coordinate changes to drawings with contractors comments provided to you on May 9th, 2017.

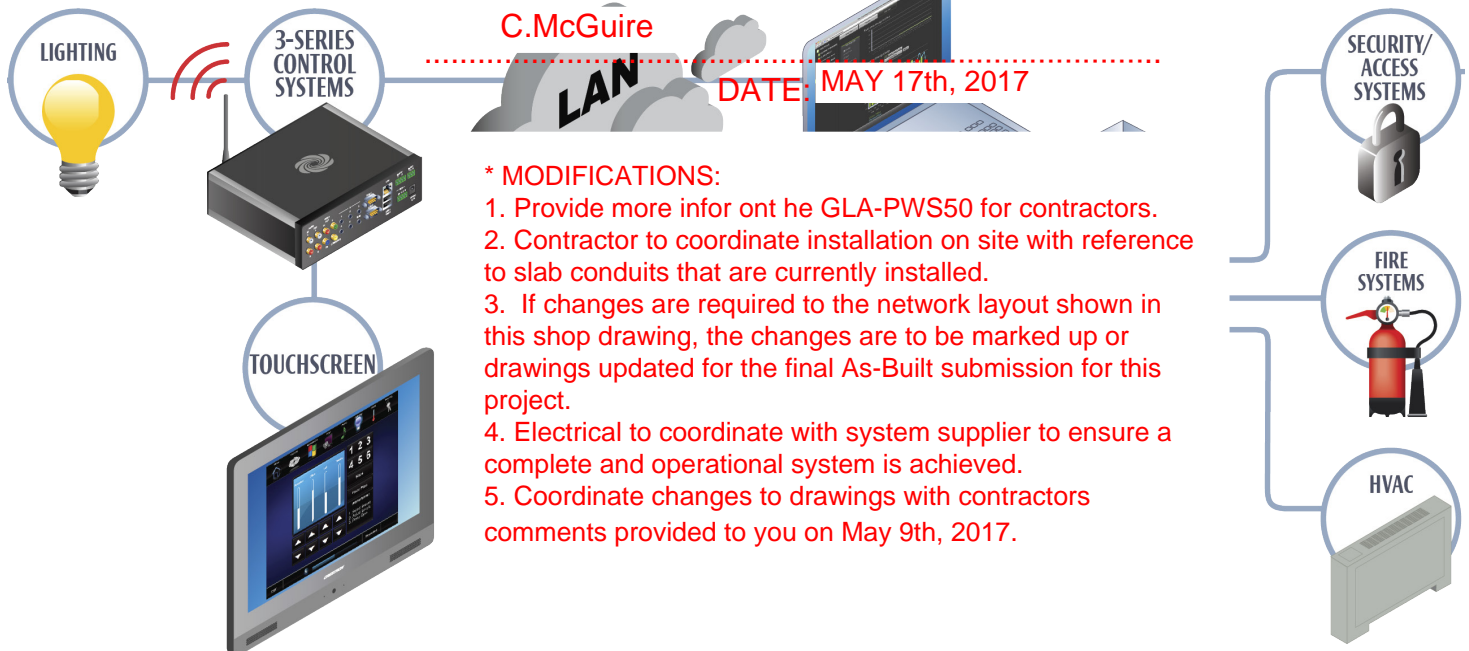

# 3-Series® Native BACnet™/IP Support

## System Design & Programming Considerations

Please note the following limits when designing or programming your control system. Actual capabilities are contingent upon the overall program size and complexity. The following limits assume the control system is dedicated for BACnet use only with no other significant control system functions:

- FT-TSC600, TPCS-4SM, TPCS-4SMD, & CW-730: 250 objects maximum
- DIN-AP3, DIN-AP3MEX, DMPS3-4K-150-C, DMPS3-200-C, DMPS3-300-C, MC3, & RMC3: 500 objects maximum
- CP3 & CP3N: 1000 objects maximum
- AV3 & PRO3: 2000 objects maximum

## MODELS

### Available Models

SW-3SERIES-BACNET-50+: BACnet™/IP Support for 3-Series® Full license for more than 50 objects

## Notes:

This product may be purchased from an authorized Crestron dealer. To find a dealer, please contact the Crestron sales representative for your area. A list of sales representatives is available online at [www.crestron.com/salesreps](http://www.crestron.com/salesreps) or by calling 800-237-2041.

The specific patents that cover Crestron products are listed online at: [patents.crestron.com](http://patents.crestron.com).

Crestron, the Crestron logo, 3-Series, and 3-Series Control System are either trademarks or registered trademarks of Crestron Electronics, Inc. in the United States and/or other countries. BACnet and the BACnet logo are either trademarks or registered trademarks of American Society of Heating, Refrigerating and Air-Conditioning Engineers, Inc. in the United States and/or other countries. Other trademarks, registered trademarks, and trade names may be used in this document to refer to either the entities claiming the marks and names or their products. Crestron disclaims any proprietary interest in the marks and names of others. Crestron is not responsible for errors or omissions in this document. Specifications are subject to change without notice. ©2015 Crestron Electronics, Inc.

REVIEWED  
 REVIEWED AND MODIFIED  
 REVISE AND RESUBMIT  
 NOT REVIEWED

The review by JRP Engineering is for the sole purpose of ascertaining conformance with the general design concept. This review shall not mean the detail design inherent in the shop drawings are approved, responsibility of which shall remain with the Contractor submitting same and review shall not relieve the Contractor of this responsibility for errors or omissions in the shop drawings or his responsibility for meeting all requirements of the Contract Documents. The Contractor is responsible for dimensions to be confirmed and correlated at the job site, for information that pertains solely to fabrication processes or to techniques of construction and installation and for co-ordination of the work of all sub-trades.

JRP Engineering

C.McGuire

DATE: MAY 17th, 2017

### \* MODIFICATIONS:

1. Provide more information on the GLA-PWS50 for contractors.
2. Contractor to coordinate installation on site with reference to slab conduits that are currently installed.
3. If changes are required to the network layout shown in this shop drawing, the changes are to be marked up or drawings updated for the final As-Built submission for this project.
4. Electrical to coordinate with system supplier to ensure a complete and operational system is achieved.
5. Coordinate changes to drawings with contractors comments provided to you on May 9th, 2017.

# GLPAC-DIMFLV

## Crestron Green Light® Integrated Lighting System

- > Up to 8 channels of 0-10 Volt dimming control
- > Works in 100 to 277 VAC systems
- > 16-Amp load rating
- > Built-in Control System with DALI, DMX, and Ethernet
- > UL924 compliant emergency lighting
- > Programmable astronomical time clock for scheduled events
- > Preloaded program for quick setup
- > Optional real-time power monitoring per channel
- > Supports keypad control, occupancy sensing, and daylight harvesting for up to 4 rooms
- > Positive air gap at each output
- > Phase-independent channels
- > Local controls for setup, testing, and verification
- > Local and remote override capability
- > Non-volatile power failure memory
- > High-speed Ethernet LAN port
- > CEC Title 24 2013 Compliant

- REVIEWED
- REVIEWED AND MODIFIED
- REVISE AND RESUBMIT
- NOT REVIEWED



The review by JRP Engineering is for the sole purpose of ascertaining conformance with the general design concept. This review shall not mean the detail design inherent in the shop drawings are approved, responsibility of which shall remain with the Contractor submitting same and review shall not relieve the Contractor of this responsibility for errors or omissions in the shop drawings or his responsibility for meeting all requirements of the Contract Documents. The Contractor is responsible for dimensions to be confirmed and correlated at the job site for information that pertains solely to fabrication processes or to techniques of construction and installation and for co-ordination of the work of all sub-trades.

The GLPAC-DIMFLV is a Crestron Green Light® integrated lighting system designed for use as a standalone lighting controller in classrooms, conference rooms, and other facilities. It provides eight channels of 0-10 Volt dimming control, each GLPAC-DIMFLV also provides a link to a centralized Crestron® lighting control system. Add optional real-time power monitoring and Fusion EM® Energy Management Software to help track and minimize energy usage throughout a facility. Crestron® and Ethernet connectivity afford extensive system integration when using keypads, touch screens, shade controllers, and other Crestron® devices.

### Emergency Configuration

The GLPAC-DIMFLV 4E Series model features built-in voltage barriers that isolate four of its eight output channels. This configuration allows loads such as emergency lighting and exit signs to be supplied from two asynchronous sources.

### Built-in Power Monitoring

Optional power monitoring tracks the real time energy usage of each load and delivers energy consumption statistics to the user to help control energy costs. By analyzing real data, organizations can make more educated decisions regarding energy resources, which will have greater impact on the bottom line.

### Easy Deployment

In a standard enclosure, the GLPAC-DIMFLV can be deployed in small spaces, including plenum ceilings. The surface-mount GLPAC-DIMFLV can be affixed to a wall or ceiling rafter, cleanly out of sight. Mounting brackets are provided.

### Flexibility

Each GLPAC-DIMFLV can be independent rooms. Single-room installations with no additional configuration system adjustments are achieved via the built-in GLPAC-DIMFLV or via the built-in GLPAC-DIMFLV is a Crestron customization is possible for

### Astronomical Time Clock

Scheduled events may be programmed to an astronomical time clock for specific times or at an offset

### Save Energy

Built-in support for occupancy sensing energy costs. Automatically maintain balanced bulb brightness. Crestron GLS Series sensor can maximize the benefits of energy

### \* MODIFICATIONS:

1. Provide more information on the GLA-PWS50 for contractors.
  2. Contractor to coordinate installation on site with reference to slab conduits that are currently installed.
  3. If changes are required to the network layout shown in this shop drawing, the changes are to be marked up or drawings updated for the final As-Built submission for this project.
  4. Electrical to coordinate with system supplier to ensure a complete and operational system is achieved.
  5. Coordinate changes to drawings with contractors
- comments provided to you on May 9th, 2017.

DATE: MAY 17th, 2017

Crestron Green Light commercial lighting  
Crestron Sales Support Services.

- MFLV4 Series: 4
- MFLV8 Series: 8
- MFLV8-4E Series: 4 and 4, isolated
- 100 to 277 Volts AC, 50/60 Hz
- Fluorescent ballast or LED driver (4-wire);
- Incandescent, magnetic ballast, incandescent, magnetic ballast, neon/cold cathode, high-intensity

Relay Lifetime: Resistive rating: 100,000 on/off operations, 50 Amps @ 277 Volts AC

General rating: 50,000 on/off operations, 167 amps @ 120/277 Volts AC

### Power Requirements

Main Power: 100-277 Volts AC, 50/60Hz, single phase (LINE 1 NEUT)

Available Cresnet Power: 10 Watts at 24 Volts DC, shared with occupancy and photosensor ports

### Connectors (Class 1) - 4-Channel Models Only

NEUT: (2) Terminal blocks, paralleled, line input neutral  
LINE 1 - LINE 4: (8) Terminal blocks, paralleled, line power inputs  
SW1 - SW4: (4) Terminal blocks, switch channel outputs  
0-10V DIM (+,-) 1-4: (1) 8-position terminal block, dim channel output, galvanically isolated; May be wired as Class 1 or Class 2

### Connectors (Class 1) - 8-Channel Models Only

NEUT: (2) Terminal blocks, paralleled, line input neutral  
LINE 1 - LINE 8: (16) Terminal blocks; 2 connections per channel, paralleled, allows for easy daisy chaining; line power inputs  
SW1 - SW8: (8) Terminal blocks, switch channel outputs  
0-10V DIM (+,-) 1-8: (2) 8-position terminal block, dim channel output, galvanically isolated; may be wired as Class 1 or Class 2

### Connectors (Class 2)

NET SLAVE: (1) 4-pin 3.5mm detachable terminal block: Cresnet ports for connection to main control processor or other GLPAC dimmer output 24 Volts DC

OVR: (1) 2-pin 3.5mm detachable terminal block, comprising (2) inputs for external contact closures to trigger the preset Override state

NET LOCAL: (1) 4-pin 3.5mm detachable terminal block: connection to local devices such as keypads, screens; outputs 24 Volts DC

RELAY 1-4 (-PM models only): (1) 8-pin 3.5mm terminal block comprising (4) normally open, isolated contacts used for interfacing to local Variable Air Volume controllers; occupancy; Rated 1 Amp, 30 Volts DC

INPUT 1-8: (1) 9-pin 3.5mm detachable terminal block: digital input ports, referenced to ground

OCCUPANCY SENSOR INPUT 1-4: (1) 6-pin 3.5mm terminal block comprising (4) occupancy sensor inputs, (1) power port (provides sensors with power)

PHOTOCELL 1-4: (1) 6-pin 3.5mm detachable terminal block comprising (4) photocell sensor inputs, (1) +24VDC, and (1) power port (provides sensors with power); Min-change setting can be used to often sensor reports changes in values

USB: (1) USB Type B console port, for communication with Crestron Toolbox™

LAN: (1) 8-wire RJ45 with 2 LED indicators; 1 Green LED indicates link status; Yellow LED indicates activity

### Controls & Indicators

MODE: (2) 7-Segment green LED digits and (2) miniature pushbuttons for setting mode during setup or local control

VALUE: (2) 7-Segment green LED digits and (2) miniature pushbuttons for setting value

SAVE: (1) Red LED and (1) miniature pushbutton for saving settings

CANCEL: (1) Red LED and (1) miniature pushbutton for cancelling current operation

PWR: (1) Green LED; solid illumination indicates line power is applied to NEUT and LINE 1

HW R: (1) Recessed miniature pushbutton for hardware reset (reboots the processor)

SW R: (1) Recessed miniature pushbutton for software reset (restarts the SIMPL program)

NET-C: (1) Yellow LED; indicates communication with main control processor (if being used)

NET-L: (1) Yellow LED; indicates communication with local devices

MSG: (1) Red LED; indicates control system has generated an error message

OVR: (1) Red LED and (1) miniature pushbutton for enabling override mode

ON/OFF: (8) Red LEDs and (8) miniature pushbuttons for individual manual channel activation and dimming

Enclosure: Surface mount metal box enclosure, suitable for mounting in plenum airspace

### Environmental

Temperature: 32°F to 104°F (0°C to 40°C)  
Humidity: 5% to 95% (non-condensing)

REVIEWED  
REVIEWED AND MODIFIED  
REVISE AND RESUBMIT  
NOT REVIEWED  
The review by JRP Engineering is for the sole purpose of ascertaining conformance with the general design concept. This review shall not mean the detail design inherent in the shop drawings are approved, responsibility of which shall remain with the Contractor submitting same and review shall not relieve the Contractor of this responsibility for errors or omissions in the shop drawings or his responsibility for meeting all requirements of the Contract Documents. The Contractor is responsible for dimensions to be confirmed and correlated at the job site for information that pertains solely to fabrication, processes or to techniques of construction and installation and for co-ordination of the work of all sub-trades.  
JRP Engineering  
C. McGuire

### \* MODIFICATIONS:

1. Provide more information on the GLA-PWS50 for contractors.
2. Contractor to coordinate installation on site with reference to slab conduits that are currently installed.
3. If changes are required to the network layout shown in this shop drawing, the changes are to be marked up or drawings updated for the final As-Built submission for this project.
4. Electrical to coordinate with system supplier to ensure a complete and operational system is achieved.
5. Coordinate changes to drawings with contractors comments provided to you on May 9th, 2017.

according to UL508, electronic Ballasts) systems incorporated in 1p circuits or other

g System, 4-Channel

GLPAC-DIM-FLV-01: Green Light Integrated Lighting System, 4-Channel, Chicago Plenum Enclosure

# GLPAC-DIMFLV Crestron Green Light® Integrated Lighting System

- GLPAC-DIMFLV4-PM: Green Light Integrated Lighting System, 4-Channel Power Monitoring
- GLPAC-DIMFLV4-PM-CP: Green Light Integrated Lighting System, 4-Channel, Power Monitoring, Chicago Plenum Enclosure
- GLPAC-DIMFLV8: Green Light Integrated Lighting System, 8-Channel
- GLPAC-DIMFLV8-CP: Green Light Integrated Lighting System, 8-Channel, Chicago Plenum Enclosure
- GLPAC-DIMFLV8-PM: Green Light Integrated Lighting System, 8-Channel, Power Monitoring
- GLPAC-DIMFLV8-PM-CP: Green Light Integrated Lighting System, 8-Channel, Power Monitoring, Chicago Plenum Enclosure
- GLPAC-DIMFLV8-4E: Green Light Integrated Lighting System, 2 Isolated 4-Channel Outputs, UL924 Listed
- GLPAC-DIMFLV8-4E-CP: Green Light Integrated Lighting System, 2 Isolated 4-Channel Outputs, UL924 Listed, Chicago Plenum Enclosure
- GLPAC-DIMFLV8-4E-PM: Green Light Integrated Lighting System, 2 Isolated 4-Channel Outputs, UL924 Listed, Power Monitoring
- GLPAC-DIMFLV8-4E-PM-CP: Green Light Integrated Lighting System, 2 Isolated 4-Channel Outputs, UL924 Listed, Chicago Plenum Enclosure, Power Monitoring

## Available Accessories

- CNX-B2B Series: Designer Keypads
- C2N-CBD-E Series: Cameo® Express Keypads
- C2N-CBD-P Series: Cameo® Keypads, Standard Mount
- C2N-CBF-P Series: Cameo® Keypads, Flush Mount
- GLS-SIM: Crestron Green Light® Sensor Integration Module
- GLS-LEXT: Crestron Green Light® Photocell, Exterior
- GLS-LOL: Crestron Green Light® Photocell, Open-Loop
- GLS-LCL: Crestron Green Light® Photocell, Closed-Loop
- GLS-ODT-C-CN: Dual-Technology Occupancy Sensor with Cresnet®, 2000 Sq. Ft.
- GLS-ODT-C-NS: Dual-Technology Ceiling Mount Occupancy Sensor
- GLS-ODT-C-2000: Crestron Green Light® Dual-Technology Ceiling Mount Occupancy Sensor, 2000 Sq. Ft.
- GLS-ODT-W-1200: Crestron Green Light® Dual-Technology Wall Mount Occupancy Sensor, 1200 Sq. Ft.
- GLS-OIR-C-CN: Passive Infrared Occupancy Sensor with Cresnet®
- GLS-OIR-C-NS: Passive Infrared Ceiling Mount Occupancy Sensor
- GLS-OIR-W-2500: Crestron Green Light® Passive Infrared Wall Mount Occupancy Sensor, 2500 Sq. Ft.
- GLS-PLS-120/277: Power Loss Sensor, 3-Phase, 120 or 277 Volts
- DIN-PWS50: DIN Rail 50 Watt Cresnet Power Supply
- GLA-PWS50: Wall Mount 50 Watt Cresnet® Power Supply

Notes:

- REVIEWED
- REVIEWED AND MODIFIED
- REVISE AND RESUBMIT
- NOT REVIEWED

This product may be purchased from an authorized Crestron dealer. To find a dealer, please contact the Crestron Sales Representative in your area. A list of sales representatives is available online at [www.crestron.com/salesreps](http://www.crestron.com/salesreps) or by calling 800-237-2041.

The specific patents that cover Crestron products are listed online at: [patents.crestron.com](http://patents.crestron.com).

**The review by JRP Engineering is for the sole purpose of ascertaining conformance with the general design concept. This review shall not mean the detail design inherent in the shop drawings are approved responsibility of which shall remain with the Contractor submitting same and review shall not relieve the Contractor of this responsibility for errors or omissions in the shop drawings or his responsibility for meeting all requirements of the Contract Documents. The Contractor is responsible for dimensions to be confirmed and correlated at the job site, for information that pertains solely to fabrication processes or to techniques of construction and installation and for co-ordination of the work of all sub-trades.**

JRP Engineering

C.McGuire

DATE: MAY 17th, 2017



### \* MODIFICATIONS:

1. Provide more information on the GLA-PWS50 for contractors.
2. Contractor to coordinate installation on site with reference to slab conduits that are currently installed.
3. If changes are required to the network layout shown in this shop drawing, the changes are to be marked up or drawings updated for the final As-Built submission for this project.
4. Electrical to coordinate with system supplier to ensure a complete and operational system is achieved.
5. Coordinate changes to drawings with contractors comments provided to you on May 9th, 2017.

# GLPAC-DIMFLV Crestron Green Light® Integrated Lighting System

## CAD DRAWING

(GLPAC-DIMFLV8-PM SHOWN)

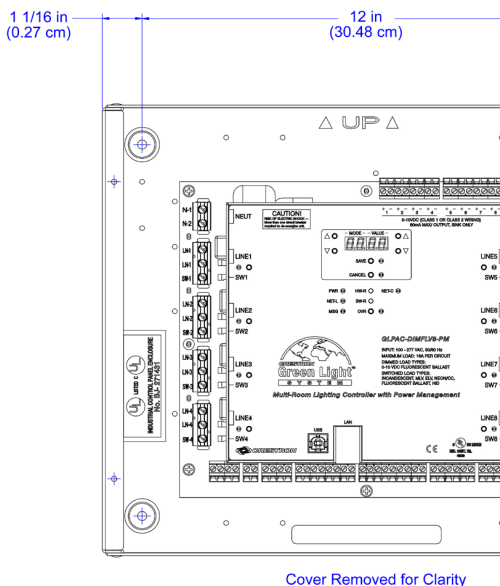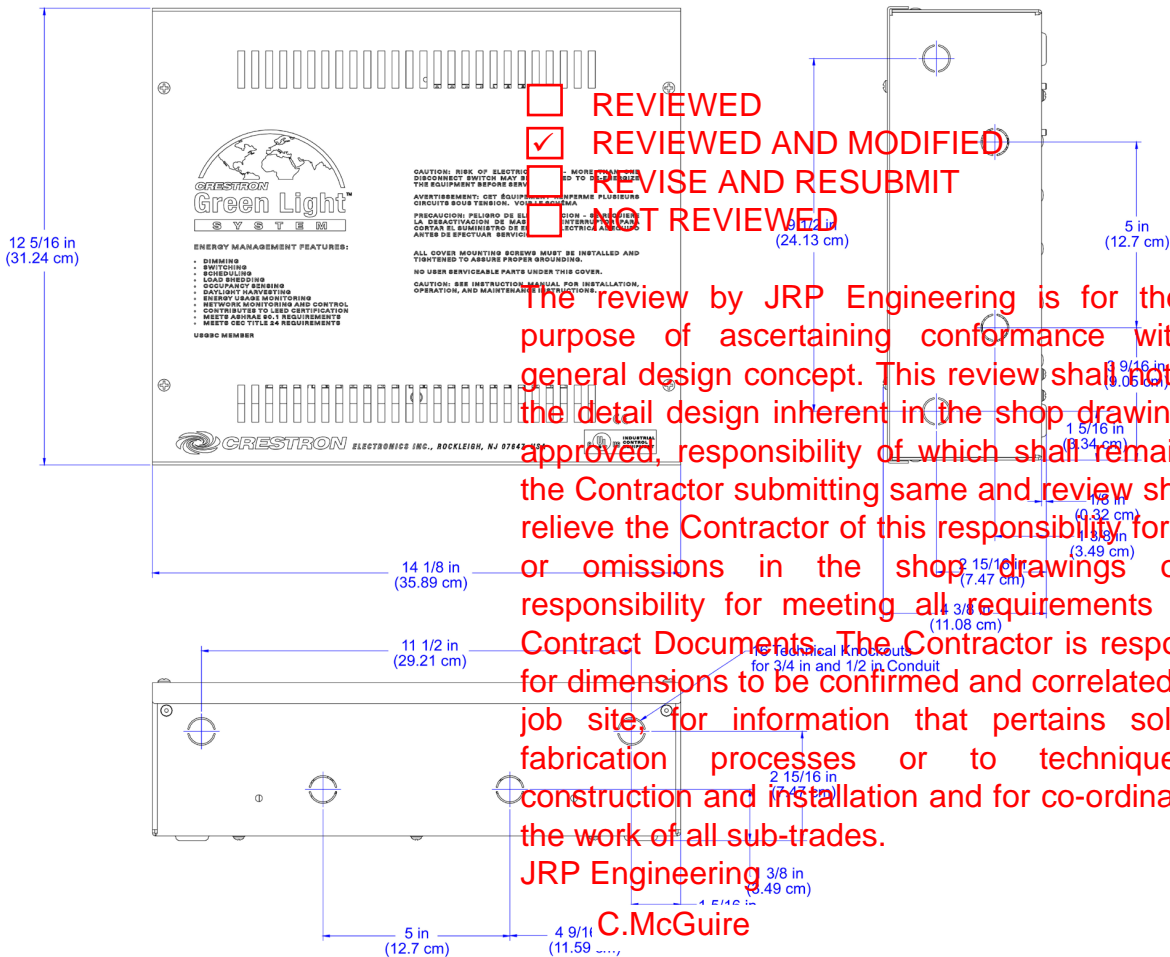

### \* MODIFICATIONS:

1. Provide more information on the GLA-PWS50 for contractors.
2. Contractor to coordinate installation on site with reference to slab conduits that are currently installed.
3. If changes are required to the network layout shown in this shop drawing, the changes are to be marked up or drawings updated for the final As-Built submission for this project.
4. Electrical to coordinate with system supplier to ensure a complete and operational system is achieved.
5. Coordinate changes to drawings with contractors comments provided to you on May 9th, 2017.

## APPLICATION DIAGRAM

- REVIEWED
- REVIEWED AND MODIFIED
- REVISE AND RESUBMIT
- NOT REVIEWED

The review by JRP Engineering is for the sole purpose of ascertaining conformance with the general design concept. This review shall not mean the detail design inherent in the shop drawings are approved, responsibility of which shall remain with the Contractor submitting same and review shall not relieve the Contractor of this responsibility for errors or omissions in the shop drawings or his responsibility for meeting all requirements of the Contract Documents. The Contractor is responsible for dimensions to be confirmed and correlated at the job site, for information that pertains solely to fabrication processes or to techniques of construction and installation and for co-ordination of the work of all sub-trades.


JRP Engineering

C. McGuire

DATE: MAY 17th, 2017

### Color Key

- Control
- Sensors
- USB
- Cresnet
- LAN

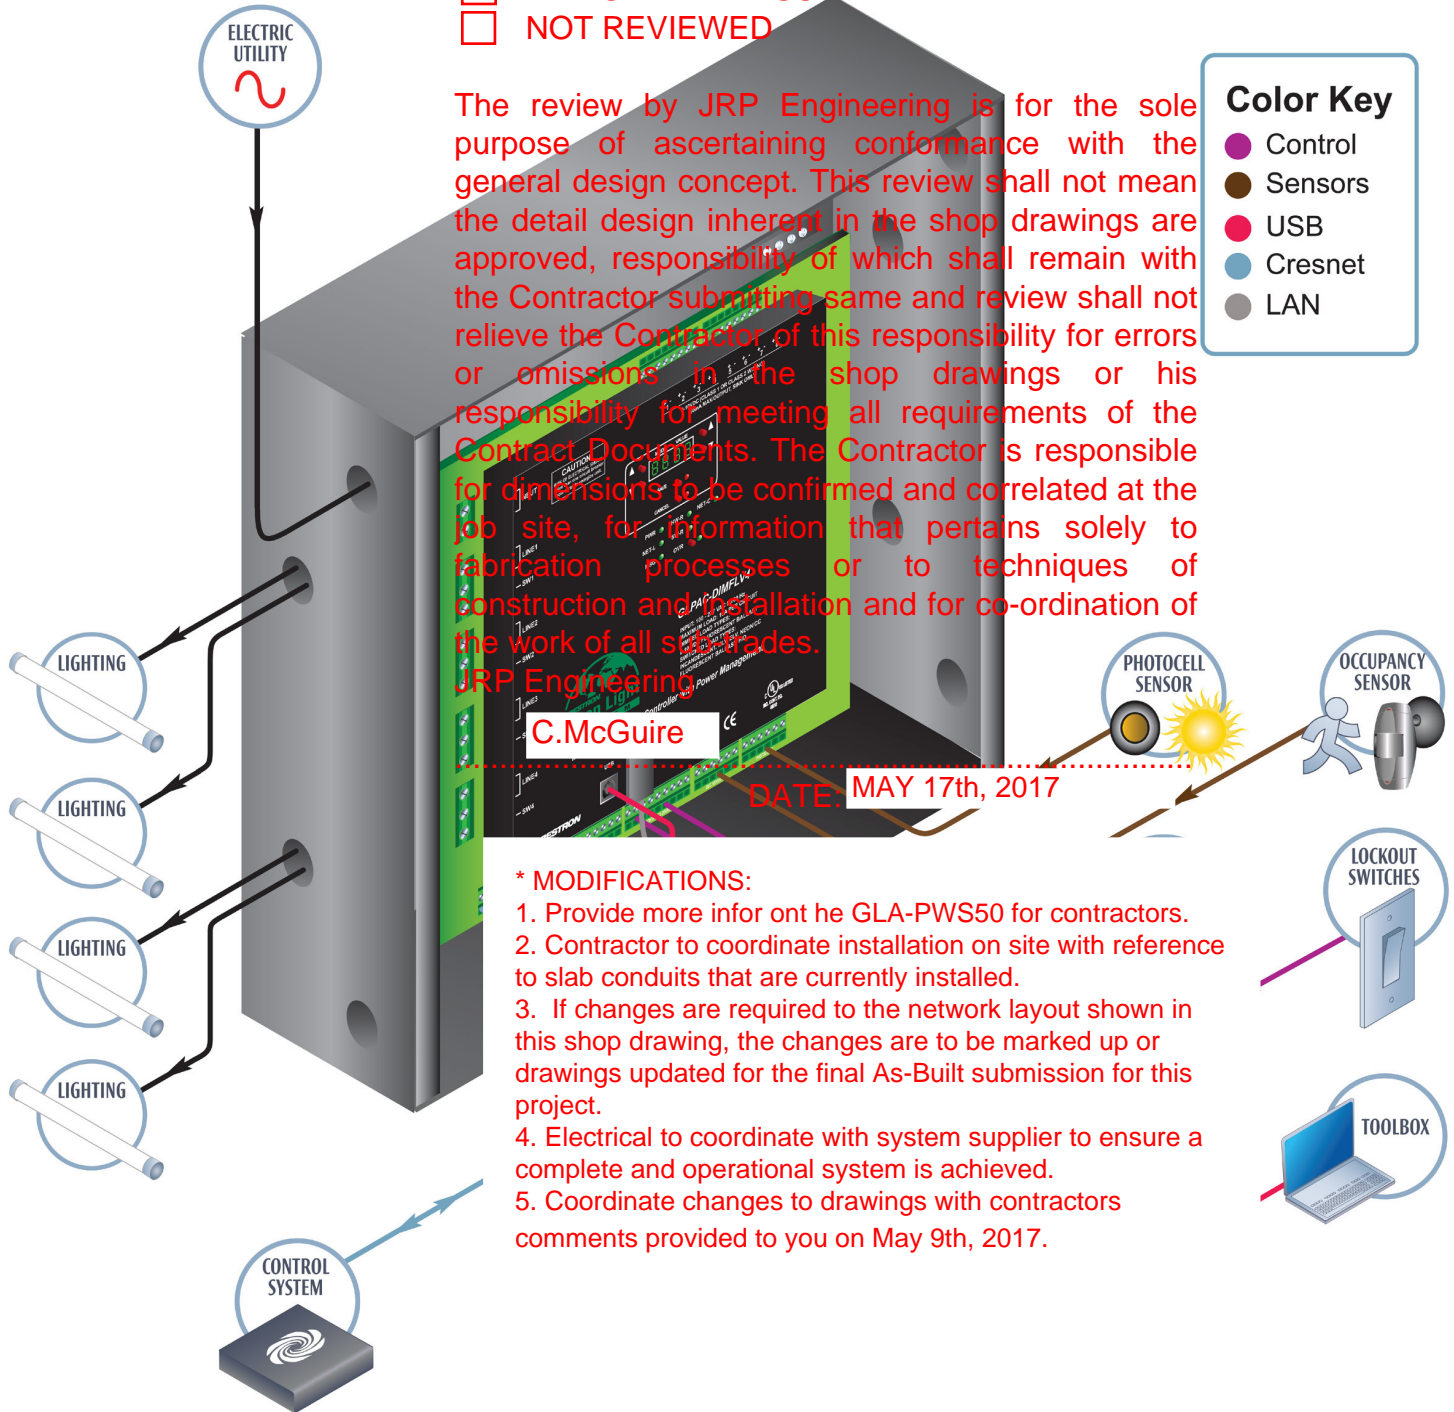

### \* MODIFICATIONS:

1. Provide more information on the GLA-PWS50 for contractors.
2. Contractor to coordinate installation on site with reference to slab conduits that are currently installed.
3. If changes are required to the network layout shown in this shop drawing, the changes are to be marked up or drawings updated for the final As-Built submission for this project.
4. Electrical to coordinate with system supplier to ensure a complete and operational system is achieved.
5. Coordinate changes to drawings with contractor comments provided to you on May 9th, 2017.

## Crestron Green Light® Power Pack

- > Lighting control for 120-277 Volt AC loads
- > Ideal for new construction or retrofits
- > Quick and easy commissioning via optional handheld remote (GLPPA-REMOTE-USER)
- > Wired or wireless link to central Crestron system
- > 1-, 2-, and 3-channel models available
- > Switched and 0-10V dimming models available
- > Occupancy sensor and photosensor integration
- > Support for up to three remote keypads
- > Easy keypad wiring using existing switch-loop wiring
- > Optional handheld remote for daily use (GLPPA-REMOTE-USER)
- > Real-time energy monitoring on select models
- > Adaptive zero-cross switching for extended life
- > Seamless integration with Crestron AV systems
- > CEC Title 24 2013 Compliant

- REVIEWED
- REVIEWED AND MODIFIED
- REVISE AND RESUBMIT
- NOT REVIEWED



The review by JRP Engineering is for the sole purpose of ascertaining conformance with the general design concept. This review shall not mean the detail design inherent in the shop drawings are approved, responsibility of which shall remain with the Contractor submitting same and review shall not relieve the Contractor of this responsibility for errors or omissions in the shop drawings or his responsibility for meeting all requirements of the Contract Documents. The Contractor is responsible for dimensions to be confirmed and correlated at the job site for information that pertains solely to fabrication processes or to techniques of construction and installation and for co-ordination of the work of all sub-trades.

### Energy Efficiency

Occupancy sensor and photosensor inputs drive the potential for significant energy savings. Lights will turn off automatically when the room is vacated, and rooms with adequate daylight will dim automatically. During the simple commissioning process, these cost-saving techniques can be made permanent to prevent users from overriding them

### Built-in Power Monitoring

Power monitoring, included on all dimming models,<sup>[1]</sup> tracks the real time energy usage of each GLPP to help control energy costs. By analyzing real data, organizations can make more educated decisions regarding energy resources, which will have greater impact on the bottom line.

### User Interface Options

Control scenes or manually adjust lighting in a space with up to three, 4-button GLPPA-KP keypads or the optional handheld user remote. To help promote installation in existing spaces, keypads can be installed in place of standard toggle switches that relay contacts close under no load.<sup>[2]</sup>

### Switching

Crestron's adaptive zero-cross switching technology extends the life of the connected ballasts and relays that relay contacts close under no load.

### Building Control System

Crestron's lighting control goes beyond just a single room. As a complete single room solution, it is designed to be part of a fully integrated building system, linked via wired or wireless to a central control system. With Crestron Fusion® lighting managers have total energy monitoring, management, and control over all GLPPs and other installed Crestron

The Crestron Green Light® Power Pack (GLPP) family delivers affordable room lighting control with essential features for reducing energy usage. Available with up to three channels of switching or 0-10V dimming, each GLPP model includes inputs for a photosensor and for an occupancy sensor for intelligent lighting control based on the amount of natural light and the presence of people in a space. The GLPP Series offers a cost-effective and powerful lighting control solution for classrooms, small offices, and open-plan offices.

### JRP Engineering

Ideal for new construction as well as retrofitting existing buildings, GLPPs are designed to install and operate easily and without hassle.

Additionally, the GLPP can be connected to a central control system, enabling it to become an integral part of the building energy management system. The dimming models also include built-in power monitoring to track energy usage.

To assess real power usage on a building energy management system, the GLPP can be connected to a central control system via a handheld remote (the GLPPA-REMOTE-USER).

### Easy Installation

Designed to mount on standard electrical boxes, the GLPP is easy to install. Once installed, each GLPP has default settings and can be easily configured.

Further commissioning can be done using the GLPPA-REMOTE-USER handheld remote or the GLPPA-IRGW-F flush-mount remote. The GLPPA-IRGW-F flush-mount remote uses the IR receiver control sensor that is connected to the GLPP commands. If occupancy sensor is used, the GLPPA-IRGW-F flush-mount remote is required for operation of a GLPP.

### \* MODIFICATIONS:

1. Provide more information on the GLA-PWS50 for contractors.
2. Contractor to coordinate installation on site with reference to slab conduits that are currently installed.
3. If changes are required to the network layout shown in this shop drawing, the changes are to be marked up on drawings updated for the final As-Built submission for this project.
4. Electrical to coordinate with system supplier to ensure a complete and operational system is achieved.
5. Coordinate changes to drawings with contractors comments provided to you on May 9th, 2017.

DATE: MAY 17th, 2017

C.McGuire

# GLPP Crestron Green Light® Power Pack

REVIEWED

REVIEWED AND MODIFIED

REVISE AND RESUBMIT

NOT REVIEWED

## Cresnet® Models - Wired Communications

Robust and reliable communications between the GLPP and a control system is provided over the Cresnet bus. The versatile topology of Cresnet means that installers can home-run, daisy-chain, or mix and match as needed. Cresnet connects to the GLPP via flying leads with wire nuts, eliminating any need for crimpers or connectors and making for a more secure, trouble-free termination.

## infiNET EX® Models - Wireless Communications

Ultra-reliable infiNET EX wireless technology provides steadfast 2-way RF communications throughout a residential or commercial structure without the need for physical control wiring. Employing a 2.4 GHz mesh network topology, each infiNET EX device functions as an expander, passing command signals through every other infiNET EX device within range (approximately 150 feet or 46 meters indoors), ensuring that every command reaches its intended destination without disruption.<sup>[3]</sup>

The GLPP communicates with a Crestron control system via an infiNET EX Wireless Gateway (model CEN-GWEXER, CEN-RFGW-EX, DIN-AP3MEX, or MC3<sup>[4]</sup>). Up to 100 infiNET EX devices may coexist on a single wireless network, and the gateway that processes the network effectively increases the range and stability of the entire network by providing multiple redundant signal paths.<sup>[3]</sup>

mesh network device(s); Subject to site-specific conditions and individual device capabilities<sup>[3]</sup>

Gateway: Requires an infiNET EX gateway<sup>[4]</sup>

## Controls & Indicators

**POWER:** (1) Green LED, indicates line voltage is supplied to unit

**STATUS:** (1) Red LED, indicates unit is in Setup mode

**STATUS:** (1) Recessed push button, toggles Setup mode

**IR RECEIVER:** (1) IR window, for use with commissioning remote control

## Connections (Class 1)

**HOT:** (1) 14 AWG Class 1 flying lead, black, line in (100-277 VAC)

**NEUT:** (1) 14 AWG Class 1 flying lead, white

**SW HOT:** (1, 2, or 3) 14 AWG Class 1 flying lead(s), red, switched hot and labeled with channel number

**GROUND:** (1) 14 AWG Class 1 flying lead, green with yellow stripe

## Connections (Class 1) - Dimmer Models Only

**0-10V dim(+):** (1, 2 or 3) 18 AWG Class 1 flying lead(s), violet, labeled with channel number

**0-10V dim(-):** (1) 18 AWG Class 1 flying lead, gray

## Connections (Class 2)

**COM:** (1) 18 AWG Class 2 flying lead, black; common for sensors, IR and

**24V:** (1) 18 AWG Class 2 flying lead, red, sensor power

3 Class 2 flying lead, orange, signal for occupancy sensor

1/2 AWG Class 2 flying lead, yellow, signal for photo sensor

1/2 Class 2 flying lead, brown wire, connects to IR terminal S or GLS-OIR-C-NS occupancy sensor; if sensors are not wire can also connect with optional flush-mount, external PA-IRGW-F)

1/2 AWG Class 2 flying leads, white with black stripe, supports LPPA-KP Power Pack Keypads

## 3 (Class 2) - Cresnet Models Only

1/2 AWG Class 2 flying lead, blue, Cresnet Data Z

1/2 AWG Class 2 flying lead, white, Cresnet Data Y

## 3 (Class 2) - infiNET EX Models Only

Connection for supplied antenna

1/2 sized steel enclosure; designed for mounting to two (2) 1/2" x 4" square electrical junction boxes;<sup>[6]</sup> 3-channel versions require a box depth of 2.125 in (54 mm)

## Environmental

**Temperature:** 32° to 104° F (0° to 40° C)

**Humidity:** 10% to 90% RH (non-condensing)

## SPECIFICATIONS

### Load Ratings

Number of Dimming or Switching Channels: 1, 2, or 3, depending on model

Per Unit: 16 A to 80%)

Dim Load Type: drivers; 60 mA

Switch Load Type: low-voltage, el discharge

Relay Lifetime

### Power Rec

Power Consumption: sensors or key Wireless Mode attached

Main Power:

Available Sensors: multiple senso

### Wired Conn

Cresnet<sup>[5]</sup>

### Wireless Communications — infiNET EX® Models Only

RF Transceiver: infiNET EX 2-way RF, 2.4 GHz ISM Channels 11-26 (2400 to 2483.5 MHz), default channel 15; IEEE 802.15.4 compliant

Range (Typical): 150 ft (46 m) indoor, 250 ft (76 m) outdoor, to nearest

The review by JRP Engineering is for the sole purpose of ascertaining conformance with the general design concept. This review shall not mean the detail design inherent in the shop drawings are approved, responsibility of which shall remain with the Contractor submitting same and review shall not relieve the Contractor of this responsibility for errors or omissions in the shop drawings or his responsibility for meeting all requirements of the Contract Documents. The Contractor is responsible for dimensions to be confirmed and correlated at the job site for information that pertains solely to fabrication and installation and for co-ordination of the work of all sub-trades.

JRP Engineering

C.McGuire

DATE: MAY 17th, 2017

### \* MODIFICATIONS:

1. Provide more information on the GLA-PWS50 for contractors.
2. Contractor to coordinate installation on site with reference to slab conduits that are currently installed.
3. If changes are required to the network layout shown in this shop drawing, the changes are to be marked up or drawings updated for the final As-Built submission for this project.
4. Electrical to coordinate with system supplier to ensure a complete and operational system is achieved.
5. Coordinate changes to drawings with contractors comments provided to you on May 9th, 2017.

# GLPP Crestron Green Light® Power Pack

## Dimensions

Height: 4.25 in (108 mm)  
 Width: 8.63 in (219 mm); 9.88 in (251 mm) with antenna at 90° angle (wireless model only)  
 Depth: 2.00 in (51 mm)

## Weight

2 lbs (907 g)

## Standards & Certifications

UL916  
 FCC  
 Title 24  
 Relays listed under UL508 Section 41 (Endurance Test) and Section 61C (Electronic Ballasts)  
 CEC Title 24 2013 Compliant

## MODELS & ACCESSORIES

### Available Models

GLPP-SWCN: Crestron Green Light® Power Pack, 1-Channel Switch w/ Cresnet®  
 GLPP-1SW2CN: Crestron Green Light® Power Pack, 2-Channel Switch w/ Cresnet®  
 GLPP-1SW3CN: Crestron Green Light® Power Pack, 3-Channel Switch w/ Cresnet®  
 GLPP-DIMFLVCN-PM: Crestron Green Light® Power Pack, 1-Channel 0-10V Dimmer w/Cresnet® & Built-  
 GLPP-1DIMFLV2CN-PM: Crestron 0-10V Dimmer w/Cresnet® & Built-  
 GLPP-1DIMFLV3CN-PM: Crestron 0-10V Dimmer w/Cresnet® & Built-  
 GLPP-SWEX: Crestron Green Light infiNET EX® Wireless  
 GLPP-1SW2EX: Crestron Green Light infiNET EX® Wireless  
 GLPP-1SW3EX: Crestron Green Light infiNET EX® Wireless  
 GLPP-DIMFLVEX-PM: Crestron Green Light 0-10V Dimmer w/infiNET EX® Wireless  
 GLPP-1DIMFLV2EX-PM: Crestron 0-10V Dimmer w/infiNET EX® Wireless  
 GLPP-1DIMFLV3EX-PM: Crestron 0-10V Dimmer w/infiNET EX® Wireless

### Available Accessories

GLPPA-KP-W-S: In-wall Keypad for GLPP, Black Smooth  
 GLPPA-KP-B-S: In-wall Keypad for GLPP, Black Smooth  
 GLPPA-KP-A-S: In-wall Keypad for GLPP, Almond Smooth  
 GLPPA-REMOTE-PROG: Commissioning Remote for GLPP  
 GLPPA-REMOTE-USER: User Remote for GLPP  
 GLPPA-IRGW-F: IR Gateway for GLPP, Flush Mount

- REVIEWED
- REVIEWED AND MODIFIED
- REVISE AND RESUBMIT
- NOT REVIEWED

The review by JRP Engineering is for the sole purpose of ascertaining conformance with the general design concept. This review shall not mean the detail design inherent in the shop drawings are approved, responsibility of which shall remain with the Contractor submitting same and review shall not relieve the Contractor of this responsibility for errors or omissions in the shop drawings or his responsibility for meeting all requirements of the Contract Documents. The Contractor is responsible for dimensions to be confirmed and correlated at the job site for information that prepares solely the fabrication processes or techniques of construction and installation and for co-ordination of the work of all sub-trades.

JRP Engineering  
 C.McGuire

DATE: MAY 17th, 2017

GLS-ODT-C-NS: Dual-Technology Ceiling Mount Occupancy Sensor  
 GLS-OIR-C-NS: Passive Infrared Ceiling Mount Occupancy Sensor  
 GLS-LOL: Crestron Green Light® Photocell, Open-Loop  
 GLS-LCL: Crestron Green Light® Photocell, Closed-Loop  
 GLS-LEXT: Crestron Green Light® Photocell, Outdoor  
 GEN-GWEXER: infiNET EX® & ER Wireless Gateway (Only for: GLPP-1DIMFLV2EX-PM, GLPP-1DIMFLV3EX-PM, GLPP-1SW2EX, GLPP-1SW3EX, GLPP-DIMFLVEX-PM, GLPP-SWEX)  
 GEN-RFGW-EX: infiNET EX® Wireless Gateway (Only for: GLPP-1DIM-FLV2EX-PM, GLPP-1DIMFLV3EX-PM, GLPP-1SW2EX, GLPP-1SW3EX, GLPP-DIMFLVEX-PM, GLPP-SWEX)  
 GEN-RFGW-EX-PWE: infiNET EX® Wireless Gateway w/PoE Injector (Only for: GLPP-1DIMFLV2EX-PM, GLPP-1DIMFLV3EX-PM, GLPP-1SW2EX, GLPP-1SW3EX, GLPP-DIMFLVEX-PM, GLPP-SWEX)  
 MCS-3-Series Control System® w/infiNET EX® (Only for: GLPP-1DIM-FLV2EX-PM, GLPP-1DIMFLV3EX-PM, GLPP-1SW2EX, GLPP-1SW3EX, GLPP-DIMFLVEX-PM, GLPP-SWEX)  
 DIN-AP3MEX: DIN Rail 3-Series® Automation Processor w/infiNET EX® (Only for: GLPP-1DIMFLV2EX-PM, GLPP-1DIMFLV3EX-PM, GLPP-1SW2EX, GLPP-1SW3EX, GLPP-DIMFLVEX-PM, GLPP-SWEX)  
 GLW-EXPEX-GD-W-T: infiNET EX® Wireless Expander, Ground Pin Down, White Textured (Only for: GLPP-1DIMFLV2EX-PM, GLPP-1DIMFLV3EX-PM, GLPP-1SW2EX, GLPP-1SW3EX, GLPP-DIMFLVEX-PM, GLPP-SWEX)  
 GLA-EXPEX: Crestron Green Light® Wireless Expander for infiNET EX® Networks (Only for: GLPP-1DIMFLV2EX-PM, GLPP-1DIMFLV3EX-PM, GLPP-1SW2EX, GLPP-1SW3EX, GLPP-DIMFLVEX-PM, GLPP-SWEX)

Notes:

### \* MODIFICATIONS:

1. Provide more info on the GLA-PWS50 for contractors.
2. Contractor to coordinate installation on site with reference to slab conduits that are currently installed.
3. If changes are required to the network layout shown in this shop drawing, the changes are to be marked up or drawings updated for the final As-Built submission for this project.
4. Electrical to coordinate with system supplier to ensure a complete and operational system is achieved.
5. Coordinate changes to drawings with contractors comments provided to you on May 9th, 2017.

keypad location to the GLPP. r functionality will effectively extend the range ge of the gateway. Battery-powered infiNET ality. Crestron also offers dedicated infiNET EX :X, sold separately), which may be deployed to fill rge of the mesh network. Up to 100 infiNET EX best practices suggest a limit of approximately support more devices, with a maximum of 16 IF conditions allowing).

er. meet code requirements.

zed Crestron dealer. To find a dealer, please jr area. A list of sales representatives is available ling 800-237-2041.

is are listed online at: [patents.crestron.com](http://patents.crestron.com).

software. For specific information, visit

reen Light, Crestron Fusion, and infiNET EX are restron Electronics, Inc. in the United States and/ trademarks, and trade names may be used in this the marks and names or their products. Crestron

disclaims any proprietary interest in the marks and names of others. Crestron is not responsible for errors in typography or photography. Specifications are subject to change without notice.

©2016 Crestron Electronics, Inc.

# GLPP Crestron Green Light® Power Pack

## CAD DRAWINGS


GLPP-1SW3CN Shown

- REVIEWED
- REVIEWED AND MODIFIED
- REVISE AND RESUBMIT
- NOT REVIEWED

The review by JRP Engineering is for the sole purpose of ascertaining conformance with the general design concept. This review shall not mean the detail design inherent in the shop drawings are approved, responsibility of which shall remain with the Contractor submitting same and review shall not relieve the Contractor of this responsibility for errors or omissions in the shop drawings or his responsibility for meeting all requirements of the Contract Documents. The Contractor is responsible for dimensions to be confirmed and correlated at the job site, for information that pertains solely to fabrication processes or to techniques of construction and installation and for co-ordination of the work of all sub-trades.

JRP Engineering  
C.McGuire

DATE: MAY 17th, 2017

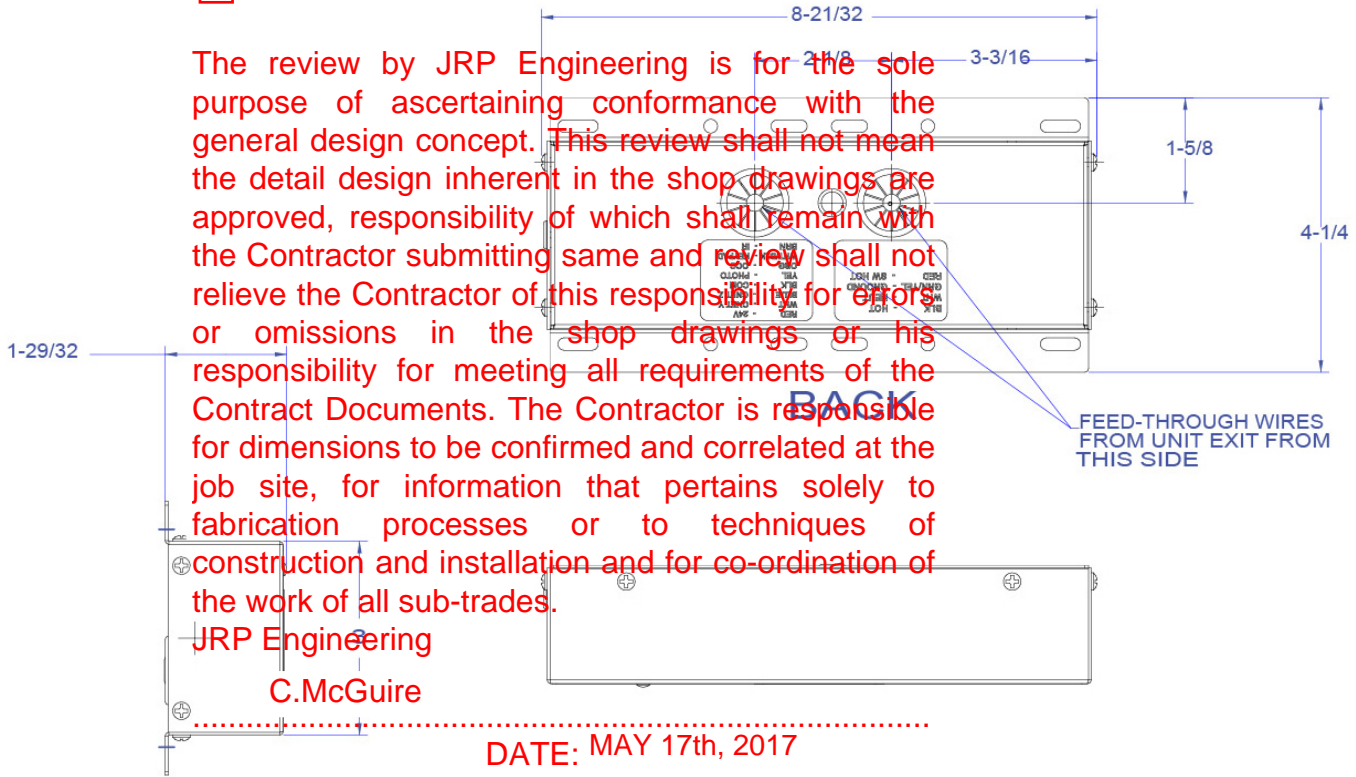


### \* MODIFICATIONS:

1. Provide more information on the GLA-PWS50 for contractors.
2. Contractor to coordinate installation on site with reference to slab conduits that are currently installed.
3. If changes are required to the network layout shown in this shop drawing, the changes are to be marked up or drawings updated for the final As-Built submission for this project.
4. Electrical to coordinate with system supplier to ensure a complete and operational system is achieved.
5. Coordinate changes to drawings with contractor comments provided to you on May 9th, 2017.


4X) 7/32  
VTG HOLES FOR  
SINGLE 4X4 BOX)

(8X) 3/16 MTG HOLES FOR  
(2) 4X4 BOXES.

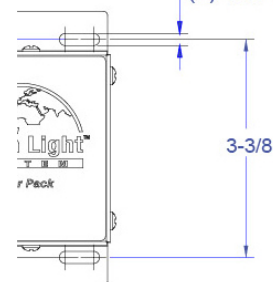


# GLPP Crestron Green Light® Power Pack

## APPLICATION DIAGRAMS

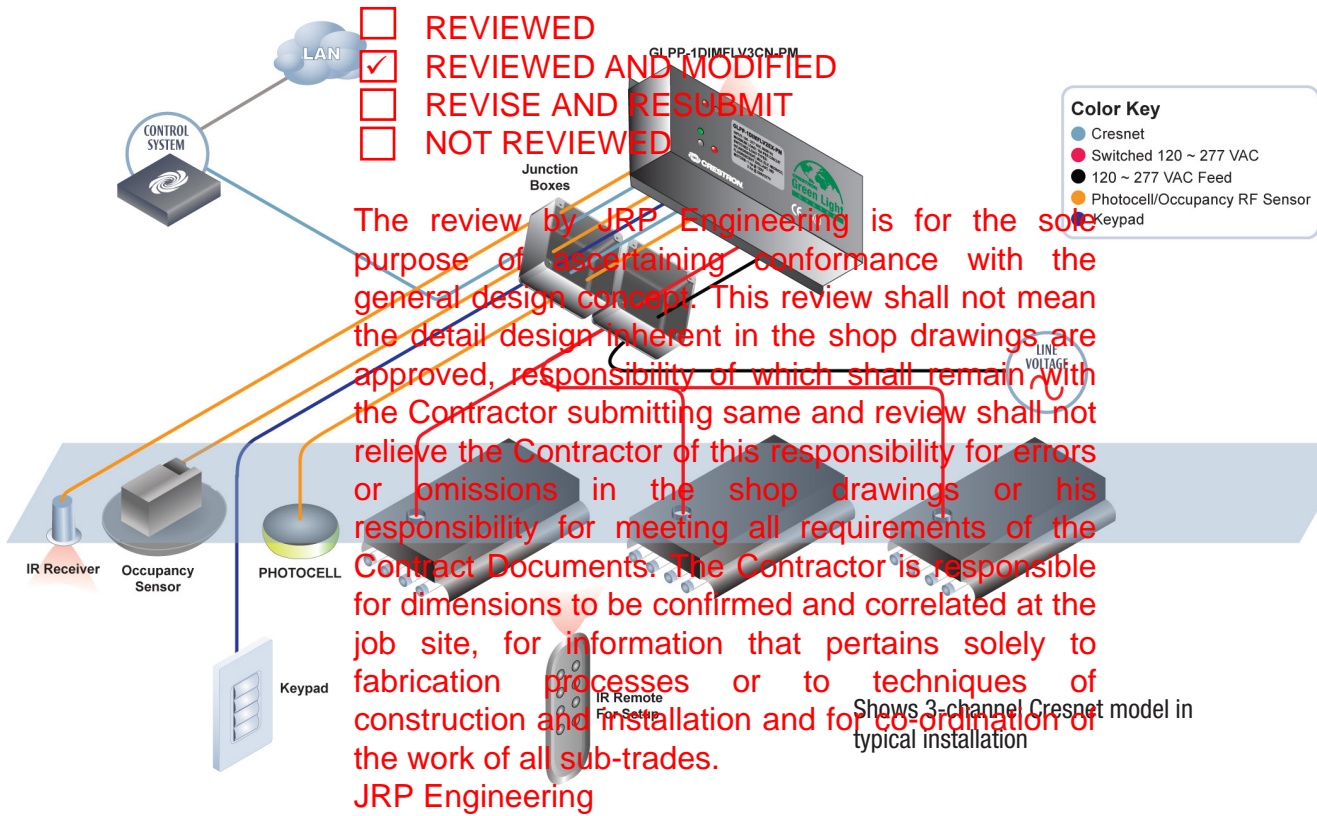

C.McGuire

DATE: MAY 17th, 2017

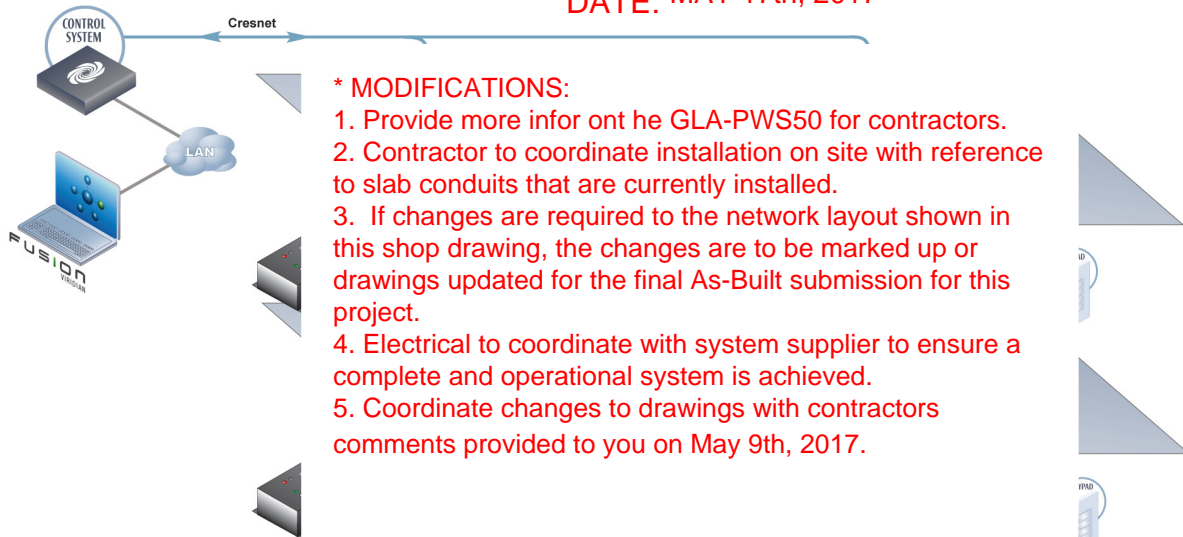


Shows typical multi-room application

## Dual-Technology Ceiling Mount Occupancy Sensor

- REVIEWED
- REVIEWED AND MODIFIED
- REVISE AND RESUBMIT
- NOT REVIEWED

- > Ceiling-mount occupancy sensor for use with standalone lighting systems
- > Dual-technology motion detection
- > 360 degree coverage pattern
- > 2,000 sq ft coverage area
- > Versiport or digital input port connection
- > Discreet, low-profile appearance
- > Extremely accurate and reliable sensing
- > Fully digital circuitry for low cost and high reliability
- > Crestron® control system interface via GLS-SIM (sold separately)

The review by JRP Engineering is for the sole purpose of ascertaining conformance with the general design concept. This review shall not mean the detail design inherent in the shop drawings are approved, responsibility of which shall remain with the Contractor submitting same and review shall not relieve the Contractor of this responsibility for errors or omissions in the shop drawings or his responsibility for meeting all requirements of the Contract Documents. The Contractor is responsible for dimensions to be confirmed and correlated at the job site, for information that pertains solely to fabrication processes or to techniques of construction and installation and for coordination of the work of all sub trades.

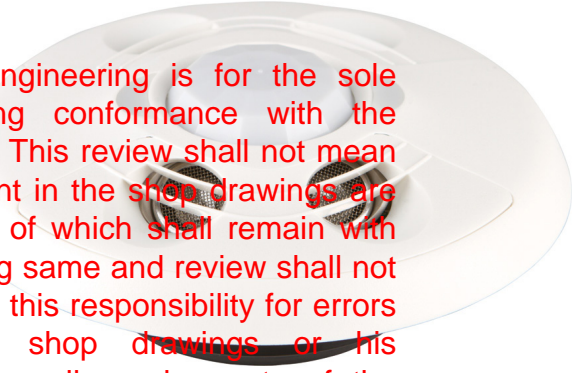

The Crestron® GLS-ODT-C-NS sensor features accurate, dual-technology occupancy detection in a large room or space and delivers a powerful and cost-effective solution for reducing energy consumption and enhancing the functionality of standalone lighting systems. The GLS-ODT-C-NS is a low-profile, ceiling-mounted occupancy sensor designed for areas up to 2,000 square feet, making it great for use in large spaces such as auditoriums, warehouses, and building lobbies. The sensor can connect directly to and be controlled by standalone lighting systems such as the GLPP, GLPAC, or GL-IPAC-SW8. The GLS-SIM Sensor Integration Module provides an interface with a Crestron control system via Crestron®

### Cresnet Option™

Cresnet provides a simple solution for configuring and wiring keypads and sensors as part of any complete Crestron system. Cresnet is the communications backbone for coordinating dimmers, keypads, shades, thermostats, and many other devices. This flexible 4-wire bus provides data communications and 24 Volts DC power for all of the devices on the Cresnet network. Using the optional GLS-SIM Sensor Integration Module, the GLS-ODT-C-NS becomes a full-featured Cresnet device.

### Dual-Technology Occupancy Sensing

Achieving consistent and dependable occupancy sensing is accomplished using a combination of ultrasonic and passive infrared (PIR) sensing technologies. Ultrasonic motion detection is highly sensitive to movements over a large area, while passive infrared sensing provides superior immunity to false triggers from vibrations, inactivity, or movement in an adjacent corridor. Ultrasonic motion detection is turned on for Side A, Side B, or both sides of the occupancy sensor. The GLS-ODT-C-NS provides independent sensitivity at each sensor type for optimum performance in any space.

### Walk-Through Mode

This sensor detects momentary occupancy and automatically turns lights off after 90 seconds with the built-in Walk-Through Mode to prevent unnecessary energy consumption.

### Versatile Installation

The GLS-ODT-C-NS achieves a discreet, nearly hidden appearance when installed on a typical drywall or droptile ceiling. Hardware for fast and simple mounting in a standard 4-inch octagon cutout is created with the help of the provided cutout template.

JRP Engineering  
C.McGuire

IR Remote DATE: MAY 17th, 2017

A variety of parameters can be set for the GLS-ODT-C-NS by using the

### \* MODIFICATIONS:

1. Provide more information on the GLA-PWS50 for contractors.
2. Contractor to coordinate installation on site with reference to slab conduits that are currently installed.
3. If changes are required to the network layout shown in this shop drawing, the changes are to be marked up or drawings updated for the final As-Built submission for this project.
4. Electrical to coordinate with system supplier to ensure a complete and operational system is achieved.
5. Coordinate changes to drawings with contractors comments provided to you on May 9th, 2017.

remote eliminates any system. The remote to be installed after

kHz)

# GLS-ODT-C-NS Dual-Technology Ceiling Mount Occupancy Sensor

## IR Remote (Sold Separately)

### Parameters and Settings Available Via IR Remote:

- Separate occupancy and vacancy sensitivity settings
- Timeout (1, 2m, 5m, 10m, 15m, 30m)
- Walk-Through mode "Short Timeout" (Enable/Disable)
- LEDs (Enable/Disable)
- PIR sensitivity (High, Med, Low, OFF), with the option to set separate occupancy and vacancy settings
- US sensitivity (High, Medium, QFD) with the option to set separate occupancy and vacancy settings
- US detection (Side A only, Side B only, Both)
- ID of sensor
- Factory Reset
- Force Vacancy
- (4) Custom buttons for future additional features

## Connections

(1) 5-pin 3.5 mm detachable terminal block; 16 AWG maximum wire width supported, includes the following terminals:

+24V: DC power input

OCC: Occupancy sensor control signal output

Provides 24 Volts DC output when occupancy is detected (both PIR and US must sense occupancy to provide 24 Volt signal, if room is transitioning from a vacant to occupied state; After initial occupancy is detected, either PIR or US detection will trigger the 24 Volt signal to maintain the occupied state)

Short circuit protected:

Connects to a GLS-SIM Integration Module (sold separately), Crestron® control system

NC: Unused

G: Ground

IR: IR single direction receiver on sensor

## Environmental

Temperature: 32° to 104° F

Humidity: 10% to 90%

## Power Requirements

Current Consumption

Crestron® Power Usage

## Enclosure

Housing: Plastic, white

Mounting: Mounts to ceiling with a 1-1/2" diameter hole created  
Includes mounting screws  
A 1-1/2" (38 mm) mirror

## Dimensions

Diameter: 4.80 in (122 mm)

Depth: 2.30 in (59 mm) overall, 0.97 in (25 mm) exposed

## Weight

5.1 oz (144 g)

## Standards & Certifications

UL 60730-1, FCC, CE, C-Tick, IC, Plenum Rated, California Title 24 Code

## MODULES & ACCESSORIES

### Available Models

GLS-ODT-C-NS: Dual-Technology Ceiling Mount Occupancy Sensor

### Available Accessories

GLS-REMOTE-ODT/OIR: IR Remote for GLS Occupancy Sensors

GLSA-ODT/OIR-TP-500: Occupancy Sensor Lens, 500 sq ft

GLS-SIM: Sensor Integration Module

Notes:

1. The GLS-ODT-C-NS requires a GLS-SIM for Crestron communications.

This product may be purchased from an authorized Crestron dealer. To find a dealer, please contact your local sales representative for your area. A list of sales representatives is available online at [www.crestron.com/salesreps](http://www.crestron.com/salesreps) or by calling 800-237-2041.

Crestron products are listed online at: [patents.crestron.com](http://patents.crestron.com).

Crestron uses open source software. For specific information, visit [www.crestron.com/open-source](http://www.crestron.com/open-source).

Crestron, the Crestron logo, and Crestron products are either trademarks or registered trademarks of Crestron Electronics, Inc. in the United States and/or other countries. Other trademarks, registered trademarks, or service marks may be used in this document to refer to either the entities claiming such marks or to products. Crestron disclaims proprietary interest in the marks and trademarks of other entities. Crestron is not responsible for errors in typography or photography. Crestron reserves the right to change without notice. ©2016 Crestron Electronics, Inc.

### \* MODIFICATIONS:

1. Provide more information on the GLA-PWS50 for contractors.
2. Contractor to coordinate installation on site with reference to slab conduits that are currently installed.
3. If changes are required to the network layout shown in this shop drawing, the changes are to be marked up on drawings updated for the final As-Built submission for this project.
4. Electrical to coordinate with system supplier to ensure a complete and operational system is achieved.
5. Coordinate changes to drawings with contractors per comments provided to you on May 9th, 2017.

## CAD DRAWING

- REVIEWED
- REVIEWED AND MODIFIED
- REVISE AND RESUBMIT
- NOT REVIEWED

The review by JRP Engineering is for the sole purpose of ascertaining conformance with the general design concept. This review shall not mean the detail design inherent in the shop drawings are approved, responsibility of which shall remain with the Contractor submitting same and review shall not relieve the Contractor of this responsibility for errors or omissions in the shop drawings or his responsibility for meeting all requirements of the Contract Documents. The Contractor is responsible for dimensions to be confirmed and correlated at the job site, for information that pertains solely to fabrication processes or to techniques of construction and installation and for co-ordination of the work of all sub-trades.

JRP Engineering  
C.McGuire


DATE: MAY 17th, 2017

Ø4.80 in  
(121.92 mm)

Ø5.25 in  
(133.02 mm)

Ø4.80 in  
(121.92 mm)

Ø5.25 in  
(133.02 mm)

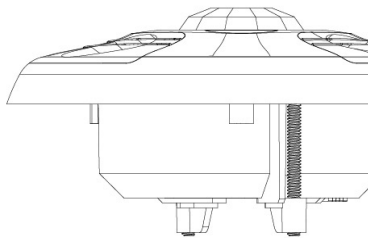

### \* MODIFICATIONS:


1. Provide more information on the GLA-PWS50 for contractors.
2. Contractor to coordinate installation on site with reference to slab conduits that are currently installed.
3. If changes are required to the network layout shown in this shop drawing, the changes are to be marked up or drawings updated for the final As-Built submission for this project.
4. Electrical to coordinate with system supplier to ensure a complete and operational system is achieved.
5. Coordinate changes to drawings with contractors comments provided to you on May 9th, 2017.

## Crestron GreenLight® Photosensor, Open-Loop

- REVIEWED
- REVIEWED AND MODIFIED
- REVISE AND RESUBMIT
- NOT REVIEWED

- > Ceiling- or wall-mount photosensor
- > Measures the light level from a natural daylight source
- > Vertical or horizontal face mounting
- > 60 degree field of view
- > 0 to 10 Volts DC analog output
- > Control system interface is Crestron® or another input

The review by JRP Engineering is for the sole purpose of ascertaining conformance with the general design concept. This review shall not mean the detail design inherent in the shop drawings are approved, responsibility of which shall remain with the Contractor submitting same, and review shall not relieve the Contractor of this responsibility for errors or omissions in the shop drawings or his responsibility for meeting all requirements of the Contract Documents. The Contractor is responsible for dimensions to be confirmed and correlated at the job site, for information that pertains solely to fabrication processes or to techniques of construction and installation and for the work of all sub-trades.

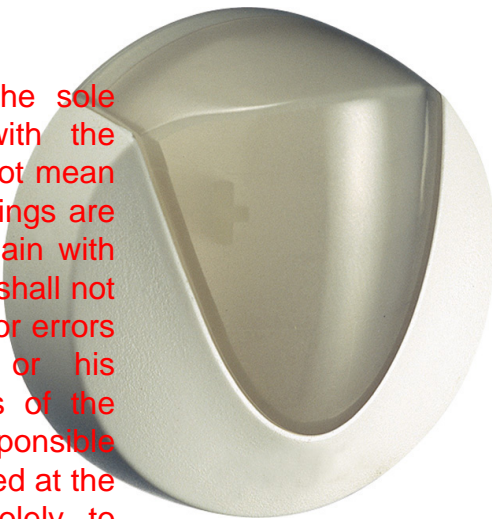

The GLS-LOL is a photosensor that measures light in order to achieve the optimal balance of natural and artificial lighting in an indoor space in daylight harvesting applications. Intended for use with an open-loop type system, the GLS-LOL continually monitors the amount of daylight coming through a window or skylight, enabling the control system to dim or switch off room lighting when there is sufficient daylight available to light the space.

Open-loop photosensors provide a cost-effective solution for daylight harvesting, allowing multiple lighting zones to be controlled by a single sensor. In a typical office, classroom, or similar space, the GLS-LOL is installed on the ceiling near a window or in the light well of a skylight, directed toward the incoming daylight and away from any electrical lighting fixtures. The system estimates the total amount of ambient lighting in the room according to the light level measured by the photocell.

The GLS-LOL can be mounted to drywall or to a drop-tile surface. Its simple 3-wire interface allows for direct connection to a Crestron system via a single Versiport I/O or analog input port, with 24 Volt power taken from the Cresnet® coil Integration Module, the GLS streamlining the total lighting

Cresnet provides a simpler part of any complete Crestron communications backbone shade motors, sensors, and 4-wire network that provide power for Cresnet devices.

### SPECIFICATION

#### Sensing

Field of View: 60 degree circular  
 Center Axis: 45 degrees from horizontal  
 Light Sensitivity: 3 to 6000 lux

#### Connections<sup>[2,3]</sup>

Plus: (1) Captive screw terminal, +24 Volt DC power input  
 Minus: (1) Captive screw terminal, power and control signal common  
 Arrow: (1) Captive screw terminal, light level control signal output, 0-10 Volts DC

#### Controls (Behind Cover)

Light Level Range: Jumper-selectable 3-300, 30-3000, or 60-6000 fc

#### Power Requirements

Current Consumption: 4 mA at 24 Volts DC  
 Power Consumption: 1 Watt<sup>[4]</sup>

#### Housing

Mounting: Directly to drywall or drop-tile

#### ACCESSORIES

Crestron GreenLight® Photosensor, Open-Loop

Crestron GreenLight® Sensor Integration Module

#### \* MODIFICATIONS:

1. Provide more information on the GLA-PWS50 for contractors.
2. Contractor to coordinate installation on site with reference to slab conduits that are currently installed.
3. If changes are required to the network layout shown in this shop drawing, the changes are to be marked up on drawings updated for the final As-Built submission for this project.
4. Electrical to coordinate with system supplier to ensure a complete and operational system is achieved.
5. Coordinate changes to drawings with contractors comments provided to you on May 9th, 2017.

DATE: MAY 17th, 2017

JRP Engineering  
 C.McGuire

# GLS-LOL Crestron Green Light® Photosensor, Open-Loop

- REVIEWED
- REVIEWED AND MODIFIED
- REVISE AND RESUBMIT
- NOT REVIEWED

## Notes:

1. Cresnet communications requires GLS-SIM Sensor Integration Module (sold separately).
2. Recommended Wire Size: 22 AWG.
3. Connects to a GLS-SIM Integration Module or to a Versiport I/O or Analog Input control port on any Crestron control system.
4. Power may be taken from Cresnet bus regardless of interface method.

This product may be purchased from an authorized Crestron dealer. To find a dealer, please contact the Crestron sales representative for your area. A list of sales representatives is available online at [www.crestron.com/salesreps](http://www.crestron.com/salesreps) or by calling 800-237-2041.

The specific patents that cover Crestron products are listed online at: [patents.crestron.com](http://patents.crestron.com)

Some Crestron products contain open source software. For specific information, visit [www.crestron.com/opensource](http://www.crestron.com/opensource).

Crestron, the Crestron logo, Cresnet, and Crestron Green Light are either trademarks or registered trademarks of Crestron Electronics, Inc. in the United States and/or other countries. Other trademarks, registered trademarks, and trade names may be used in this document to refer to either the entities claiming the marks and names or their products. Crestron disclaims any proprietary interest in the marks and names of others. Crestron is not responsible for errors in typography or photography. Specifications are subject to change without notice.  
©2015 Crestron Electronics, Inc

The review by JRP Engineering is for the sole purpose of ascertaining conformance with the general design concept. This review shall not mean the detail design inherent in the shop drawings are approved, responsibility of which shall remain with the Contractor submitting same and review shall not relieve the Contractor of this responsibility for errors or omissions in the shop drawings or his responsibility for meeting all requirements of the Contract Documents. The Contractor is responsible for dimensions to be confirmed and correlated at the job site, for information that pertains solely to fabrication processes or to techniques of construction and installation and for co-ordination of the work of all sub-trades.

JRP Engineering

C.McGuire


.....  
DATE: MAY 17th, 2017

## \* MODIFICATIONS:

1. Provide more information on the GLA-PWS50 for contractors.
2. Contractor to coordinate installation on site with reference to slab conduits that are currently installed.
3. If changes are required to the network layout shown in this shop drawing, the changes are to be marked up or drawings updated for the final As-Built submission for this project.
4. Electrical to coordinate with system supplier to ensure a complete and operational system is achieved.
5. Coordinate changes to drawings with contractors comments provided to you on May 9th, 2017.

## Cameo® Keypad, Standard Mount

- REVIEWED
- REVIEWED AND MODIFIED
- REVISE AND RESUBMIT
- NOT REVIEWED

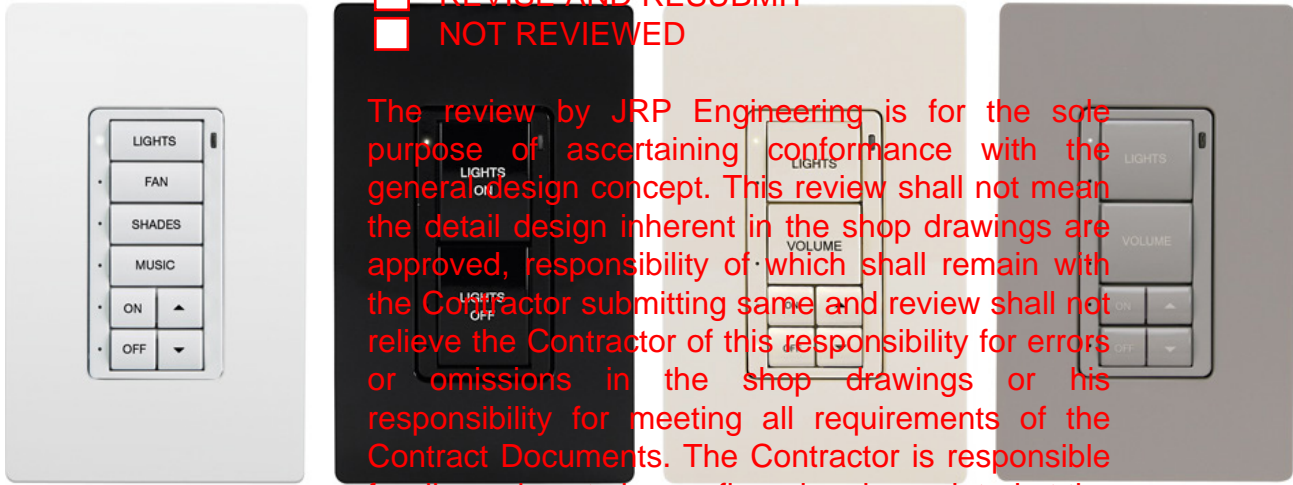

The review by JRP Engineering is for the sole purpose of ascertaining conformance with the general design concept. This review shall not mean the detail design inherent in the shop drawings are approved, responsibility of which shall remain with the Contractor submitting same and review shall not relieve the Contractor of this responsibility for errors or omissions in the shop drawings or his responsibility for meeting all requirements of the Contract Documents. The Contractor is responsible for dimensions to be confirmed and correlated at the

- > Stylish and versatile wall-mount keypad
- > Standard electrical box installation
- > 12 color-matched smooth and textured finishes
- > Ascent® solid metal faceplates available in paint<sup>(1)</sup>
- > Versatile combinations of 2 to 8 pushbuttons
- > Installer-configurable with choice of 4 button sizes
- > "Split" buttons for "up/down" and "on/off" functions
- > "Button Events" enable tap, double-tap, and press and hold functionality
- > Customizable backlit button engraving<sup>(1)</sup>
- > White LED feedback indicators
- > Built-in LED blinking and bar graph logic
- > Auto-dimmable backlight and LED intensity
- > Ambient light sensor
- > Dual digital/analog input ports for external devices
- > Quick and easy installation
- > Cresnet® wired communications

job site, for information that pertains solely to fabrication processes or to techniques of construction and installation and for co-ordination of the work of all sub-trades.

**JRP Engineering**  
C.McGuire

The Cameo® Standard Mount Keypad (C2N-CBD-P) from Crestron® presents a fresh, innovative concept in keypad design, featuring a highly configurable one-gang wall mount form factor that is at once inviting to the touch and appealing to the eye. The C2N-CBD-P easily installs alongside other low-voltage in-wall devices to deliver an advanced custom keypad control solution as part of a complete Crestron control system.

### Customizable Buttons

Exquisite  
**DATE: MAY 17th, 2017**  
A single Cameo Keypad can be configured easily by the installer to provide from two to eight buttons. Each keypad is actually furnished with an assortment of button caps in four


### \* MODIFICATIONS:

1. Provide more information on the GLA-PWS50 for contractors.
2. Contractor to coordinate installation on site with reference to slab conduits that are currently installed.
3. If changes are required to the network layout shown in this shop drawing, the changes are to be marked up on drawings updated for the final As-Built submission for this project.
4. Electrical to coordinate with system supplier to ensure a complete and operational system is achieved.
5. Coordinate changes to drawings with contractors comments provided to you on May 9th, 2017.

button caps in four sizes. Button caps may be used to clearly designate

to use "button" button by tapping, "Shift key" button while customization for this

customizable button text built-in light sensor give crisp, legible text

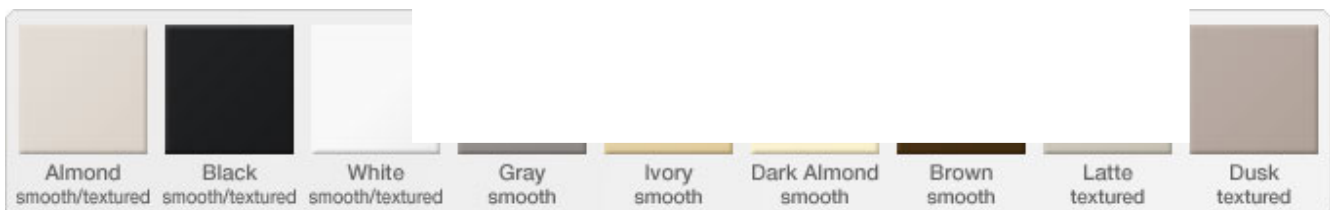

Actual colors may vary.

# C2N-CBD-P Cameo® Keypad, Standard Mount

## Enhanced LED Feedback

Six pinhead-sized white LEDs afford fully customizable feedback to show the status of each button. Ten blink terms are built in, enabling blinking LED feedback with simplified programming and reduced traffic on the Cresnet® network. Onboard bar graph logic allows the feedback LEDs to function as a 6-segment bar graph display, providing clear level indication while adjusting lighting and audio settings. Auto-dimming LED intensity ensures optimal visibility under any lighting conditions.

## Ambient Light Sensor

In addition to controlling the backlight and LED intensity, the built-in light sensor can also be utilized by the control system to support basic daylight harvesting and other programmatic functions.

## Control Ports

Dual digital/analog input ports onboard the C2N-CBD-P provide a local interface for a range of devices including the Crestron GLS Series Occupancy Sensors and Photosensors or a contact for door closure, DC logic, or 0-10 Volts DC analog voltage. Using the control ports, it's possible to add monitoring of room occupancy, ambient light level, door closures, and other conditions without having to home run extra wiring to the central equipment location.

## Cresnet

The Cresnet bus is the communications backbone for many Crestron keypads, lighting controllers, shade motors, sensors, and other devices. Cresnet is a simple, yet flexible 4-wire network that provides bidirectional communication and 24VDC power for Cresnet devices. Up to 252 keypads and other devices.

## Standard Wall Mount

Cameo Standard Mount Keypads are designed for use in an electrical wall box, making them perfect for use alongside other low-voltage devices. Available with "smooth" or "textured" finishes, Cameo Standard Mount Keypads are a popular off-the-shelf decorator-style faceplate.

## Ascent® Metal Faceplates

For the ultimate in style and elegance, Crestron offers solid metal faceplates (CBD-FP-ASCENT) with a contemporary appearance in a range of finishes.

## SPECIFICATIONS

### Buttons

**Keypad Buttons:** Configurable for 2 to 8 single-action pushbuttons  
**Button Events:** Programmable for Normal, Tap, Double-Tap, and Press and Hold

**Button Caps:** Includes (2) large, (3) medium, (5) small, and (2 pair) split small button caps;<sup>[3]</sup>

All button caps are blank. Custom-engraved, backlit button caps are available separately.

**Backlight:** White LED backlight for button engraving; Software-adjustable intensity, auto-dimmable

### LED Indicators

**Feedback:** (6) White LEDs, one per each of 6 small button positions; Programmable, auto-dimmable, software-adjustable intensity, 10 blinking patterns

**Bar Graph:** (1) 6-segment bar graph display utilizing the 6 feedback LEDs

### Light Sensor

Photosensor for ambient light auto-dimming function; Can be configured to report ambient light level to control system

### Connectors

**NET:** 4-pin 3.5mm detachable terminal block; Cresnet® slave port, connects to Cresnet control network

**Input Ports:** 2-pin detachable terminal block comprising (2) digital/analog input ports (referenced to GND);

**Impedance:** 200k Ohms, logic level

**Voltage:** 24 Volts DC maximum, 0-10VDC

**Current:** 10mA per pin

**Power:** 240mA

**Voltage:** 24 Volts DC

**Current:** 10mA

**Power:** 240mA

**Voltage:** 24 Volts DC

**Current:** 10mA

**Power:** 240mA

**Voltage:** 24 Volts DC

**Current:** 10mA

**Power:** 240mA

**Voltage:** 24 Volts DC

**Current:** 10mA

**Power:** 240mA

REVIEWED  
 REVISED AND MODIFIED  
 REVISE AND RESUBMIT  
 NOT REVIEWED

The review of IRP Engineering is for the sole purpose of ascertaining conformance with the general design concept. This review shall not mean the detail design inherent in the shop drawings are approved, responsibility of which shall remain with the Contractor submitting same and review shall not relieve the Contractor of this responsibility for errors or omissions in the shop drawings or his responsibility for meeting all requirements of the Contract Documents. The Contractor is responsible for dimensions to be confirmed and correlated at the job site, for information that pertains solely to fabrication processes or to techniques of construction and installation and for co-ordination of the work of all sub-trades.

IRP Engineering  
C. McGuire

DATE: IN MAY 17th, 2017

### \* MODIFICATIONS:

1. Provide more information on the GLA-PWS50 for contractors.
2. Contractor to coordinate installation on site with reference to slab conduits that are currently installed.
3. If changes are required to the network layout shown in this shop drawing, the changes are to be marked up on drawings updated for the final As-Built submission for this project.
4. Electrical to coordinate with system supplier to ensure a complete and operational system is achieved.
5. Coordinate changes to drawings with contractors comments provided to you on May 9th, 2017.

rical box or mud ring  
late (not included) or Crestron

# C2N-CBD-P Cameo® Keypad, Standard Mount

## Dimensions

**Height:** 4.13 in (105 mm) without faceplate  
**Width:** 1.75 in (45 mm) without faceplate  
**Depth:** 1.19 in (31 mm) without connector

## Weight

2.3 oz (64 g)

## MODELS & ACCESSORIES

### Available Models

**C2N-CBD-P-A-S:** Cameo® Keypad, Standard Mount, Almond Smooth  
**C2N-CBD-P-A-T:** Cameo® Keypad, Standard Mount, Almond Textured  
**C2N-CBD-P-B-S:** Cameo® Keypad, Standard Mount, Black Smooth  
**C2N-CBD-P-B-T:** Cameo® Keypad, Standard Mount, Black Textured  
**C2N-CBD-P-BRN-S:** Cameo® Keypad, Standard Mount, Brown Smooth  
**C2N-CBD-P-DA-S:** Cameo® Keypad, Standard Mount, Dark Almond Smooth  
**C2N-CBD-P-DSK-T:** Cameo® Keypad, Standard Mount, Dusk Textured  
**C2N-CBD-P-GRY-S:** Cameo® Keypad, Standard Mount, Gray Smooth  
**C2N-CBD-P-IVR-S:** Cameo® Keypad, Standard Mount, Ivory Smooth  
**C2N-CBD-P-LAT-T:** Cameo® Keypad, Standard Mount, Latte Textured  
**C2N-CBD-P-W-S:** Cameo® Keypad, Standard Mount, White Smooth  
**C2N-CBD-P-W-T:** Cameo® Keypad, Standard Mount, White Textured

### Available Accessories

**CB2-BTN:** Large Backlit Engravable Button Cap for Cameo Keypads, [Specify Color]  
**CB3-BTN:** Medium Backlit Engravable Button Cap for Cameo Keypads, [Specify Color]  
**CB6-BTN:** Small Backlit Engravable Button Cap for Cameo Keypads, [Specify Color]  
**CB6S-BTN:** Split Small Backlit Engravable Button Cap Pair for Cameo Keypads, [Specify Color]  
**CBD-FP-ASCENT:** Ascent® Solid Metal Faceplate for Cameo® Keypad, Standard Mount [specify button layout and finish]  
**CCR-L-1:** Crestron® Color Ring  
**CCR-FP-ASCENT-1:** Ascent® Color Ring  
**CRESNET-HP-NP:** Cresnet® “High-Power” Control Cable, non-plenum  
**CRESNET-NP:** Cresnet® Control Cable, non-plenum  
**CRESNET-P:** Cresnet® Control Cable, plenum

## Notes:

1. Custom engraving sold separately.
2. Item(s) sold separately.
3. Split small buttons may be installed in the bottom two positions only.

- This product may be purchased from an authorized Crestron dealer. To find a dealer, please contact the Crestron sales representative for your area. A list of sales representatives is available online at [www.crestron.com](http://www.crestron.com). Sales representative phone number: 800.237.2041.
- REVIEWED AND MODIFIED**
- REVISE AND RESUBMIT**
- NOT REVIEWED**
- The specific patents that cover Crestron products are listed online at: [patents.crestron.com](http://patents.crestron.com).  
Some Crestron products contain open source software. For specific information, visit [www.crestron.com/opensource](http://www.crestron.com/opensource).

**The review by JRP Engineering is for the sole purpose of ascertaining conformance with the general design concept. This review shall not mean the detail design inherent in the shop drawings are approved, responsibility of which shall remain with the Contractor submitting same and review shall not relieve the Contractor of this responsibility for errors or omissions in the shop drawings or his responsibility for meeting all requirements of the Contract Documents. The Contractor is responsible for dimensions to be confirmed and correlated at the job site, for information that pertains solely to fabrication processes or to techniques of construction and installation and for co-ordination of the work of all sub-trades.**

**JRP Engineering**

**C.McGuire**


DATE: MAY 17th, 2017

### \* MODIFICATIONS:

1. Provide more information on the GLA-PWS50 for contractors.
2. Contractor to coordinate installation on site with reference to slab conduits that are currently installed.
3. If changes are required to the network layout shown in this shop drawing, the changes are to be marked up or drawings updated for the final As-Built submission for this project.
4. Electrical to coordinate with system supplier to ensure a complete and operational system is achieved.
5. Coordinate changes to drawings with contractors comments provided to you on May 9th, 2017.

# C2N-CBD-P Cameo® Keypad, Standard Mount





- REVIEWED
- REVIEWED AND MODIFIED
- REVISE AND RESUBMIT
- NOT REVIEWED

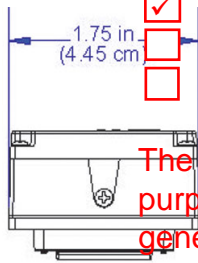

The review by JRP Engineering is for the sole purpose of ascertaining conformance with the general design concept. This review shall not mean the detail design inherent in the shop drawings are approved, responsibility of which shall remain with the Contractor submitting same and review shall not relieve the Contractor of this responsibility for errors or omissions in the shop drawings or his responsibility for meeting all requirements of the Contract Documents. The Contractor is responsible for dimensions to be confirmed and correlated at the job site, for information that pertains solely to fabrication processes or to techniques of construction and installation and for co-ordination of the work of all sub-trades.

JRP Engineering  
C. McGuire

DATE: MAY 17th, 2017

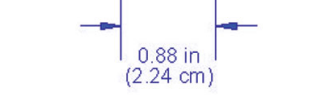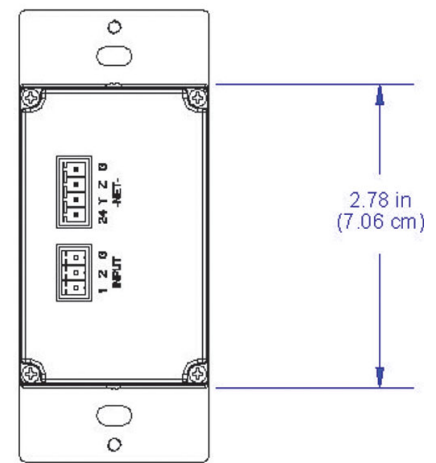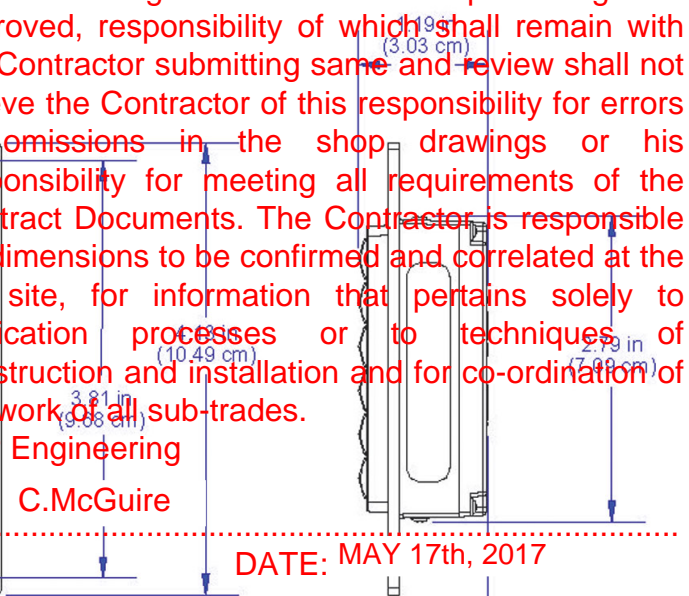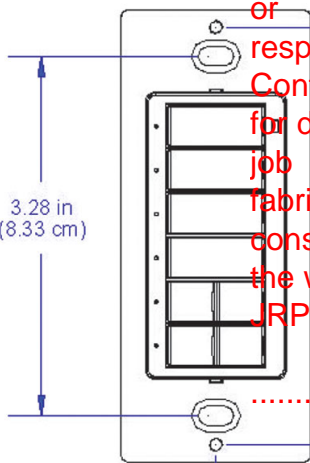

**\* MODIFICATIONS:**

1. Provide more information on the GLA-PWS50 for contractors.
2. Contractor to coordinate installation on site with reference to slab conduits that are currently installed.
3. If changes are required to the network layout shown in this shop drawing, the changes are to be marked up or drawings updated for the final As-Built submission for this project.
4. Electrical to coordinate with system supplier to ensure a complete and operational system is achieved.
5. Coordinate changes to drawings with contractor comments provided to you on May 9th, 2017.

# GLA-PWS50

## Wall Mount 50 Watt Cresnet Power Supply

The GLA-PWS50 is a 50 Watt Cresnet Power Supply designed for use with a Crestron Green Light? system, or anywhere a wall-mountable Cresnet power supply is needed. The GLA-PWS50 mounts conveniently over a 4" square or 2-gang electrical box. All connections are made inside the electrical box via flying leads using twist-on wire connectors. A partition is included to isolate high voltage from Class 2 wiring within the box.

- > 50 Watt Cresnet power supply
- > Powers the IPAC and other Cresnet devices
- > Provides backup power for Crestron Green Light controllers
- > Mounts to a 4" square or 2-gang electrical box
- > Euro/UK mountable version also available (GLA-PWS50)

### SPECIFICATIONS

#### Output Power

Output Power: 50 Watts (2.1 Amps) @ 24 Volts DC, regulated, limited power source  
Ripple/Noise: <1%

#### Power Requirements

Line Power: 1 Amp @ 100-240 Volts AC, 50/60 Hz

#### Connections

Line Power: (3) 6" flying leads, 18 AWG, line power input; Hot (black), neutral (white), and ground (green w/yellow) connections  
Output: (2) 6" flying leads, 18 AWG, Cresnet power output; 24 Volts DC (red) and Ground (black w/white);  
Connects to "24" and "G" connections of the Cresnet control network, or directly to a 24 Volt DC powered Crestron device  
Fuse: DC output fuse, T3.15AH;  
(5x20mm, 250V, 3.15A, time-lag, ceramic cartridge)

#### LED Indicators

24VDC: (1) green LED, indicates 24 Volts DC output, extinguishes when blown

#### Environmental

Temperature: 32° to 104°F (0° to 40°C)  
Humidity: 10% to 90% RH (non-condensing)  
Heat Dissipation: 26 BTU/hr

#### Enclosure

Metal construction, mounts to a 4-inch square or 2-gang electrical box with low-voltage partition

#### Dimensions

Height: 4.00 in (10.16 cm)  
Width: 5.55 in (14.09 cm)  
Depth: 2.27 in (5.76 cm) without partition

REVIEWED  
 REVIEWED AND MODIFIED  
 REVISE AND RESUBMIT  
 NOT REVIEWED

The review by JRP Engineering is for the sole purpose of ascertaining conformance with the general design concept. This review shall not mean the detail design inherent in the shop drawings are approved, responsibility of which shall remain with the Contractor submitting same and review shall not relieve the Contractor of this responsibility for errors or omissions in the shop drawings or his responsibility for meeting all requirements of the Contract Documents. The Contractor is responsible for dimensions to be confirmed and correlated at the job site, for information that pertains solely to fabrication and to techniques of construction and installation and for co-ordination of the work of all sub-trades.

JRP Engineering

C.McGuire

DATE: MAY 17th, 2017

#### \* MODIFICATIONS:

1. Provide more information on the GLA-PWS50 for contractors.
2. Contractor to coordinate installation on site with reference to slab conduits that are currently installed.
3. If changes are required to the network layout shown in this shop drawing, the changes are to be marked up or drawings updated for the final As-Built submission for this project.
4. Electrical to coordinate with system supplier to ensure a complete and operational system is achieved.
5. Coordinate changes to drawings with contractors comments provided to you on May 9th, 2017.



#### Weight

2.2 lb (0.94 kg)

#### Available Models

GLA-PWS50-1002457 Wall Mount 50 Watt Cresnet Power Supply

# GLA-PWS50 Wall Mount 50 Watt Cresnet Power Supply

- REVIEWED
- REVIEWED AND MODIFIED
- REVISE AND RESUBMIT
- NOT REVIEWED

The review by JRP Engineering is for the sole purpose of ascertaining conformance with the general design concept. This review shall not mean the detail design inherent in the shop drawings are approved, responsibility of which shall remain with the Contractor submitting same and review shall not relieve the Contractor of this responsibility for errors or omissions in the shop drawings or his responsibility for meeting all requirements of the Contract Documents. The Contractor is responsible for dimensions to be confirmed and correlated at the job site, for information that pertains solely to fabrication processes or to techniques of construction and installation and for co-ordination of the work of all subcontractors.


JRP Engineering

C. McGuire

DATE: MAY 17th, 2017

**\* MODIFICATIONS:**

1. Provide more information on the GLA-PWS50 for contractors.
2. Contractor to coordinate installation on site with reference to slab conduits that are currently installed.
3. If changes are required to the network layout shown in this shop drawing, the changes are to be marked up or drawings updated for the final As-Built submission for this project.
4. Electrical to coordinate with system supplier to ensure a complete and operational system is achieved.
5. Coordinate changes to drawings with contractors comments provided to you on May 9th, 2017.

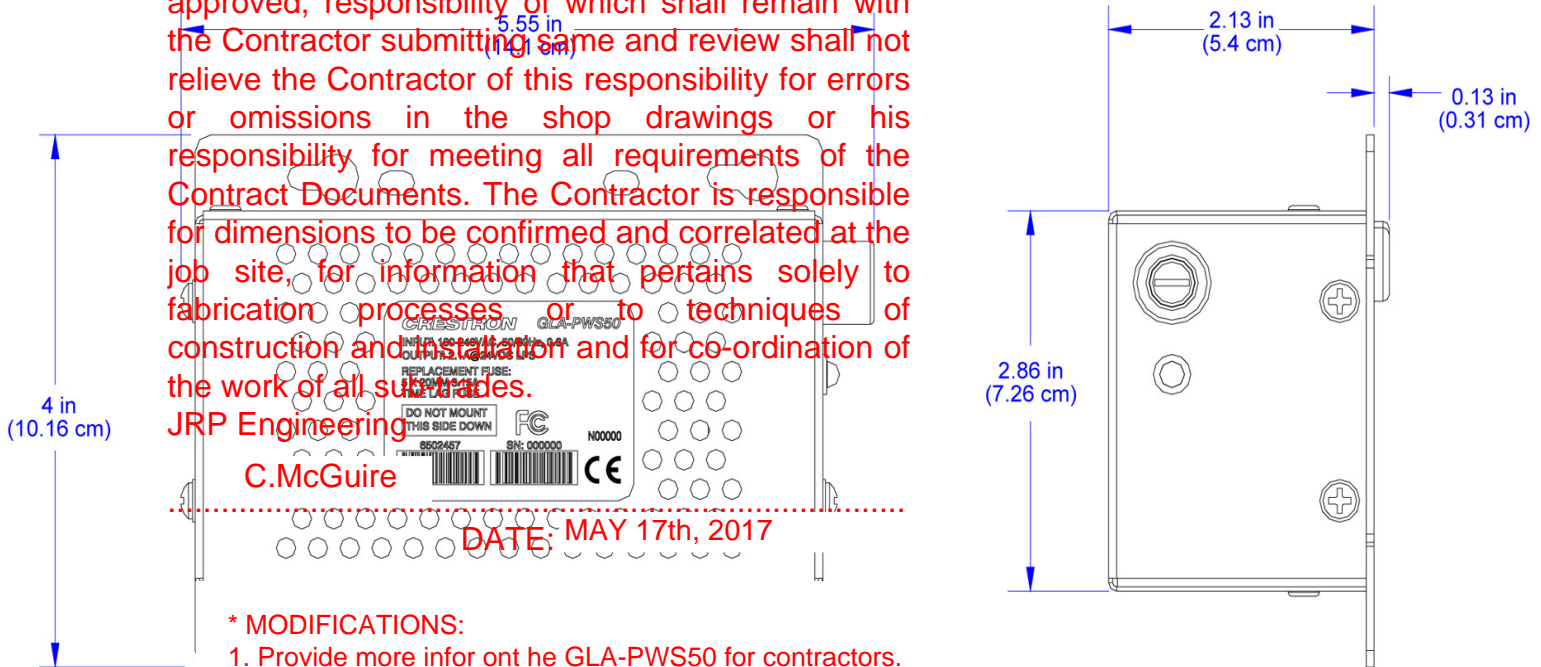


## Keypad for GLPP Systems

- REVIEWED
- REVIEWED AND MODIFIED
- REVISE AND RESUBMIT
- NOT REVIEWED

- > In-wall keypads for GLPP systems
- > Master Scene keypad for multiple scene recall, Zone Keypads for specific zone control, Occupancy Sensing, and Zone Master Keypad for lighting control in single rooms with multiple zones
- > Seamless integration with GLPP systems
- > 2-conductor wire connection to the bus
- > Flexible installation in low-voltage, low-current, low-voltage wiring
- > Non-polarized 2-wire communications bus
- > Smooth black, white, or almond colors available
- > Rocker switch and four button caps included, depending on model
- > Up to 3 GLPPA-KP Series in 2 occupancies and 1 photosensor can be connected to a single GLPP system

The review by JRP Engineering is for the sole purpose of ascertaining conformance with the general design concept. This review shall not mean the detail design inherent in the shop drawings are approved, responsibility of which shall remain with the Contractor submitting same and review shall not relieve the Contractor of this responsibility for errors or omissions in the shop drawings or his responsibility for meeting all requirements of the Contract Documents. The Contractor is responsible for dimensions to be confirmed and correlated at the job site for information that pertains solely to fabrication processes or to techniques of construction and installation and for co-ordination of the work of all sub-trades.

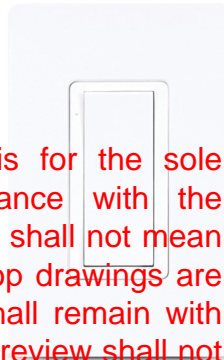

The GLPPA-KP Series of In-wall Keypads feature "plug and play" control of loads connected to a Crestron Universal Light Power Pack (ULLP) system. This versatile family of keypads offers a simple lighting control solution with out-of-the-box functionality for quick and easy system setup. Use the keypads to turn the load on or off and to set and recall scenes. "Zone Keypad" models connect automatically to the GLPP for individual zone control and do not require any programming. A rocker button, multi-zone model keypad provides zoned lighting control from a single interface. The GLPPA-KP Series easily connects to the GLPP main unit via a two-wire, low-voltage bus. Available in white, and almond, the GLPPA-KP keypads suit almost any décor.

### Easy Installation

Two flying leads connect a GLPPA-KP Series keypad to the GLPP system via a non-polarized, low-voltage bus. Use new or existing high-voltage wiring (Class 2) for quick installation. Up to three keypads, two occupancy sensors, and one photosensor can be connected to any single GLPP system.

### SPECIFICATIONS

#### Power Requirements

at 24 Volts DC) supplied by GLPP over proprietary 2-wire bus

#### Flexible Configurations

Crestron® offers several easy-to-configure lighting

- The GLPPA-KP Master rocker-switch for on The four-button con master on and off c adjusted by any use GLPPA-REMOTE-PR
- Zone Keypad models lighting control syst is pre-programmed example, in a two-z automatically contr
- The GLPPA-KP4 four-series by providing c room. The four butt 3-channel GLPP sys

Up to three GLPPA-KP key

#### \* MODIFICATIONS:

1. Provide more infor ont he GLA-PWS50 for contractors.
2. Contractor to coordinate installation on site with reference to slab conduits that are currently installed.
3. If changes are required to the network layout shown in this shop drawing, the changes are to be marked up or drawings updated for the final As-Built submission for this project.
4. Electrical to coordinate with system supplier to ensure a complete and operational system is achieved.
5. Coordinate changes to drawings with contractors comments provided to you on May 9th, 2017.

DATE: MAY 17th, 2017

ble for single rocker switch or (4) single-action

-tap, Press and Hold (not all events trigger

ocker and (4) small button caps with labeling s Only): Pre-labeled: ALL ON, SCENE 1,

y

-action pushbuttons

nd Hold (not all events trigger actions)

on caps with labeling; Ships with (1) additional

s Only): (5) Pre-labeled button caps: ALL ON,

SCENE 1, SCENE 2, SCENE3, ALL OFF

# GLPPA-KP Keypad for GLPP Systems

## LED Indicators

Feedback (GLPPA-KP Model Only): (1) White LED, illuminates when any load is above 0%

REVIEWED

## Connections

Communications Bus: (2) 18 AWG Class 2 flying leads, white with black stripe (non-polarized)

REVIEWED AND MODIFIED

REVISE AND RESUBMIT

NOT REVIEWED

## Environmental

Temperature: 32° to 113° F (0° to 45° C)

Humidity: 10% to 90% RH (non-condensing)

## Enclosure

Plastic, 1-gang mountable in a standard electrical box; Requires decorator style faceplate (not included)

## Dimensions

Height: 4.13 in (105 mm)

Width: 1.75 in (45 mm)

Depth: 1.8 in (46 mm)

## Weight

3.6 oz (103 g)

## MODELS

### Available Models

GLPPA-KP-A-S: In-wall Master Scene Keypad for GLPP, Almond Smooth

GLPPA-KP-B-S: In-wall Master Scene Keypad for GLPP, Black Smooth

GLPPA-KP-W-S: In-wall Master Scene Keypad for GLPP, White Smooth

GLPPA-KP1-A-S: In-wall Zone Keypad for GLPP, Almond Smooth

GLPPA-KP1-B-S: In-wall Zone Keypad for GLPP, Black Smooth

GLPPA-KP1-W-S: In-wall Zone Keypad for GLPP, White Smooth

GLPPA-KP2-A-S: In-wall Zone Keypad for GLPP, Almond Smooth

GLPPA-KP2-B-S: In-wall Zone Keypad for GLPP, Black Smooth

GLPPA-KP2-W-S: In-wall Zone Keypad for GLPP, White Smooth

GLPPA-KP3-A-S: In-wall Zone Keypad for GLPP, Almond Smooth

GLPPA-KP3-B-S: In-wall Zone Keypad for GLPP, Black Smooth

GLPPA-KP3-W-S: In-wall Zone Keypad for GLPP, White Smooth

GLPPA-KP4-A-S: In-wall Zone Master Keypad for GLPP, Almond Smooth

GLPPA-KP4-B-S: In-wall Zone Master Keypad for GLPP, Black Smooth

GLPPA-KP4-W-S: In-wall Zone Master Keypad for GLPP, White Smooth

Notes:

This product may be purchased from an authorized Crestron dealer. To find a dealer, please contact the Crestron sales representative for your area. A list of sales representatives is available on the [www.crestron.com](http://www.crestron.com) website or by calling 800-237-2041.

The specific patents that cover Crestron products are listed online at: [patents.crestron.com](http://patents.crestron.com).

Certain Crestron products contain open source software. For specific information, visit [www.crestron.com/opensource](http://www.crestron.com/opensource).

The review by JRP Engineering is for the sole purpose of ascertaining conformance with the general design concept. This review shall not mean the detail design inherent in the shop drawings are approved, responsibility of which shall remain with

Crestron, the Crestron logo, and Crestron Green Light are either trademarks or registered trademarks of Crestron Electronics, Inc. in the United States and/or other countries. Other trademarks, registered trademarks, and trade names may be used in this document to refer to either the entities claiming the marks and names or their products. Crestron disclaims any liability for errors in the mark and name of other entities. Crestron is not responsible for errors in typography or photography. Specifications are subject to change without notice.  
© 2016 Crestron Electronics, Inc.

the Contractor submitting same and review shall not relieve the Contractor of this responsibility for errors or omissions in the shop drawings or his responsibility for meeting all requirements of the Contract Documents. The Contractor is responsible for dimensions to be confirmed and correlated at the job site, for information that pertains solely to fabrication processes or to techniques of construction and installation and for co-ordination of the work of all sub-trades.

JRP Engineering

C.McGuire

DATE: MAY 17th, 2017

### \* MODIFICATIONS:

1. Provide more information on the GLA-PWS50 for contractors.
2. Contractor to coordinate installation on site with reference to slab conduits that are currently installed.
3. If changes are required to the network layout shown in this shop drawing, the changes are to be marked up on drawings updated for the final As-Built submission for this project.
4. Electrical to coordinate with system supplier to ensure a complete and operational system is achieved.
5. Coordinate changes to drawings with contractors comments provided to you on May 9th, 2017.

# GLPPA-KP Keypad for GLPP Systems

## CAD DRAWINGS (GLPPA-KP MODEL SHOWN)

- REVIEWED
- REVIEWED AND MODIFIED
- REVISE AND RESUBMIT
- NOT REVIEWED

The review by JRP Engineering is for the sole purpose of ascertaining conformance with the general design concept. This review shall not mean the detail design inherent in the shop drawings are approved, responsibility of which shall remain with the Contractor submitting same and review shall not relieve the Contractor of this responsibility for errors or omissions in the shop drawings or his responsibility for meeting all requirements of the Contract Documents. The Contractor is responsible for dimensions to be confirmed and correlated at the job site, for information that pertains solely to fabrication processes or to techniques of construction and installation and for co-ordination of the work of all sub-trades.

JRP Engineering

C.McGuire

DATE: MAY 17th, 2017

### \* MODIFICATIONS:

1. Provide more information on the GLA-PWS50 for contractors.
2. Contractor to coordinate installation on site with reference to slab conduits that are currently installed.
3. If changes are required to the network layout shown in this shop drawing, the changes are to be marked up on drawings updated for the final As-Built submission for this project.
4. Electrical to coordinate with system supplier to ensure a complete and operational system is achieved.
5. Coordinate changes to drawings with contractors comments provided to you on May 9th, 2017.

# GLS-PART-CN

## Cresnet® Partition Sensor

- > Sleek, compact design
- > Adjustable infrared beam for high accuracy
- > Sensing distance of up to 4 feet
- > Cresnet® for power and communications
- > Crestron® control system integration via Cresnet
- > Digital output provides either 24 Volts DC, 10 mA output, or a closure to ground
- > Visible LED display that indicates sensor status



REVIEWED  
 REVIEWED AND MODIFIED  
 REVISE AND RESUBMIT  
 NOT REVIEWED

The review by JRP Engineering is for the sole purpose of ascertaining conformance with the general design concept. This review shall not mean the detail design inherent in the shop drawings are approved, responsibility of which shall remain with the contractor submitting same and review shall not relieve the Contractor of this responsibility for errors or omissions in the shop drawings or his responsibility for meeting all requirements of the Contract Documents. The Contractor is responsible for dimensions to be confirmed and correlated at the job site for information that pertains solely to fabrication processes or to techniques of construction and installation and for coordination of the work of all sub-trades.

The GLS-PART-CN is a sleek, surface-mount partition sensor that utilizes the dependable Cresnet® wired network for power and communications. Designed with hospitality environments in mind, this easily installed sensor uses an infrared (IR) beam to sense the position of movable partitions within a space. The IR beam's signal strength is adjustable, providing a sensing distance of up to four feet, making the GLS-PART-CN a versatile partition sensor with optimized sensing accuracy. Three LEDs on the unit provide at-a-glance information on the sensor's state of power, communications, and partition detection. The GLS-PART-CN offers mounting options for rooms with finished or drop ceilings.

The GLS-PART-CN has plug-in outputs and built-in time delays. Also, the partition sensor easily connects via Cresnet to a Crestron control processor to manage divisible room environments.

**Sensing**  
 Method of Detection: Diffuse reflective  
 Light Source: Pulse-modulated infrared LED  
 IR Sensitivity: Adjustable  
 Sensing Distance: 0 to 122 cm

### Cresnet

The GLS-PART-CN uses the dependable Cresnet wired network for communication between devices. Cresnet provides a simple solution for configuring and wiring sensors as part of a Crestron system. Cresnet is the communications backbone for lighting dimmers, keypads, shades, thermostats, and many other devices. This flexible bus provides data communications and 24 Volts DC power for all of the devices on the Cresnet network.

### Connectors

NET/EXT: (1) 5-pin 3.5mm detachable terminal block; Cresnet® slave port and digital output port; either 24 Volts DC, 10 mA (default) or a closure to ground when partition is detected

### Versatile Installation

The GLS-PART-CN has a white faceplate for drop ceilings. For droptile ceilings, the 3-1/2 inch deep electrical box. A faceplate<sup>(1)</sup> can be used to match room. Only about 20 mm of the ceiling is required for making it an unobtrusive addition.

### Digital Output

This sleek sensor delivers unpaired digital output on the terminal block, with integration with a Crestron Control Processor. The Cresnet connector provides a closure to ground, perfect for connection to a digital output device.

### \* MODIFICATIONS:

1. Provide more information on the GLA-PWS50 for contractors.
2. Contractor to coordinate installation on site with reference to slab conduits that are currently installed.
3. If changes are required to the network layout shown in this shop drawing, the changes are to be marked up or drawings updated for the final As-Built submission for this project.
4. Electrical to coordinate with system supplier to ensure a complete and operational system is achieved.
5. Coordinate changes to drawings with contractors and comments provided to you on May 9th, 2017.

Power is supplied to device; flashes to indicate partition detection  
 LED indicates Cresnet communication status  
 LED indicates partition detection  
 LED indicates IR beam sensitivity of IR beam; also used for partition detection  
 LED indicates IR beam sensitivity of IR beam; also used for partition detection

24 Volts DC

Operating Temperature: 0° to 55° C)

# GLS-PART-CN Cresnet® Partition Sensor

## Housing

**Construction:** Plastic

**Mounting:** Surface mount; 1-gang mountable in a 3-1/2 inch deep electrical box, fits decorator-style faceplate

- REVIEWED
- REVIEWED AND MODIFIED
- REVISE AND RESUBMIT
- NOT REVIEWED

## Dimensions

**Height:** 2.23 in (57 mm)

**Width:** 4.16 in (106 mm)

**Depth:** 1.35 in (34 mm)

## Weight

3.32 oz (94 g)

## MODELS & ACCESSORIES

### Available Models

**GLS-PART-CN-W:** Cresnet® Partition Sensor, White

#### Notes:

1. Sold separately.

This product may be purchased from an authorized Crestron dealer. To find a dealer, please contact the Crestron sales representative for your area. A list of sales representatives is available online at [www.crestron.com/salesreps](http://www.crestron.com/salesreps) or by calling 800-237-2041.

The specific patents that cover Crestron products are listed online at: [patents.crestron.com](http://patents.crestron.com).

Certain Crestron products contain open source software. For specific information, visit [www.crestron.com/opensource](http://www.crestron.com/opensource).

Crestron, the Crestron logo, Cresnet, and Crestron Control System are either trademarks or registered trademarks of Crestron Electronics, Inc. in the United States and/or other countries. Other trademarks, registered trademarks, and trade names may be used in this document to refer to either the entities claiming the marks and names or their products. Crestron disclaims proprietary interest in the marks and names of others. Crestron is not responsible for errors in typography or photography. Specifications are subject to change without notice.  
©2015 Crestron Electronics, Inc.

The review by JRP Engineering is for the sole purpose of ascertaining conformance with the general design concept. This review shall not mean the detail design inherent in the shop drawings are approved, responsibility of which shall remain with the Contractor submitting same and review shall not relieve the Contractor of this responsibility for errors or omissions in the shop drawings or his responsibility for meeting all requirements of the Contract Documents. The Contractor is responsible for dimensions to be confirmed and correlated at the job site, for information that pertains solely to fabrication processes or to techniques of construction and installation and for co-ordination of the work of all sub-trades.

JRP Engineering  
C.McGuire


DATE: MAY 17th, 2017

#### \* MODIFICATIONS:

1. Provide more information on the GLA-PWS50 for contractors.
2. Contractor to coordinate installation on site with reference to slab conduits that are currently installed.
3. If changes are required to the network layout shown in this shop drawing, the changes are to be marked up or drawings updated for the final As-Built submission for this project.
4. Electrical to coordinate with system supplier to ensure a complete and operational system is achieved.
5. Coordinate changes to drawings with contractors comments provided to you on May 9th, 2017.

# GLS-PART-CN Cresnet® Partition Sensor

- REVIEWED
- REVIEWED AND MODIFIED
- REVISE AND RESUBMIT
- NOT REVIEWED

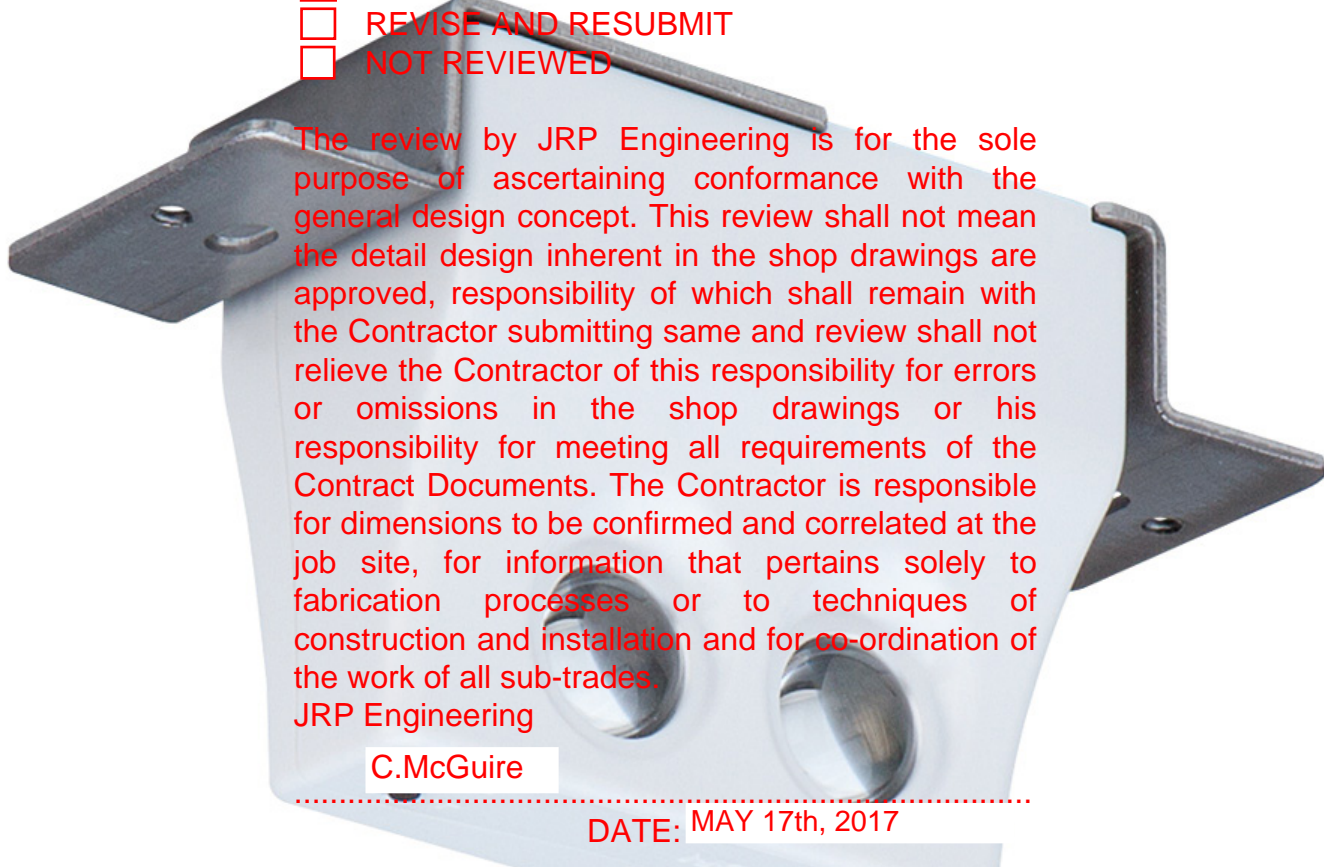

The review by JRP Engineering is for the sole purpose of ascertaining conformance with the general design concept. This review shall not mean the detail design inherent in the shop drawings are approved, responsibility of which shall remain with the Contractor submitting same and review shall not relieve the Contractor of this responsibility for errors or omissions in the shop drawings or his responsibility for meeting all requirements of the Contract Documents. The Contractor is responsible for dimensions to be confirmed and correlated at the job site, for information that pertains solely to fabrication processes or to techniques of construction and installation and for co-ordination of the work of all sub-trades.

JRP Engineering

C.McGuire

DATE: MAY 17th, 2017

**\* MODIFICATIONS:**

1. Provide more information on the GLA-PWS50 for contractors.
2. Contractor to coordinate installation on site with reference to slab conduits that are currently installed.
3. If changes are required to the network layout shown in this shop drawing, the changes are to be marked up or drawings updated for the final As-Built submission for this project.
4. Electrical to coordinate with system supplier to ensure a complete and operational system is achieved.
5. Coordinate changes to drawings with contractors comments provided to you on May 9th, 2017.

# TSW-760

- REVIEWED
- REVIEWED AND MODIFIED
- REVISE AND RESUBMIT
- NOT REVIEWED

## 7" Touch Screen

- > Ultra clean, modern appearance
- > Thin profile and easy installation
- > Affordable and easy to install
- > 7" widescreen display with 1024 x 600 WGA display resolution
- > 1024 x 600 WGA display resolution
- > Capacitive touch screen technology
- > Multi-touch capable
- > Smart Graphics™ performance
- > Voice recognition capability
- > H.264 or MJPEG streaming video
- > Rava® SIP intercom and phone technology
- > Customizable audio feedback
- > Built-in web browsing
- > On-screen multi-language keyboard
- > Customizable screen saver
- > Built-in microphone and camera

The review by JRP Engineering is for the sole purpose of ascertaining conformance with the general design concept. This review shall not mean the detail design inherent in the shop drawings are approved, responsibility of which shall remain with the Contractor submitting same and review shall not relieve the Contractor of this responsibility for errors or omissions in the shop drawings or his responsibility for meeting all requirements of the Contract Documents. The Contractor is responsible for dimensions to be confirmed and correlated at the job site, for information that pertains solely to fabrication processes or to techniques of construction and installation and for co-ordination of the work of all sub-trades.

JRP Engineering


C. McGuire

Automatically adjusting completely when backlight is turned off

DATE: MAY 17th, 2017

### \* MODIFICATIONS:

1. Provide more information on the GLA-PWS50 for contractors.
  2. Contractor to coordinate installation on site with reference to slab conduits that are currently installed.
  3. If changes are required to the network layout shown in this shop drawing, the changes are to be marked up or drawings updated for the final As-Built submission for this project.
  4. Electrical to coordinate with system supplier to ensure a complete and operational system is achieved.
  5. Coordinate changes to drawings with contractors
- Comments provided to you on May 9th, 2017.

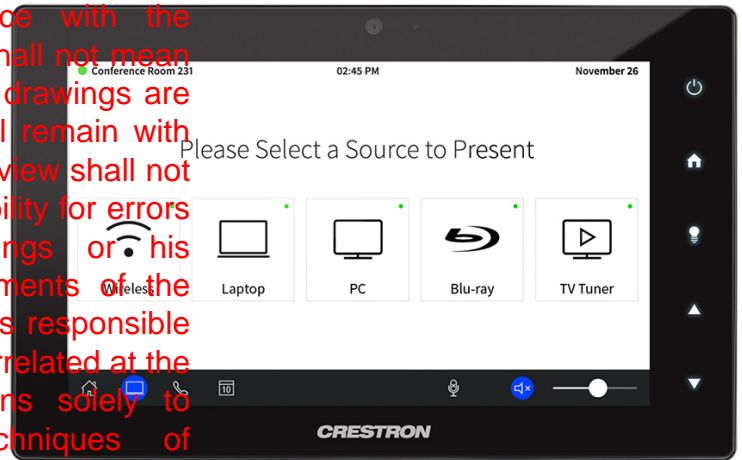

The TSW-760 delivers the ultimate touch screen experience in an unobtrusive, space-saving design featuring a brilliant 7 inch capacitive touch screen display with Smart Graphics™ and 5 soft-touch buttons. PoE connectivity and a range of mounting options make installation a breeze for both new and retrofit applications. Additional advanced features include control any function using voice commands, view security cameras and other video sources, communicate using built-in intercom and browse the Internet.<sup>[2]</sup>

Smart Graphics to deliver the ultimate user experience. Smart Graphics™ create value by enabling the creation of dynamically changing content. Smart Graphics™ create incredible efficiency and unparalleled user experience. Smart Graphics™ create Smart Graphics, programmers can swiftly integrate Smart Graphics, animated feedback, rich metadata, Smart Graphics, gets, and full-motion video for a deeply engaging user screen experience.

offers these enhancements and more:

5 soft-touch buttons, sliders, knobs, and gauges that are easy to use. Smart Graphics™ enhance the feeling of realism, with lists and toolbars that respond with instant momentum at the flick of a fingertip. Smart Graphics™ offers content that snap into place, offering an easy way to manage content.

Smart Graphics™ offers to personalize the touch screen with clocks, weather information, and other information. Smart Graphics™ offers a screen saver that allows display of time, temperature, and other text content at a reduced brightness level.

- Customizable themes allowing a completely different look and feel for every user, event, or season
- Fully-developed SmartObjects® that enable sophisticated control over complex devices with minimal programming
- A consistent look and feel across multiple touch screens of varying sizes


### Advanced Touch Screen

A Crestron® touch screen brings all the technology in your room to a single command center. Touch screen replaces cluttered wall switches and buttons, enhancing the way you interact with lighting, shades, HVAC, and more. Touch screens are fully-customizable and offer real-time status displays for web browsing, and advanced navigation of digital media servers, tuners, and other devices.<sup>[1]</sup>

With its clean, contemporary design highlighted by edge-to-edge glass and stunning color graphics, the Crestron TSW-760 touch screen makes an elegant statement on any wall, tabletop, or lectern. Perfectly at home in the most contemporary residence or modern office building, its high-tech good looks underline its power for simplifying everyday tasks and functions throughout any facility.

# TSW-760 7" Touch Screen

- REVIEWED
- REVIEWED AND MODIFIED
- REVISE AND RESUBMIT
- NOT REVIEWED

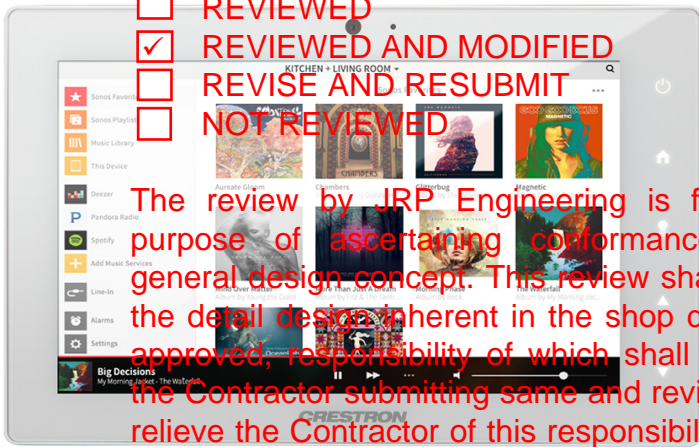

The review by JRP Engineering is for the sole purpose of ascertaining conformance with the general design concept. This review shall not mean the detail design inherent in the shop drawings are approved, responsibility of which shall remain with the Contractor submitting same and review shall not relieve the Contractor of this responsibility for errors or omissions in the shop drawings or his responsibility for meeting all requirements of the Contract Documents. The Contractor is responsible for dimensions to be confirmed and correlated at the job site, for information that pertains solely to fabrication processes or to techniques of construction and installation, and for co-ordination of the work of all trades.

TSW-760-W-S Shown in White

TSW-760-B-S and TSW-760-TTK TableTop Mounting Kit

## Soft-Touch Buttons

The TSW-760 includes five backlit, soft-touch capacitive buttons for quick access to commonly used functions. The buttons are pre-labeled with icons for "Power", "Home", "Lights", "Up", and "Down" functions. Each button is programmed to the control system for custom functionality. The buttons' backlighting can be manually adjusted to be optimal brightness according to the ambient light in the room. The backlight brightness is also customizable through programming. When the backlight is turned off, the buttons disappear. The buttons' backlighting is controlled on a per-button basis, the five buttons can be hidden or shown in any combination.

## Streaming Video

High-performance streaming video capability makes it possible to view security cameras and other video sources right on the touch screen. Native support for H.264 and MJPEG formats allows the TSW-760 to display live streaming video from an IP camera, a streaming encoder (Crestron CEN-NVS200, DM-TXRX-100-STR, or similar<sup>[4]</sup>), or a DigitalMedia™ switcher. Video is delivered to the touch screen over Ethernet, eliminating the need for any extra video wiring.

## Rava® SIP Intercom [1]

Rava Intercom Technology enables hands-free VoIP communication with other Rava-enabled touch screens and door stations. Rava works over a 2-way intercom, video intercom,<sup>[5]</sup> and paging without additional wiring. VoIP phone capability is also possible through SIP-compatible IP phone system or SIP server, allowing the functionality complete with speed-dialing, caller ID, and other enhancements. Built-in echo cancellation affords an advance for clear, seamless voice communication using the integrated microphone and speakers.

## Built-in Camera

The built-in camera can be used to see loved ones through video intercom, or another or to see Quick or unexpected TSW-760. For security camera can be used on screens or monitors.

## Voice Recognition

Some things are hard to do and let Crestron touch screen provides the ability. Voice recognition can play a specific music scene, lock the device. Simply press the touch screen. Crestron does the

## \* MODIFICATIONS:

1. Provide more information on the GLA-PWS50 for contractors.
2. Contractor to coordinate installation on site with reference to slab conduits that are currently installed.
3. If changes are required to the network layout shown in this shop drawing, the changes are to be marked up or drawings updated for the final As-Built submission for this project.
4. Electrical to coordinate with system supplier to ensure a complete and operational system is achieved.
5. Coordinate changes to drawings with contractors comments provided to you on May 9th, 2017.

DATE: MAY 17th, 2017

web browser, the TSW-760 provides quick access to desktop and other web-based services at the touch of a hand. A hand-danced touch screen control of DVRs and other devices, having to pick up a separate tablet or smartphone. If controlled or managed through a web browser, it can be used in a Crestron system through the TSW-760. Of course, the TSW-760 can also be used to simply browse the Internet, check traffic on a map, or up a recipe.<sup>[2]</sup>

# TSW-760 7" Touch Screen

## Native Sonos® App

Crestron is proud to feature a native Sonos app on the TSW-760 touch screen. With the app, users can enjoy the full Sonos experience since it is integrated directly with the Crestron Control System. The app is installed and configured app provides a wide variety of audio content that can be controlled and distributed through the audio system straight from the touch screen. The only app of its kind on the market, the Sonos app brings a versatile library and easy-to-use distribution controls for contractors, listeners and audiophiles alike.

## On-Screen Keyboard

Typing in passwords, URLs, and text searches is facilitated using the on-screen multi-language keyboard.

## Multi-Touch Support

The TSW-760's capacitive touch screen affords enhanced capabilities for browsing web pages using multi-touch gestures.

## Audio Feedback

Customized audio files can be loaded to add another dimension to the touch screen graphics using personalized sounds, button feedback, and voice prompts.

## Single-Wire Connectivity

A simple Ethernet LAN connection is all that is required to wire the TSW-760, containing all control, video, intercom, and power signals within a single wire.

## Power over Ethernet

Using PoE technology, the TSW-760 gets its operating power right through the LAN wiring. PoE (Power over Ethernet) eliminates the need for a local power supply or PoE injector. The TSW-760 (PWE-4803RU<sup>(4)</sup>) simply connects to a PoE switch at the location. Crestron PoE switches can also be used to provide a local power supply.

## Simple, Versatile Mounting

The TSW-760 is easily installed on a 2-gang European electrical drywall and other surfaces (H x 86mm W) cutout. The mounting surface and latch visible screws for an ultra

Crestron also offers the TSW-UMB-60, which provides a post-construction mounting solution for a variety of current TSW-760. The TSW-UMB-60 is used without having to cut or pre-drill hardware. For a pre-construction installation, the TSW-760 can be used along with a TSW-760-Masonry and concrete application kit (TSW-UMB-60) along with a TSW-760-Masonry and concrete application kit (TSW-UMB-60).

## Secure Mounting

Every TSW-760 includes an optional security latch for installations in which the physical security of the touch screen is important. When installed, the security latch ensures that a casual passerby cannot remove the TSW-760 from its mounted position in the wall. The latch can only be disengaged through a special removal sequence, protecting the touch screen against theft while still allowing serviceability where required.

## Tabletop Option

Using the optional Tabletop Kit (TSW-760-TTK<sup>(4)</sup>), the TSW-760 becomes a stylish, freestanding touch screen that fits perfectly on a table, desk, or countertop. It can even be permanently attached to the surface using the optional Swivel Mount Kit (TSW-560/760/1060-SMK<sup>(4)</sup>).

## SPECIFICATIONS

### Touch Screen Display

Display Type: TFT-LCD, active matrix color LCD

Size: 7 inch (178 mm) diagonal

Aspect Ratio: 15:9 WVGA

Resolution: 1024 x 600 pixels

Brightness: 350 nits (cd/m<sup>2</sup>)

Contrast: 1100:1

Color Depth: 24-bit, 16.7M colors

Illumination: Edgelit LED

Viewing Angle: ±80° horizontal, ±80° vertical

Touch Screen: Projected capacitive, 5-point multi-touch capable

REVIEWED  
REVIEWED AND MODIFIED  
REVISED AND RESUBMITTED  
NOT REVIEWED  
The reviewer is the sole purpose of ascertaining conformance with the general design concept. This review shall not mean the detail design inherent in the shop drawings are approved, responsibility of which shall remain with the Contractor submitting same and review shall not relieve the Contractor of this responsibility for errors or omissions in the shop drawings or his responsibility for meeting all requirements of the Contract Documents. The Contractor shall be responsible for dimensions to be confirmed and correlated at the job site, for information that pertains solely to fabrication processes or to techniques of construction and installation and for coordination of the work of all sub-trades.

JRP Engineering  
C. McGuire

DATE: MAY 17th, 2017

### \* MODIFICATIONS:

1. Provide more information on the GLA-PWS50 for contractors.
  2. Contractor to coordinate installation on site with reference to slab conduits that are currently installed.
  3. If changes are required to the network layout shown in this shop drawing, the changes are to be marked up or drawings updated for the final As-Built submission for this project.
  4. Electrical to coordinate with system supplier to ensure a complete and operational system is achieved.
  5. Coordinate changes to drawings with contractors
- comments provided to you on May 9th, 2017.

ected capacitive pushbuttons, programmable, "Power", "Home", "Lights", "Up", and "Down"; and disabled on a per-button basis. Button on rear panel for hardware reset.

multi-language web browser,<sup>[2]</sup> multi-rd, screensaver, single scalable streaming

inese (Simplified), Chinese (Traditional), sh (UK), English (US), Finnish, French, German, talian, Japanese, Korean, Norwegian, Polish, zilian), Romanian, Russian, Slovak, Spanish,

ic, Chinese (Simplified), Croatian, Czech, English (US), Finnish, French (Canada), French ew, Hungarian, Italian, Japanese, Norwegian Russian, Serbian, Spanish, Swedish, Turkish

Voice Recognition: Afrikaans (South Africa); Chinese, Mandarin (China, Simplified); Chinese, Mandarin (Hong Kong, Simplified); Chinese, Mandarin (Taiwan, Traditional); Chinese, Yue (Hong Kong, Traditional); Czech (Czech

# TSW-760 7" Touch Screen

Republic); Dutch (Netherlands); English (Australia); English (Canada); English (Generic); English (India); English (New Zealand); English (South Africa); English (UK); English (US); English (France); German (Germany); isiZulu (South Africa); Italian (Italy); Japanese (Japan); Korean (South Korea); Polish (Poland); Portuguese (Brazil); Russian (Russia); Spanish (Spain); Turkish (Turkey)

**Web Browser:** Arabic, Bulgarian, Catalan, Chinese, Croatian, Czech, Danish, Dutch, English, Filipino, Finnish, French, German, Greek, Hebrew, Hindi, Hungarian, Indonesian, Italian, Japanese, Korean, Latvian, Lithuanian, Norwegian Bokmal, Pashto, Persian, Polish, Portuguese, Romanian, Romansh, Russian, Serbian, Slovak, Slovenian, Spanish, Swedish, Thai, Turkish, Ukrainian, Vietnamese

## Memory

**DDR3L RAM:** 2 GB  
**Storage:** Firmware/Application: 4 GB Class 10 microSD card<sup>(4)</sup>  
System: 4 GB eMMC  
**Maximum Project Size:** 600 MB

## Communications

**Ethernet:** 10/100 Mbps, auto-switching, auto-negotiating, auto-discovery, full/half duplex, TCP/IP, UDP/IP, ARP, DHCP, SSL, TLS, SSH, SFTP (SSH File Transfer Protocol), IEEE 802.1X, SNMPv1/v2c, IEEE 802.3at and 802.3at Type 1 compliant

## Streaming Decoder

**Video Formats:** H.264 (MPEG-4 part 10)  
Decodes and displays a maximum of (1) discrete video streaming source

**Audio Formats:** AAC stereo  
**Bitrates:** Up to 25 Mbps (20 Mbps maximum recommended)

**Streaming Input Resolutions:** Up to 1920x1080@30fps maximum recommended

## Audio

**Features:** Built-in microphone and language voice recognition<sup>[1,2]</sup>  
**Audio Feedback Formats:** MP3

## Camera<sup>[1]</sup>

**Image Size:** 5.0 MP  
**Field of View:** 50° horizontal

## Connectors

**LAN PoE:** (1) 8-pin RJ45 with 2 LE 10Base-T/100Base-TX Ethernet ports  
Green and yellow LEDs indicate Ethernet activity  
**USB:** (1) USB 2.0 Type A (for future expansion)

## Power Requirements

**Power over Ethernet:** IEEE 802.3at Type 1 (802.3af compatible) Class 3 (12.95 W) PoE Powered Device

## Environmental

**Temperature:** 32° to 112° F (0° to 45° C)  
**Humidity:** 10% to 90% RH (non-condensing)  
**Heat Dissipation:** 44 BTU/hr

## Enclosure

**Construction:** Plastic, smooth black or white finish, edge-to-edge glass with black or white surround  
**Mounting:** Surface mount over a 2 or 3-gang electrical box, 2-gang European (DIN 19073) electrical box, 2-gang UK electrical box (minimum 35 mm mounting depth), or 2-3/8" H x 3-3/8" W (60mm H x 86mm W) cutout; Additional wall mount and tabletop options available separately

## Dimensions

**Height:** 4.80 in (122 mm)  
**Width:** 6.21 in (158 mm)  
**Depth:** 1.53 in (39 mm)  
**Weight:** 14.1 oz (400 g)

## MODELS & ACCESSORIES

### Available Models

TSW-760-B-S: 7" Touch Screen, Black Smooth  
TSW-760-W-S: 7" Touch Screen, White Smooth  
TSW-760-B-S-7: 7" Touch Screen, w/out Camera/Microphone, Black Smooth

-760 Mount Kit for TSW-560-TTK, Bracket for TSW-560/760/1060, Mounting Kit for TSW-UMB-60, Mounting Box for TSW-560/760/1060 -

PoE Switch, PoE Transmitter/Receiver

Available on TSW-760-B-S and TSW-760-W-S models  
TSW-760-W-S model only.  
Additional information, and certain other functions require an

- 3. Supports Smart Graphics only. Not compatible with "traditional" UI projects.
- 4. Item(s) sold separately.
- 5. H.264 compatible IP camera required.

REVIEWED  
REVISIONS MODIFIED  
REVIS AND RESUBMIT  
NOT REVIEWED

This review by JRP Engineering is for the sole purpose of ascertaining conformance with the general design concept. This review shall not mean the detail design inherent in the shop drawings are approved, responsibility of which shall remain with the Contractor submitting same and review shall not relieve the Contractor of this responsibility for errors or omissions in the shop drawings or his responsibility for meeting all requirements of the Contract Documents. The Contractor is responsible for dimensions to be confirmed and correlated at the job site for information that pertains solely to fabrication processes or to techniques of construction and installation and for co-ordination of the work of all sub-trades.

JRP Engineering  
C.McGuire

DATE: MAY 17th, 2017

- \* MODIFICATIONS:  
1. Provide more information on the GLA-PWS50 for contractors.
- 2. Contractor to coordinate installation on site with reference to slab conduits that are currently installed.
- 3. If changes are required to the network layout shown in this shop drawing, the changes are to be marked up on drawings updated for the final As-Built submission for this project.
- 4. Electrical to coordinate with system supplier to ensure a complete and operational system is achieved.
- 5. Coordinate changes to drawings with contractors comments provided to you on May 9th, 2017.

# TSW-760 7" Touch Screen

## CAD DRAWINGS

- REVIEWED
- REVIEWED AND MODIFIED
- REVISE AND RESUBMIT
- NOT REVIEWED

The review by JRP Engineering is for the sole purpose of ascertaining conformance with the general design concept. This review shall not mean the detail design inherent in the shop drawings are approved, responsibility of which shall remain with the Contractor submitting same and review shall not relieve the Contractor of this responsibility for errors or omissions in the shop drawings or his responsibility for meeting all requirements of the Contract Documents. The Contractor is responsible for dimensions to be confirmed and correlated at the job site, for information that pertains solely to fabrication processes or to techniques of construction and installation and for co-ordination of the work of all sub-trades.

JRP Engineering

C.McGuire

DATE MAY 17th, 2017

### \* MODIFICATIONS:


1. Provide more info on the GLA-PWS50 for contractors.
2. Contractor to coordinate installation on site with reference to slab conduits that are currently installed.
3. If changes are required to the network layout shown in this shop drawing, the changes are to be marked up or drawings updated for the final As-Built submission for this project.
4. Electrical to coordinate with system supplier to ensure a complete and operational system is achieved.
5. Coordinate changes to drawings with contractors comments provided to you on May 9th, 2017.

This product may be purchased from an authorized Crestron dealer. To find a dealer, please contact the Crestron sales representative for your area. A list of sales representatives is available online at [www.crestron.com/salesreps](http://www.crestron.com/salesreps) or by calling 800-237-2041.

The specific patents that cover Crestron products are listed online at: [patents.crestron.com](http://patents.crestron.com).

Certain Crestron products contain open source software. For specific information, please visit [www.crestron.com/opensource](http://www.crestron.com/opensource).

Crestron, the Crestron logo, DigitalMedia, Rava, Smart Graphics, and SmartObjects are either trademarks or registered trademarks of Crestron Electronics, Inc. in the United States and/or other countries. Sonos is either a trademark or a registered trademark of Sonos, Inc. in the United States and/or other countries. Other trademarks, registered trademarks, and trade names may be used in this document to refer to either the entities claiming the marks and names or their products. Crestron disclaims any proprietary interest in the marks and names of others. Crestron is not responsible for errors in typography or photography. Specifications are subject to change without notice. ©2016 Crestron Electronics, Inc.

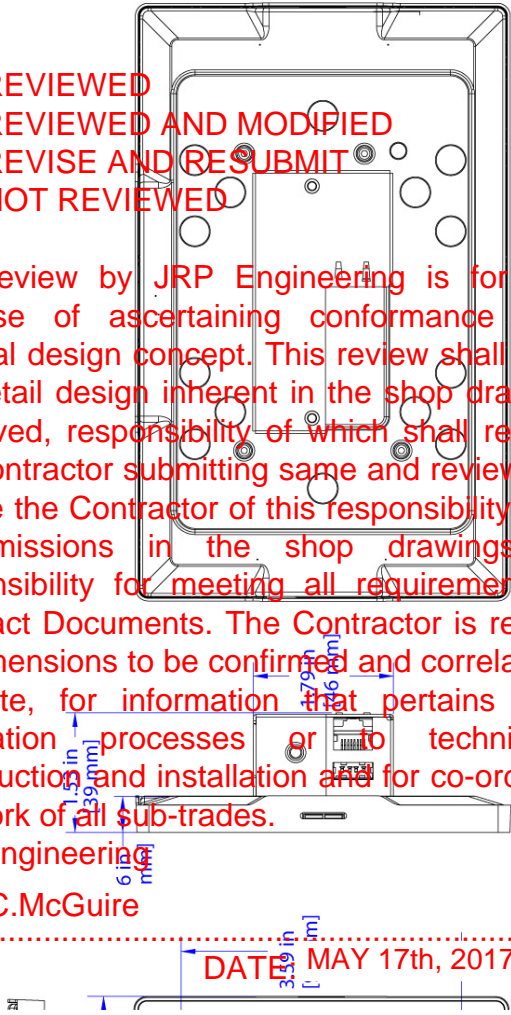

# GL-IPAC-SW8


## Crestron Green Light® Integrated Switching System

- > 8 internal circuits for switched loads
- > Expandable to 64 circuits of switched load
- > Supports 1 to 277 VAC applications
- > 16 Amp load rating per channel
- > Built-in astronomical time clock
- > Positive air gap at each output

REVIEWED  
 REVIEWED AND MODIFIED  
 REVISE AND RESUBMIT  
 NOT REVIEWED

- > Phase-independent channels
- > Local controls for setup, testing, and verification
- > Local and remote override capability
- > Non-volatile power failure memory
- > Easy access is facilitated from the hinged front cover
- > CEC Title 24 Energy Compliance

The review by JRP Engineering is for the sole purpose of ascertaining conformance with the general design concept. This review shall not mean the detail design inherent in the shop drawings are approved responsibility of which shall remain with the Contractor submitting same and review shall not

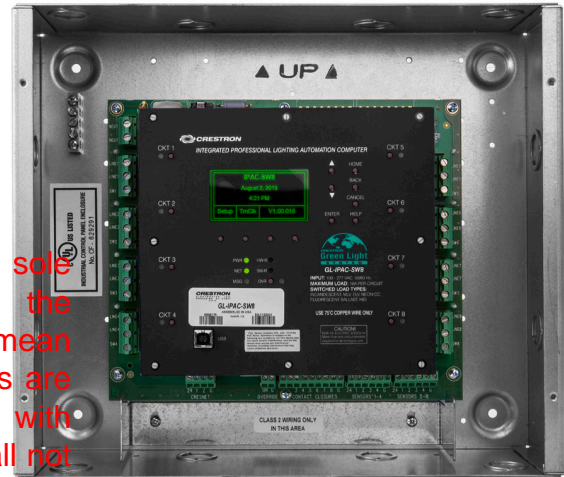

The GL-IPAC-SW8 switching panel provides internal controls for 8 circuits of switched load and is expandable to support up to 64 circuits of switched load by adding external panels and switching modules. It features local inputs for sensors and keypads, along with a LCD user interface where installers or users can set up the system without having to connect to a computer.

The GL-IPAC-SW8 is perfect for smaller-sized installations, such as retail stores, small office spaces, parking garages, and service stations, which typically require only on/off switching—eliminating the need for a larger, more expensive panel. In addition, the GL-IPAC-SW8 can be easily integrated with Crestron automation solutions, for centralized monitoring and remote control of multiple locations.

### Out-of-the-Box Lighti

The GL-IPAC-SW8 comes preconfigured for use as the controller processor for a Crestron Green Light® Power Switching System. Right out of the box, the GL-IPAC-SW8 affords complete and comprehensive functionality, complete switching and two remote key clock events.

Keypads with as much control lighting load turn on and off automatically. Lighting events at an offset from sunrise may also be implemented on room occupancy.

### Save Energy

Built-in support for balance between demand. Automatically turn off bulb brightness when sensors can be placed on energy manager.

### Easy Deployment

Packaged in one metal enclosure, the GL-IPAC-SW8 can be deployed in small spaces including plenum ceilings. The surface-mount GL-IPAC-SW8 can be affixed to a wall or ceiling rafter, cleanly out of sight. Standard wire-entry knockouts are provided.

relieve the Contractor of this responsibility for errors or omissions in the shop drawings or his responsibility for meeting all requirements of the Contract Documents. The Contractor is responsible for dimensions to be confirmed and correlated at the job site for smaller information that pertains solely to falsification processes and techniques of construction and installation and for co-ordination of the work of all sub-trades.

JRP Engineering  
C. McGuire

DATE: MAY 17th, 2017

### \* MODIFICATIONS:

1. Provide more information on the GLA-PWS50 for contractors.
2. Contractor to coordinate installation on site with reference to slab conduits that are currently installed.
3. If changes are required to the network layout shown in this shop drawing, the changes are to be marked up or drawings updated for the final As-Built submission for this project.
4. Electrical to coordinate with system supplier to ensure a complete and operational system is achieved.
5. Coordinate changes to drawings with contractors comments provided to you on May 9th, 2017.

### Load Rating

Switched Channels: 8 internal; expandable up to 64 by adding external panels and modules

Load Rating: 16 Amps @ 120 to 277 Volts AC, 50/60 Hz

Switched Load Types: Fluorescent Ballast, Incandescent, Magnetic Ballast, Low-Voltage, Neon/Cold Cathode, High-Intensity Discharge  
 or  
 Switching Rating: 100,000 on/off operations, 50A @ 277 VAC  
 50,000 on/off operations, 16A @ 120/277 VAC

### Dimensions

77 Volts AC, 50/60 Hz, via channel 1 (LINE 1, NEUT)  
 Power: 15 Watts at 24 Volts DC

### Terminal Blocks

Terminal Block 1)  
 16-pin terminal blocks, paralleled, line input neutral  
 16-pin terminal blocks; 2 connections per channel, for easy daisy-chaining; line power inputs  
 16-pin terminal blocks, switch channels outputs

### Terminal Block 2)

3.5mm terminal block; a maximum of 10 GLS-SIMs  
 a the Cresnet® terminal block for occupancy sensors  
 10 GLS-SIMs for photo sensors; up to 20 occupancy

# GL-IPAC-SW8 Crestron Green Light® Integrated Switching System

sensors may be supplied (10 external Cresnet sensors and 10 external, non-system sensors) connected to Cresnet via GLS-SIM. 20 photo sensors may be supplied (10 external, non-system sensors wired directly to a Cresnet occupancy sensor and 10 external, non-system sensors wired to a GLS-SIM using Cresnet).

**OVR:** (1) 2-pin 3.5mm terminal block, comprising (2) inputs for external contact closures to trigger the preset Override state

**CONTACT CLOSURES:** (1) 9-pin 3.5mm terminal block comprising (8) contact closure inputs and (1) GND port

**SENSOR INPUT 1-4:** (1) 6-pin 3.5mm terminal block comprising (4) sensor inputs for internal, non-system occupancy sensors, (1) +24VDC, and (1) GND port (provides sensors with power)

**SENSOR INPUT 5-8:** (1) 6-pin 3.5mm terminal block comprising (4) sensor inputs for internal, non-system photo sensors, (1) +24VDC, and (1) GND port (provides sensors with power)

**USB:** (1) USB Type B console port, for communication with Crestron Toolbox™

**LAN:** (1) 8-wire RJ45 with 2 LED Indicators, 10/100BaseT Ethernet port. Green LED indicates link status; Yellow LED indicates Ethernet activity

## LED Display

Green LCD dot matrix, 128x64 resolution, adjustable LED backlight

## Controls & Indicators

**SELECTION BUTTONS:** (2) push-button, adjust menu parameters

**ENTER:** (1) push-button, save and stores settings

**HOME:** (1) push-button, returns to the home page

**BACK:** (1) push-button, returns to the previous page

**CANCEL:** (1) push-button, cancels current action without saving

**HELP:** (1) push-button

**Soft Keys:** (4) push-button

**PWR:** (1) Green LED; NEUT and LINE1

**HW-R:** (1) Recessed indicator (the processor)

**SW-R:** (1) Recessed indicator (the program)

**OVR:** (1) Red LED and indicator (override mode)

**ON/OFF:** (8) Red LED: manual channel activation

## Environmental

**Temperature:** 32° to 104° F

**Humidity:** 10% to 90% RH

## Dimensions

**Height:** 12.13 in (308 mm)

**Width:** 14.13 in (359 mm)

**Depth:** 4.06 in (104 mm)

## Standards & Certifications

UL Listed Enclosure  
CEC Title 24 2013 Compliant

## MODELS & ACCESSORIES

### Available Models

GL-IPAC-SW8: Crestron Green Light® Integrated Switching System

### Available Accessories

- CNX-B2B Series: Designer Keypads
- C2N-CBD-E Series: Cameo® Express Keypads, Standard Mount
- C2N-CBD-P Series: Cameo® Keypads, Standard Mount
- C2N-CBF-P Series: Cameo® Keypads, Flush Mount
- C2N-DB Series: Decorator Keypads
- GLS-INT: Crestron Green Light® Sensor Integration Module
- GLS-EXT: Crestron Green Light® Photocell, Outdoor
- GLS-LOL: Crestron Green Light® Photocell, Open-Loop
- GLS-ODT-C-CN: Dual-Technology Occupancy Sensor with Cresnet®, 2000 Sq. Ft.
- GLS-ODT-W-CN: Passive Infrared Occupancy Sensor with Cresnet®
- GLS-ODT-C-500: Crestron Green Light® Dual-Technology Ceiling Mount Occupancy Sensor, 500 Sq. Ft.
- GLS-ODT-C-1000: Crestron Green Light® Dual-Technology Ceiling Mount Occupancy Sensor, 1000 Sq. Ft.
- GLS-ODT-W-1000: Crestron Green Light® Dual-Technology Ceiling Mount Occupancy Sensor, 2000 Sq. Ft.
- GLS-ODT-W-1000: Crestron Green Light® Dual-Technology Wall Mount Occupancy Sensor, 1000 Sq. Ft.
- GLS-ODT-W-1000: Crestron Green Light® Dual-Technology Wall Mount Occupancy Sensor, 2000 Sq. Ft.
- GLS-ODT-W-1000: Crestron Green Light® Dual-Technology Wall Mount Occupancy Sensor, 3000 Sq. Ft.
- GLS-ODT-W-1000: Crestron Green Light® Dual-Technology Wall Mount Occupancy Sensor, 100000 Sq. Ft.

The review by JRP Engineering is for the sole purpose of ascertaining conformance with the general design concept. This review shall not mean the detail design inherent in the shop drawings are approved, responsibility of which shall remain with the Contractor submitting same and review shall not relieve the Contractor of this responsibility for errors or omissions in the shop drawings or his responsibility for meeting all requirements of the contract documents. The Contractor is solely responsible for dimensions to be confirmed and correlated at the job site, for information that pertains solely to fabrication processes or to techniques of construction and installation and for co-ordination of the work of all sub-trades.

JRP Engineering  
C.McGuire

DATE: MAY 17th, 2017

### \* MODIFICATIONS:

1. Provide more information on the GLA-PWS50 for contractors.
  2. Contractor to coordinate installation on site with reference to slab conduits that are currently installed.
  3. If changes are required to the network layout shown in this shop drawing, the changes are to be marked up or drawings updated for the final As-Built submission for this project.
  4. Electrical to coordinate with system supplier to ensure a complete and operational system is achieved.
  5. Coordinate changes to drawings with contractors
- comments provided to you on May 9th, 2017.

Obtain an authorized Crestron dealer. To find a dealer, please contact your sales representative for your area. A list of sales representatives is available on the Crestron website or by calling 800-237-2041.

Crestron products are listed online at: [patents.crestron.com](http://patents.crestron.com).

Crestron, Crestron Green Light, Crestron Toolbox, and Crestron trademarks or registered trademarks of Crestron Electronics, Inc. in the United States and other countries. Other trademarks, registered trademarks, and trade names may refer to either the entities claiming the marks and names or to other entities. Crestron Electronics, Inc. claims no proprietary interest in the marks and names of others. Specifications are subject to change without notice. ©2014 Crestron Electronics, Inc.

## REVIEWED Sensor Integration Module

REVIEWED AND MODIFIED

REWISE AND RESUBMIT

NOT REVIEWED

The GLS-SIM is a compact interface device designed to allow Crestron Green Light® sensors to be connected directly to a Cresnet control network. Cresnet® is the communications backbone for Crestron sensors, dimmers, keypads, touchpanels, shade controllers, thermostats, and

many other devices. This flexible wiring provides data communications and 24 Volts DC power for all of the devices on the Cresnet network. The GLS-SIM installs easily at the sensor location, mounting conveniently inside the electrical box or exposed above the ceiling. Wiring connections to the network and sensor are facilitated using miniature screw terminals.

The GLS-SIM is compatible with Crestron GLS-series sensors which with most 24 Volt-powered sensors from any manufacturer. Up to 1A @ 24VDC power is available<sup>[1]</sup> to support multiple sensors in parallel.

The GLS-SIM actually includes two sensing inputs, each capable of sensing a contact closure, logic level or 0-10V analog signal. When used with a Crestron IPAC or iLux® system, setup is simplified using onboard DIP switches to select the sensor type (i.e. occupancy, photocell position set, and operation) and normally open or normally-closed).

**JRP Engineering** shall not relieve the Contractor of this responsibility for errors or omissions in the shop drawings or his responsibility for meeting all requirements of the Contract Documents. The Contractor is responsible for dimensions to be confirmed and controlled at the job site, for information that pertains solely to fabrication processes or to techniques of construction and installation and for co-ordination of the work of all sub-trades.

Provides Crestron compatibility for Crestron GLS-series and third-party sensors  
**JRP Engineering**

> Wrote by **C. McGuire** occupancy sensors, photocells, partition

> Provides 24 Volts DC (1A max)  
 > Includes 2 independent sensing inputs

### \* MODIFICATIONS:

- > 1. Provide more information on the GLA-PWS50 for contractors.
  - > 2. Contractor to coordinate installation on site with reference to slab conduits that are currently installed.
  - > 3. If changes are required to the network layout shown in this shop drawing, the changes are to be marked up on drawings updated for the final As-Built submission for this project.
  - > 4. Electrical to coordinate with system supplier to ensure a complete and operational system is achieved.
  - > 5. Coordinate changes to drawings with contractors
- comments provided to you on May 9th, 2017.

ANALOG INPUT: Rated for 0-10 volts DC, protected to 24 volts DC maximum, input impedance 20k ohms;  
 Programmable 5 Volts, 2k ohms pull-up resistor per pin;  
 Maximum Power Load: 1 Amp @ 24 Volts DC<sup>[1]</sup>

### Controls



### LED Indicators

- PWR:** (1) green LED, indicates 24 Volts DC power supplied from Cresnet control network  
**NET:** (1) yellow LED, indicates communication with Cresnet system  
**SETUP:** (1) red LED, used for touch-settable ID (TSID)

### Environmental

**Temperature :** 32° to 104°F (0° to 40°C)  
**Humidity :** 0% to 95% RH (non-condensing)

### Power Requirements

**Cresnet Power Usage:** 1 Watt (0.04 Amps @ 24 VDC) (Does not include power draw of attached devices.)

### Dimensions

**Height:** 2.00 in (51 mm)  
**Width:** 2.00 in (51 mm)  
**Depth:** 0.86 in (22 mm)

### Weight

2 oz (46 g)

### Available Models

**GLS-SIM [6502480]:** Crestron Green Light® Sensor Integration Module

### Available Accessories

- GLS-LCL [6502415]:** Crestron Green Light® Photosensor, Closed-Loop
- GLS-LOL [6502416]:** Crestron Green Light® Photosensor, Open-Loop
- GLS-ODT-C-500:** Crestron Green Light® Dual-Technology Ceiling Mount Occupancy Sensor, 500 Sq. Ft [Discontinued]
- GLS-ODT-C-1000:** Crestron Green Light® Dual-Technology Ceiling Mount Occupancy Sensor, 1000 Sq. Ft. [Discontinued]

# GLS-SIM Sensor Integration Module



REVIEWED



REVIEWED AND MODIFIED



REVISE AND RESUBMIT



NOT REVIEWED

**GLS-ODT-C-2000:** Crestron Green Light® Dual-Technology Ceiling Mount Occupancy Sensor, 2000 Sq. Ft. [Discontinued]  
**GLS-ODT-W-1200 [6502420]:** Crestron Green Light® Dual-Technology wall Mount Occupancy Sensor, 1200 Sq. Ft.  
**GLS-OIR-C-450:** Crestron Green Light® Passive Infrared Ceiling Mount Occupancy Sensor, 450 Sq. Ft. [Discontinued]  
**GLS-OIR-C-1500:** Crestron Green Light® Passive Infrared Ceiling Mount Occupancy Sensor, 1500 Sq. Ft. [Discontinued]  
**GLS-OIR-W-2500 [6502423]:** Crestron Green Light® Passive Infrared Wall Mount Occupancy Sensor, 2500 Sq. Ft.  
**CRESNET-HP-NP-TL-SP1000 [6500492]:** Cresnet® "High-Power" Control Cable, non-plenum, teal, 1000 ft spool  
**CRESNET-HP-NP-TL-SP500 [6500489]:** Cresnet® "High-Power" Control Cable, non-plenum, teal, 500 ft spool  
**CRESNET-NP-BK-B500 [6500494]:** Cresnet® Control Cable, Non-Plenum, Black, 500 ft (152 m) box  
**CRESNET-NP-OR-B500 [6500495]:** Cresnet® Control Cable, Non-Plenum, Orange, 500 ft (152 m) box  
**CRESNET-NP-TL-B250 [6500410]:** Cresnet® Control Cable, Non-Plenum, Teal, 250 ft (76 m) box  
**CRESNET-NP-TL-B500 [6500719]:** Cresnet® Control Cable, Non-Plenum, Teal, 500 ft (152 m) box  
**CRESNET-NP-TL-SP1000 [6500794]:** Cresnet® Control Cable, Non-Plenum, Teal, 1000 ft (304 m) spool  
**CRESNET-NP-TL-SP500 [6500183]:** Cresnet® Control Cable, Non-Plenum, Teal, 500 ft (152 m) spool  
**CRESNET-NP-YL-B500:** Cresnet® Control Cable, non-plenum, yellow, 500 ft box [Discontinued]  
**CRESNET-P-BK-SP500 [6500184]:** Cresnet® Control Cable, Plenum-Rated, Black, 500 ft (152 m) spool  
**CRESNET-P-OR-SP500 [6500185]:** Cresnet® Control Cable, Plenum-Rated, Orange, 500 ft (152 m) spool  
**CRESNET-P-TL-SP1000 [6500941]:** Cresnet® Control Cable, Plenum-Rated, Teal, 1000 ft (304 m) spool  
**CRESNET-P-TL-SP500 [6500098]:** Cresnet® Control Cable, Plenum-Rated, Teal, 500 ft (152 m) spool  
**CRESNET-P-YL-SP500:** Cresnet® Control Cable, plenum, yellow, 500 ft spool [Discontinued]

## Notes:

1. Actual load capability dependent upon the amount of available Cresnet power in the system. This product may be purchased from an authorized Crestron dealer. To find a dealer, please contact the Crestron sales representative for your area. A list of sales representatives is available online at [www.crestron.com/salesreps](http://www.crestron.com/salesreps) or by calling 800-237-2041. Specifications subject to change without notice. Crestron is not responsible for errors in typography or photography.

The specific patents that cover Crestron products are listed online at: [patents.crestron.com](http://patents.crestron.com).

Crestron, Crestron Green Light, the Crestron logo, and iLux are either trademarks or registered trademarks of Crestron Electronics, Inc. in the United States and/or other countries. Other trademarks and trade names may be used in this document to refer to either the entities claiming the marks and names or their products. Crestron disclaims any proprietary interest in the marks and names of others.  
©2012 Crestron Electronics, Inc.

The review by JRP Engineering is for the sole purpose of ascertaining conformance with the general design concept. This review shall not mean the detail design inherent in the shop drawings are approved, responsibility of which shall remain with the Contractor submitting same and review shall not relieve the Contractor of this responsibility for errors or omissions in the shop drawings or his responsibility for meeting all requirements of the Contract Documents. The Contractor is responsible for dimensions to be confirmed and correlated at the job site, for information that pertains solely to fabrication processes or to techniques of construction and installation and for co-ordination of the work of all sub-trades.

JRP Engineering  
C.McGuire


DATE: MAY 17th, 2017

## \* MODIFICATIONS:

1. Provide more information on the GLA-PWS50 for contractors.
2. Contractor to coordinate installation on site with reference to slab conduits that are currently installed.
3. If changes are required to the network layout shown in this shop drawing, the changes are to be marked up or drawings updated for the final As-Built submission for this project.
4. Electrical to coordinate with system supplier to ensure a complete and operational system is achieved.
5. Coordinate changes to drawings with contractors comments provided to you on May 9th, 2017.

# GLS-SIMSensor Integration Module

- REVIEWED
- REVIEWED AND MODIFIED
- REVISE AND RESUBMIT
- NOT REVIEWED

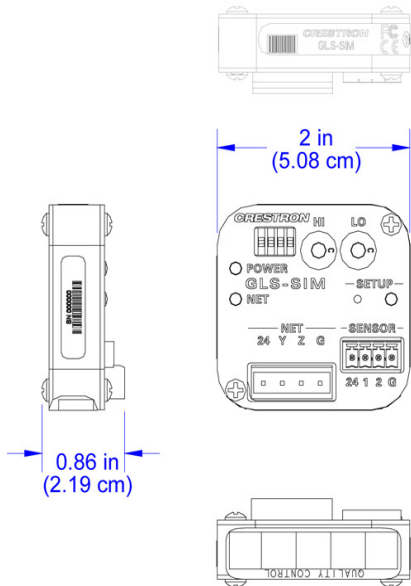


The review by JRP Engineering is for the sole purpose of ascertaining conformance with the general design concept. This review shall not mean the detail design inherent in the shop drawings are approved, responsibility of which shall remain with the Contractor submitting same and review shall not relieve the Contractor of this responsibility for errors or omissions in the shop drawings or his responsibility for meeting all requirements of the Contract Documents. The Contractor is responsible for dimensions to be confirmed and correlated at the job site for information that pertains solely to fabrication processes or to techniques of construction and installation and for co-ordination of the work of all sub-trades.


JRP Engineering  
C. McGuire

DATE: MAY 17th, 2017

**\* MODIFICATIONS:**

1. Provide more information on the GLA-PWS50 for contractors.
2. Contractor to coordinate installation on site with reference to slab conduits that are currently installed.
3. If changes are required to the network layout shown in this shop drawing, the changes are to be marked up or drawings updated for the final As-Built submission for this project.
4. Electrical to coordinate with system supplier to ensure a complete and operational system is achieved.
5. Coordinate changes to drawings with contractors comments provided to you on May 9th, 2017.

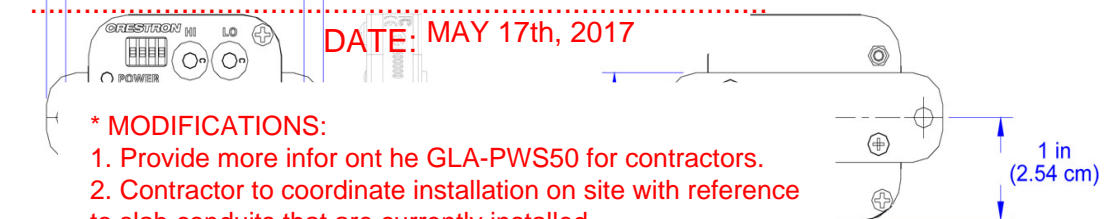

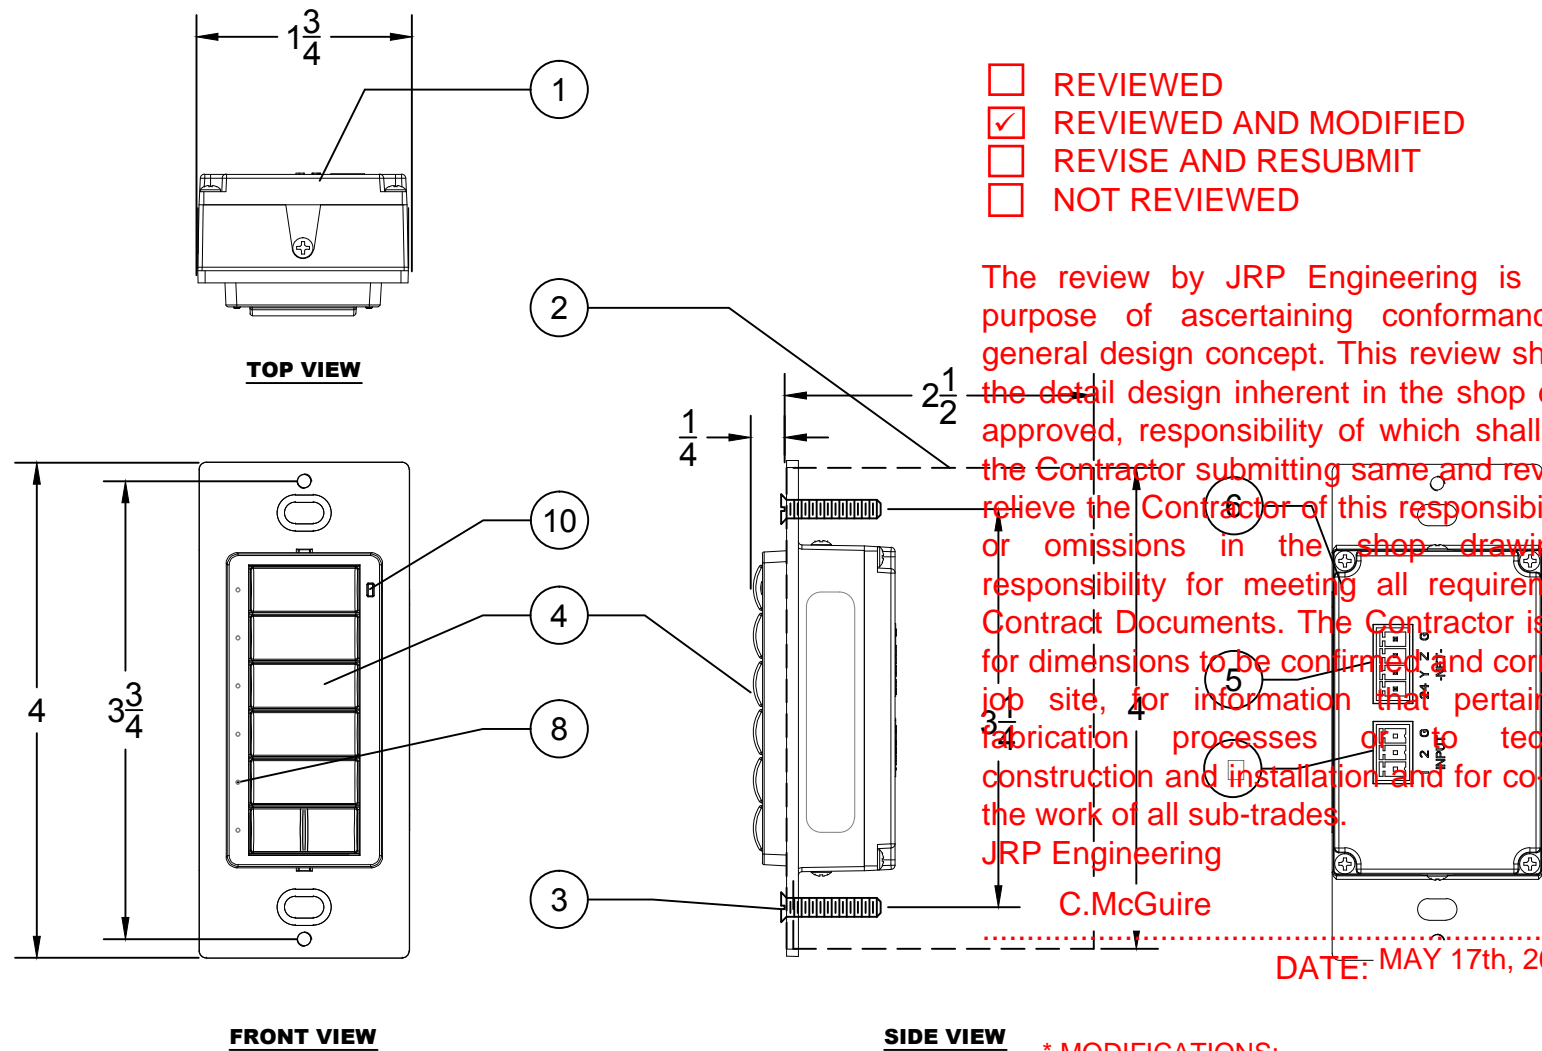

- REVIEWED
- REVIEWED AND MODIFIED
- REVISE AND RESUBMIT
- NOT REVIEWED

The review by JRP Engineering is for the sole purpose of ascertaining conformance with the general design concept. This review shall not mean the detail design inherent in the shop drawings are approved, responsibility of which shall remain with the Contractor submitting same and review shall not relieve the Contractor of this responsibility for errors or omissions in the shop drawings or his responsibility for meeting all requirements of the Contract Documents. The Contractor is responsible for dimensions to be confirmed and correlated at the job site, for information that pertains solely to fabrication processes or to techniques of construction and installation and for co-ordination of the work of all sub-trades.

JRP Engineering

C.McGuire

DATE: MAY 17th, 2017

**\* MODIFICATIONS:**

1. Provide more info on the GLA-PWS50 for contractors.
2. Contractor to coordinate installation on site with reference to slab conduits that are currently installed.
3. If changes are required to the network layout shown in this shop drawing, the changes are to be marked up or drawings updated for the final As-Built submission for this project.
4. Electrical to coordinate with system supplier to ensure a complete and operational system is achieved.
5. Coordinate changes to drawings with contractors comments provided to you on May 9th, 2017.

**IMPORTANT:**

SEE INSTALLATION AND OPERATION MANUAL FOR KEYPAD ASSEMBLY INSTRUCTIONS AND BUTTON CONFIGURATION INSTRUCTIONS.

**IMPORTANT:**

KEYPADS WILL SHIP FROM THE FACTORY WITH NO BUTTONS INSTALLED. ALL KEYPADS SHIP WITH A COMPLETE SET OF BUTTONS TO FORM ANY OF THE LAYOUTS SHOWN ON THE "MODIFIED" DETAIL PAGE. ANY INFORMATION PROVIDED FOR ENGRAVING OR PROGRAMMING INFORMATION WILL NOT BE IMPLEMENTED UNTIL AFTER SYSTEM COMMISSIONING IS COMPLETE, AT WHICH TIME REPLACEMENT BUTTONS WITH THE SPECIFIED ENGRAVING WILL BE PROVIDED.

**NOTES KEY**

- ① #C2N-CBD-P CAMEO SERIES CONTROL STATION WITH LED INDICATORS.
- ② SINGLE GANG ELECTRICAL BOX WITH NECESSARY ACCESSORIES, 2.5" DEEP MINIMUM (NOT BY CRESTRON).
- ③ 0.1 IN PAN HEAD SCREW (TYP OF (2) PER STATION). PROVIDED WITH CONTROL STATION BY CRESTRON.
- ④ CUSTOM ENGRAVEABLE AND CONFIGURABLE KEYPAD BUTTONS. SEE MANUAL FOR ASSEMBLY INSTRUCTIONS.
- ⑤ CRESNET CONNECTION PORT FOR CONTROL VIA 2-SERIES CONTROL SYSTEM.
- ⑥ GROUNDING WIRE FOR KEYPAD TO ELECTRICAL ENCLOSURE.
- ⑦ NOT SHOWN: TO BE USED WITH ANY DECORA STYLE FACEPLATE. FURNISHED BY OTHERS.
- ⑧ LED INDICATORS - INDICATE SELECTED SCENE
- ⑨ 3-PIN 3.5MM DETACHABLE TERMINAL BLOCK. COMPRISES OF (2) VERSIPORT INPUTS.
- ⑩ PHOTSENSOR FOR CONTROL OF AUTO-DIMMING FUNCTION. CAN BE CONFIGURED TO REPORT AMBIENT LIGHT LEVEL TO CONTROL SYSTEM.

**NOTE:**


KEYPAD IS COMPATIBLE WITH STANDARD DECORA-STYLE FACEPLATE, **NOT** PROVIDED BY CRESTRON.

**WIRING NOTES:**

**CAUTION: POSSIBLE EQUIPMENT DAMAGE IF MISWIRED**

1. DO NOT POWER UP SYSTEM UNTIL ALL WIRING IS VERIFIED. CARE SHOULD BE TAKEN TO ENSURE DATA (Y, □) AND POWER (24,G) CONNECTIONS ARE NOT CROSSED.
2. GROUND SHIELD AT CONTROL SYSTEM END **ONLY**.
3. STRIP ONLY THE MINIMUM AMOUNT OF JACKETING FROM THE WIRES, AND INSULATE EXPOSED CONDUCTORS/ DRAIN WIRES WITH HEAT SHRINK TUBING.
4. GENUINE CRESNET CONTROL CABLE IS RECOMMENDED FOR CONNECTION OF CRESTRON COMMERCIAL LIGHTING SYSTEMS.
5. WHEN DAISY CHAINING NETWORK UNITS, ALWAYS TWIST THE ENDS OF THE INCOMING WIRE AND THE OUTGOING WIRE THAT SHARE A PIN ON THE NETWORK CONNECTOR. IF NECESSARY USE A PIGTAIL WHEN LANDING MORE THAN TWO CONDUCTORS ON A SMALL CONNECTOR.

**CRESNET CONTROL WIRING**

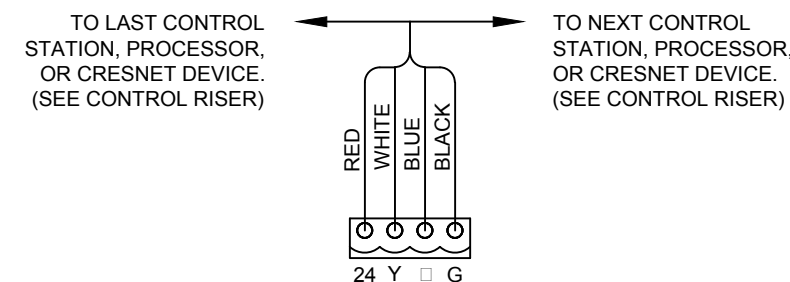

PART #: C2N-CBD-P

DESCRIPTION: C2N-CBD-P KEYPAD

DATE: 7/22/2013

REVISION: 006

NOTES:



15 Volvo Drive  
Rockleigh NJ 07647  
Tel: 888-273-7876  
Fax: 201-767-6011  
www.crestron.com

DEVICE:  
C2N-CBD-P CAMEO  
KEYPAD  
PHYSICAL DETAILS

DRAWING:  
1 OF 5

**C2N-CBD-P KEYPAD**

- REVIEWED
- REVIEWED AND MODIFIED
- REVISE AND RESUBMIT
- NOT REVIEWED



The review by JRP Engineering is for the sole purpose of ascertaining conformance with the general design concept. This review shall not mean the detail design inherent in the shop drawings are approved, responsibility of which shall remain with the Contractor submitting same and review shall not relieve the Contractor of this responsibility for errors or omissions in the shop drawings or his responsibility for meeting all requirements of the Contract Documents. The Contractor is responsible for dimensions to be confirmed and correlated at the job site, for information that pertains solely to fabrication processes or to techniques of construction and installation and for co-ordination of the work of all sub-trades.

JRP Engineering  
C.McGuire

DATE: MAY 17th, 2017

**\* MODIFICATIONS:**

1. Provide more info on the GLA-PWS50 for contractors.
2. Contractor to coordinate installation on site with reference to slab conduits that are currently installed.
3. If changes are required to the network layout shown in this shop drawing, the changes are to be marked up or drawings updated for the final As-Built submission for this project.
4. Electrical to coordinate with system supplier to ensure a complete and operational system is achieved.
5. Coordinate changes to drawings with contractors comments provided to you on May 9th, 2017.

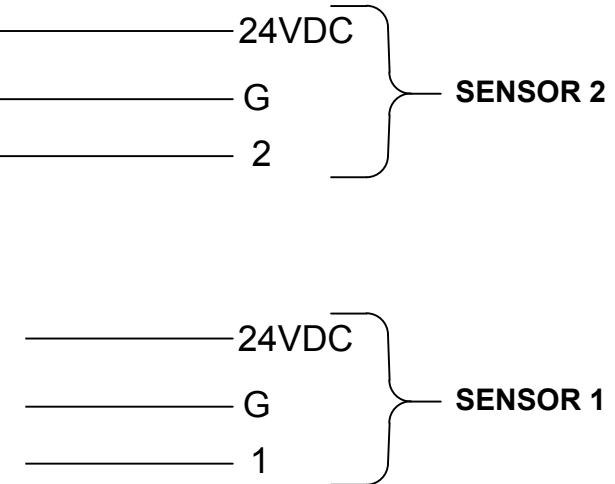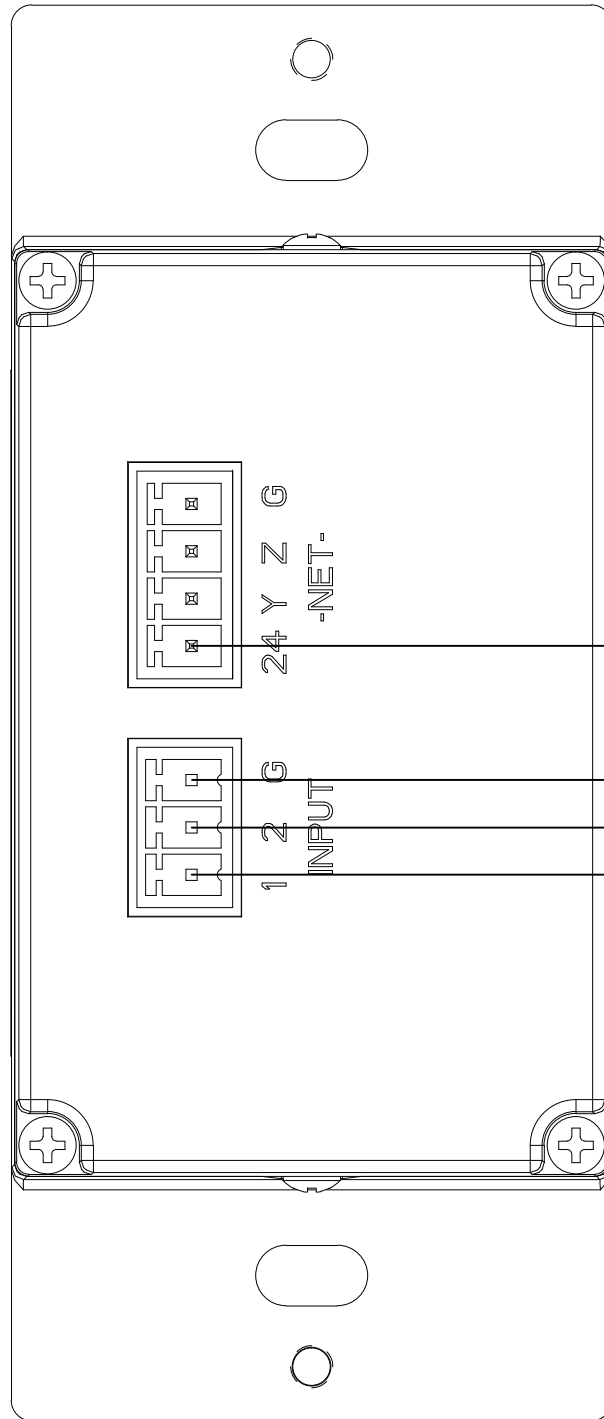

## WIRING FOR OPTIONAL VERSIPOINT SENSOR INPUTS

WHERE CONVENIENT AND APPROPRIATE, VERSIPOINT INPUTS MAY BE USED TO CONNECT OCCUPANCY SENSORS OR PHOTOCELLS TO CRESNET NETWORK RATHER THAN USING GLS-SIM INTERFACE MODULE.



PART #: C2N-CBD-P

DESCRIPTION: C2N-CBD-P VERSIPOINT WIRING

REVISION: 003

DATE: 3/6/12

NOTES:



15 Volvo Drive  
Rockleigh NJ 07647  
Tel: 888-273-7876  
Fax: 201-767-6011  
www.crestron.com

DEVICE:  
C2N-CBD-P CAMEO  
KEYPAD  
VERSIPOINT WIRING

DRAWING:  
2 OF 5



# C2N-CBD-P KEYPAD ENGRAVING SHEET MODIFIED KEYPAD LAYOUTS



PART #: C2N-CBD-P  
DESCRIPTION: C2N-CBD-P MODIFIED LAYOUT & ENGRAVING

REVISION: 008  
DATE: 1/5/2015

NOTES: UPDATE AVAILABLE STYLES- OTHER STYLES NOT RENUMBERED



15 Volvo Drive  
Rockleigh NJ 07647  
Tel: 888-273-7876  
Fax: 201-767-6011  
www.crestron.com

DEVICE:  
C2N-CBD-P CAMEO  
KEYPAD  
"MODIFIED" LAYOUT

DRAWING:  
4 OF 5

- REVIEWED
- REVIEWED AND MODIFIED
- REVISE AND RESUBMIT
- NOT REVIEWED

The review by JRP Engineering is for the sole purpose of ascertaining conformance with the general design concept. This review shall not mean the detail design inherent in the shop drawings are approved, responsibility of which shall remain with the Contractor submitting same and review shall not relieve the Contractor of this responsibility for errors or omissions in the shop drawings or his responsibility for meeting all requirements of the Contract Documents. The Contractor is responsible for dimensions to be confirmed and correlated at the job site, for information that pertains solely to fabrication processes or to techniques of construction and installation and for co-ordination of the work of all sub-trades.  
JRP Engineering

C.McGuire

DATE: MAY 17th, 2017


- \* MODIFICATIONS:**
1. Provide more info on the GLA-PWS50 for contractors.
  2. Contractor to coordinate installation on site with reference to slab conduits that are currently installed.
  3. If changes are required to the network layout shown in this shop drawing, the changes are to be marked up or drawings updated for the final As-Built submission for this project.
  4. Electrical to coordinate with system supplier to ensure a complete and operational system is achieved.
  5. Coordinate changes to drawings with contractors comments provided to you on May 9th, 2017.

**PLEASE USE THESE STYLES AS A GUIDE TO FILL OUT THE MODIFIED KEYPAD LAYOUT & ENGRAVING FORMS ON THE NEXT PAGE**

NOTE THAT SEVERAL STYLES HAVE BEEN REMOVED FROM THIS SHEET, BUT STYLE NUMBERS ARE UNCHAINED TO MAINTAIN COMPATIBILITY WITH OLDER SHEETS.

- REVIEWED
- REVIEWED AND MODIFIED
- REVISE AND RESUBMIT
- NOT REVIEWED

## C2N-CBD-P KEYPAD ENGRAVING & CONTROL DETAIL SHEET. MODIFIED KEYPAD LAYOUTS



KEYPAD STYLE: \_\_\_\_\_  
 STATION ID: \_\_\_\_\_  
 LOCATION: \_\_\_\_\_  
 COLOR: \_\_\_\_\_  
 TEXTURE OR SMOOTH (CIRCLE ONE)  
 SEE PREVIOUS SHEET FOR STYLE NUMBERS

BUTTONS ARE CLASSED AS HALF, SINGLE, DOUBLE, OR TRIPLE SPACE. DOUBLE AND TRIPLE SPACE BUTTONS CAN HAVE 2 LINES OF TEXT AND EACH LINE CAN HAVE A MAXIMUM OF 7 CHARACTERS. (SEPARATE LINES WITH /)

STANDARD RAISE ▲ AND LOWER ▼ BUTTONS ARE SHIPPED WITH EACH KEYPAD FOR USE IN THE SPLIT BUTTONS (HALF-WIDTH BUTTONS AT THE BOTTOM). IF YOU WISH ENGRAVING ON THESE BUTTONS ONLY 3-4 CHARACTERS, DEPENDING ON CHARACTER WIDTH, WILL FIT ON THESE BUTTONS.

ENGRAVING SCHEDULE	
BUTTON ID	ENGRAVING
1	
2	
3	
4	
5	
6	
7	
8	

CONTROL	
ZONES TO BE CONTROLLED	

KEYPAD STYLE: \_\_\_\_\_  
 STATION ID: \_\_\_\_\_  
 LOCATION: \_\_\_\_\_  
 COLOR: \_\_\_\_\_  
 TEXTURE OR SMOOTH (CIRCLE ONE)  
 SEE PREVIOUS SHEET FOR STYLE NUMBERS

BUTTONS ARE CLASSED AS HALF, SINGLE, DOUBLE, OR TRIPLE SPACE. DOUBLE AND TRIPLE SPACE BUTTONS CAN HAVE 2 LINES OF TEXT AND EACH LINE CAN HAVE A MAXIMUM OF 7 CHARACTERS. (SEPARATE LINES WITH /)

STANDARD RAISE ▲ AND LOWER ▼ BUTTONS ARE SHIPPED WITH EACH KEYPAD FOR USE IN THE SPLIT BUTTONS (HALF-WIDTH BUTTONS AT THE BOTTOM). IF YOU WISH ENGRAVING ON THESE BUTTONS ONLY 3-4 CHARACTERS, DEPENDING ON CHARACTER WIDTH, WILL FIT ON THESE BUTTONS.

ENGRAVING SCHEDULE	
BUTTON ID	ENGRAVING
1	
2	
3	
4	
5	
6	
7	
8	

CONTROL	
ZONES TO BE CONTROLLED	

**PLEASE NOTE:**  
 THIS SHEET AND THE SHEETS FOR "STANDARD" LAYOUTS THAT PRECEDE IT DO NOT NEED TO BE RETURNED COMPLETED WITH THE SUBMITTAL PACKAGE FOR THIS PROJECT. THESE SHEETS MUST BE RETURNED NOT LATER THAN YOUR REQUEST FOR SYSTEM COMMISSIONING.

KEYPADS SHIP WITH NO BUTTONS INSTALLED. SEE NOTE ON C2N-CBD-P SHEET 1 OF 5 FOR DETAILS.

### INSTRUCTIONS

IF YOU WISH TO USE ANY MODIFIED LAYOUTS FOR YOUR PROJECT, PLEASE FOLLOW THE INSTRUCTIONS BELOW. IF YOU WISH STANDARD LAYOUTS ONLY, PLEASE GO TO THE PRIOR SHEET "STANDARD KEYPAD LAYOUTS"

- MAKE AS MANY COPIES AS YOU NEED OF THIS SHEET TO BE ABLE TO CREATE AS MANY DIFFERENT STATION ENGRAVINGS AS YOU REQUIRE. NOTE THAT IF YOU HAVE SEVERAL STATIONS THAT ARE THE SAME, YOU MAY LIST MULTIPLE STATION ID NUMBERS IN THE APPROPRIATE SPACE, YOU DON'T NEED A SEPARATE SHEET FOR EACH STATION.
- ENTER THE STYLE NUMBER (SEE PREVIOUS SHEET FOR STYLES) THAT YOU WOULD LIKE FOR A STATION OR TYPE OF STATION.
- LOOK AT THE SINGLE-LINE RISER DIAGRAMS EARLIER IN THIS SUBMITTAL PACKAGE. EACH KEYPAD WILL HAVE A "STATION ID". NOTE THAT STATION ID IN THE APPROPRIATE SPACE, AS WELL AS THE DEVICE LOCATION. IF THE DEVICE LOCATION ISNT SPECIFIED, PLEASE TRY TO UPDATE IT.
- ON THIS SUBMITTAL'S BILL OF MATERIALS PAGE YOU WILL SEE A LISTING OF ALL KEYPADS, AS WELL AS THEIR COLOR AND FINISH.
- IF THE KEYPADS HAVE NOT YET BEEN SHIPPED, YOU MAY CHANGE TO COLOR/FINISH FOR NO ADDITIONAL FEE. NOTE THE COLOR YOU WOULD LIKE THE KEYPAD TO BE ON THE "COLOR" LINE, WITH EITHER "SMOOTH" (GLOSS) OR "TEXTURED" (MATTE) ON THE LINE BELOW COLOR.
- BE AWARE THAT IF THE KEYPADS HAVE SHIPPED AND THE COLOR NEEDS TO CHANGE, RESTOCKING FEES WILL BE APPLIED.
- IN THE ENGRAVING TABLE, ENTER THE TEXT YOU WOULD LIKE TO HAVE ENGRAVED ON THE BUTTONS.
- ONCE YOU ARE FINISHED WITH ALL ENGRAVING DETAILS, PLEASE SEND THE SHEET(S) TO LIGHTINGCOMMISSIONING@CRESTRON.COM
- PLEASE ENTER PROGRAMMING INFORMATION FOR EACH STATION. ZONES TO BE CONTROLLED BY EACH BUTTON. CONTROLS LIKE "PROJECTION SCREEN UP" OR OTHER NON-ONE RELATED ACTIONS MAY ALSO BE NOTED.

#### AVAILABLE COLORS & FINISHES

- |             |                    |
|-------------|--------------------|
| WHITE       | SMOOTH OR TEXTURED |
| BLACK       | SMOOTH OR TEXTURED |
| ALMOND      | SMOOTH OR TEXTURED |
| GRAY        | SMOOTH             |
| IVORY       | SMOOTH             |
| DARK ALMOND | SMOOTH             |
| BROWN       | SMOOTH             |
| LATTE       | TEXTURED           |
| DUSK        | TEXTURED           |

PLEASE GO TO WWW.CRESTRON.COM FOR PHOTOS OF THESE COLORS, OR CONTACT YOUR CRESTRON PROJECT COORDINATOR FOR SAMPLES

The review by JRP Engineering is for the sole purpose of ascertaining conformance with the general design concept. This review shall not mean the detail design inherent in the shop drawings are approved, responsibility of which shall remain with the Contractor submitting same and review shall not relieve the Contractor of this responsibility for errors or omissions in the shop drawings or his responsibility for meeting all requirements of the Contract Documents. The Contractor is responsible for dimensions to be confirmed and correlated at the job site, for information that pertains solely to fabrication processes or to techniques of construction and installation and for co-ordination of the work of all sub-trades.

JRP Engineering  
C.McGuire

DATE: MAY 17th, 2017

**\* MODIFICATIONS:**

- Provide more infor ont he GLA-PWS50 for contractors.
- Contractor to coordinate installation on site with reference to slab conduits that are currently installed.
- If changes are required to the network layout shown in this shop drawing, the changes are to be marked up or drawings updated for the final As-Built submission for this project.
- Electrical to coordinate with system supplier to ensure a complete and operational system is achieved.
- Coordinate changes to drawings with contractors comments provided to you on May 9th, 2017.

KEYPAD STYLE: \_\_\_\_\_  
 STATION ID: \_\_\_\_\_  
 LOCATION: \_\_\_\_\_  
 COLOR: \_\_\_\_\_  
 TEXTURE OR SMOOTH (CIRCLE ONE)  
 SEE PREVIOUS SHEET FOR STYLE NUMBERS

BUTTONS ARE CLASSED AS HALF, SINGLE, DOUBLE, OR TRIPLE SPACE. DOUBLE AND TRIPLE SPACE BUTTONS CAN HAVE 2 LINES OF TEXT AND EACH LINE CAN HAVE A MAXIMUM OF 7 CHARACTERS. (SEPARATE LINES WITH /)

STANDARD RAISE ▲ AND LOWER ▼ BUTTONS ARE SHIPPED WITH EACH KEYPAD FOR USE IN THE SPLIT BUTTONS (HALF-WIDTH BUTTONS AT THE BOTTOM). IF YOU WISH ENGRAVING ON THESE BUTTONS ONLY 3-4 CHARACTERS, DEPENDING ON CHARACTER WIDTH, WILL FIT ON THESE BUTTONS.

7	
8	

KEYPAD STYLE: \_\_\_\_\_  
 STATION ID: \_\_\_\_\_  
 LOCATION: \_\_\_\_\_  
 COLOR: \_\_\_\_\_  
 TEXTURE OR SMOOTH (CIRCLE ONE)  
 SEE PREVIOUS SHEET FOR STYLE NUMBERS

BUTTONS ARE CLASSED AS HALF, SINGLE, DOUBLE, OR TRIPLE SPACE. DOUBLE AND TRIPLE SPACE BUTTONS CAN HAVE 2 LINES OF TEXT AND EACH LINE CAN HAVE A MAXIMUM OF 7 CHARACTERS. (SEPARATE LINES WITH /)

STANDARD RAISE ▲ AND LOWER ▼ BUTTONS ARE SHIPPED WITH EACH KEYPAD FOR USE IN THE SPLIT BUTTONS (HALF-WIDTH BUTTONS AT THE BOTTOM). IF YOU WISH ENGRAVING ON THESE BUTTONS ONLY 3-4 CHARACTERS, DEPENDING ON CHARACTER WIDTH, WILL FIT ON THESE BUTTONS.

ENGRAVING SCHEDULE	
BUTTON ID	ENGRAVING
1	
2	
3	
4	
5	
6	
7	
8	

CONTROL	
ZONES TO BE CONTROLLED	

PART #: C2N-CBD-P

DESCRIPTION: C2N-CBD-P MODIFIED LAYOUT & ENGRAVING

DATE: 1/2/13

REVISION: 005


NOTES:



15 Volvo Drive  
 Rockleigh NJ 07647  
 Tel: 888-273-7876  
 Fax: 201-767-6011  
 www.crestron.com

DEVICE:  
 C2N-CBD-P CAMEO  
 KEYPAD  
 "MODIFIED" LAYOUT  
 INSTRUCTIONS

DRAWING:  
 5 OF 5

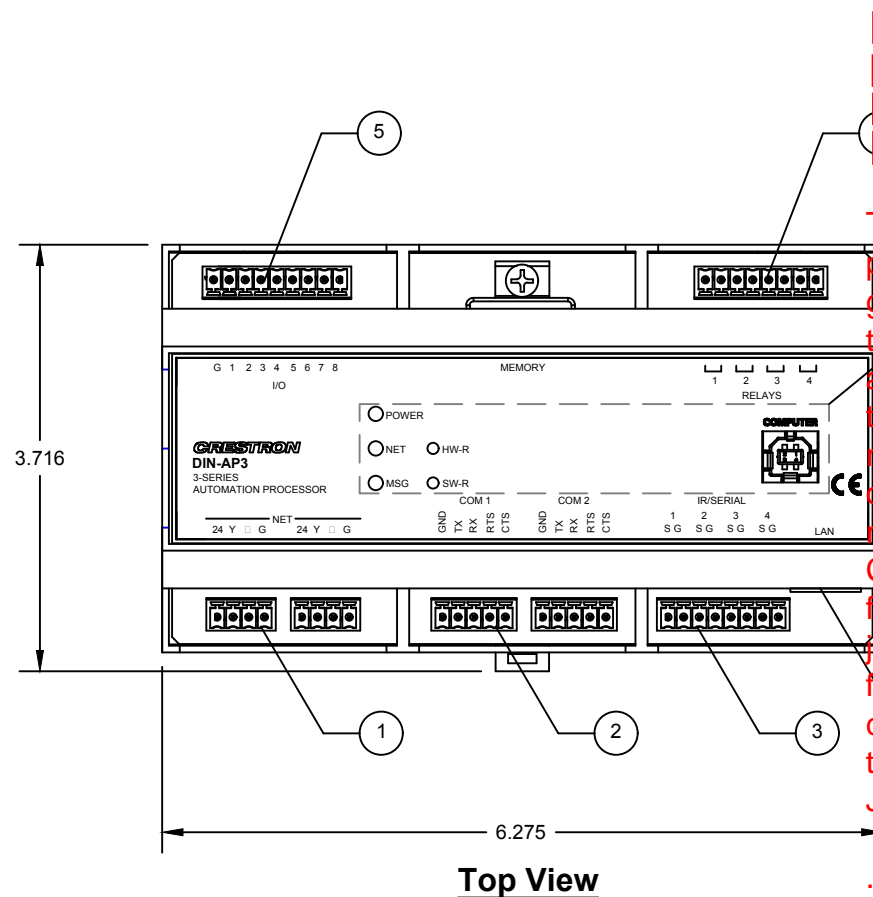


- REVIEWED
- REVIEWED AND MODIFIED
- REVISE AND RESUBMIT
- NOT REVIEWED

The review by JRP Engineering is for the sole purpose of ascertaining conformance with the general design concept. This review shall not mean the detail design inherent in the shop drawings are approved, responsibility of which shall remain with the Contractor submitting same and review shall not relieve the Contractor of this responsibility for errors or omissions in the shop drawings or his responsibility for meeting all requirements of the Contract Documents. The Contractor is responsible for dimensions to be confirmed and correlated at the job site, for information that pertains solely to fabrication processes or to techniques of construction and installation and for co-ordination of the work of all sub-trades.

JRP Engineering  
C. McGuire

End View

DATE: MAY 17th, 2017

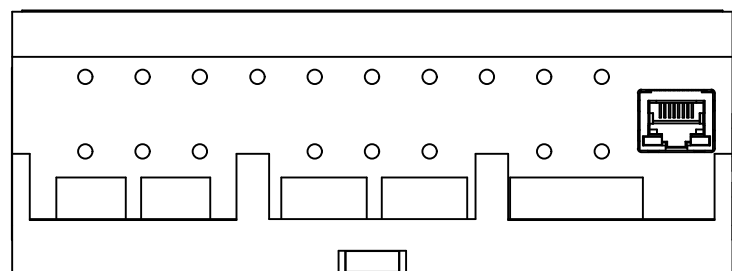

Side View

\* MODIFICATIONS:

1. Provide more information on the GLA-PWS50 for contractors.
2. Contractor to coordinate installation on site with reference to slab conduits that are currently installed.
3. If changes are required to the network layout shown in this shop drawing, the changes are to be marked up or drawings updated for the final As-Built submission for this project.
4. Electrical to coordinate with system supplier to ensure a complete and operational system is achieved.
5. Coordinate changes to drawings with contractor comments provided to you on May 9th, 2017.

**DIN-AP3 3-SERIES CONTROL AUTOMATION PROCESSOR**

**NOTES KEY**

- 1 **NET:** (2) 4-pin 3.5mm detent terminated terminals, one terminated Crest meter port. Shorted Crest terminal of (20) detent addition device mounted on the addition of DIN-HUB or similar "daisy" device.
- 2 **COM 1 - 2:** (2) DB module, bidirectional RS-232/422/485 port. Up to 115.2kbps baud rate and software controlled port.
- 3 **IR CONNECTORS**  
**IR 1 - 4:** (1) 8-pin detent 3.5mm terminated connector (4) IR/Serial Port IR output up to 1.2 MHz  
  
1-wire TTL/RS-232 (0-5 Volt) up to 115.2kbps  
  
Indication indicator per port, low impedance firing of port  
  
4 **LAN:** (1) 8-wire RJ45 (8P8C modular female) 10BaseT/100BaseTX Ethernet port  
  
(2) LED, green LED indicator Ethernet indicator LED indicator Ethernet  
  
5 **I/O 1 - 8:** (1) 8-pin 3.5mm detent terminated connector (8) digital output or Analog input port (referenced to GND) Digital Voltage Range: 0-24 Volt DC  
Logic Threshold: ≥1.2 Volts DC active/high  
Digital Output: 250mA from maximum 24 Volt DC, diode for the "wired" load  
Analog Input: Rated for 0-10 Volt DC, protected to 24 Volt DC maximum, input impedance 20k ohms  
Programmable 5 Volt, 20mA current regulator  
  
6 **RELAY 1 - 4:** (1) 8-pin 3.5mm detent terminated connector (4) form C relay, isolated relay  
Rated 1 Amp, 30 Volt AC/DC  
MOV protected relay contact  
  
7 **FACE PANEL CONNECTORS, INDICATORS AND CONTROLS:**

**POWER REQUIREMENTS & ENVIRONMENTAL**

Crest Power Usage: 8 Watts (0.30 Amps @ 24 Volt DC) when in Crest network power  
  
**Environmental**  
Temperature: 32° to 104°F (0° to 40°C)  
Humidity: 10% to 90% RH (non-condensing)  
  
Heat Dissipation: 26 BTU/hr  
  
PLEASE REFER TO INSTALLATION & OPERATIONS GUIDE FOR FURTHER INFORMATION

PART #: DIN-AP3

DESCRIPTION: DIN-AP3 3-SERIES CONTROL SYSTEM

REVISION: 001

DATE: 7/10/2013

NOTES:



15 Volvo Drive  
Rockleigh NJ 07647  
Tel: 888-273-7876  
Fax: 201-767-6011  
www.creston.com

PART #: DIN-AP3

DRAWING: 1 OF 1



**INSTALLATION**

**OBSERVE THE FOLLOWING WHEN INSTALLING THE CABINET:**

- THE CABINET MUST BE MOUNTED BY A LICENSED ELECTRICIAN IN ACCORDANCE WITH ALL NATIONAL AND LOCAL CODES.
- ALLOW ADEQUATE CLEARANCE (3' MINIMUM) IN FRONT OF CABINET FOR SERVICING.
- THE CABINET IS DESIGNED FOR SURFACE MOUNTING ON A WALL.
- CABINETS ARE INTENDED FOR INDOOR USE ONLY.
- PANEL DRAWS A SMALL AMOUNT OF CURRENT FROM SWITCH INPUT #1 FOR SYSTEM OPERATION. INPUT #1 MUST BE ENERGIZED FOR PANEL TO OPERATE.

TORQUE			
TERMINAL	CONN. WIRE RANGE	TORQUE	STRIP LENGTH
LN INPUTS	14-10 AWG	4.42 LB-IN (0.5Nm)	5/16" (8MM)
SW INPUTS	14-10 AWG	4.42 LB-IN (0.5Nm)	5/16" (8MM)
N1, N1 NEUTRAL BUS	14-10 AWG	4.42 LB-IN (0.5Nm)	5/16" (8MM)
GROUND LUG	14-4 AWG	25-45 LB-IN (2.8-5.1Nm)	3/4" (19MM)
LV CONNECTORS*	26-12 AWG	4.42 LB-IN (0.5Nm)	1/4" (6MM)

\* MAY BE WIRED AS CLASS 1 OR CLASS 2

**NOTE: UNIT REQUIRES 'LINE1' AND NEUTRAL TO BE CONNECTED TO POWER UP.**

**GENERAL NOTES**

- DO NOT POWER UP SYSTEM UNTIL ALL WIRING IS VERIFIED. CARE SHOULD BE TAKEN TO ENSURE DATA (Y, □) AND POWER (24V) CONNECTIONS ARE NOT CROSSED.
- PANEL REQUIRES OVERCURRENT PROTECTION FROM AN EXTERNAL BREAKER PANEL (F.B.O.).

**SPECIFICATIONS**

SPECIFICATION	DETAILS
INPUT VOLTAGE	100-277 VAC 50/60 Hz
SWITCHING CHANNELS	8
SWITCHING LOAD TYPES	INCANDESCENT, MAGNETIC LOW VOLTAGE, ELECTRONIC LOW VOLTAGE, NEON/COLD CATHODE, HIGH-INTENSITY DISCHARGE, MOTOR
MAXIMUM LOAD	16A PER OUTPUT
LOAD RELAY RATING	277 VAC, 50A
ENVIRONMENTAL TEMPERATURE HUMIDITY	32° TO 104°F (0° TO 40°C) 10% TO 90% RH, NON-CONDENSING
AVAILABLE CRESNET POWER	15 WATTS AT 24V DC, SHARED WITH OCCUPANCY AND PHOTOCCELL SENSOR PORTS

- REVIEWED
- NEUTRAL BUS REVIEWED AND MODIFIED
- REVISION AND RESUBMIT
- NOT REVIEWED


The review by JRP Engineering is for the sole purpose of ascertaining conformance with the general design concept. This review shall not mean the detail design inherent in the shop drawings are approved, responsibility of which shall remain with the Contractor submitting same and review shall not relieve the Contractor of this responsibility for errors or omissions in the shop drawings or his responsibility for meeting all requirements of the Contract Documents. The Contractor is responsible for dimensions to be confirmed and correlated at the job site, for information that pertains solely to fabrication processes or to techniques of construction and installation and for co-ordination of the work of all sub-trades.

JRP Engineering  
C.McGuire

DATE: MAY 17th, 2017

**\* MODIFICATIONS:**

- Provide more information on the GLA-PWS50 for contractors.
- Contractor to coordinate installation on site with reference to slab conduits that are currently installed.
- If changes are required to the network layout shown in this shop drawing, the changes are to be marked up or drawings updated for the final As-Built submission for this project.
- Electrical to coordinate with system supplier to ensure a complete and operational system is achieved.
- Coordinate changes to drawings with contractors comments provided to you on May 9th, 2017.

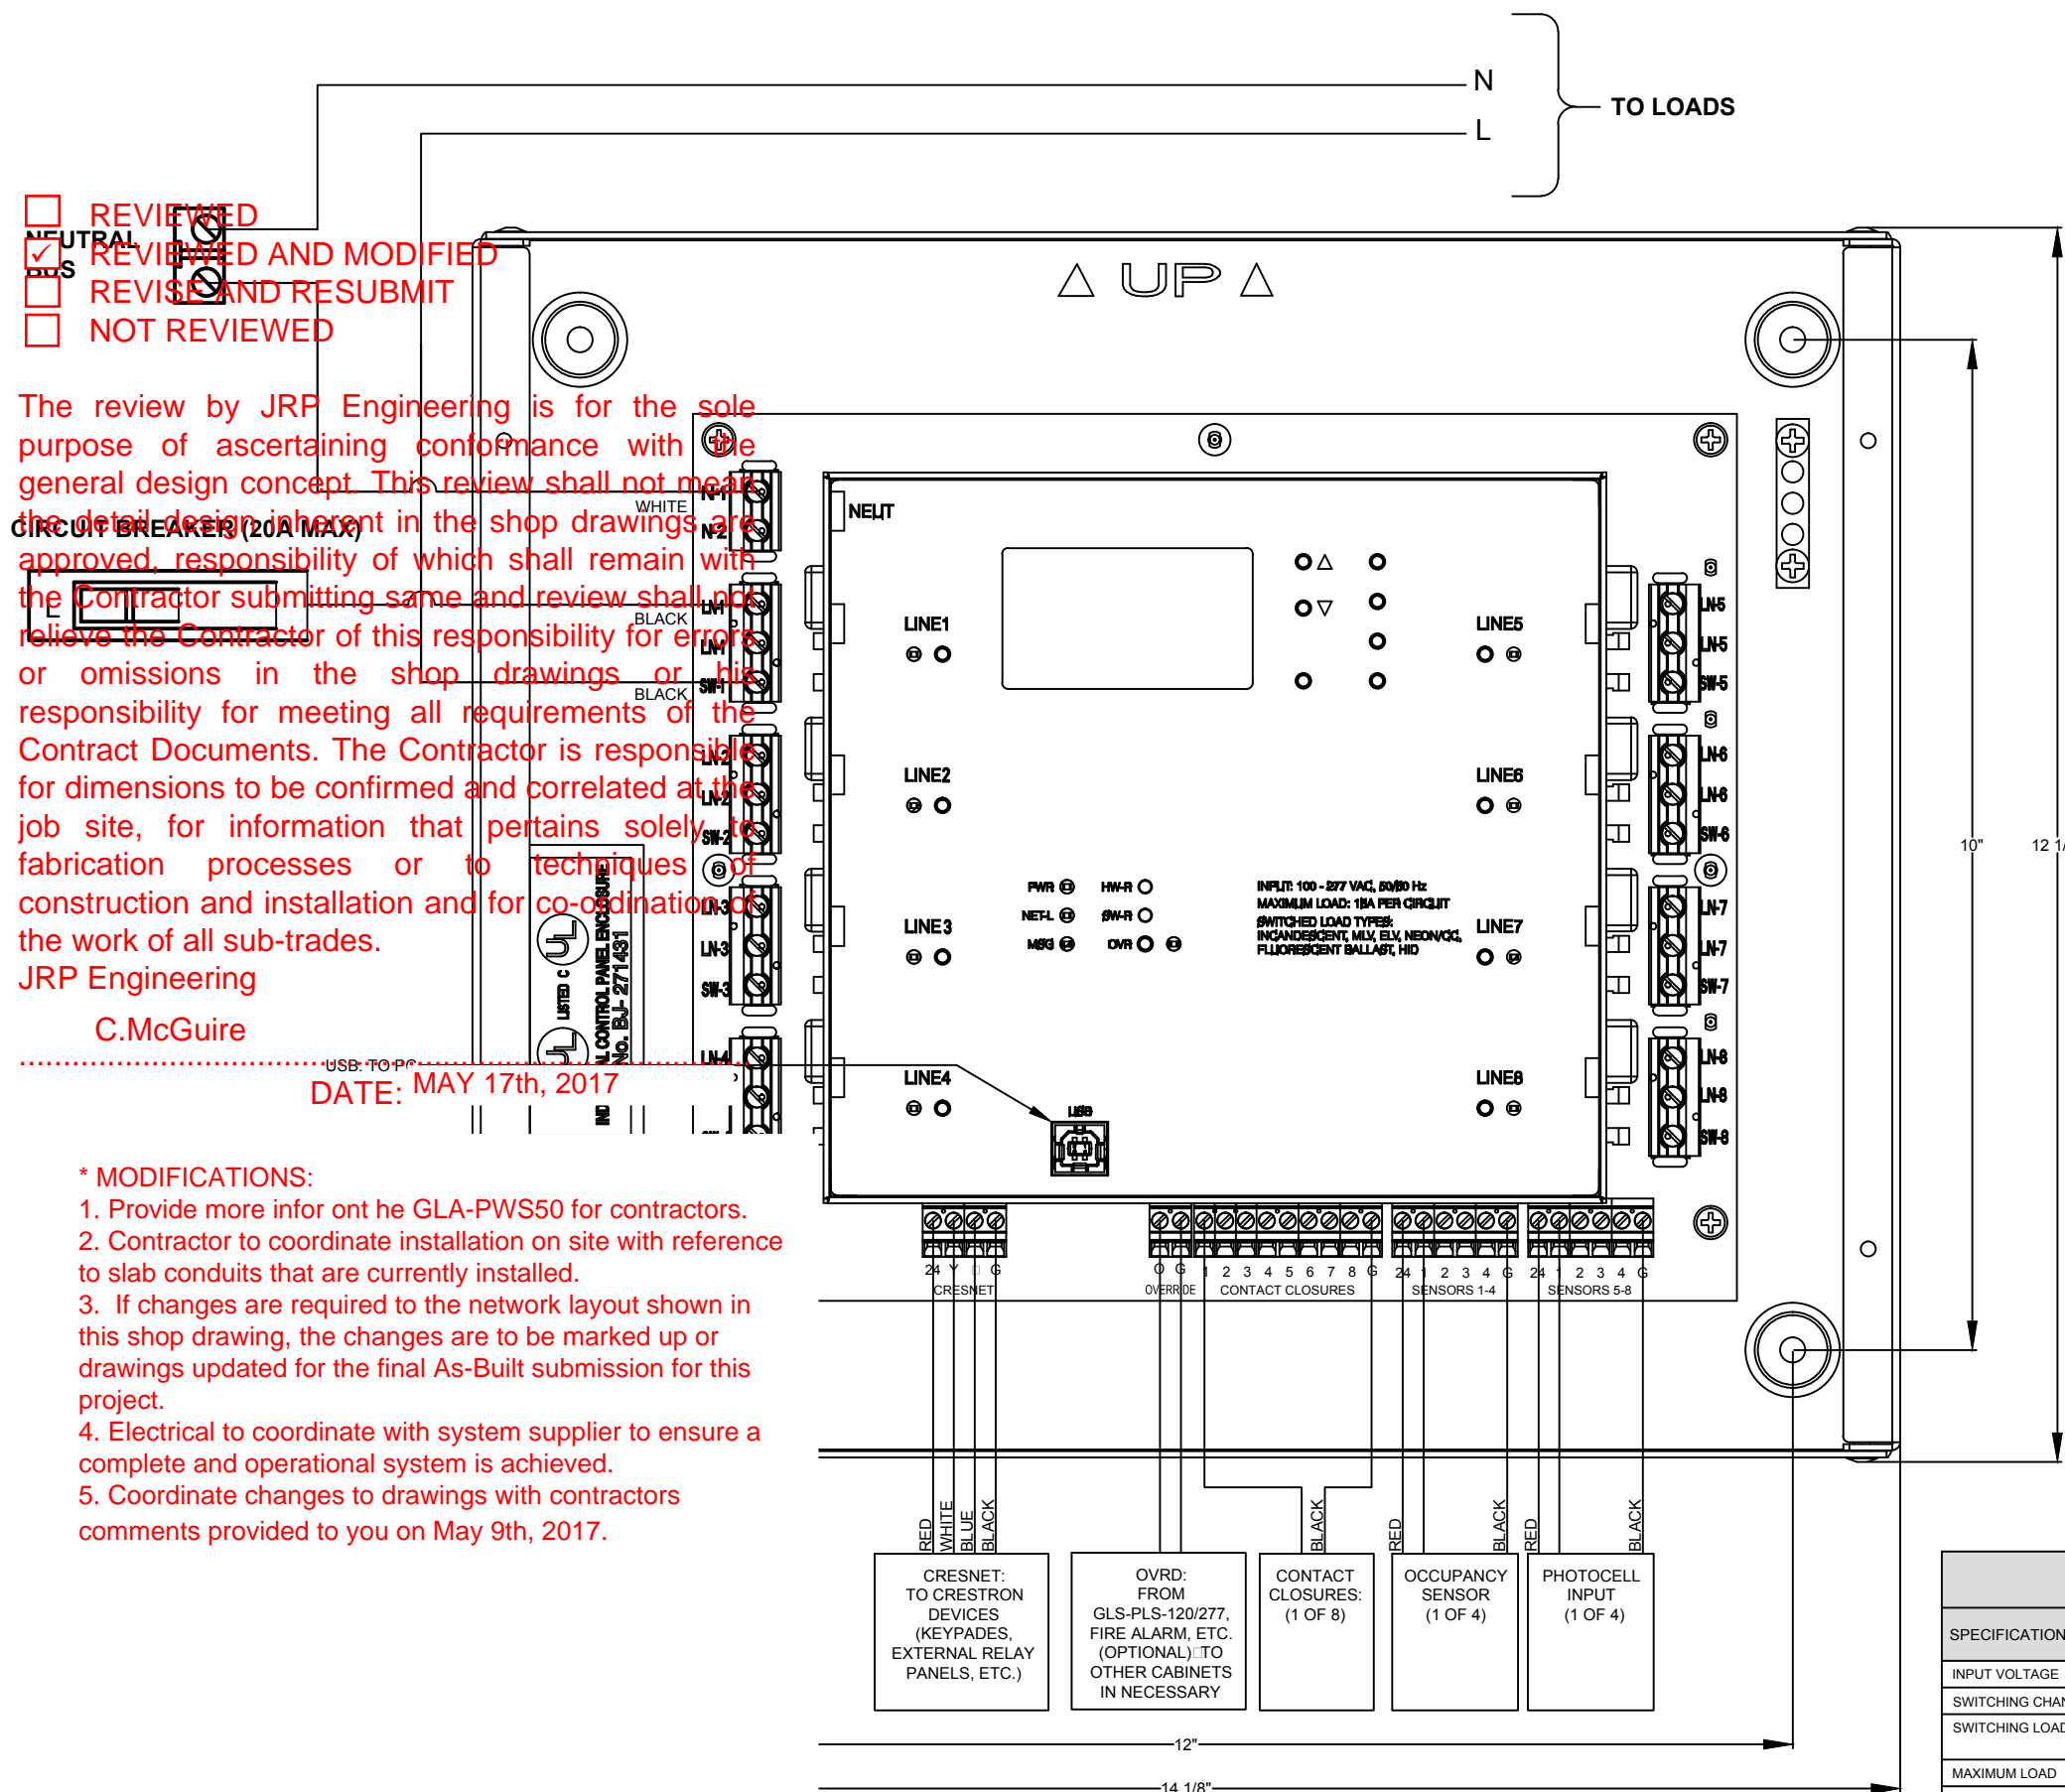

15 Volvo Drive  
Rockleigh NJ 07647  
Tel: 888-273-7876  
Fax: 201-767-6011  
www.crestron.com

PART #: GL-IPAC-SW8

DRAWING: 1 OF 1

PART #: GL-IPAC-SW8


DESCRIPTION: GL-IPAC-SW8 INTEGRATED RELAY PANEL & CONTROL

REVISION: 001

DATE: 1/21/2014

NOTES: PRELIMINARY

# GLPAC-DIMFLV4 DIMMING MODULE

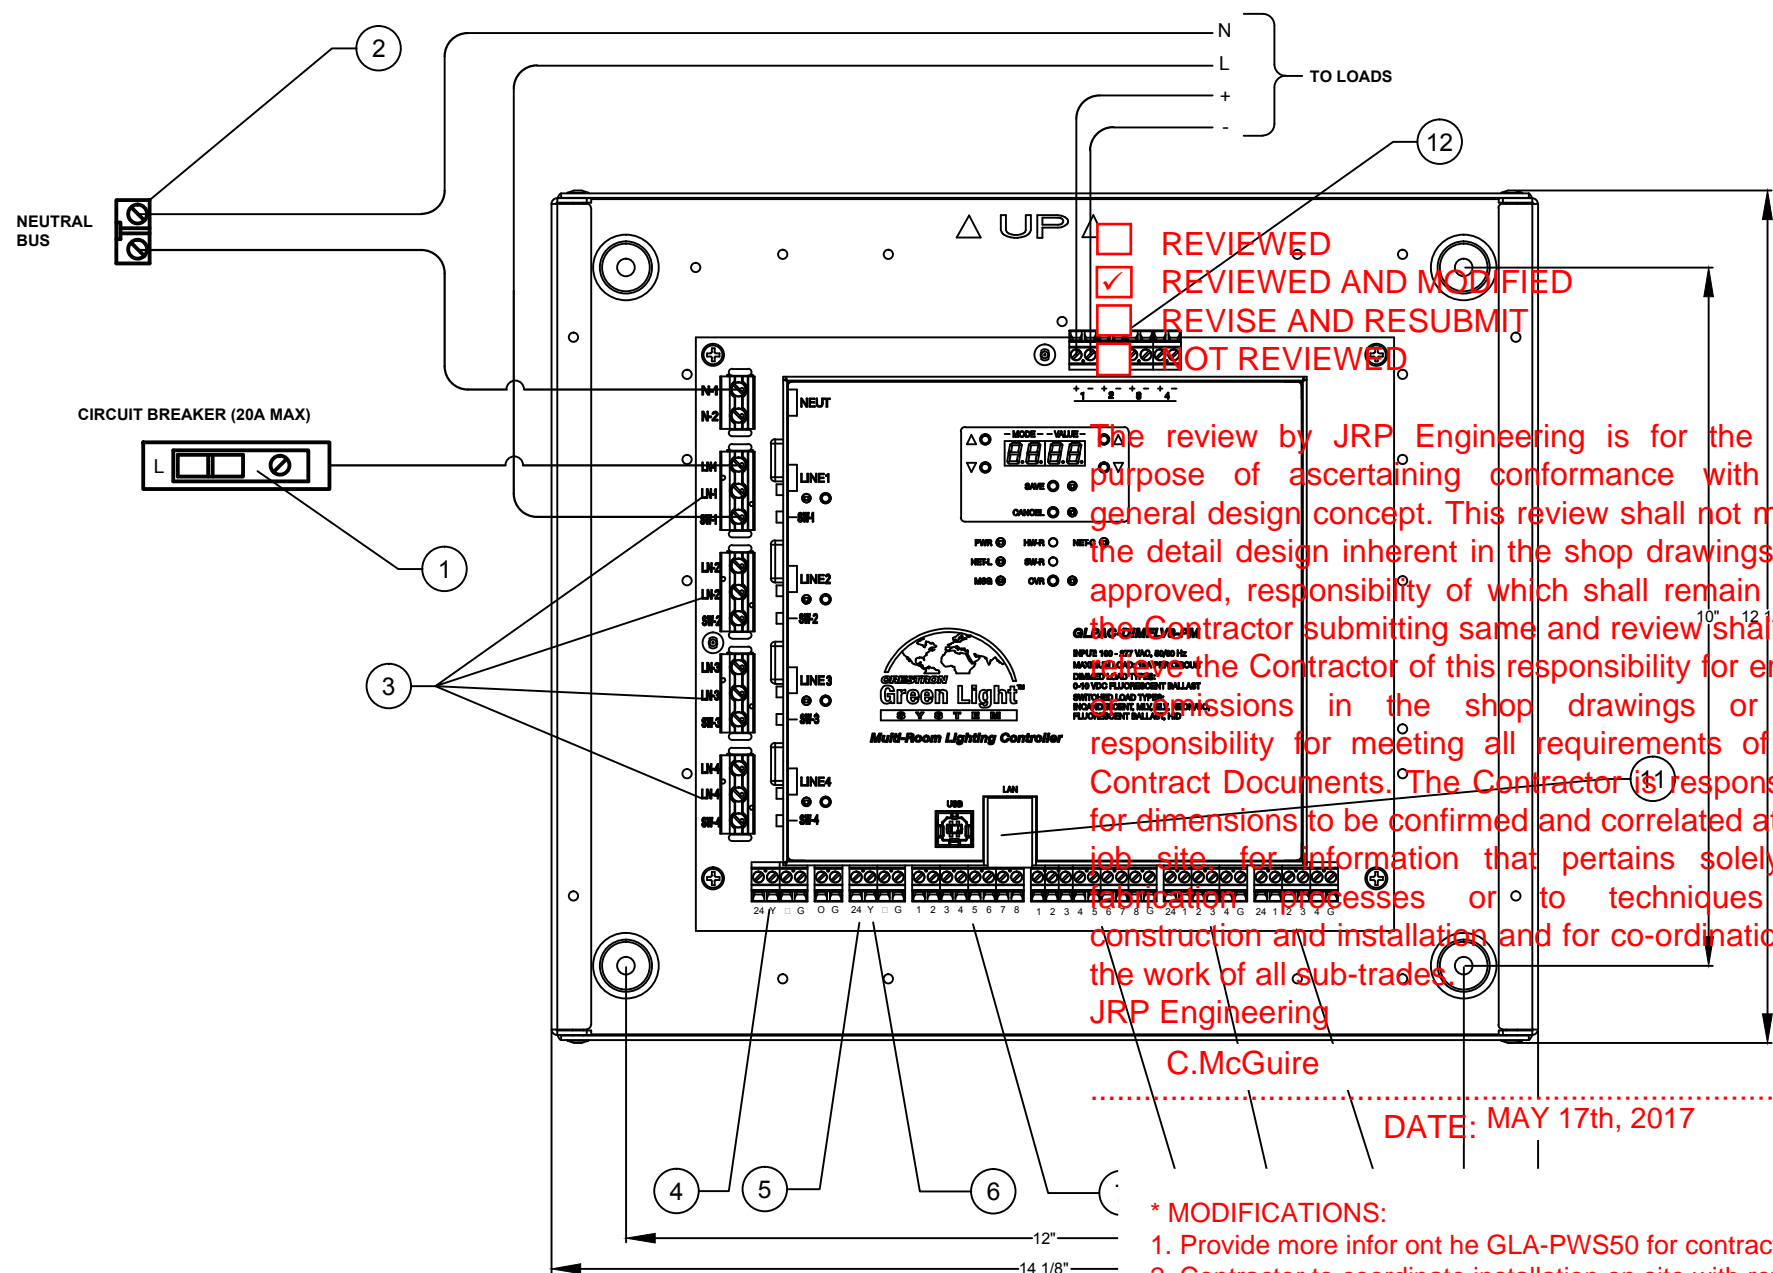

REVIEWED  
 REVIEWED AND MODIFIED  
 REVISE AND RESUBMIT  
 NOT REVIEWED

The review by JRP Engineering is for the sole purpose of ascertaining conformance with the general design concept. This review shall not mean the detail design inherent in the shop drawings are approved, responsibility of which shall remain with the Contractor submitting same and review shall not be the Contractor of this responsibility for errors or omissions in the shop drawings or his responsibility for meeting all requirements of the Contract Documents. The Contractor is responsible for dimensions to be confirmed and correlated at the job site for information that pertains solely to fabrication processes or to techniques of construction and installation and for co-ordination of the work of all sub-trades.

JRP Engineering  
 C. McGuire  
 DATE: MAY 17th, 2017

- \* MODIFICATIONS:**
1. Provide more info on the GLA-PWS50 for contractors.
  2. Contractor to coordinate installation on site with reference to slab conduits that are currently installed.
  3. If changes are required to the network layout shown in this shop drawing, the changes are to be marked up or drawings updated for the final As-Built submission for this project.
  4. Electrical to coordinate with system supplier to ensure a complete and operational system is achieved.
  5. Coordinate changes to drawings with contractors comments provided to you on May 9th, 2017.

SPECIFICATIONS	
SPECIFICATION	DETAILS
INPUT VOLTAGE	100-277 VAC 50/60 Hz
DIMMER CHANNELS	4
SUPPORTED LOAD TYPES	FLUORESCENT BALLAST, INCANDESCENT, MAGNETIC LOW VOLTAGE, ELECTRONIC LOW VOLTAGE, NEON/COLD CATHODE, HIGH-INTENSITY DISCHARGE, MOTOR
MAXIMUM LOAD	16A PER OUTPUT
LOAD RELAY RATING	277 VAC, 50A
SIGNAL RELAY RATING	1A, 30 VOLTS DC
ENVIRONMENTAL TEMPERATURE HUMIDITY	32° TO 104°F (0° TO 40°C) 10% TO 90% RH, NON-CONDENSING
AVAILABLE CRESNET POWER	10 WATTS AT 24V DC, SHARED WITH OCCUPANCY AND PHOTOCCELL SENSOR PORTS



## NOTES KEY

- 1 CIRCUIT BREAKER (20A MAX) - BREAKER IS FURNISHED BY ELECTRICAL CONTRACTOR.
- 2 NEUTRAL BUS BAR - BUS BAR IS INTEGRAL TO CIRCUIT BREAKER PANEL BOARD.
- 3 (2) LINE AND (1) LOAD TERMINAL FOR EACH OF (4) CIRCUITS. (SCREWS TO BE TORQUED TO 8 IN-LB)
- 4 MASTER CRESNET NETWORK CONNECTOR FOR COMMUNICATION TO BUILDING PROCESSOR.
- 5 EMERGENCY OVERRIDE INPUT FOR UL 24 COMPLIANCE
- 6 LOCAL CRESNET NETWORK CONNECTOR FOR COMMUNICATION LOCAL DEVICES.
- 7 SIGNAL RELAYS TO HVAC SYSTEMS (PM VERSION ONLY).
- 8 CONTACT CLOSURES.
- 9 (4) OCCUPANCY SENSOR INPUTS. 24V LOW VOLTAGE POWER PROVIDED.
- 10 (4) PHOTO SENSOR INPUTS. 24V LOW VOLTAGE POWER PROVIDED.
- 11 ETHERNET CONNECTION FOR SYSTEM CONFIGURATION.
- 12 0-10V OUTPUT FOR DIMMING OF FIXTURES. USE CLASS 1 OR CLASS 2 WIRE. 0-10V OUTPUTS MUST CORRESPOND TO LINE OUTPUTS. MINIMUM GAUGE WIRE IS 18AWG.

## GENERAL NOTES

1. DO NOT POWER UP SYSTEM UNTIL ALL WIRING IS VERIFIED. CARE SHOULD BE TAKEN TO ENSURE DATA (Y, □) AND POWER (24, G) CONNECTIONS ARE NOT CROSSED.
2. MODULE SHIPS FROM WITH FACTORY INSTALLED JUMPERS ON EACH CIRCUIT. JUMPERS MUST BE REMOVED AT COMMISSIONING.
5. PANEL REQUIRES OVERCURRENT PROTECTION FROM AN EXTERNAL BREAKER PANEL (F.B.O.).

## RESNET CONTROL WIRING

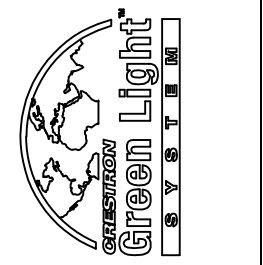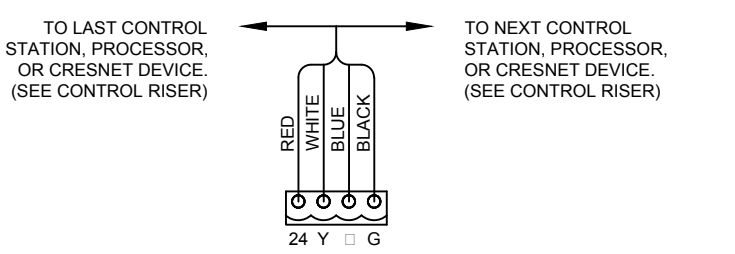

PART #: GLPAC-DIMFLV4  
 DESCRIPTION: GLPAC-DIMFLV4  
 REVISION: 000  
 DATE: 4/13/2011  
 NOTES:

**CRESTRON**  
 15 Volvo Drive  
 Rockleigh NJ 07647  
 Tel: 888-273-7876  
 Fax: 201-767-6011  
 www.crestron.com

PART #: GLPAC-DIMFLV4  
 DRAWING: 1 OF 2

- REVIEWED
- REVIEWED AND MODIFIED
- REVISE AND RESUBMIT
- NOT REVIEWED

Bus review by JRP Engineering is for the sole purpose of ascertaining conformance with the general design concept. This review shall not mean the detail design inherent in the shop drawings are approved, responsibility of which shall remain with the Contractor submitting same and review shall not relieve the Contractor of this responsibility for errors or omissions in the shop drawings or this responsibility for meeting all requirements of the Contract Documents. The Contractor is responsible for dimensions to be confirmed and correlated at the job site, for information that pertains safety of fabrication processes or to techniques of construction and installation and for co-ordination of the work of all sub-trades.


JRP Engineering

C. McGuire

DATE: MAY 17th, 2017

**\* MODIFICATIONS:**

1. Provide more information on the GLA-PWS50 for contractors.
2. Contractor to coordinate installation on site with reference to slab conduits that are currently installed.
3. If changes are required to the network layout shown in this shop drawing, the changes are to be marked up or drawings updated for the final As-Built submission for this project.
4. Electrical to coordinate with system supplier to ensure a complete and operational system is achieved.
5. Coordinate changes to drawings with contractors comments provided to you on May 9th, 2017.

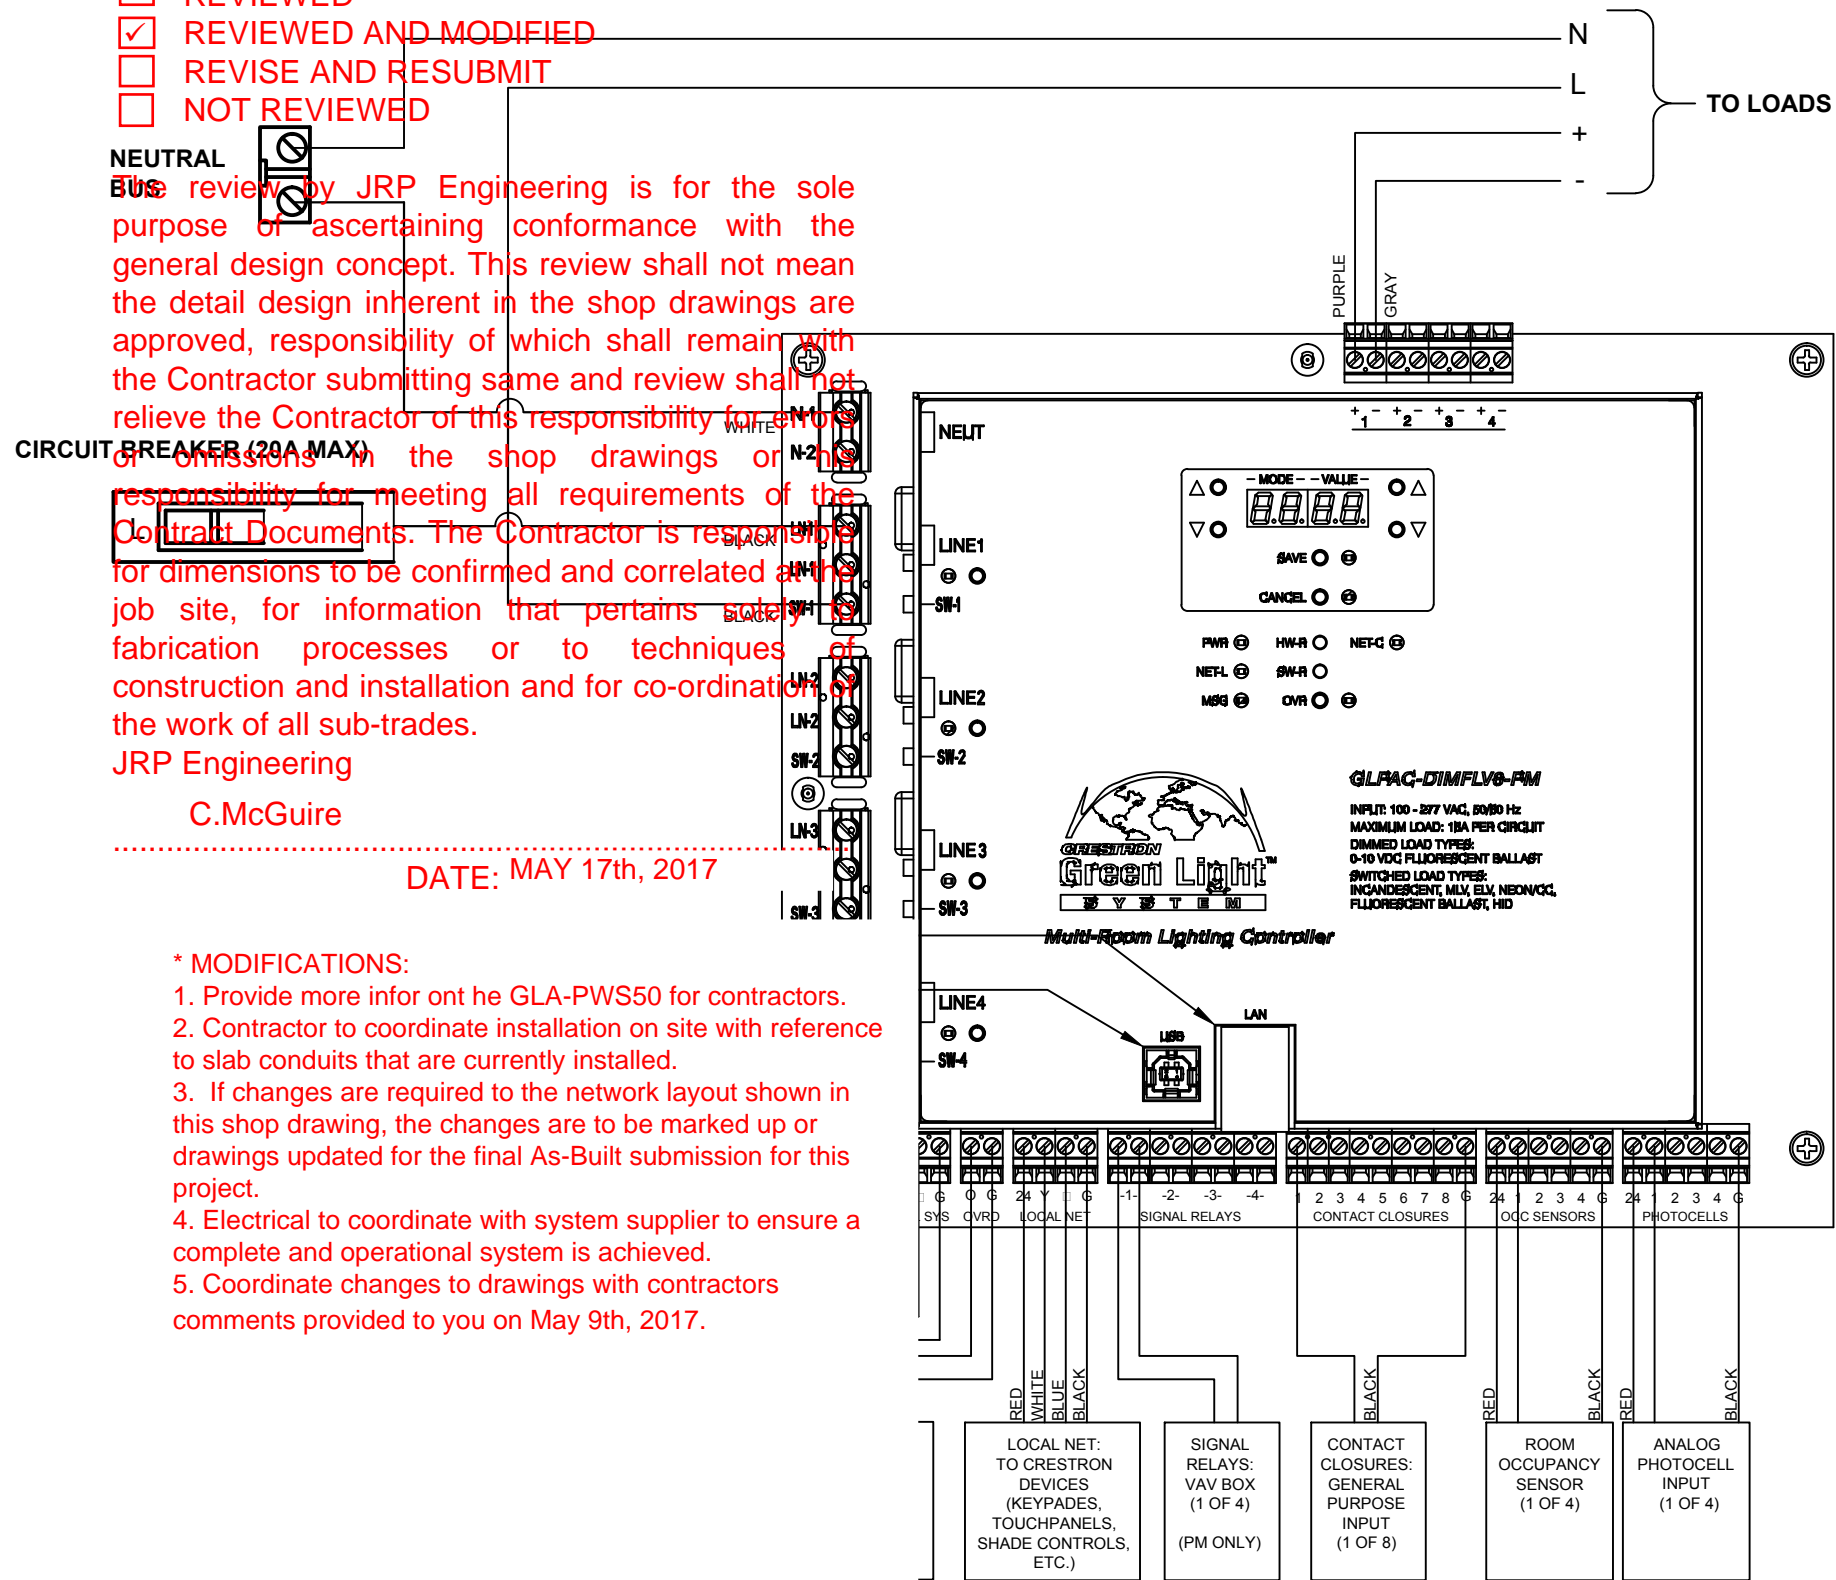

**INSTALLATION**

- OBSERVE THE FOLLOWING WHEN INSTALLING THE CABINET:**
- THE CABINET MUST BE MOUNTED BY A LICENSED ELECTRICIAN IN ACCORDANCE WITH ALL NATIONAL AND LOCAL CODES.
  - ALLOW ADEQUATE CLEARANCE (3' MINIMUM) IN FRONT OF CABINET FOR SERVICING.
  - THE CABINET IS DESIGNED FOR SURFACE MOUNTING ON A WALL.
  - CABINETS ARE INTENDED FOR INDOOR USE ONLY.

TORQUE			
TERMINAL	CONN. WIRE RANGE	TORQUE	STRIP LENGTH
LN INPUTS	14-10 AWG	4.42 LB-IN (0.5Nm)	5/16" (8MM)
SW INPUTS	14-10 AWG	4.42 LB-IN (0.5Nm)	5/16" (8MM)
N1, N1 NEUTRAL BUS	14-10 AWG	4.42 LB-IN (0.5Nm)	5/16" (8MM)
0-10V OUTPUTS*	28-12 AWG	4.42 LB-IN (0.5Nm)	5/16" (8MM)
GROUND LUG	14-4 AWG	25-45 LB-IN (2.8-5.1Nm)	3/4" (19MM)
LV CONNECTORS*	26-12 AWG	4.42 LB-IN (0.5Nm)	1/4" (6MM)

\* MAY BE WIRED AS CLASS 1 OR CLASS 2

- LOAD WIRING:**
1. TURN OFF ALL CIRCUIT BREAKERS
  2. CONNECT THE NEUTRAL BUS AND GROUND LUGS
  3. CONNECT THE INCOMING FEED CONNECTORS TO THE 'LINE' AND 'N' INPUT TERMINALS (REFER TO DIAGRAM)

- NOTE:** WHEN FEEDING FROM A SINGLE BRANCH CIRCUIT, ADDITIONAL LINE TERMINALS ARE PROVIDED TO ALLOW FOR DAISY-CHAINING OF CHANNELS
4. CONNECT 0-10V CONTROL WIRES FOR THE DIMMED LOADS TO THE APPROPRIATE OUTPUT TERMINALS (1-8)
  5. TEST THE CIRCUIT FOR ELECTRICAL FAULTS BY TURNING ON EACH CIRCUIT BREAKER, CHECKING THAT THE BREAKERS DO NOT TRIP, AND THAT POWER IS DELIVERED TO THE PROPER LOADS

**NOTE:** UNIT REQUIRES 'LINE1' AND NEUTRAL TO BE CONNECTED TO POWER UP

**INPUT WIRING:**

USE CRESTRON CERTIFIED WIRE SUCH AS CRESNET-NP OR CRESNET-P. TO ENSURE OPTIMUM PERFORMANCE OVER THE FULL RANGE OF YOUR INSTALLATION TOPOLOGY, USE CRESTRON CERTIFIED WIRE. FAILURE TO DO SO MAY INCUR ADDITIONAL CHARGES IF SUPPORT IS REQUIRED TO IDENTIFY PERFORMANCE DEFICIENCIES BECAUSE OF USING IMPROPER WIRE.

SEE DIAGRAM TO THE LEFT FOR WIRING OF REPRESENTATIVE DEVICES.

**TESTING:**

**MANUAL CONTROL**  
LIGHTING LOADS CAN BE MANUALLY CONTROLLED FROM THE FRONT PANEL

**OVERRIDE MODE**  
THE OVERRIDE MODE OVERRIDES THE CONTROL SYSTEM PROGRAM AND SETS ALL OF THE OUTPUT STATES TO THE STORED OVERRIDE VALUES (SEE BELOW)

TO ENABLE OVERRIDE, PRESS AND RELEASE THE 'OVR' BUTTON. THE 'OVR' LED FLASHES SLOWLY

**NOTE:** IF OVERRIDE MODE WAS ENABLED FROM AN EXTERNAL DEVICE (I.E. A CONTACT CLOSURE ON THE 'OVRD' TERMINALS, THE OVR LED WILL FLASH QUICKLY. PRESSING THE OVR BUTTON HAS NO EFFECT.

TO DISABLE OVERRIDE MODE, PRES THE OVR BUTTON AGAIN. THE OVR LED EXTINGUISHES AND THE OUTPUTS RETURN TO THE STATES SET BY THE CONTROL PROGRAM.

**NOTE:** IF OVERRIDE STATES HAVE NOT BEEN STORED, THE FACTORY DEFAULT IS "ALL ON"

**SAVE OVERRIDE SETTINGS**  
THE STATE OF ALL OUTPUTS CAN BE SAVED AS AN OVERRIDE SETTING, WHICH IS AUTOMATICALLY RECALLED BY OVERRIDE MODE

**NOTE:** THE CONTROL SYSTEM PROGRAM CAN BE SET TO PREVENT LOCALLY CHANGING THE OVERRIDE STATE. IF THIS SETTING IS ENABLED, THE DISPLAY WILL SHOW "ERR" WHEN TRYING TO SAVE OVERRIDE STATES.

TO SAVE THE CURRENT STATE OF ALL OUTPUTS AS THE OVERRIDE SETTING, PRESS AND HOLD THE OVR BUTTON FOR 3 SECONDS, UNTIL THE LED BLINKS ONCE.



PART #: GLPAC-DIMFLV4

DESCRIPTION: GLPAC-DIMFLV4

REVISION: 000

DATE: 4/13/2011

NOTES:




15 Volvo Drive  
Rockleigh NJ 07647  
Tel: 888-273-7876  
Fax: 201-767-6011  
www.crestron.com

PART #: GLPAC-DIMFLV4

DRAWING: 2 OF 2

# GLPAC-DIMFLV8 DIMMING MODULE

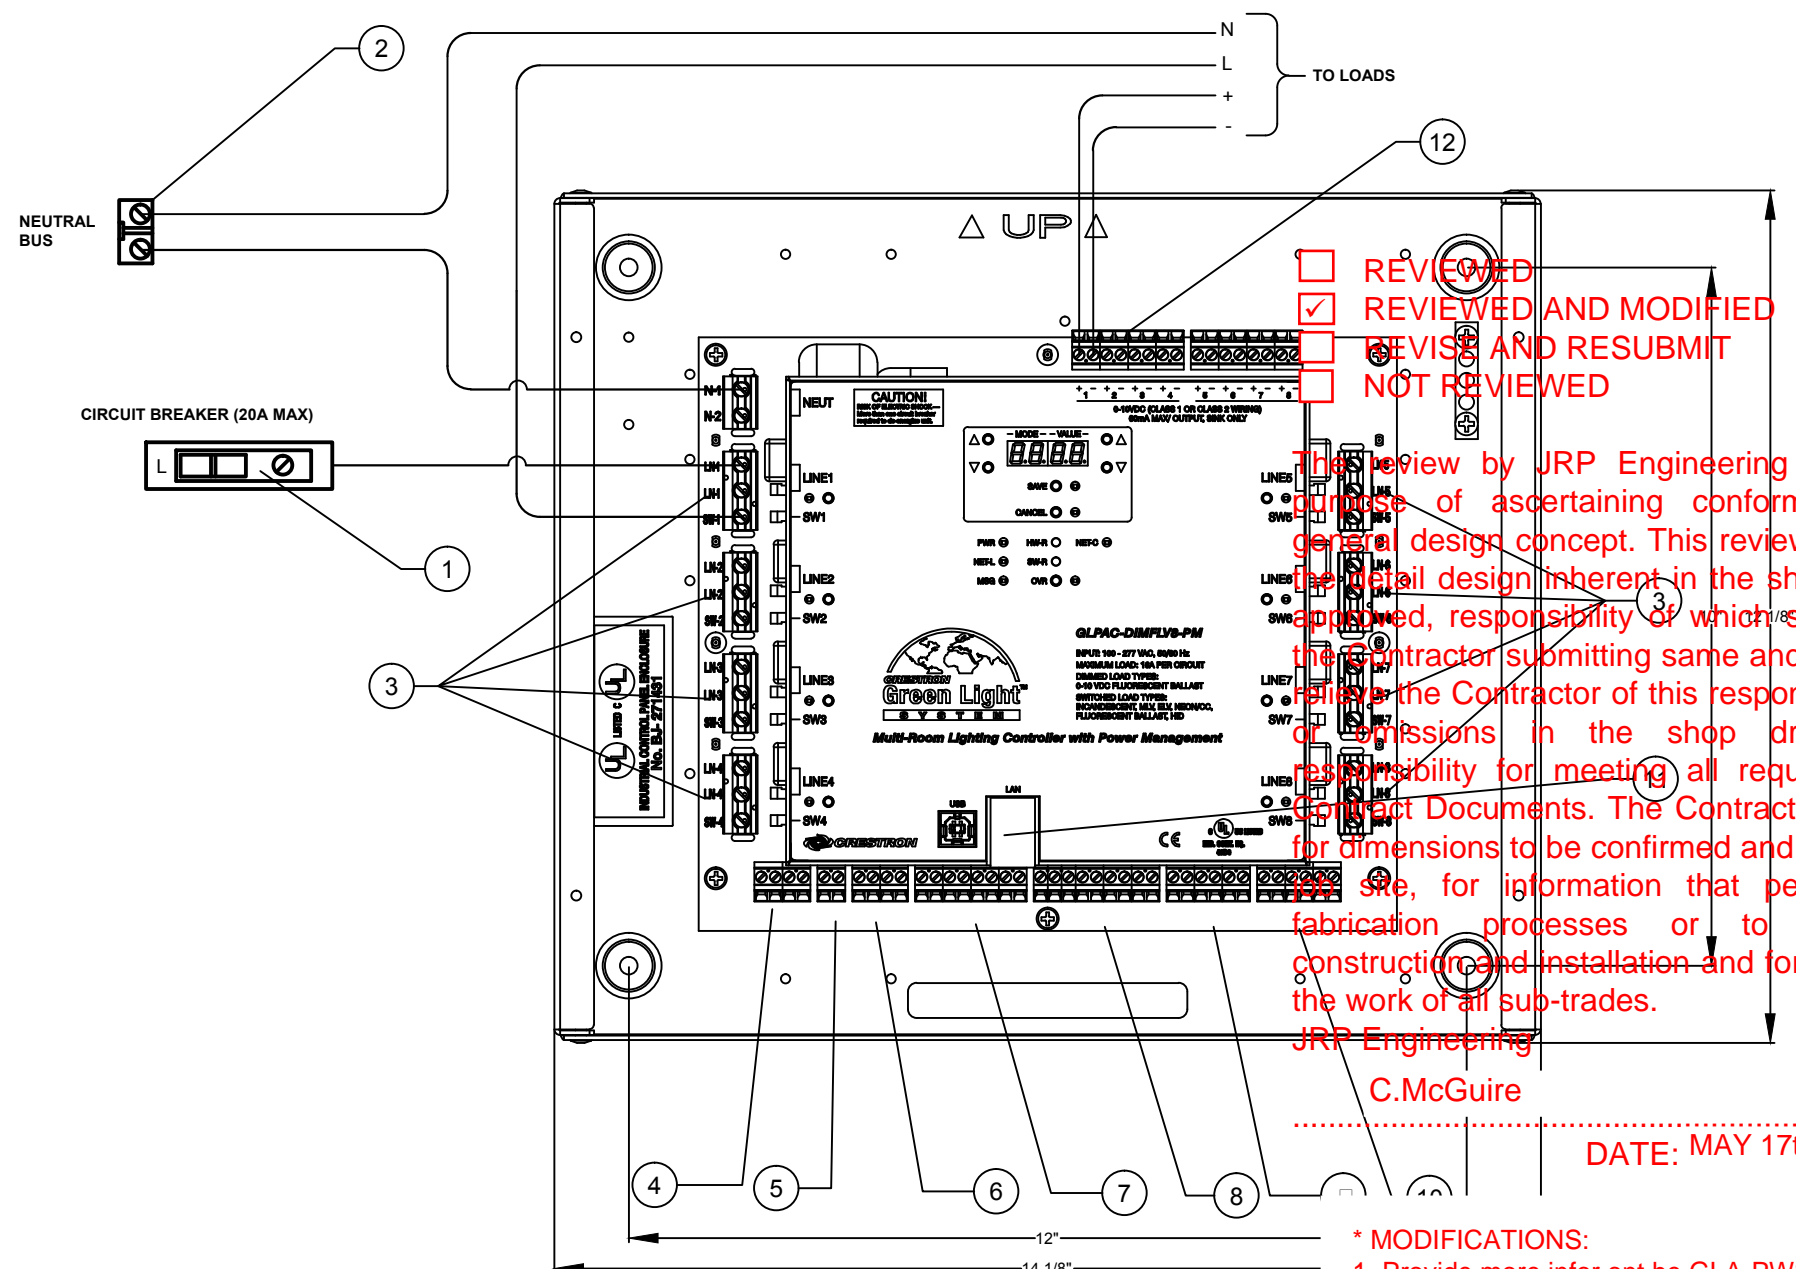

REVIEWED  
 REVIEWED AND MODIFIED  
 REVISE AND RESUBMIT  
 NOT REVIEWED

This review by JRP Engineering is for the sole purpose of ascertaining conformance with the general design concept. This review shall not mean the detail design inherent in the shop drawings are approved, responsibility of which shall remain with the Contractor submitting same and review shall not relieve the Contractor of this responsibility for errors or omissions in the shop drawings or his responsibility for meeting all requirements of the Contract Documents. The Contractor is responsible for dimensions to be confirmed and correlated at the job site, for information that pertains solely to fabrication processes or to techniques of construction and installation and for co-ordination of the work of all sub-trades.

JRP Engineering  
 C. McGuire  
 DATE: MAY 17th, 2017

- \* MODIFICATIONS:**
1. Provide more info on the GLA-PWS50 for contractors.
  2. Contractor to coordinate installation on site with reference to slab conduits that are currently installed.
  3. If changes are required to the network layout shown in this shop drawing, the changes are to be marked up or drawings updated for the final As-Built submission for this project.
  4. Electrical to coordinate with system supplier to ensure a complete and operational system is achieved.
  5. Coordinate changes to drawings with contractors comments provided to you on May 9th, 2017.

SPECIFICATIONS	
SPECIFICATION	DETAILS
INPUT VOLTAGE	100-277 VAC 50/60 Hz
DIMMER CHANNELS	8
SUPPORTED LOAD TYPES	FLUORESCENT BALLAST, INCANDESCENT, MAGNETIC LOW VOLTAGE, ELECTRONIC LOW VOLTAGE, NEON/COLD CATHODE, HIGH-INTENSITY DISCHARGE, MOTOR
MAXIMUM LOAD	16A PER OUTPUT
LOAD RELAY RATING	277 VAC, 50A
SIGNAL RELAY RATING	1A, 30 VOLTS DC
ENVIRONMENTAL TEMPERATURE HUMIDITY	32° TO 104°F (0° TO 40°C) 10% TO 90% RH, NON-CONDENSING
AVAILABLE CRESNET POWER	10 WATTS AT 24V DC, SHARED WITH OCCUPANCY AND PHOTOCCELL SENSOR PORTS

## NOTES KEY

1. CIRCUIT BREAKER (20A MAX) - BREAKER IS FURNISHED BY ELECTRICAL CONTRACTOR.
2. NEUTRAL BUS BAR - BUS BAR IS INTEGRAL TO CIRCUIT BREAKER PANEL BOARD.
3. (2) LINE AND (1) LOAD TERMINAL FOR EACH OF (8) CIRCUITS. (SCREWS TO BE TORQUED TO 8 IN-LB)
4. MASTER CRESNET NETWORK CONNECTOR FOR COMMUNICATION TO BUILDING PROCESSOR.
5. EMERGENCY OVERRIDE INPUT FOR UL 24 COMPLIANCE
6. LOCAL CRESNET NETWORK CONNECTOR FOR COMMUNICATION LOCAL DEVICES.
7. SIGNAL RELAYS TO HVAC SYSTEMS (PM VERSION ONLY).
8. CONTACT CLOSURES.
9. (4) OCCUPANCY SENSOR INPUTS. 24V LOW VOLTAGE POWER PROVIDED.
10. (4) PHOTO SENSOR INPUTS. 24V LOW VOLTAGE POWER PROVIDED.
11. ETHERNET CONNECTION FOR SYSTEM CONFIGURATION.
12. 0-10V OUTPUT FOR DIMMING OF FIXTURES. USE CLASS 1 OR CLASS 2 WIRE. 0-10V OUTPUTS MUST CORRESPOND TO LINE OUTPUTS. MINIMUM GAUGE WIRE IS 18AWG.



## GENERAL NOTES

1. DO NOT POWER UP SYSTEM UNTIL ALL WIRING IS VERIFIED. CARE SHOULD BE TAKEN TO ENSURE DATA (Y, G) AND POWER (24, G) CONNECTIONS ARE NOT CROSSED.
2. MODULE SHIPS FROM WITH FACTORY INSTALLED JUMPERS ON EACH CIRCUIT. JUMPERS MUST BE REMOVED AT COMMISSIONING.
3. NEUTRAL REQUIRES OVERCURRENT PROTECTION FROM AN INTERNAL BREAKER PANEL (F.B.O.).

INCLUDING "4E" IN THE PART NUMBER INCLUDES 3 BARRIERS SEPARATING LEFT & RIGHT SIDES TO 4 R 4 NORMAL AND 4 EMERGENCY CIRCUITS. PANEL USES "EMERGENCY CIRCUITS" LABEL. CIRCUITS 1-4 USED FOR EMERGENCY. CIRCUIT 1 MUST BE LIVE TO OPERATE.

MODELS ARE AVAILABLE WITH EMERGENCY BUT THIS MUST BE SPECIFIED AT THE TIME OF RELEASE FOR LABEL TO BE ADDED.

## RESNET CONTROL WIRING

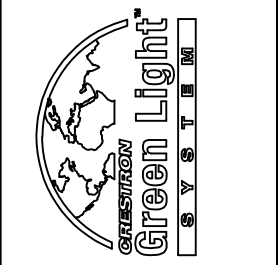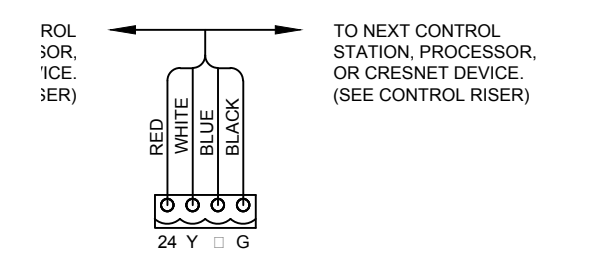

PART #: GLPAC-DIMFLV8  
 DESCRIPTION: GLPAC-DIMFLV8  
 REVISION: 003  
 DATE: 10/2/2015  
 NOTES:

**CRESTRON**  
 15 Volvo Drive  
 Rockleigh NJ 07647  
 Tel: 888-273-7876  
 Fax: 201-767-6011  
 www.crestron.com

PART #: GLPAC-DIMFLV8  
 DRAWING: 1 OF 2



- REVIEWED
- REVIEWED AND MODIFIED
- REVISED AND RESUBMIT
- NOT REVIEWED


The review by JRP Engineering is for the sole purpose of ascertaining conformance with the general design concept. This review shall not mean the detail design inherent in the shop drawings are approved, responsibility of which shall remain with the Contractor. The Contractor shall not relieve the Contractor of this responsibility for errors or omissions in the shop drawings or his responsibility for meeting all requirements of the Contract Documents. The Contractor is responsible for dimensions to be confirmed and correlated at the job site, for information that pertains solely to fabrication processes or to techniques of construction and installation and for co-ordination of the work of all sub-trades.

JRP Engineering  
C.McGuire

DATE: MAY 17th, 2017

**\* MODIFICATIONS:**

1. Provide more information on the GLA-PWS50 for contractors.
2. Contractor to coordinate installation on site with reference to slab conduits that are currently installed.
3. If changes are required to the network layout shown in this shop drawing, the changes are to be marked up or drawings updated for the final As-Built submission for this project.
4. Electrical to coordinate with system supplier to ensure a complete and operational system is achieved.
5. Coordinate changes to drawings with contractors comments provided to you on May 9th, 2017.

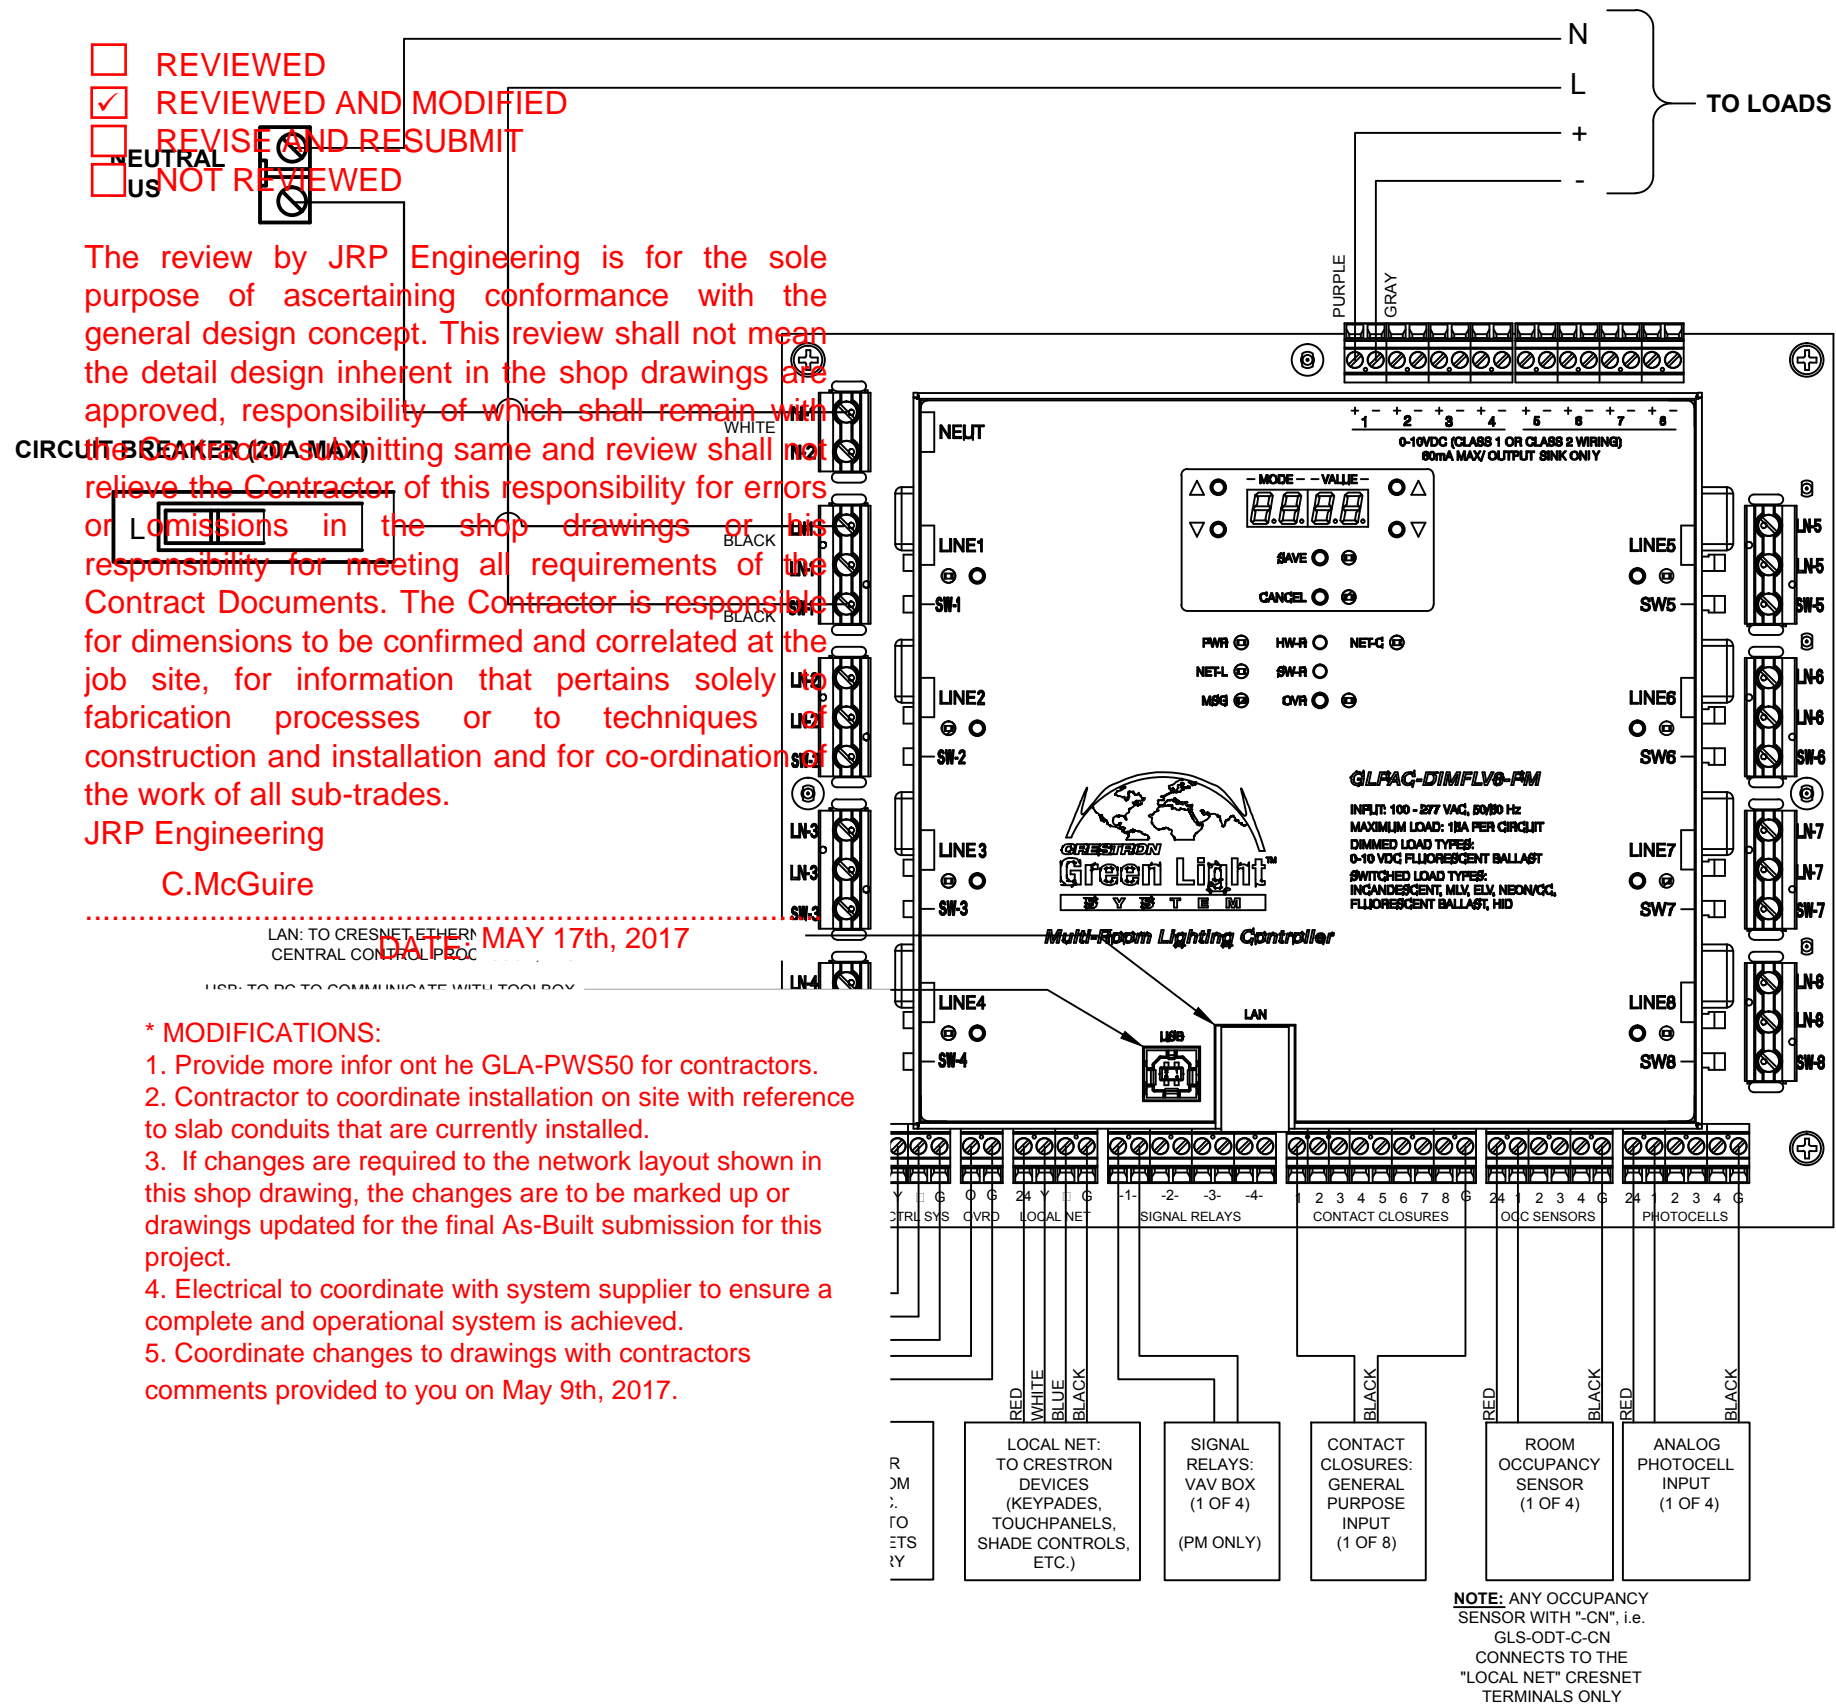

**INSTALLATION**

- OBSERVE THE FOLLOWING WHEN INSTALLING THE CABINET:**
- THE CABINET MUST BE MOUNTED BY A LICENSED ELECTRICIAN IN ACCORDANCE WITH ALL NATIONAL AND LOCAL CODES.
  - ALLOW ADEQUATE CLEARANCE (3' MINIMUM) IN FRONT OF CABINET FOR SERVICING.
  - THE CABINET IS DESIGNED FOR SURFACE MOUNTING ON A WALL.
  - CABINETS ARE INTENDED FOR INDOOR USE ONLY.

TORQUE			
TERMINAL	CONN. WIRE RANGE	TORQUE	STRIP LENGTH
LN INPUTS	14-10 AWG	4.42 LB-IN (0.5Nm)	5/16" (8MM)
SW INPUTS	14-10 AWG	4.42 LB-IN (0.5Nm)	5/16" (8MM)
N1, N1 NEUTRAL BUS	14-10 AWG	4.42 LB-IN (0.5Nm)	5/16" (8MM)
0-10V OUTPUTS*	28-12 AWG	4.42 LB-IN (0.5Nm)	5/16" (8MM)
GROUND LUG	14-4 AWG	25-45 LB-IN (2.8-5.1Nm)	3/4" (19MM)
LV CONNECTORS*	26-12 AWG	4.42 LB-IN (0.5Nm)	1/4" (6MM)

\*MAY BE WIRED AS CLASS 1 OR CLASS 2

- LOAD WIRING:**
1. TURN OFF ALL CIRCUIT BREAKERS
  2. CONNECT THE NEUTRAL BUS AND GROUND LUGS
  3. CONNECT THE INCOMING FEED CONNECTORS TO THE 'LINE' AND 'N' INPUT TERMINALS (REFER TO DIAGRAM)

**NOTE:** WHEN FEEDING FROM A SINGLE BRANCH CIRCUIT, ADDITIONAL LINE TERMINALS ARE PROVIDED TO ALLOW FOR DAISY-CHAINING OF CHANNELS

4. CONNECT 0-10V CONTROL WIRES FOR THE DIMMED LOADS TO THE APPROPRIATE OUTPUT TERMINALS (1-8)
5. TEST THE CIRCUIT FOR ELECTRICAL FAULTS BY TURNING ON EACH CIRCUIT BREAKER, CHECKING THAT THE BREAKERS DO NOT TRIP, AND THAT POWER IS DELIVERED TO THE PROPER LOADS

**NOTE:** UNIT REQUIRES 'LINE1' AND NEUTRAL TO BE CONNECTED TO POWER UP ANY GLPAC INCLUDING "4E" IN THE PART NUMBER IS INTENDED FOR USE WITH LINES 1-4 POWERED FROM EMERGENCY POWER, 5-8 FROM NORMAL POWER.

**INPUT WIRING:**

USE CRESTRON CERTIFIED WIRE SUCH AS CRESNET-NP OR CRESNET-P. TO ENSURE OPTIMUM PERFORMANCE OVER THE FULL RANGE OF YOUR INSTALLATION TOPOLOGY, USE CRESTRON CERTIFIED WIRE. FAILURE TO DO SO MAY INCUR ADDITIONAL CHARGES IF SUPPORT IS REQUIRED TO IDENTIFY PERFORMANCE DEFICIENCIES BECAUSE OF USING IMPROPER WIRE.

SEE DIAGRAM TO THE LEFT FOR WIRING OF REPRESENTATIVE DEVICES.

**TESTING:**

**MANUAL CONTROL**  
LIGHTING LOADS CAN BE MANUALLY CONTROLLED FROM THE FRONT PANEL

**OVERRIDE MODE**  
THE OVERRIDE MODE OVERRIDES THE CONTROL SYSTEM PROGRAM AND SETS ALL OF THE OUTPUT STATES TO THE STORED OVERRIDE VALUES (SEE BELOW)

TO ENABLE OVERRIDE, PRESS AND RELEASE THE 'OVR' BUTTON. THE 'OVR' LED FLASHES SLOWLY

**NOTE:** IF OVERRIDE MODE WAS ENABLED FROM AN EXTERNAL DEVICE (I.E. A CONTACT CLOSURE ON THE 'OVRD' TERMINALS, THE OVR LED WILL FLASH QUICKLY. PRESSING THE OVR BUTTON HAS NO EFFECT.

TO DISABLE OVERRIDE MODE, PRES THE OVR BUTTON AGAIN. THE OVR LED EXTINGUISHES AND THE OUTPUTS RETURN TO THE STATES SET BY THE CONTROL PROGRAM.

**NOTE:** IF OVERRIDE STATES HAVE NOT BEEN STORED, THE FACTORY DEFAULT IS "ALL ON"

**SAVE OVERRIDE SETTINGS**  
THE STATE OF ALL OUTPUTS CAN BE SAVED AS AN OVERRIDE SETTING, WHICH IS AUTOMATICALLY RECALLED BY OVERRIDE MODE

**NOTE:** THE CONTROL SYSTEM PROGRAM CAN BE SET TO PREVENT LOCALLY CHANGING THE OVERRIDE STATE. IF THIS SETTING IS ENABLED, THE DISPLAY WILL SHOW "ERR" WHEN TRYING TO SAVE OVERRIDE STATES.

TO SAVE THE CURRENT STATE OF ALL OUTPUTS AS THE OVERRIDE SETTING, PRESS AND HOLD THE OVR BUTTON FOR 3 SECONDS, UNTIL THE LED BLINKS ONCE.

PART #: GLPAC-DIMFLV8

DESCRIPTION: GLPAC-DIMFLV8

REVISION: 003

DATE: 10/2/2015

NOTES:



15 Volvo Drive  
Rockleigh NJ 07647  
Tel: 888-273-7876  
Fax: 201-767-6011  
www.crestron.com

PART #: GLPAC-DIMFLV8

DRAWING: 2 OF 2



- REVIEWED
- REVIEWED AND MODIFIED
- REVISE AND RESUBMIT
- NOT REVIEWED

The review by JRP Engineering is for the sole purpose of ascertaining conformance with the general design concept. This review shall not mean the detail design inherent in the shop drawings are approved, responsibility of which shall remain with the Contractor submitting same and review shall not relieve the Contractor of this responsibility for errors or omissions in the shop drawings or his responsibility for meeting all requirements of the Contract Documents. The Contractor is responsible for dimensions to be confirmed and correlated at the job site, for information that pertains solely to fabrication processes or to techniques of construction and installation and for co-ordination of the work of all sub-trades.



JRP Engineering

C.McGuire

DATE: MAY 17th, 2017

**\* MODIFICATIONS:**

1. Provide more information on the GLA-PWS50 for contractors.
2. Contractor to coordinate installation on site with reference to slab conduits that are currently installed.
3. If changes are required to the network layout shown in this shop drawing, the changes are to be marked up or drawings updated for the final As-Built submission for this project.
4. Electrical to coordinate with system supplier to ensure a complete and operational system is achieved.
5. Coordinate changes to drawings with contractors comments provided to you on May 9th, 2017.

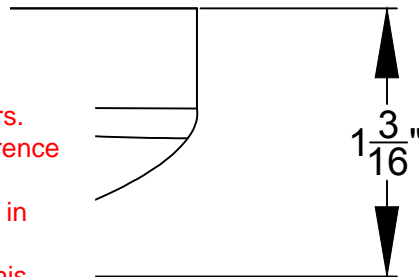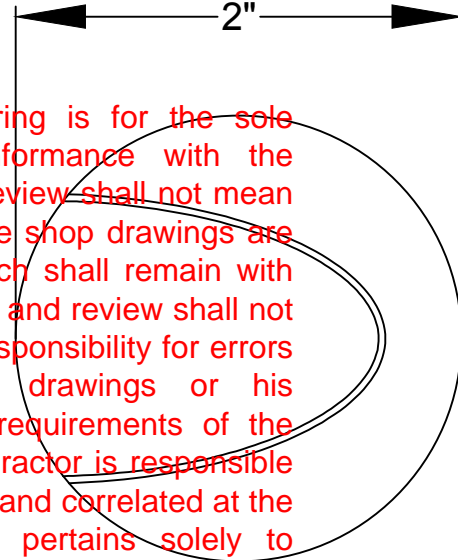

**PHYSICAL DETAILS**

**FEATURES & INSTALLATION ASIS**

AN INSTALLATION GUIDE SHIPS WITH EACH SENSOR. PLEASE SEE THAT DOCUMENT FOR FULL INSTRUCTIONS. THIS SHEET IS INTENDED AS AN OVERVIEW OF CAPABILITIES ONLY.

**DESCRIPTIONS:**

THE **GLS-LOL** IS A PHOTOCELL SENSOR DESIGNED FOR DAYLIGHT HARVESTING APPLICATIONS TO PROVIDE CONTROL OF ROOM LIGHTING BASED ON THE PRESENCE OF NATURAL DAYLIGHT. INTENDED FOR USE WITH AN OPEN-LOOP TYPE SYSTEM, THE **GLS-LOL** CONTINUALLY MONITORS THE AMOUNT OF DAYLIGHT COMING THROUGH A WINDOW OR SKYLIGHT, ALLOWING ROOM LIGHTING TO BE DIMMED OR SWITCHED OFF WHEN THERE IS SUFFICIENT DAYLIGHT AVAILABLE.

THE **GLS-LOL** CAN BE MOUNTED TO A DRYWALL OR DROP-TILE SURFACE. ITS SIMPLE 3-WIRE INTERFACE ALLOWS FOR CONNECTION TO A CRESTRON CONTROL SYSTEM VIA A SINGLE VERSIPORT I/O (AVAILABLE ON **GLS-SIM** INTERFACES, **C2N-CBD-P** "CAMEO" KEYPADS, AS WELL AS CERTAIN PROCESSORS AND OTHER INTERFACE MODULES) OR DIRECT CONNECTION TO **GLPAC-DIMFLV** OR **GLPP** INTEGRATED CONTROL DEVICES.

**GENERAL NOTES & SPECIFICATIONS**

1. **SENSING:**  
 FIELD OF VIEW: 60 DEGREE CONE  
 CENTER OF AXIS: 45 DEGREES FROM MOUNTING SURFACE  
 LIGHT SENSITIVITY: 3 TO 6000 FOOT-CANDLES
2. **CONNECTIONS:**  
 PLUS: (1) CAPTIVE SCREW TERMINAL, +24VDC INPUT  
 MINUS: (1) CAPTIVE SCREW TERMINAL, POWER & CONTROL COMMON  
 ARROW: (1) CAPTIVE SCREW TERMINAL, 0-10VDC CONTROL OUTPUT
3. **CONTROLS: (BEHIND COVER)**  
 LIGHT LEVEL RANGE: JUMPER-SELECTABLE 3-300M 30-3000, OR 60-6000 FC
4. **POWER:**  
 CURRENT CONSUMPTION: 4mA @ 24 VOLTS DC  
 CRESNET POWER USAGE: 1 WATT  
 (CRESNET BUS MAY BE USED REGARDLESS OF INTERFACE METHOD)
5. **HOUSING:**  
 CONSTRUCTION: HIGH-IMPACT INJECTION-MOLDED PLASTIC, WHITE  
 MOUNTING: SURFACE MOUNT TO DRYWALL OR DROP-TILE
6. **DIMENSIONS:**  
 HEIGHT: 1.20 IN. (3.05 cm)  
 DIAMETER: 2.0 IN. (5.08 cm)

PART #: GLS-LOL

DESCRIPTION: OPEN LOOP PHOTOCELL

DATE: 7/20/2012

REVISION: 000


NOTES:



15 Volvo Drive  
 Rockleigh NJ 07647  
 Tel: 888-273-7876  
 Fax: 201-767-6011  
 www.crestron.com

PART #:  
 GLS-LOL  
 OPEN-LOOP  
 PHOTOCELL

DRAWING:  
 1 of 2

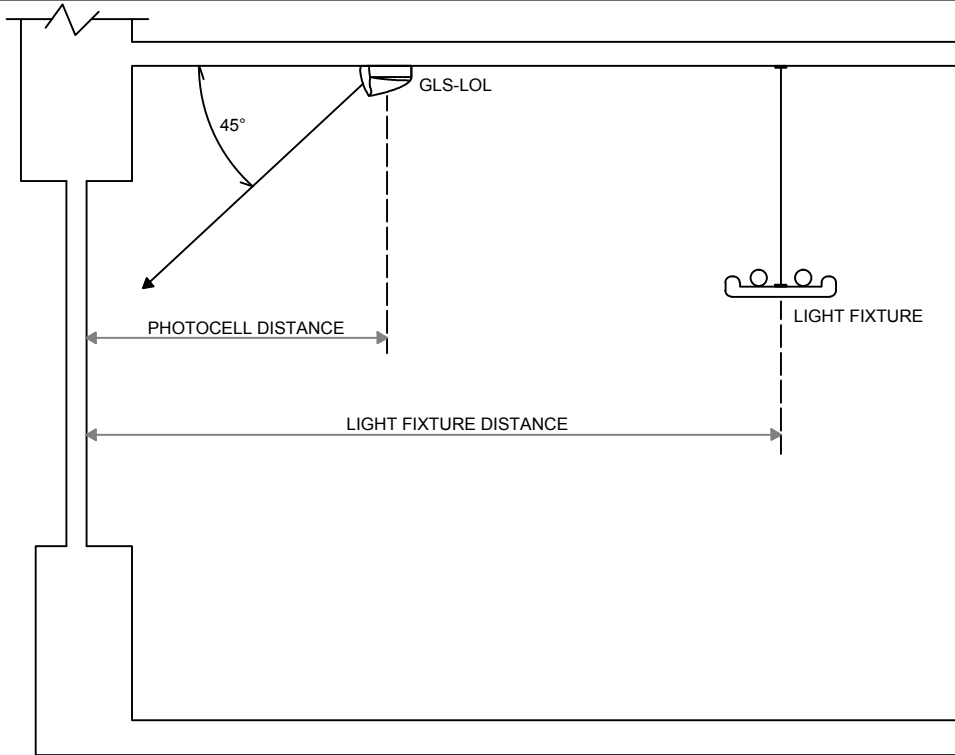


**PHOTOCELL PLACEMENT**

BEFORE INSTALLING THE PHOTOCELL, VERIFY THE DAYLIGHT LEVELS ON A SUNNY DAY AT THE PROPOSED LOCATION OF THE PHOTOCELL. WITH THE LIGHTS SWITCHED OFF, USE A LIGHT METER TO READ THE DAYLIGHT LEVEL. ORIENT THE LIGHT METER IN THE SAME DIRECTION THE PHOTOCELL WILL VIEW. THE LIGHT LEVELS UNDER SUNNY CONDITIONS MUST BE AT LEAST 35FC. IF THE LIGHT LEVELS ARE LESS, YOU SHOULD SELECT ANOTHER LOCATION OR REORIENT THE PHOTOCELL.

THE PHOTOCELL IS DESIGNED FOR MOUNTING IN A DRY LOCATION THAT IS EXPOSED TO DAYLIGHT. THE PHOTOCELL SHOULD NOT BE EXPOSED TO DIRECT ILLUMINATION FROM AN ELECTRIC LIGHT SOURCE.

WHERE WINDOWS ARE THE PRIMARY SOURCE OF DAYLIGHT, THE PHOTOCELL TYPICALLY MOUNTS ON THE CEILING BETWEEN THE WINDOW AND THE FIRST ROW OF FIXTURES. THE PHOTOCELL POINTS TOWARD THE WINDOW AT APPROXIMATELY A 45° ANGLE. FOR THE BEST RESULTS, THE DISTANCE FROM THE PHOTOCELL TO THE WINDOW SHOULD BE ABOUT 1/3 TO 1/2 OF THE DISTANCE FROM THE FIRST LIGHT FIXTURES TO THE WINDOW.

FOR SKYLIGHT APPLICATIONS, THE PHOTOCELL MOUNTS IN THE LIGHTWELL OF THE SKYLIGHT, ORIENTED TOWARD THE INCOMING DAYLIGHT. TYPICALLY, THE PHOTOCELL IS AIMED TOWARD THE SKYLIGHT. THE LIGHT LEVEL RANGE ADJUSTMENT MAY NEED TO BE CHANGED TO 60-6000 FC FOR SKYLIGHT APPLICATIONS.

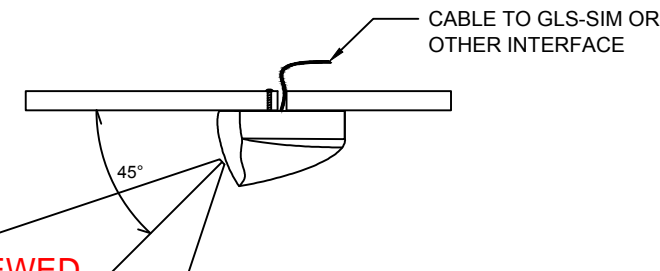


- REVIEWED
- REVIEWED AND MODIFIED
- REVISE AND RESUBMIT
- NOT REVIEWED

The review by JRP Engineering is for the sole purpose of ascertaining conformance with the general design concept. This review shall not mean the detail design inherent in the shop drawings are approved, responsibility of which shall remain with the Contractor submitting same and review shall not relieve the Contractor of this responsibility for errors or omissions in the shop drawings or his responsibility for meeting all requirements of the Contract Documents. The Contractor is responsible for dimensions to be confirmed and correlated at the job site, for information that pertains solely to fabrication processes or to techniques of construction and installation and for co-ordination of the work of all sub-trades.


JRP Engineering  
C.McGuire

DATE: MAY 17th, 2017  
WITH GLS-ODT-C-CN SENSOR

**GLS-LOL PLACEMENT**

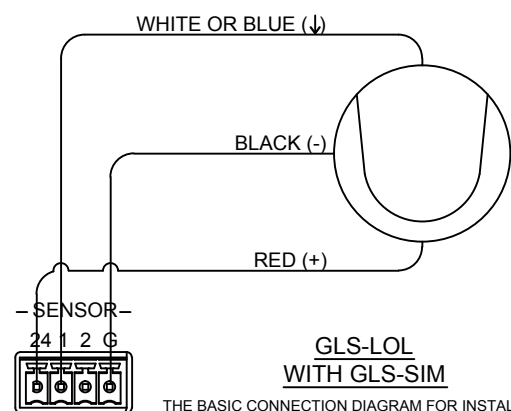

**GLS-LOL WITH GLS-SIM**  
THE BASIC CONNECTION DIAGRAM FOR INSTALLING A GLS-LOL PHOTOCELL WITH A GLS-SIM INTERFACE. SET THE FIRST DIP SWITCH (1 OR 3) FOR THE INPUT "ON" AND THE SECOND DIP SWITCH (2 OR 4) "OFF".

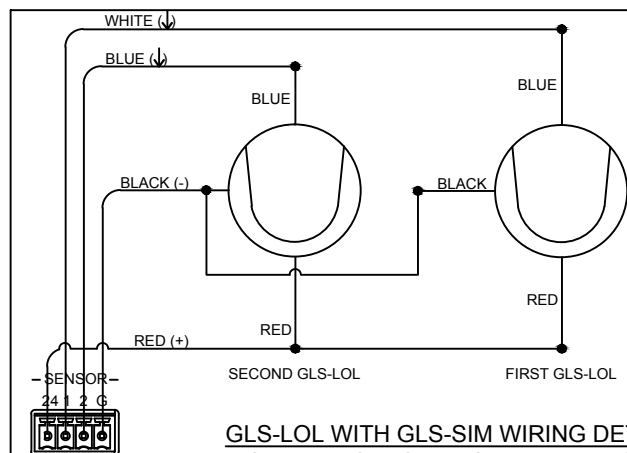


**GLS-LOL WITH GLS-SIM WIRING DETAIL (SHARED CRESNET CABLE METHOD)**


IN THIS EXAMPLE, BOTH GLS-LOL SENSORS ARE CONNECTED TO THE SIM WITH THE SAME CRESNET CABLE, WHICH CONTAINS 4 WIRES. SINCE EACH SENSOR ONLY REQUIRES 3 WIRES THEY MAY USE THE SAME CONDUCTORS FOR POWER (BLACK & RED) WHILE STILL ALLOWING EACH A SEPARATE CONDUCTOR (BLUE OR WHITE) FOR SIGNAL. EACH SENSOR DETECTS DAYLIGHT AND TURNS ON OR OFF ONLY ITS SPECIFIC LIGHTS INDEPENDENT OF THE OTHER SENSOR.

THIS ALLOWS FEWER CABLE RUNS TO SENSORS WITHIN THE SAME PROXIMITY. SPECIAL CARE MUST BE TAKEN WITH THIS METHOD TO INSURE THAT THE TERMINATIONS ARE MADE CORRECTLY OR THE SYSTEM MAY NOT FUNCTION AS DESIRED.

DO NOT CONNECT TWO GLS-LOL SENSORS TO THE SAME INPUT. TWO SENSORS CONNECTED TOGETHER MAY PROVIDE CONFLICTING DATA AND RESULT IN THE SYSTEM NOT OPERATING CORRECTLY.

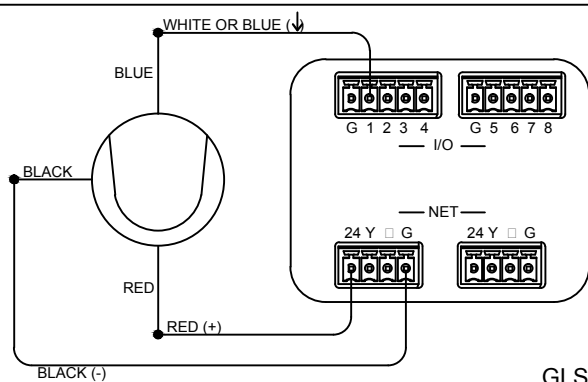

**GLS-LOL WITH OTHER INTERFACES TYPES**  
OTHER INTERFACE TYPES ARE AVAILABLE ON PAC2, DIN-I08, DIN-AP2 AND OTHER DEVICES. ALL FEATURE CONNECTIONS SIMILAR TO THE ONES SHOWN HERE.

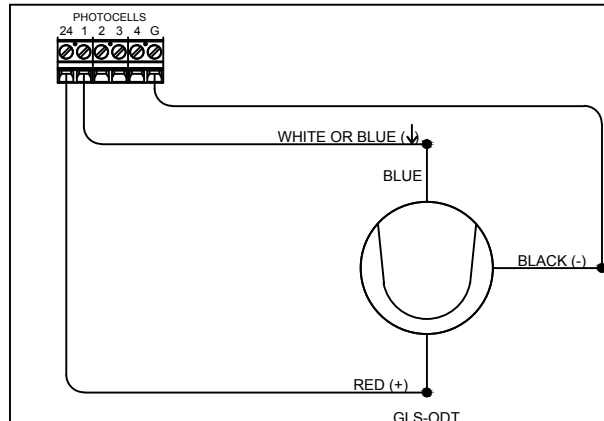

**GLS-LOL WITH GLPAC WIRING DETAIL**

GLPAC PANELS INCLUDE DEDICATED TERMINALS FOR PHOTOCELLS AND OTHER SENSORS. FOUR INDEPENDENT TERMINALS ARE PROVIDED.

ALL 24V AND GROUND TERMINALS ARE CONNECTED IN PARALLEL WITH SIMILAR TERMINALS. SHOULD THERE BE INSUFFICIENT OCCUPANCY SENSOR TERMINALS FOR 24V IT IS ACCEPTABLE TO USE OTHER 24V TERMINALS WITHIN THE SAME GLPAC.

**GLS-LOL WIRING DETAILS**

PART #: GLS-LOL

DESCRIPTION: OPEN LOOP PHOTOCELL

REVISION: 002

DATE: 8/28/2014

NOTES:



15 Volvo Drive  
Rockleigh NJ 07647  
Tel: 888-273-7876  
Fax: 201-767-6011  
www.crestron.com

PART #: GLS-LOL  
OPEN-LOOP PHOTOCELL

DRAWING: 2 of 2



**FEATURES & INSTALLATION BASICS**

AN INSTALLATION GUIDE SHIPS WITH EACH SENSOR. PLEASE SEE THAT DOCUMENT FOR FULL INSTRUCTIONS. THIS SHEET IS INTENDED AS AN OVERVIEW OF CAPABILITIES ONLY.

**MOUNTING OPTIONS:**

1. DROP CEILING MOUNT USING SCREWS (INCLUDED- PREINSTALLED).
2. BACK BOX OR SURFACE MOUNT RACEWAY MOUNTING (BOX/RACEWAY & SCREWS FBO).

CRESTRON RECOMMENDS USING AN OCTAGONAL 4" X 1-1/2" DEEP BACK BOX FOR THESE SENSORS. **IF A SQUARE 1900 BACK BOX IS USED, A 7.0 CUBIC INCH ROUND MUD RING IS REQUIRED.**

A GLS-SIM, IF REQUIRED, MAY MOUNT INSIDE THE SAME BACKBOX GIVEN SUFFICIENT DEPTH.


ALL GLS-ODT-C SENSORS ARE DESIGNED FOR OPTIMAL MOUNTING AT 8'. HEIGHTS OF 8'-12' ARE ACCEPTABLE. SPECIAL-ORDER SENSORS MAY BE ADDED TO AN ORDER FOR AN ADDITIONAL CHARGE ALLOWING MOUNTING HEIGHTS OF UP TO 20'.

SEE INSTALLATION INSTRUCTIONS FOR FULL INFORMATION.


NOTE: BEFORE SECURING SENSOR TO THE CEILING, ROTATE THE DEVICE TO ENSURE THAT IT FACES THE DESIRED DIRECTION. REFER TO THE "DETECTION RANGE" SECTION TO CHOOSE THE BEST ORIENTATION. AVOID AREAS WHERE FALSE TRIPPING MAY OCCUR DUE TO OUTSIDE MOTION SUCH AS AN OPEN DOOR. IDENTIFY AND AVOID AREA OF POSSIBLE VIBRATIONS AND AIR CURRENTS (i.e. PROJECTORS, FANS, VENTS" AND MOUNT THE SENSOR AT LEAST 5 FEET AWAY FROM THESE ITEMS.

NOTE: DEPENDING ON INSTALLATION REQUIREMENTS, THE ULTRASONIC SENSORS CAN BE ENABLED OR DISABLED THROUGH THE IR REMOTE. THE ULTRASONIC SENSORS ARE SPLIT INTO TWO BANKS- A & B- WHICH ARE LABELED UNDER THE COVER OF THE SENSOR. IF THE SENSOR IS ALREADY INSTALLED AND THE ORIENTATION OF THE SENSORS IS UNKNOWN, BANK A IS LOCATED ON THE RED LED SIDE OF THE SENSOR AND BANK B IS LOCATED ON THE GREEN LED SIDE OF THE SENSOR.

MODEL/FEATURE BASICS						
MODEL	DESCRIPTION	CURRENT CONSUMPTION	CRESNET POWER	COVERAGE	IR SENSOR	SUGGESTED LOCATION
GLS-ODT-C-NS	2-WAY DUAL TECH	45mA	1.08w	2000 FT <sup>2</sup> (185.8m <sup>2</sup> )	IR SENSOR FOR GLPP CONTROL	MOUNT IN CENTER OF ROOM/AREA OR MOUNT IN CORNER*

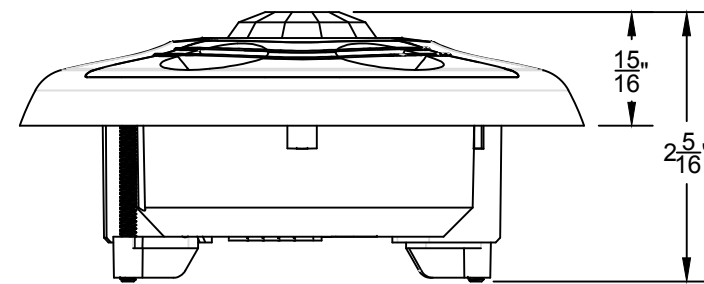

SIDE VIEW

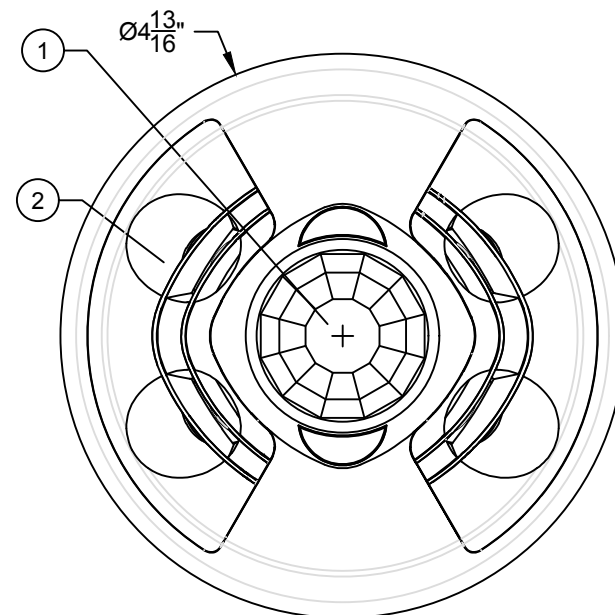

TOP VIEW

PHYSICAL DET

- REVIEWED
- REVIEWED AND MODIFIED
- REVISE AND RESUBMIT
- NOT REVIEWED

The review by JRP Engineering is for the sole purpose of ascertaining conformance with the general design concept. This review shall not mean the detail design inherent in the shop drawings are approved, responsibility of which shall remain with the Contractor submitting same and review shall not relieve the Contractor of this responsibility for errors or omissions in the shop drawings or his responsibility for meeting all requirements of the Contract Documents. The Contractor is responsible for dimensions to be confirmed and correlated at the job site, for information that pertains solely to fabrication processes or to techniques of construction and installation and for co-ordination of the work of all sub-trades.

JRP Engineering  
 C.McGuire  
 DATE: MAY 17th, 2017

**\* MODIFICATIONS:**

1. Provide more info on the GLA-PWS50 for contractors.
2. Contractor to coordinate installation on site with reference to slab conduits that are currently installed.
3. If changes are required to the network layout shown in this shop drawing, the changes are to be marked up or drawings updated for the final As-Built submission for this project.
4. Electrical to coordinate with system supplier to ensure a complete and operational system is achieved.
5. Coordinate changes to drawings with contractors comments provided to you on May 9th, 2017.

GLS-ODT-C-NS DETAILS

**NOTES KEY**

- ① IR SENSOR
- ② ULTRASONIC SENSORS
- ③ 5-PIN CONNECTOR
 

1: +24VDC	24 VDC POWER FROM CONTROLLER (GLPP, GLPAC, GL-IPAC, GLS-SIM)
2: OCC	CONNECTS TO OCCUPANCY SENSOR PORT OF GLPP, GLPAC, GL-IPAC or #1 OR #2 INPUT OF GLS-SIM OR CAMEO KEYPAD
3: N/C	NO CONNECTION
4: GND	CONNECT TO CONTROLLER GROUND
5: IR	CONNECT TO IR PORT ON GLPP FOR PROGRAMMING WITHOUT SEPARATE IR SENSOR

PART #: GLS-ODT-C-NS

DESCRIPTION: DUAL TECHNOLOGY OCCUPANCY SENSOR

REVISION: 001

DATE: 10/20/2015










NOTES:



15 Volvo Drive  
 Rockleigh NJ 07647  
 Tel: 888-273-7876  
 Fax: 201-767-6011  
 www.crestron.com

PART #: GLS-ODT-C-NS  
 OCCUPANCY SENSOR

DRAWING:  
 1 of 2

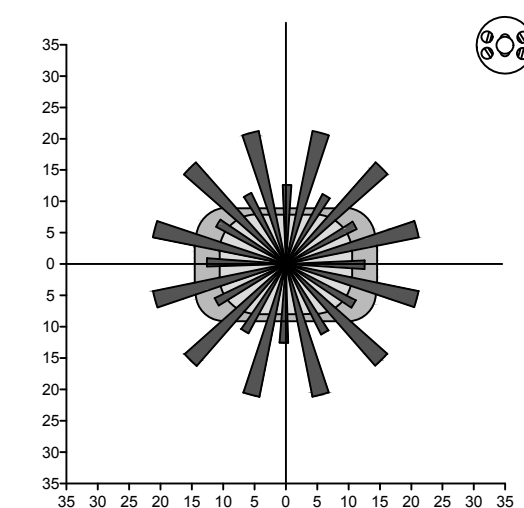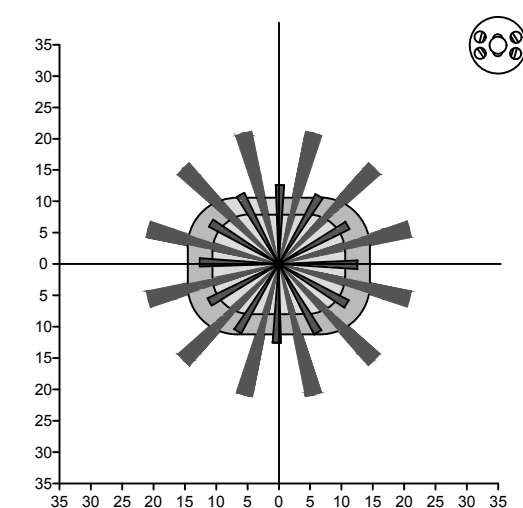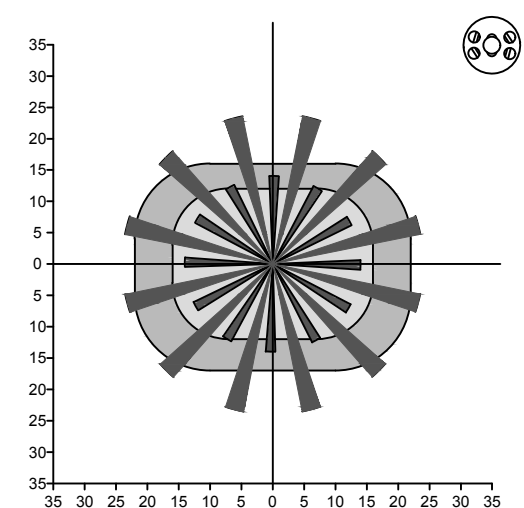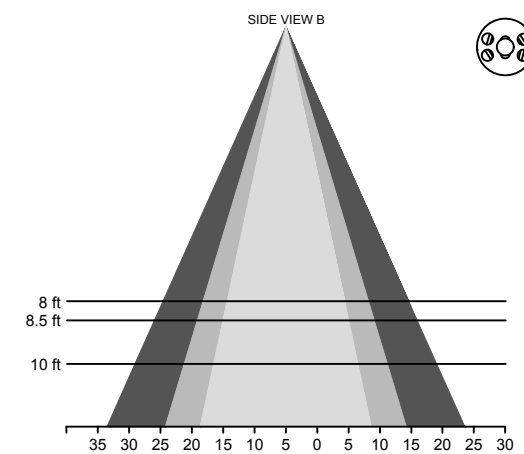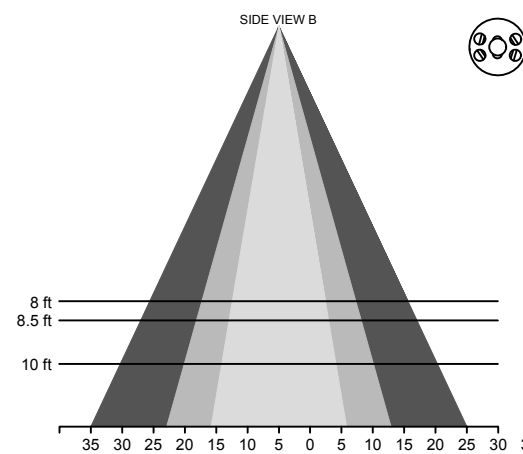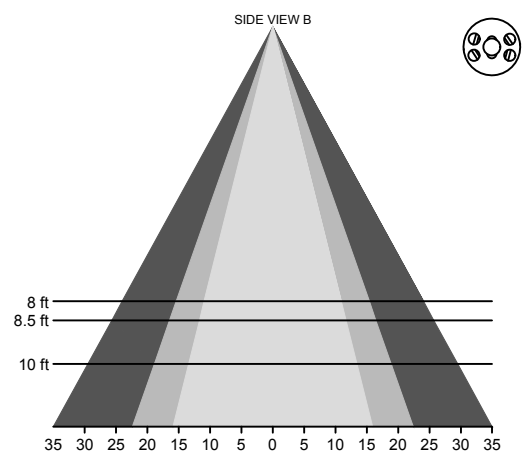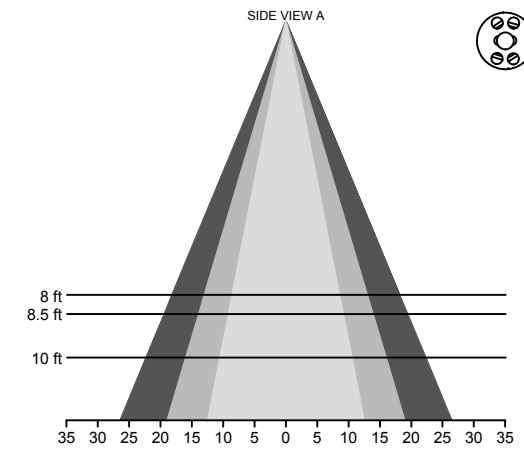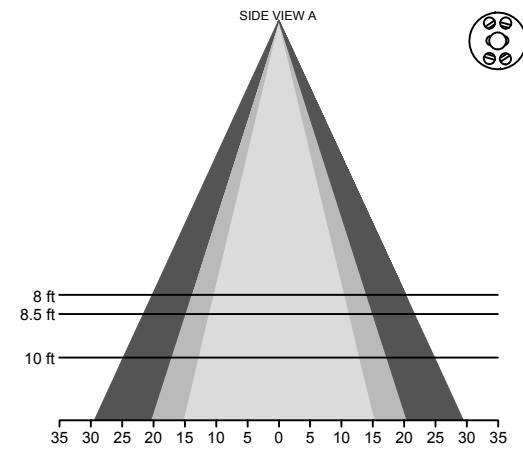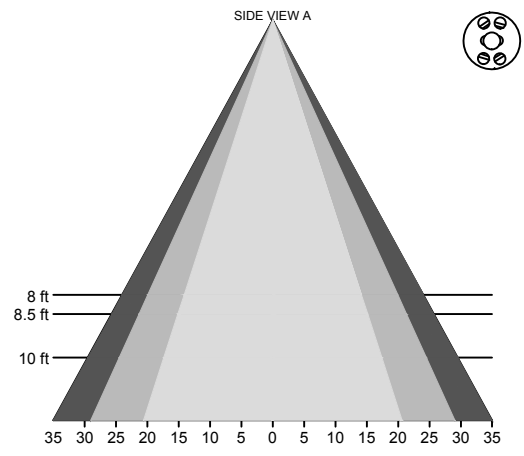

APPROXIMATE COVERAGE  
HIGH SENSITIVITY SETTING

APPROXIMATE COVERAGE  
MEDIUM SENSITIVITY SETTING

APPROXIMATE COVERAGE  
LOW SENSITIVITY SETTING

NOT TO SCALE

**GLS-ODT-C-NS FIELD OF VIEW RANGES**

- REVIEWED
- REVIEWED AND MODIFIED
- REVISE AND RESUBMIT
- NOT REVIEWED

The review by JRP Engineering is for the sole purpose of ascertaining conformance with the general design concept. This review shall not mean the detail design inherent in the shop drawings are approved, responsibility of which shall remain with the Contractor submitting same and review shall not relieve the Contractor of this responsibility for errors or omissions in the shop drawings or his responsibility for meeting all requirements of the Contract Documents. The Contractor is responsible for dimensions to be confirmed and correlated at the job site, for information that pertains solely to fabrication processes or to techniques of construction and installation, and for co-ordination of the work of all sub-trades.

**JRP Engineering**

**TWO POSSIBLE MOUNTING & MASKING OPTIONS:**

THE BOTTOM TWO MOUNTING AREAS IN A CORRIDOR. IT IS UNDESIRABLE FOR CORRIDOR TRAFFIC TO TURN ON THE LIGHTS IN THE CONFERENCE ROOM ON THE LEFT. OCCUPANCY SENSOR IS MOUNTED IN A CORNER WITH ONE ULTRASONIC SENSOR BANK TURNED OFF, COVERING THE ROOM BUT NOT THE CORRIDOR. IN THE ROOM ON THE RIGHT, A SENSOR IS LOCATED OVER THE CENTER OF THE ROOM. THIS SENSOR HAS A MASK INSTALLED WHICH PREVENTS THE SENSOR FROM SEEING CORRIDOR TRAFFIC WHILE STILL COVERING MOST OF THE ROOM.

C.McGuire IS SUPPLIED WITH ONE MASK, PERFORATED IN 32° INCREMENTS THAT CAN BE PLACED OR REMOVED TO MASK OR REVEAL CERTAIN AREAS, AND ONE SOLID HALF-MASK.

**DATE: MAY 17th, 2017**

- \* MODIFICATIONS:**
1. Provide more info on the GLA-PWS50 for contractors.
  2. Contractor to coordinate installation on site with reference to slab conduits that are currently installed.
  3. If changes are required to the network layout shown in this shop drawing, the changes are to be marked up or drawings updated for the final As-Built submission for this project.
  4. Electrical to coordinate with system supplier to ensure a complete and operational system is achieved.
  5. Coordinate changes to drawings with contractors comments provided to you on May 9th, 2017.

PART #: GLS-ODT-C-NS	DESCRIPTION: DUAL TECH OCCUPANCY SENSOR	DATE: 7/17/2014
	REVISION: 000	NOTES:


**CRESTRON**

15 Volvo Drive  
Rockleigh NJ 07647  
Tel: 888-273-7876  
Fax: 201-767-6011  
www.crestron.com

PART #:  
GLS-ODT-C-NS  
OCCUPANCY SENSOR

**FEATURES & INSTALLATION ASIS**

AN INSTALLATION GUIDE SHIPS WITH EACH SENSOR. PLEASE SEE THAT DOCUMENT FOR FULL INSTRUCTIONS. THIS SHEET IS INTENDED AS AN OVERVIEW OF CAPABILITIES ONLY.

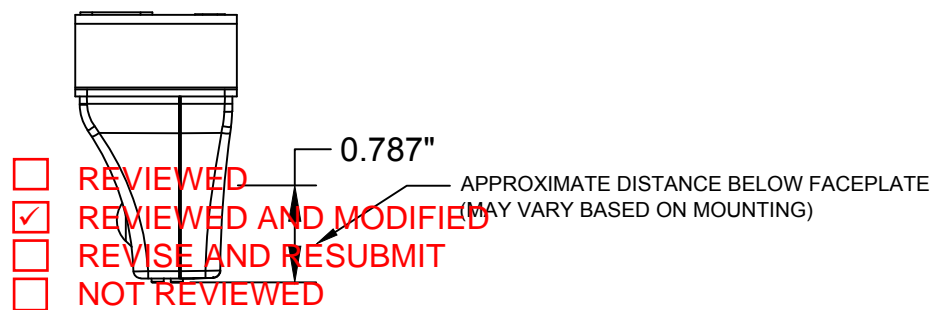

- REVIEWED
- REVIEWED AND MODIFIED
- REVISE AND RESUBMIT
- NOT REVIEWED

**SIDE VIEW**


The review by JRP Engineering is for the sole purpose of ascertaining conformance with the general design concept. This review shall not mean the detail design inherent in the shop drawings are approved, responsibility of which shall remain with the Contractor submitting same and review shall not relieve the Contractor of this responsibility for errors or omissions in the shop drawings or his responsibility for meeting all requirements of the Contract Documents. The Contractor is responsible for dimensions to be confirmed and correlated at the job site for information that pertains solely to fabrication processes or to techniques of construction and installation and for co-ordination of the work of all sub-trades.

JRP Engineering  
C.McGuire


DATE: MAY 17th, 2017

**\* MODIFICATIONS:**

1. Provide more information on the GLA-PWS50 for contractors.
2. Contractor to coordinate installation on site with reference to slab conduits that are currently installed.
3. If changes are required to the network layout shown in this shop drawing, the changes are to be marked up or drawings updated for the final As-Built submission for this project.
4. Electrical to coordinate with system supplier to ensure a complete and operational system is achieved.
5. Coordinate changes to drawings with contractors comments provided to you on May 9th, 2017.

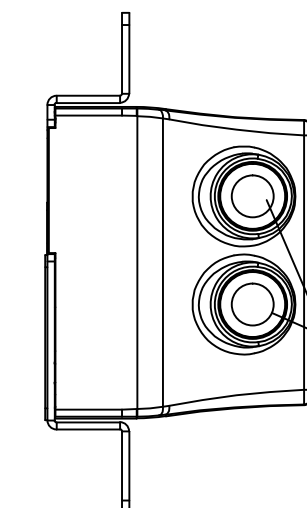

**SENSING SIDE VIEW**

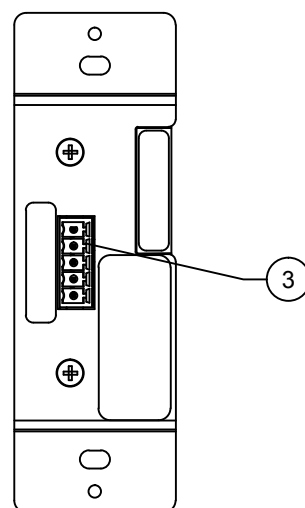

**REAR VIEW**

**DEVICE OVERVIEW:**

THE GLS-PART-CN IS A SURFACE-MOUNT PARTITION SENSOR THAT UTILIZES THE CRESNET WIRED NETWORK FOR POWER & COMMUNICATIONS. THE SENSOR USES AN INFRARED BEAM TO SENSE THE POSITION OF MOVEABLE PARTITIONS WITHIN A SPACE. THE IR BEAM'S SIGNAL STRENGTH IS ADJUSTABLE AND FEATURES A SENSING DISTANCE OF UP TO FOUR FEET. THREE LEDS ON THE UNIT PROVIDE AT-A-GLANCE INFORMATION ON THE SENSOR'S STATE OF POWER, COMMUNICATIONS, AND PARTITION DETECTION. THE GLS-PART-CN OFFERS MOUNTING OPTIONS FOR ROOMS WITH FINISHED OR DROP TILE CEILINGS.

THE GLS-PART-CN HAS A WHITE FINISH AND CAN MOUNT DIRECTLY INTO FINISHED CEILINGS. FOR DROP TILE CEILINGS, THE UNIT INSTALLS INTO A 1-GANG 3 1/2" DEEP ELECTRICAL BOX. A DECORATOR (DECORA) FACEPLATE CAN BE USED TO MATCH THE UNIT WITH THE COLOR OF THE ROOM. ONLY ABOUT 20mm (.75") OF THE UNIT IS VISIBLE AFTER INSTALLATION.

THE GLS-PART-CN USES A 5-PIN VERSION OF THE CRESNET CONNECTOR. THE FIFTH PIN PROVIDES EITHER A 24 VOLT 10mA OUTPUT OR A CLOSURE TO GROUND, ALLOWING CONNECTION TO A VERSIPOINT OR DIGITAL INPUT PORT.

**SENSING:**  
**METHOD OF DETECTION:** DIFFUSE REFLECTIVE  
**LIGHT SOURCE:** PULSE MODULATED LED  
**IR SENSITIVITY:** ADJUSTABLE  
**SENSING DISTANCE:** 4 FEET (122cm)

**CONNECTORS:**  
**NET/EXT:** (1) 5-PIN 3.5mm DETACHABLE TERMINAL BLOCK  
 CRESNET AND DIGITAL OUTPUT  
 DIGITAL OUTPUT IS EITHER 24VDC 10mA (DEFAULT) OR CLOSURE TO GROUND

**CONTROLS & INDICATORS:**  
**PWR:** (1) GREEN LED, INDICATES POWER IS SUPPLIED TO DEVICE; FLASHES TO INDICATE SENSITIVITY LEVEL  
**NET:** (1) YELLOW LED, INDICATED CRESNET COMMUNICATION STATUS  
**ALIGN:** (1) RED LED, INDICATES PARTITION DETECTION  
**+:** (1) PUSHBUTTON, USED TO INCREASE SENSITIVITY OF IR OR FOR TOUCH ID  
**-:** (1) PUSHBUTTON, USED TO DECREASE SENSITIVITY OF IR OR FOR TOUCH ID

**POWER REQUIREMENTS:**  
**CURRENT CONSUMPTION:** 42mA @ 24 VOLTS DC  
**CRESNET POWER USAGE:** 1 WATT

**ENVIRONMENTAL:**  
**TEMPERATURE:** -13° TO 131° F (-25° TO 55° C)

**NOTES KEY**

- ① SENSING WINDOWS
- ② INDICATOR LEDS (3)
- ③ CRESNET & EXTERNAL SIGNAL CONNECTOR  
 24: +24VDC (CRESNET RED)  
 Y: CRESNET Y (CRESNET WHITE)  
 □: CRESNET □ (CRESNET BLUE)  
 G: GROUND (CRESNET BLACK)  
 EXT: EXTERNAL SIGNAL OUTPUT

**GLS-PART-CN DETAILS**

PART #: GLS-PART-CN

DESCRIPTION: CRESNET PARTITION SENSOR PHYSICAL & WIRING

DATE: 6/1/2015

REVISION: 000

NOTES:



15 Volvo Drive  
 Rockleigh NJ 07647  
 Tel: 888-273-7876  
 Fax: 201-767-6011  
 www.crestron.com

PART #:  
 GLS-PART-CN

DRAWING:  
 1 OF 1

- REVIEWED
- REVIEWED AND MODIFIED
- REVISE AND RESUBMIT
- NOT REVIEWED


The review by JRP Engineering is for the sole purpose of ascertaining conformance with the general design concept. This review shall not mean the detail design inherent in the shop drawings are approved, responsibility of which shall remain with the Contractor submitting same and review shall not relieve the Contractor of his responsibility for errors or omissions in the shop drawings or his responsibility for meeting all requirements of the Contract Documents. The Contractor is responsible for dimensions to be confirmed and correlated at the job site, for information that pertains solely to fabrication processes or to techniques of construction and installation and for co-ordination of the work of all sub-trades.

JRP Engineering  
C. McGuire




DATE: MAY 17th, 2017

**\* MODIFICATIONS:**

1. Provide more information on the GLA-PWS50 for contractors.
2. Contractor to coordinate installation on site with reference to slab conduits that are currently installed.
3. If changes are required to the network layout shown in this shop drawing, the changes are to be marked up or drawings updated for the final As-Built submission for this project.
4. Electrical to coordinate with system supplier to ensure a complete and operational system is achieved.
5. Coordinate changes to drawings with contractor comments provided to you on May 9th, 2017.

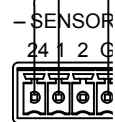

**GLS-LOL WIRING DETAIL**

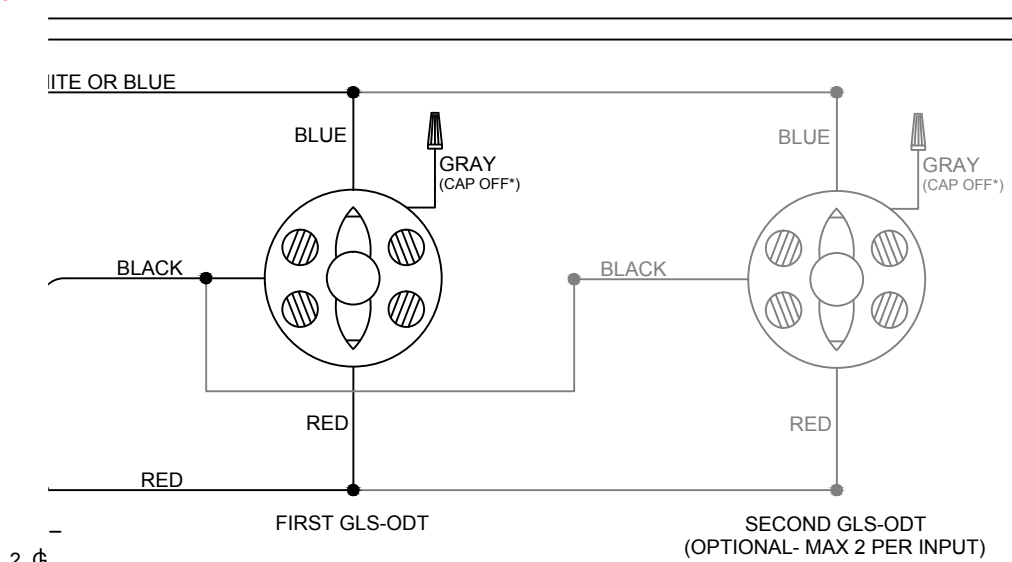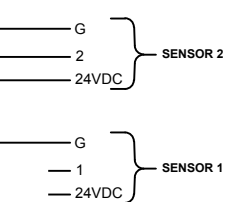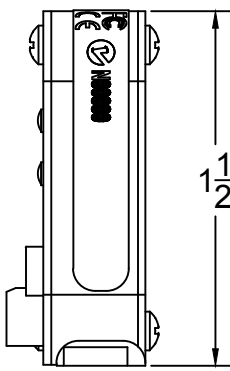


**GLS-ODT (ALL TYPES) WIRING DETAIL**

\*GRAY WIRE MAY BE CONNECTED INSTEAD OF BLUE WIRE IF USE OF INTERNAL PHOTOSENSOR IS DESIRED. PHOTOSENSOR IS NOT NORMALLY UTILIZED

**SENSOR WIRING DETAILS**

GLS-LOL CONNECTIONS ARE VIA SCREW TERMINALS WITHIN DEVICE. GLS-ODT CONNECTIONS ARE VIA FLYING LEADS. SEE INSTRUCTION SHEETS PROVIDED IN SENSOR PACKAGE FOR FULL INFORMATION.

**RESNET CONTROL WIRING**

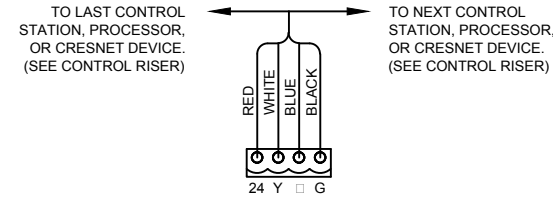

**RESSIN OR SYSTEMS WITH A PROCESSOR**

PROJECT RISERS SHOULD SHOW AN ADDRESS FOR EACH GLS-SIM SUCH AS "SIM-03" OR "SIM-AD". PLEASE SET THAT ADDRESS VIA THE TWO ROTARY DIP SWITCHES (NOTE 1 THIS SHEET). SYSTEMS WITH MULTIPLE PROCESSORS MAY SHOW DUPLICATE ADDRESSES.

ADDRESSES 00, 01, AND 02 HAVE PRESET FUNCTIONS. 03 IS THE FIRST VALID ADDRESS FOR SYSTEMS WITH A CENTRAL PROCESSOR.

**WIRING & ADDRESSING OR STAN ALONE ILLUM SYSTEMS**

ILLUM (CLS-C6) SYSTEMS WITHOUT A PROCESSOR HAVE SPECIFIC REQUIREMENTS FOR GLS-SIM ADDRESSING & WIRING.

- GLS-SIM MUST BE SET TO ADDRESS "C0" OR "C1" FOR OCCUPANCY & PHOTO SENSING.
- OCCUPANCY SENSORS MAY ONLY CONNECT TO INPUT #1
- PHOTO SENSORS MAY ONLY CONNECT TO INPUT #2
- PARTITION SENSORS MAY ONLY CONNECT TO INPUT #1.
- ADDRESSES FOR PARTITION SENSORS START AT "0", BUT ADDRESS MUST BE SET PER A CHART ON THE GLS-PART DETAIL SHEET. PLEASE CONTACT YOUR PROJECT ENGINEER TO CONFIRM THE ADDRESS REQUIRED FOR THIS PROJECT IF IT HAS NOT BEEN SUPPLIED ON THE PROJECT RISER DRAWING.

**NOTES KEY**

- 1 (2) ROTARY DIP SWITCHES USED FOR MANUALLY SETTING THE CRESNET ID. 00 SETTING ENABLES TOUCH-SETTABLE ID.
  - 2 (1) 4-POSITION DIP SWITCH SETS SENSOR TYPE AND OPERATING MODE. SEE CHART BELOW FOR SETTINGS.
  - 3 (1) MINIATURE PUSHBUTTON, USED FOR TOUCH SETTABLE ID.
  - 4 **PWR:** (1) GREEN LED, ILLUMINATES WHEN DC POWER IS APPLIED TO THE NET PORT  
**NET:** (1) YELLOW LED, INDICATES COMMUNICATION WITH CONTROL PROCESSOR
  - 5 CRESNET NETWORK CONNECTOR TO CONTROL PROCESSOR OR ADDITIONAL MODULES. FACTORY BUILT CABINETS WILL HAVE CRESNET CONNECTIONS WIRED IN FACTORY.
  - 6 (1) 4-PIN 3.5MM DETACHABLE TERMINAL BLOCK SENSOR INPUT COMPRISED OF 24VDC POWER OUTPUT AND
- DIGITAL INPUT: RATED FOR 0-24 VOLTS DC, INPUT IMPEDANCE 20 OHMS, LOGIC THRESHOLD 1.25 VOLTS DC
- ANALOG INPUT: RATED FOR 0-10 VOLTS DC, PROTECTED TO 24 VOLTS DC MAXIMUM, INPUT IMPEDANCE 20 OHMS PROGRAMMABLE 5 VOLTS, 2 OHMS PULL-UP RESISTOR PER PIN  
MAXIMUM POWER LOAD: 1 AMP @ 24 VOLTS DC.

**DIP SWITCH SETTINGS**

SENSOR INPUT	DIP SWITCH	GLS-PART PARTITION SENSOR	GLS-PART-CN PARTITION SENSOR	OCCUPANCY SENSOR	PHOTOCELL
1	1	OFF	ON	ON	ON
	2	OFF	ON	ON	OFF
2	3	OFF	ON	ON	ON
	4	OFF	ON	ON	OFF

PLEASE NOTE THE DIFFERENCE BETWEEN SETTINGS FOR USE WITH OLDER GLS-PART PARTITION SENSORS AND NEWER GLS-PART-CN PARTITION SENSORS. A GLS-SIM MAY BE REQUIRED FOR USING THESE SENSORS WITH CERTAIN FIRMWARE VERSIONS. CONSULT YOUR PROJECT ENGINEER WITH ANY QUESTIONS.

SWITCH SETTINGS ARE SHOWN FOR TYPICAL CRESTRON-PROVIDED DEVICES. NON-CRESTRON DEVICES MAY NOT USE THESE SETTINGS. ALTERNATE MODES ARE AVAILABLE SEE GLS-SIM INSTALLATION & OPERATION GUIDE FOR FULL DETAILS.

NOTE THAT IF NON-CRESTRON DEVICES ARE BEING USED, CRESTRON REQUIRES THE FOLLOWING INFORMATION PRIOR TO SHIPPING EQUIPMENT:

A COMPLETE ANNOTATED GROUND PLAN INDICATING EACH DEVICE, TO WHICH GLS-SIM IT IS TO CONNECT (REFERENCED BY THE DEVICE ID SHOWN ON PROJECT RISER DIAGRAMS), AND WHAT TYPE OF INPUT IS REQUIRED- CONTACT CLOSURE, 0-10V SENSING, OR CRESTRON DIGITAL LOGIC. FAILURE TO PROVIDE THIS INFORMATION WILL RESULT IN ADDITIONAL CHARGES FOR ONSITE REPROGRAMMING OF THE DEVICE CONFIGURATIONS.



PART #: GLS-SIM

DESCRIPTION: SENSOR INTEGRATION MODULE WITH WIRING DETAILS

DATE: 10/2015

REVISION: 005

NOTES: UPDATED FOR GLS-PART-CN



15 Volvo Drive  
Rockleigh NJ 07647  
Tel: 888-273-7876  
Fax: 201-767-6011  
www.crestron.com

PART #:  
GLS-SIM WITH  
SENSOR WIRING  
DRAWING:

- REVIEWED
- REVIEWED AND MODIFIED
- REVISE AND RESUBMIT
- NOT REVIEWED





The review by JRP Engineering is for the sole purpose of ascertaining conformance with the general design concept. This review shall not mean the detail design inherent in the shop drawings are approved, responsibility of which shall remain with the Contractor submitting same and review shall not relieve the Contractor of this responsibility for errors or omissions in the shop drawings or his responsibility for meeting all requirements of the Contract Documents. The Contractor is responsible for dimensions to be confirmed and correlated at the job site, for information that pertains solely to fabrication processes or to techniques of construction and installation and for co-ordination of the work of all sub-trades.

JRP Engineering  
C.McGuire

DATE: MAY 17th, 2017

**\* MODIFICATIONS:**

1. Provide more info on the GLA-PWS50 for contractors.
2. Contractor to coordinate installation on site with reference to slab conduits that are currently installed.
3. If changes are required to the network layout shown in this shop drawing, the changes are to be marked up or drawings updated for the final As-Built submission for this project.
4. Electrical to coordinate with system supplier to ensure a complete and operational system is achieved.
5. Coordinate changes to drawings with contractors comments provided to you on May 9th, 2017.

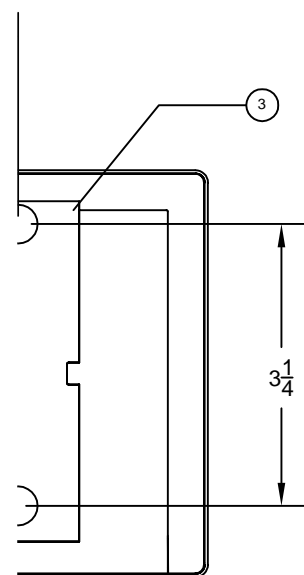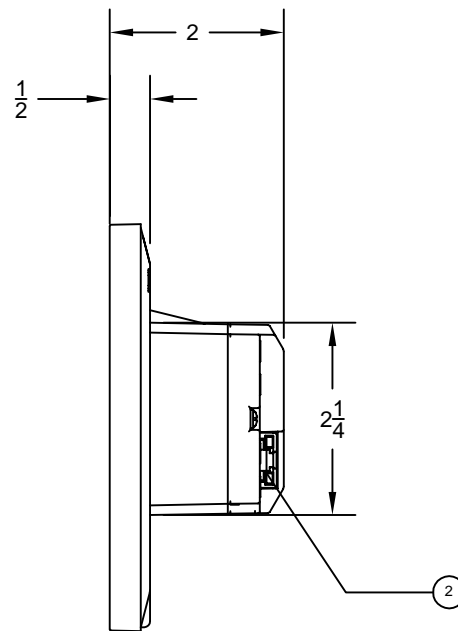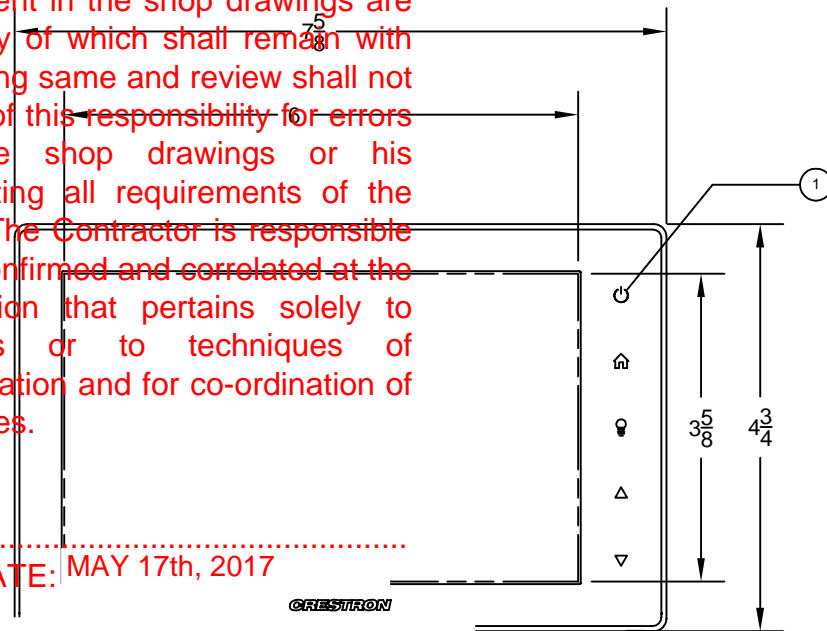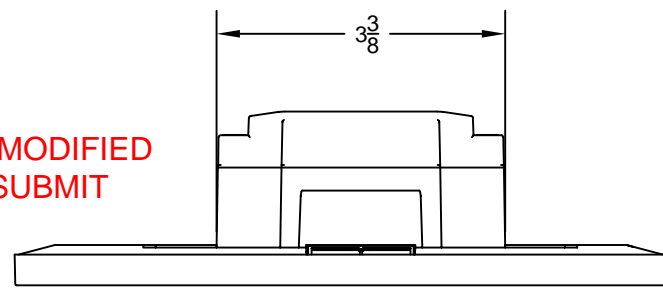

**TSW-750 7" TOUCH SCREEN**

**NOTES KEY**

1. **HARD KEYS:** (5) PROJECTED CAPACITIVE PUSHBUTTONS, PROGRAMMABLE, PRE-LABELED WITH ICONS FOR "POWER", "HOME", "LIGHTS", "UP", AND "DOWN"
- RESET: (1) MINIATURE PUSHBUTTON ON REAR PANEL FOR HARDWARE RESET. (NOT SHOWN)
2. **LAN POE PORT:** (1) 8-WIRE RJ-45 WITH TWO LED INDICATORS; 10BASE-T/100BASE-TX ETHERNET PORT.

802.3AF POWER OVER ETHERNET COMPLIANT (CLASS 3: 6.49-12.95w);


GREEN LED INDICATES LINK STATUS;  
YELLOW LED INDICATES ETHERNET ACTIVITY

PIN	SIGNAL	PIN	SIGNAL
1	TX+	5	N/C
2	TX-	6	RC-
3	RC+	7	N/C
4	N/C	8	N/C

3. **MOUNTING:** MAGNETICALLY ATTACHES OVER 2-GANG OR 3-GANG US OR 2-GANG EUROPEAN ELECTRICAL BOX. MAY ALSO ATTACH DIRECTLY TO DRYWALL OR OTHER SURFACES OVER THE FRONT OF A 2-3/8"H x 3-3/8"W CUTOUT. PROTRUDES 1/2" FROM THE MOUNTING SURFACE. MAGNETIC ATTACHMENT ELIMINATES ANY VISIBLE SCREWS.

**GENERAL NOTES & SPECIFICATIONS**

1. REFER TO SPECIFICATION SHEETS AND INSTALL & OPERATIONS MANUAL FOR FURTHER INFORMATION.
2. **TOUCH SCREEN DISPLAY:**  
DISPLAY TYPE: TFT ACTIVE MATRIX COLOR LCD  
SIZE: 7" (178mm) DIAGONAL  
ASPECT RATIO: 15:9 WVGA  
RESOLUTION: 800x480 PIXELS  
BRIGHTNESS: 300 NITS (CD/M<sup>2</sup>) TYPICAL  
CONTRAST: 350:1 TYPICAL  
COLOR DEPTH: 18-BIT, 262K COLORS  
ILLUMINATION: EDGELIT LED, AUTO-BRIGHTNESS  
VIEWING ANGLE: +/- 70° HORIZONTAL, +65° VERTICAL  
TOUCH SCREEN: PROJECTED CAPACITIVE
3. **MEMORY:**  
DDR RAM: 1GB  
FLASH: 4GB  
MAXIMUM PROJECT SIZE: 512MB
4. **GRAPHIC ENGINE:** CORE 3 UI
5. **COMMUNICATIONS:** ETHERNET 10/100 Mbps, AUTO-SWITCHING, AUTO-NEGOTIATING, AUTO DISCOVERY, FULL/HALF DUPLEX, DHCP, IEEE 802.3af COMPLIANT.
6. **POWER:** IEEE 802.3af CLASS 3 POWER OVER ETHERNET DEVICE
7. **ENVIRONMENTAL:**  
TEMPERATURE: 32° TO 112°F (0° TO 45°C)  
HUMIDITY: 10% TO 90% RH (NON-CONDENSING)  
HEAT DISSIPATION: 44 BTU/HR
8. **PHYSICAL:**  
CONSTRUCTION: PLASTIC  
WEIGHT: 14.1 oz (400g)
9. **COLORS:** AVAILABLE IN BLACK OR WHITE, SMOOTH

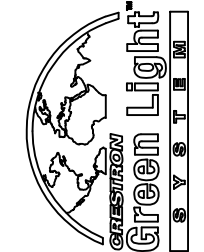

PART #: TSW-750

DESCRIPTION: 7" SURFACE MOUNT TOUCH SCREEN

DATE: 7/20/2012

REVISION: 000

NOTES:



15 Volvo Drive  
Rockleigh NJ 07647  
Tel: 888-273-7876  
Fax: 201-767-6011  
www.crestron.com

PART #: TSW-750

DRAWING: 1 OF 1



1 GROUND FLOOR – R.C.P  
E101 SCALE 1:100

- REVIEWED
- REVIEWED AND MODIFIED
- REVISE AND RESUBMIT
- NOT REVIEWED

The review by JRP Engineering is for the sole purpose of ascertaining conformance with the general design concept. This review shall not mean the detail design inherent in the shop drawings are approved, responsibility of which shall remain with the Contractor submitting same and review shall not relieve the Contractor of this responsibility for errors or omissions in the shop drawings or his responsibility for meeting all requirements of the Contract Documents. The Contractor is responsible for dimensions to be confirmed and correlated at the job site, for information that pertains solely to fabrication processes or to techniques of construction and installation and for co-ordination of the work of all sub-trades.  
JRP Engineering  
C.McGuire

DATE: MAY 17th, 2017

- \* MODIFICATIONS:
1. Provide more info on the GLA-PWS50 for contractors.
  2. Contractor to coordinate installation on site with reference to slab conduits that are currently installed.
  3. If changes are required to the network layout shown in this shop-drawing, the changes are to be marked up or drawings updated for the final As-Built submission for this project.
  4. Electrical to coordinate with system supplier to ensure a complete and operational system is achieved.
  5. Coordinate changes to drawings with contractors comments provided to you on May 9th, 2017.

\*\*\*DRAWING IS NOT TO SCALE AND SCHEMATIC IN NATURE.\*\*\*

- ETHERNET
- CRESNET

**DRAWING NOTES:**

- ◇ PROVIDE SIDE LIT LED EXIT SIGN C/W DIRECTIONAL ARROW AS INDICATED, ALL ASSOCIATED HARDWARE. EXIT SIGN TO BE TIED INTO EMERGENCY LIGHTING CIRCUIT.
- ◇ LIGHT FIXTURE TO BE TIED INTO EMERGENCY LIGHTING CIRCUIT AND REMAIN UNSWITCHED AT ALL TIMES.
- ◇ PROVIDE LIGHTING FIXTURE, ALL CONDUIT, WIRING AND ASSOCIATED HARDWARE.
- ◇ FIRE ALARM PANEL, REFER TO RISER DIAGRAM FOR FURTHER DETAILS.
- ◇ PROVIDE FIRE ALARM DEVICE AS INDICATED C/W ALL CONDUIT, WIRING AND ASSOCIATED HARDWARE.
- ◇ LIGHTING TO BE CONTROLLED BY BAS BUILDING AUTOMATION SYSTEM.
- ◇ LOW VOLTAGE LIGHTING CONTROL PANEL, TO BE MOUNTED AS HIGH AS POSSIBLE. LOCATION TO BE DETERMINED ON-SITE.



- |                            |                    |
|----------------------------|--------------------|
| ◆ TOUCH SCREEN             | ■ GLPP-1 DIMMING   |
| ◆ KEYPAD                   | ■ GLPP-2 DIMMING   |
| ◆ WIRELESS KEYPAD          | ■ GLPP-3 DIMMING   |
| ◆ WIRELESS DIMMER          | ■ GLPP-1 SWITCHING |
| ◆ GLPP KEYPAD              | ■ GLPP-2 SWITCHING |
| ◆ TIMER SWITCHES           | ■ GLPP-3 SWITCHING |
| ◆ WALL OCC SENSOR SWITCH   | ■ GLPAC-4          |
| ◆ DT OCC SENSOR CN         | ■ GLPAC-8          |
| ◆ DT OCC SENSOR NS         | ■ CLS-C6 (ILUX)    |
| ◆ PIR OCC SENSORS          | ■ CLS-EXP-DIM      |
| ◆ HIGH BAY OCC SENSORS     | ■ CLS-EXP-DIMLU    |
| ◆ WIRELESS OCC SENSORS     | ■ CLS-EXP-DIMFLV   |
| ◆ DT WALL OCC SENSORS      | ■ CLS-EXP-DIMFDB   |
| ◆ PIR WALL OCC SENSORS     | ■ C2N-IO           |
| ◆ EXT PHOTO SENSOR         | ■ C2N-SDC          |
| ◆ PHOTO SENSOR             | ■ SIM              |
| ◆ CLOSED LOOP PHOTO SENSOR | ■ WIRELESS GATEWAY |
| ◆ WIRELESS PHOTO SENSOR    | ■ COUNTER          |
| ◆ PARTITION SENSOR         | ■ 0-10V            |
| ◆ ESR                      | ■ ELV              |
| ■ GLA-EPC-1D               | ■ 2WIRE            |
|                            | ■ 3WIRE            |
|                            | ■ DMX              |
|                            | ■ SHADES           |
|                            | ■ MLV              |
|                            | ■ DALI             |
|                            | ■ EM               |

**JRP ENGINEERING**  
Professional Engineers

9 Holgate Cr. Kanata, Ontario, K2K 1B4  
Tel: (613) 827-2462 Email: Admin@jrpeng.com

An exact copy of all working documents including, without limitation, the original of the present document or plan is kept on file by J.R.P. Engineering. Any modification carried out to this document or plan or to accompanying documents without written authorization by the engineer is prohibited.

Authorized modifications must be signed and sealed by an engineer and this engineer will be completely responsible for these modifications. J.R.P. Engineering is not and will not be responsible for the consequences of these modifications or for modifications carried out without its consent.

No	DESCRIPTION	DATE
1	ISSUED FOR PRICING	AUG 29 2016
0	ISSUED FOR PERMIT	AUG 5 2016

**REVISIONS**

No	DESCRIPTION	DATE


client:  
**TOMLINSON**  
5597 POWER RD  
OTTAWA, ON  
K1G 3N4

project:  
**TOMLINSON**  
NEW BUILDING  
CITIGATE, OTTAWA


drawing title:  
**R.C.P**  
GROUND FLOOR

scale:	AS SHOWN	drawn by:	M.G
designed by:	M.G	reviewed by:	J.R.P.
approved by:	J.R.P.	date:	APR 2016

project no.:	100-16L	drawing no.:	E-101
revision:	0		

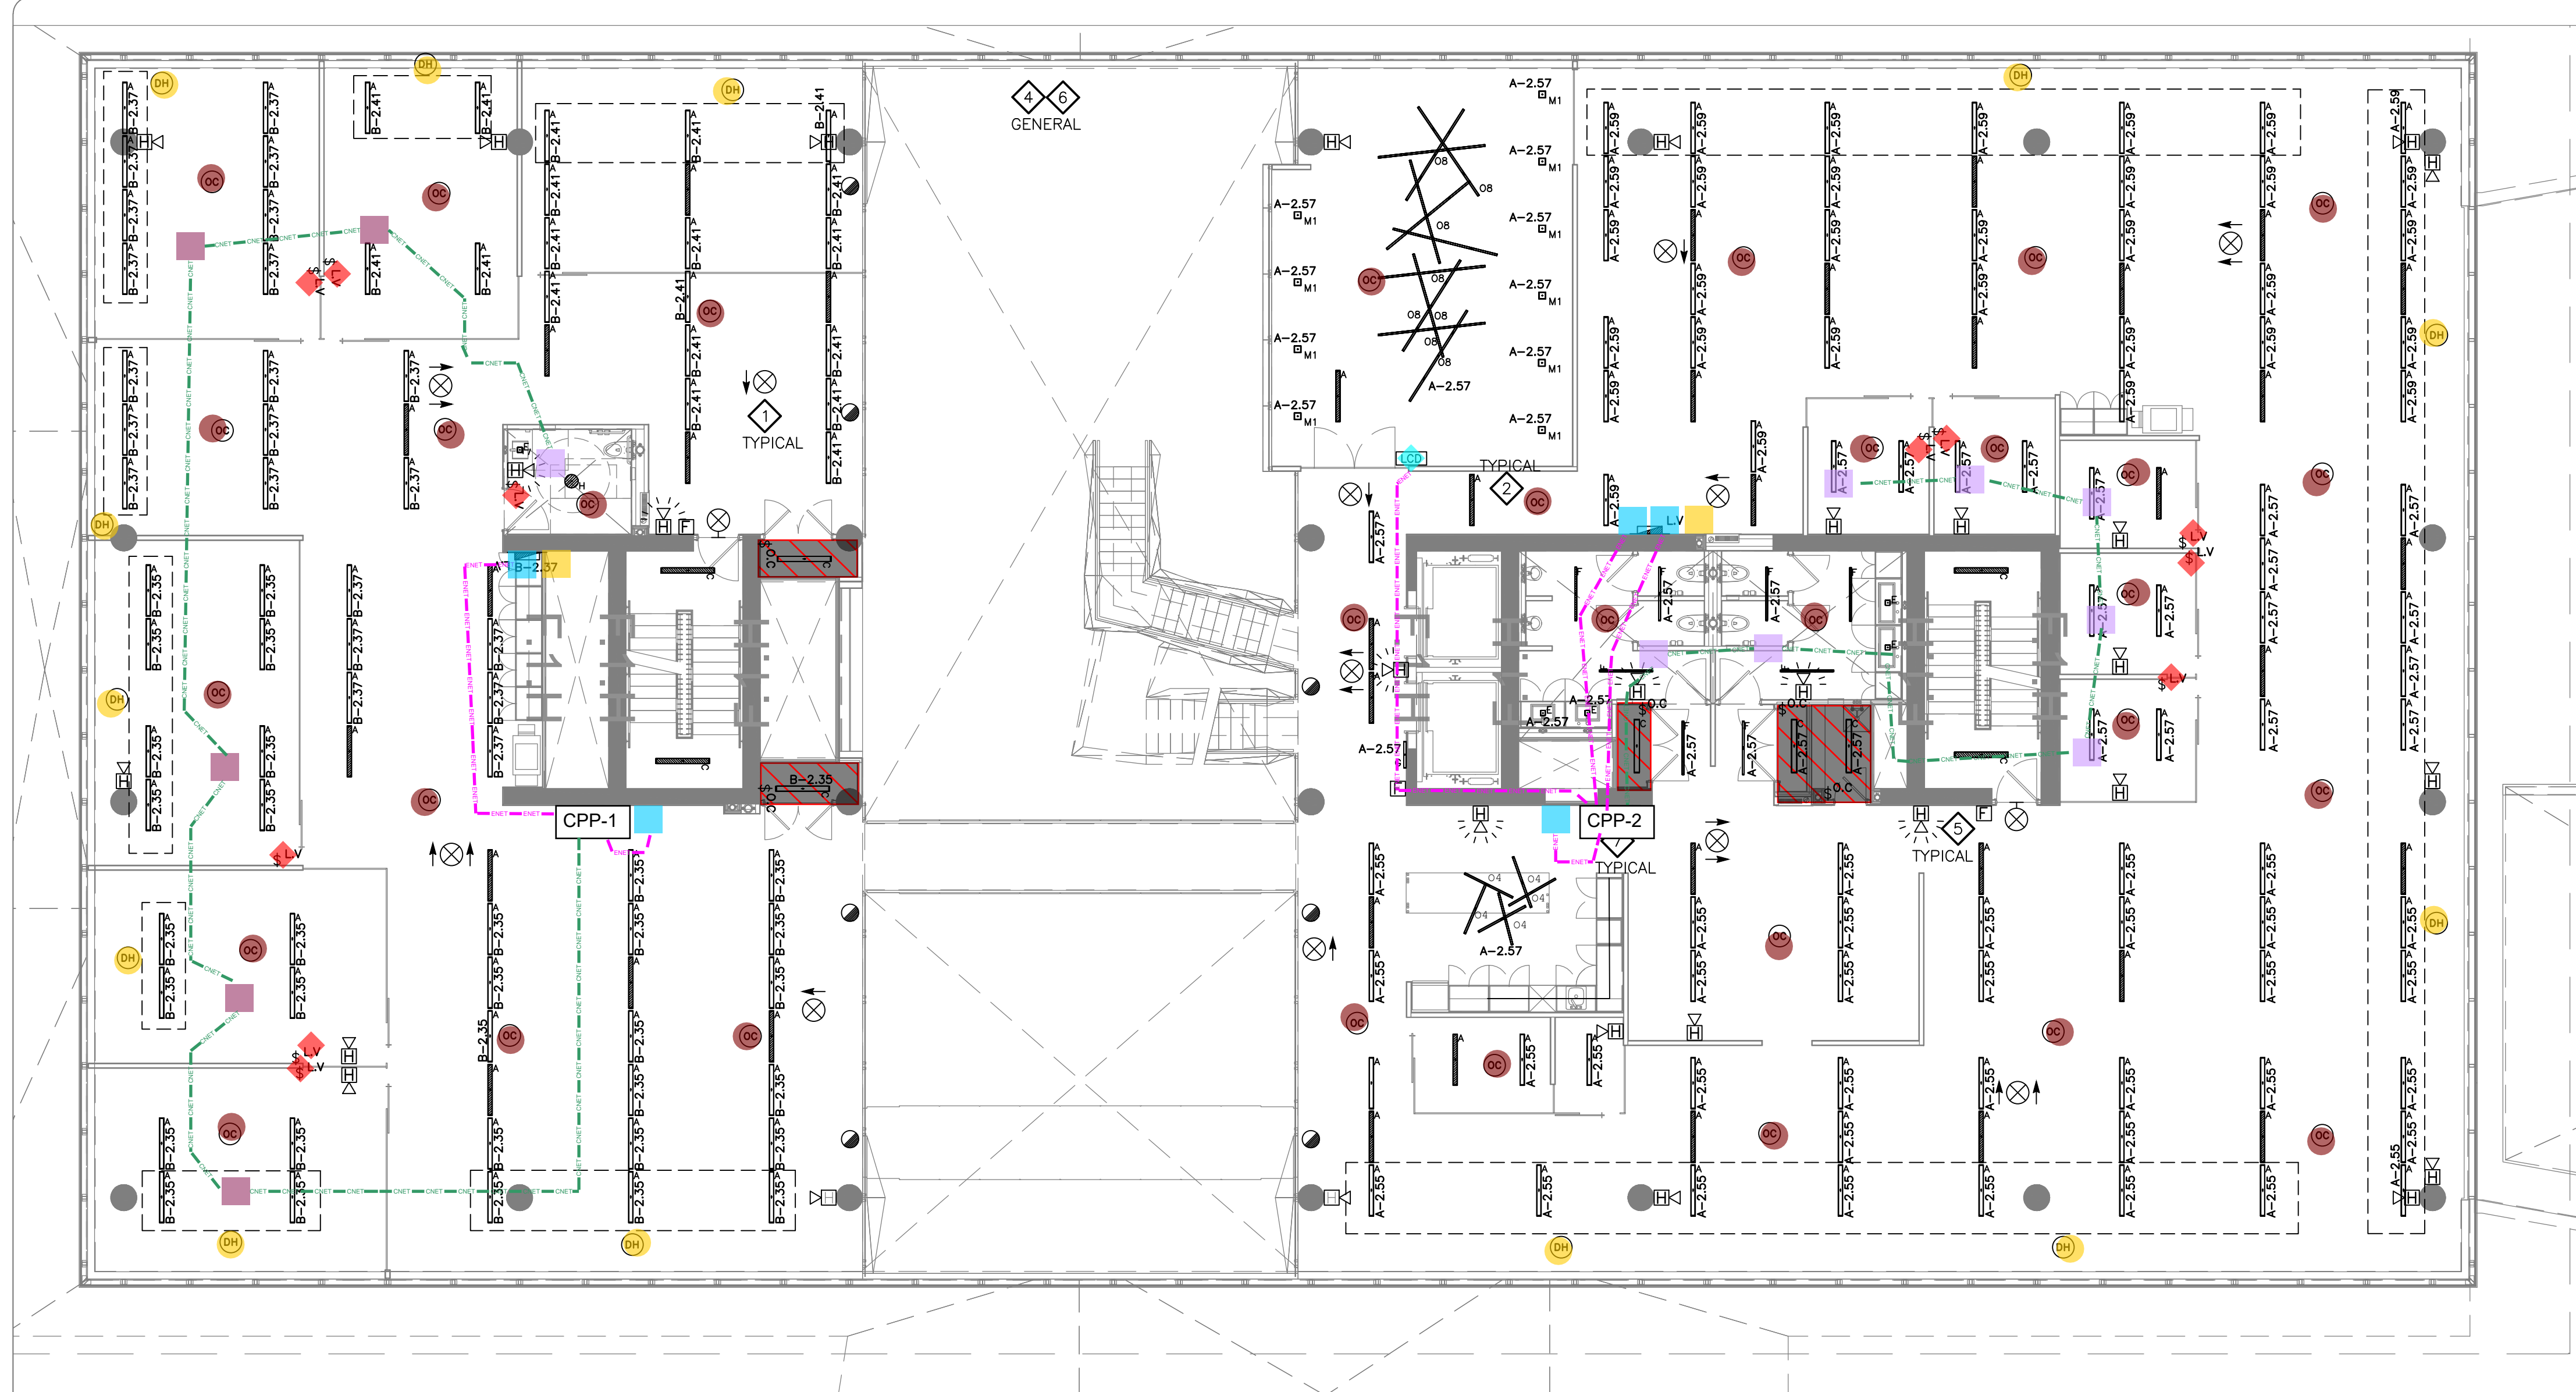

1 SECOND FLOOR – R.C.P.  
E102 SCALE 1:100

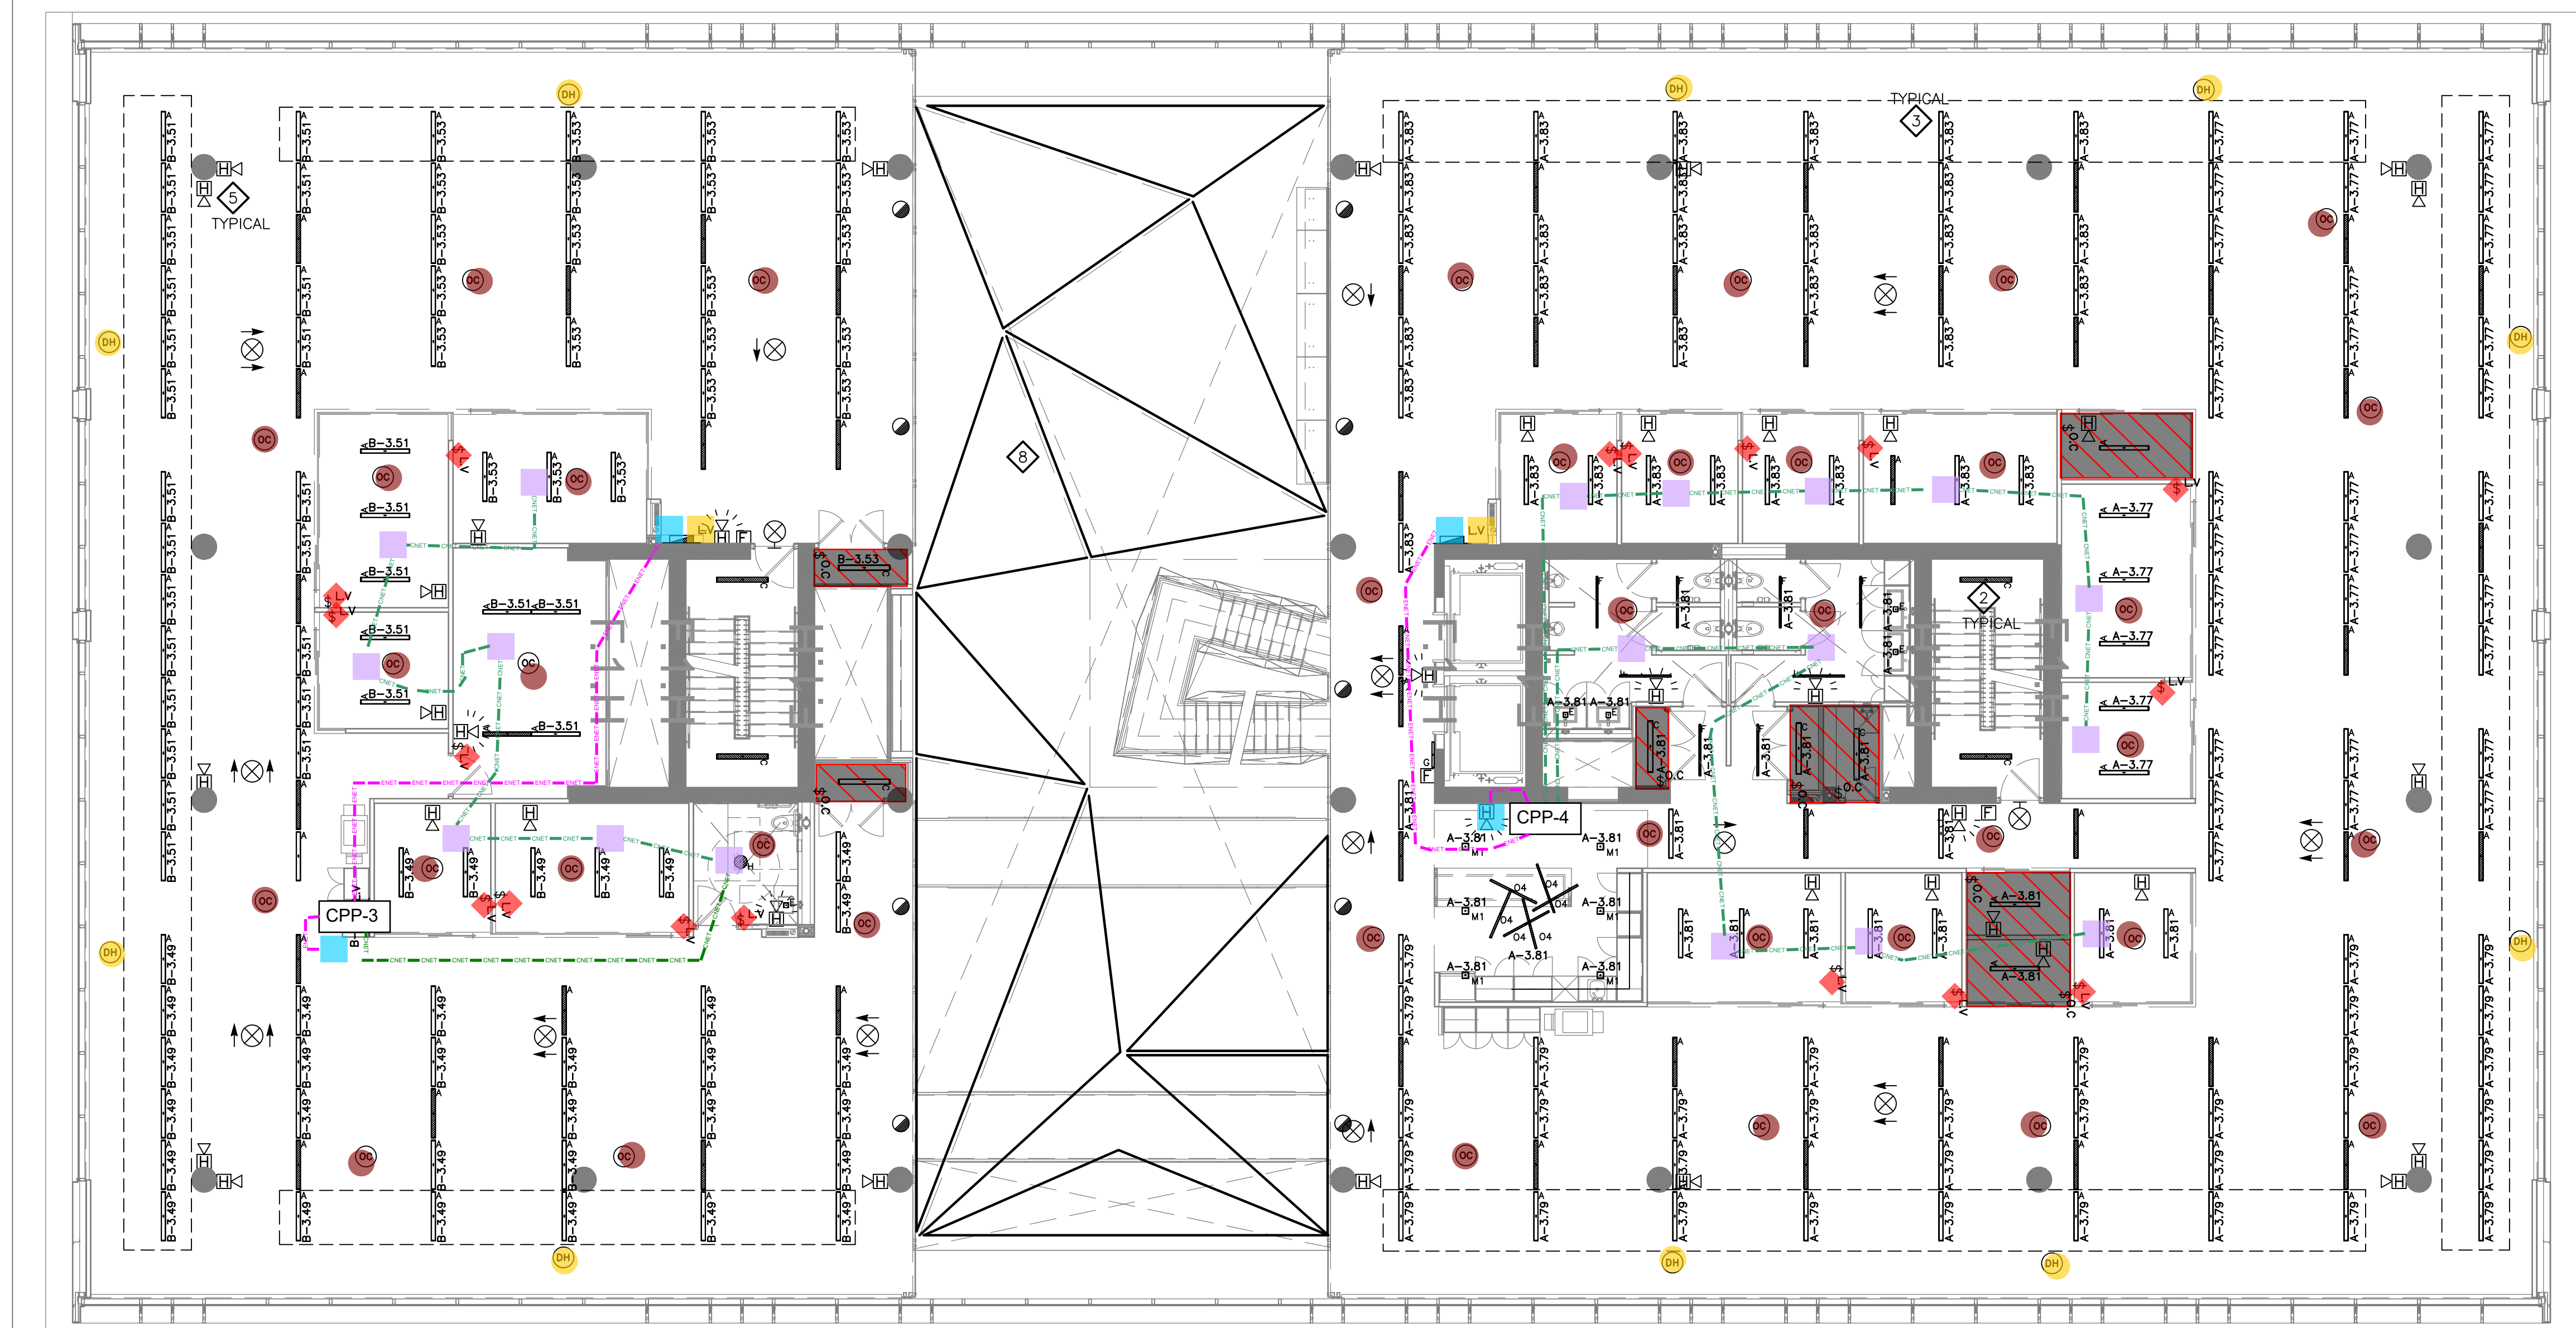

2 THIRD FLOOR – R.C.P.  
E102 SCALE 1:100

\*\*\*DRAWING IS NOT TO SCALE AND SCHEMATIC IN NATURE.\*\*\*

ETHERNET  
CRESNET

DRAWING NOTES:

- ◇ PROVIDE SIDE LIT LED EXIT SIGN C/W DIRECTIONAL ARROWS AS INDICATED, ALL ASSOCIATED HARDWARE, EXIT SIGN TO BE TIED INTO EMERGENCY LIGHTING CIRCUIT.
- ◇ LIGHT FIXTURE TO BE TIED INTO EMERGENCY LIGHTING CIRCUIT AND REMAIN UNSWITCHED AT ALL TIMES.
- ◇ PROVIDE LIGHTING FIXTURE, ALL CONDUIT, WIRING AND ASSOCIATED HARDWARE.
- ◇ ATRIUM LIGHTING TO BE TIED INTO EMERGENCY LIGHTING CIRCUITS AND REMAIN UNSWITCHED AT ALL TIMES.
- ◇ PROVIDE FIRE ALARM DEVICE AS INDICATED C/W ALL CONDUIT, WIRING AND ASSOCIATED HARDWARE.
- ◇ LIGHTING TO BE CONTROLLED BY BAS BUILDING AUTOMATION SYSTEM.
- ◇ LOW VOLTAGE LIGHTING CONTROL PANEL. TO BE MOUNTED AS HIGH AS POSSIBLE. LOCATION TO BE DETERMINED ONSITE.
- ◇ PROVIDE CUSTOM SUSPENDED LIGHT FIXTURE WITH PRE-BUILT ILLUMINATED CORNERS AND CONTINUOUS RUNS OF LIGHTING CREATING THE LOOK OF A SINGLE FIXTURE. COORDINATE SUSPENSION WITH ACOUSTIC PANELS MANUFACTURER/CONTRACTOR. FIXTURES TO BE SELF SUPPORTING.

- REVIEWED
- ☑ REVIEWED AND MODIFIED
- ☑ REVISE AND RESUBMIT
- NOT REVIEWED

The review by JRP Engineering is for the sole purpose of ascertaining conformance with the general design concept. This review shall not mean the detail design inherent in the shop drawings are approved, responsibility of which shall remain with the Contractor submitting same and review shall not relieve the Contractor of this responsibility for errors or omissions in the shop drawings or his responsibility for meeting all requirements of the Contract Documents. The Contractor is responsible for dimensions to be confirmed and correlated at the job site, for information that pertains solely to fabrication processes or to techniques of construction and installation and for co-ordination of the work of all sub-trades.  
JRP Engineering  
C.McGuire  
DATE: MAY 17th, 2017

- \* MODIFICATIONS:
1. Provide more info on the GLA-PWS50 for contractors.
  2. Contractor to coordinate installation on site with reference to slab conduits that are currently installed.
  3. If changes are required to the network layout shown in this shop drawing, the changes are to be marked up or drawings updated for the final As-Built submission for this project.
  4. Electrical to coordinate with system supplier to ensure a complete and operational system is achieved.
  5. Coordinate changes to drawings with contractors comments provided to you on May 9th, 2017.



- ◆ TOUCH SCREEN
- ◆ KEYPAD
- ◆ WIRELESS KEYPAD
- ◆ WIRELESS DIMMER
- ◆ GLPP KEYPAD
- ◆ TIMER SWITCHES
- ◆ WALL OCC SENSOR SWITCH
- ◆ DT OCC SENSOR CN
- ◆ DT OCC SENSOR NS
- ◆ PIR OCC SENSORS
- ◆ HIGH BAY OCC SENSORS
- ◆ WIRELESS OCC SENSORS
- ◆ DT WALL OCC SENSORS
- ◆ PIR WALL OCC SENSORS
- ◆ EXT PHOTO SENSOR
- ◆ PHOTO SENSOR
- ◆ CLOSED LOOP PHOTO SENSOR
- ◆ WIRELESS PHOTO SENSOR
- ◆ PARTITION SENSOR
- ◆ ESR
- ◆ GLA-EPC-1D
- ◆ GLPP-1 DIMMING
- ◆ GLPP-2 DIMMING
- ◆ GLPP-3 DIMMING
- ◆ GLPP-1 SWITCHING
- ◆ GLPP-2 SWITCHING
- ◆ GLPP-3 SWITCHING
- ◆ GLPAC-4
- ◆ GLPAC-8
- ◆ CLS-C6 (ILUX)
- ◆ CLS-EXP-DIM
- ◆ CLS-EXP-DIMLV
- ◆ CLS-EXP-DIMFLV
- ◆ CLS-EXP-DIMFLVB
- ◆ C2N-I/O
- ◆ C2N-SDC
- ◆ SIM
- ◆ WIRELESS GATEWAY
- ◆ COUNTER
- ◆ 0-10V
- ◆ ELV
- ◆ 3WIRE
- ◆ DMX
- ◆ SHADES
- ◆ MLV
- ◆ 2WIRE
- ◆ DALI
- ◆ EM

An exact copy of all working documents including, without limitation, the original of the present document or plan is kept on file by J.R.P. Engineering. Any modification carried out to this document or plan or to accompanying documents without written authorization by the engineer is prohibited.

Authorized modifications must be signed and sealed by an engineer and this engineer will be completely responsible for these modifications. J.R.P. Engineering is not and will not be responsible for the consequences of these modifications or for modifications carried out without its consent.

1	ISSUED FOR PRICING	AUG 29 2016
0	ISSUED FOR PERMIT	AUG 5 2016
No	DESCRIPTION	DATE

REVISIONS

--	--	--


client:  
TOMLINSON  
5597 POWER RD  
OTTAWA, ON  
K1G 3N4

project:  
TOMLINSON  
NEW BUILDING  
CITIGATE, OTTAWA


drawing title:  
R.C.P.  
SECOND & THIRD  
FLOOR

scale:	AS SHOWN	drawn by:	M.G
designed by:	M.G	reviewed by:	J.R.P.
approved by:	J.R.P.	date:	APR 2016

project no.:	100-16L	drawing no.:	E-102
revision:	0		

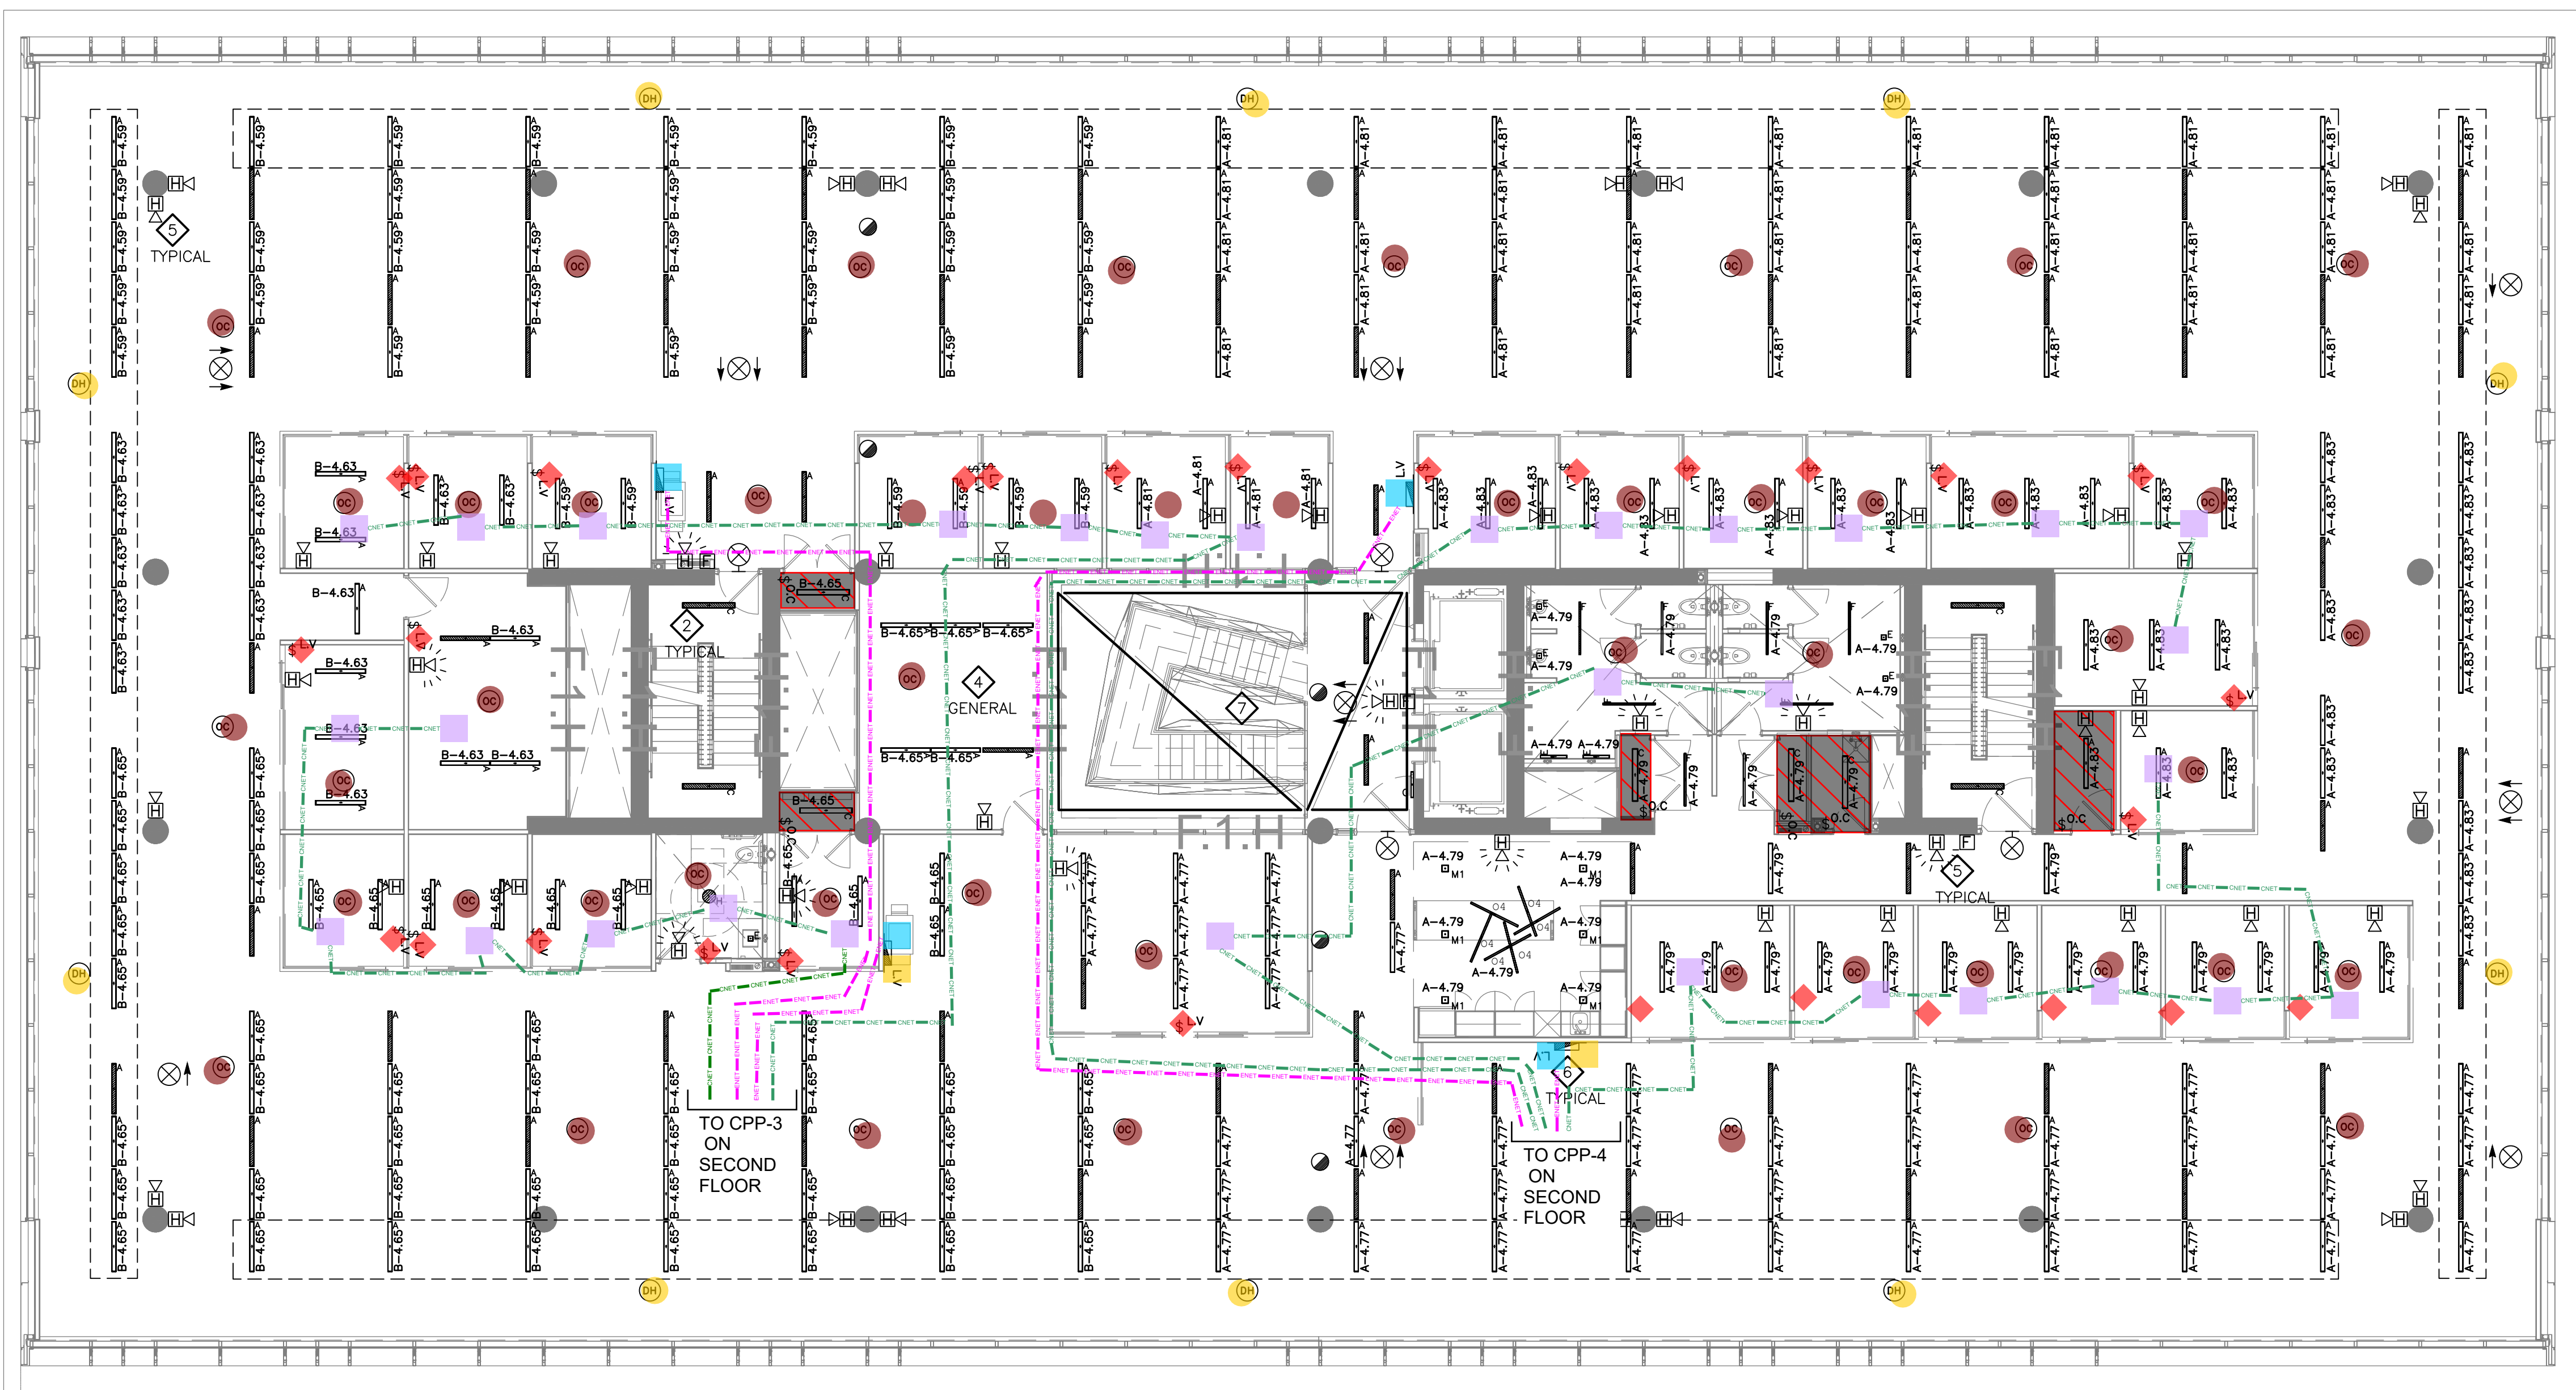

1 FOURTH FLOOR – R.C.P  
E103 SCALE 1:100

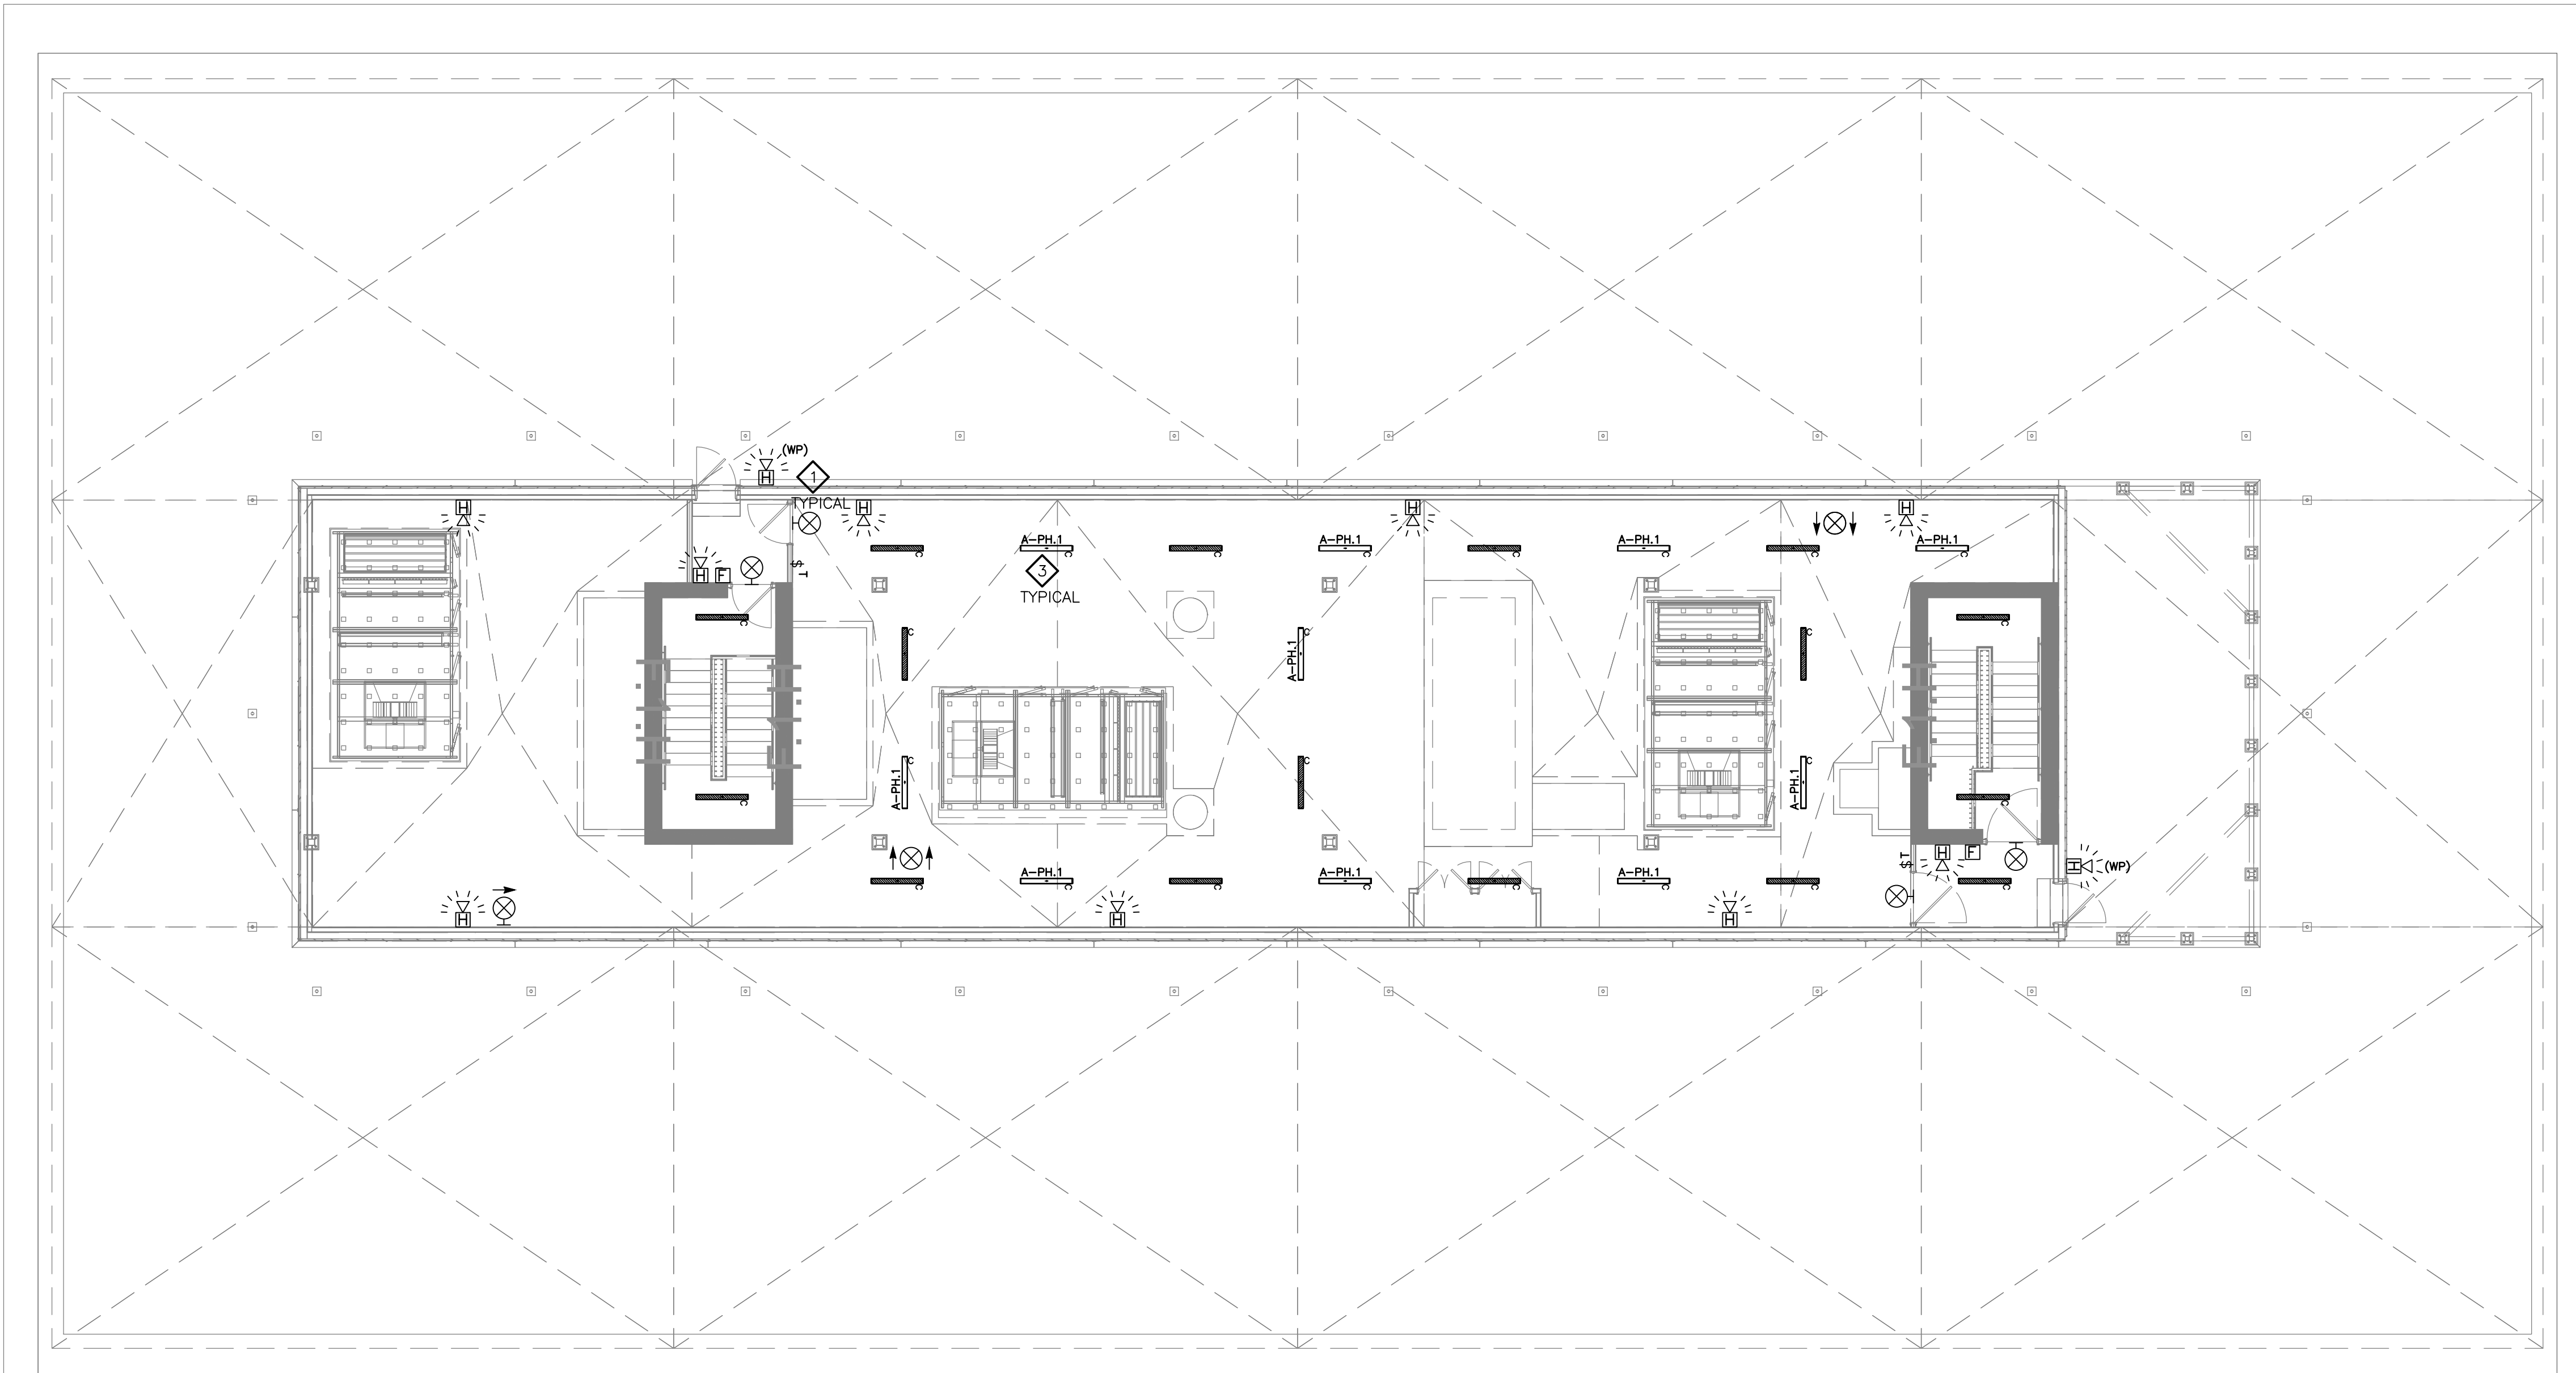

2 PENTHOUSE – R.C.P  
E103 SCALE 1:100

- REVIEWED
- REVIEWED AND MODIFIED
- REVISE AND RESUBMIT
- NOT REVIEWED

The review by JRP Engineering is for the sole purpose of ascertaining conformance with the general design concept. This review shall not mean the detail design inherent in the shop drawings are approved, responsibility of which shall remain with the Contractor submitting same and review shall not relieve the Contractor of this responsibility for errors or omissions in the shop drawings or his responsibility for meeting all requirements of the Contract Documents. The Contractor is responsible for dimensions to be confirmed and correlated at the job site, for information that pertains solely to fabrication processes or to techniques of construction and installation and for co-ordination of the work of all sub-trades.

JRP Engineering  
C.McGuire  
DATE: MAY 17th, 2017

- \* MODIFICATIONS:
1. Provide more info on the GLA-PWS50 for contractors.
  2. Contractor to coordinate installation on site with reference to slab conduits that are currently installed.
  3. If changes are required to the network layout shown in this shop drawing, the changes are to be marked up or drawings updated for the final As-Built submission for this project.
  4. Electrical to coordinate with system supplier to ensure a complete and operational system is achieved.
  5. Coordinate changes to drawings with contractors comments provided to you on May 9th, 2017.

\*\*\*DRAWING IS NOT TO SCALE AND SCHEMATIC IN NATURE.\*\*\*

- ETHERNET
- CRESNET

**DRAWING NOTES:**

- ◇ PROVIDE LED EXIT SIGN C/W DIRECTIONAL ARROWS AS INDICATED. ALL ASSOCIATED HARDWARE, EXIT SIGN TO BE TIED INTO EMERGENCY LIGHTING CIRCUIT.
- ◇ LIGHT FIXTURE TO BE TIED INTO EMERGENCY LIGHTING CIRCUIT AND REMAIN UNSWITCHED AT ALL TIMES.
- ◇ PROVIDE LIGHTING FIXTURE, ALL CONDUIT, WIRING AND ASSOCIATED HARDWARE.
- ◇ LIGHTING TO BE CONTROLLED BY BAS BUILDING AUTOMATION SYSTEM.
- ◇ PROVIDE FIRE ALARM DEVICE AS INDICATED C/W ALL CONDUIT, WIRING AND ASSOCIATED HARDWARE.
- ◇ LOW VOLTAGE LIGHTING CONTROL PANEL TO BE MOUNTED AS HIGH AS POSSIBLE. LOCATION TO BE DETERMINED ONSITE.
- ◇ PROVIDE CUSTOM SUSPENDED LIGHT FIXTURE WITH PRE-BUILT ILLUMINATED CORNERS AND CONTINUOUS RUNS OF LIGHTING CREATING THE LOOK OF A SINGLE FIXTURE. COORDINATE SUSPENSION WITH ACOUSTIC PANELS MANUFACTURER/CONTRACTOR. FIXTURES TO BE SELF SUPPORTING.



- ◆ TOUCH SCREEN
- ◆ KEYPAD
- ◆ WIRELESS KEYPAD
- ◆ WIRELESS DIMMER
- ◆ TIMER SWITCHES
- ◆ LEVITON WALL OCC SENSOR SWITCH
- ◆ DT OCC SENSOR ON
- ◆ DT OCC SENSOR NS
- ◆ PIR OCC SENSORS
- ◆ HIGH BAY OCC SENSORS
- ◆ WIRELESS OCC SENSORS
- ◆ DT WALL OCC SENSORS
- ◆ PIR WALL OCC SENSORS
- ◆ EXT PHOTO SENSOR
- ◆ PHOTO SENSOR
- ◆ CLOSED LOOP PHOTO SENSOR
- ◆ WIRELESS PHOTO SENSOR
- ◆ PARTITION SENSOR
- ◆ ESR
- ◆ EPC
- ◆ GLPP-1 DIMMING
- ◆ GLPP-2 DIMMING
- ◆ GLPP-3 DIMMING
- ◆ GLPP-1 SWITCHING
- ◆ GLPP-2 SWITCHING
- ◆ GLPP-3 SWITCHING
- ◆ GLPAC-4
- ◆ GLPAC-8
- ◆ CLS-C6 (LUX)
- ◆ CLS-EXP-DIM
- ◆ CLS-EXP-DIMU
- ◆ CLS-EXP-DIMFLV
- ◆ CLS-EXP-DIMFDB
- ◆ C2N-IO
- ◆ C2N-SDC
- ◆ SIM
- ◆ WIRELESS GATEWAY
- ◆ COUNTER
- ◆ 0-10V
- ◆ ELV
- ◆ 3WIRE
- ◆ DMX
- ◆ SHADES
- ◆ MLV
- ◆ 2WIRE
- ◆ DALI
- ◆ EM

**JRP ENGINEERING**  
Professional Engineers  
9 Holgate Cr. Kanata, Ontario, K2K 1B4  
Tel: (613) 827-2462 Email: Admin@jrpeng.com

An exact copy of all working documents including, without limitation, the original of the present document or plan is kept on file by J.R.P. Engineering. Any modification carried out to this document or plan or to accompanying documents without written authorization by the engineer is prohibited.

Authorized modifications must be signed and sealed by an engineer and this engineer will be completely responsible for these modifications. J.R.P. Engineering is not and will not be responsible for the consequences of these modifications or for modifications carried out without its consent.

No	DESCRIPTION	DATE
1	ISSUED FOR PRICING	AUG 29 2016
0	ISSUED FOR PERMIT	AUG 5 2016

REVISIONS	
No	DESCRIPTION

client:	TOMLINSON 5597 POWER RD OTTAWA, ON K1G 3N4
project:	TOMLINSON NEW BUILDING CITIGATE, OTTAWA
drawing title:	R.C.P FOURTH FLOOR & PENTHOUSE

scale:	AS SHOWN	drawn by:	M.G
designed by:	M.G	reviewed by:	J.R.P.
approved by:	J.R.P.	date:	APR 2016

project no.:	100-16L	drawing no.:	E-103
revision:	0		

An exact copy of all working documents including, without limitation, the original of the present document or plan is kept on file by J.R.P. Engineering. Any modification carried out to this document or plan or to accompanying documents without written authorization by the engineer is prohibited.

Authorized modifications must be signed and sealed by an engineer and this engineer will be completely responsible for these modifications. J.R.P. Engineering is not and will not be responsible for the consequences of these modifications or for modifications carried out without its consent.

- REVIEWED
- REVIEWED AND MODIFIED
- REVISE AND RESUBMIT
- NOT REVIEWED

The review by JRP Engineering is for the sole purpose of ascertaining conformance with the general design concept. This review shall not mean the detail design inherent in the shop drawings are approved, responsibility of which shall remain with the Contractor submitting same and review shall not relieve the Contractor of this responsibility for errors or omissions in the shop drawings or his responsibility for meeting all requirements of the Contract Documents. The Contractor is responsible for dimensions to be confirmed and correlated at the job site, for information that pertains solely to fabrication processes or to techniques of construction and installation and for co-ordination of the work of all sub-trades.

C. McGuire  
DATE: MAY 17th, 2017


- \* MODIFICATIONS:**
1. Provide more info on the GLA-PWSSD for contractors.
  2. Contractor to coordinate installation on site with reference to slab conduits that are currently installed.
  3. If changes are required to the network layout shown in this shop drawing, the changes are to be marked up on drawings updated for the final As-Built submission for this project.
  4. Electrical to coordinate with system supplier to ensure a complete and operational system is achieved.
  5. Coordinate changes to drawings with contractors comments provided to you on May 9th, 2017.

\*\*\*DRAWING IS NOT TO SCALE AND SCHEMATIC IN NATURE.\*\*\*

- ETHERNET
- CRESNET

**DRAWING NOTES:**

1. PROVIDE LED EXIT SIGN C/W DIRECTIONAL ARROWS AS INDICATED. ALL ASSOCIATED HARDWARE. EXIT SIGN TO BE TIED INTO EMERGENCY LIGHTING CIRCUIT.
2. LIGHT FIXTURE TO BE TIED INTO EMERGENCY LIGHTING CIRCUIT AND REMAIN UNSWITCHED AT ALL TIMES.
3. PROVIDE LIGHTING FIXTURE, ALL CONDUIT, WIRING AND ASSOCIATED HARDWARE.
4. FIRE ALARM PANEL, REFER TO RISER DIAGRAM FOR FURTHER DETAILS.
5. PROVIDE FIRE ALARM DEVICE AS INDICATED C/W ALL CONDUIT, WIRING AND ASSOCIATED HARDWARE.
6. LIGHTING TO BE CONTROLLED BY BAS BUILDING AUTOMATION SYSTEM.

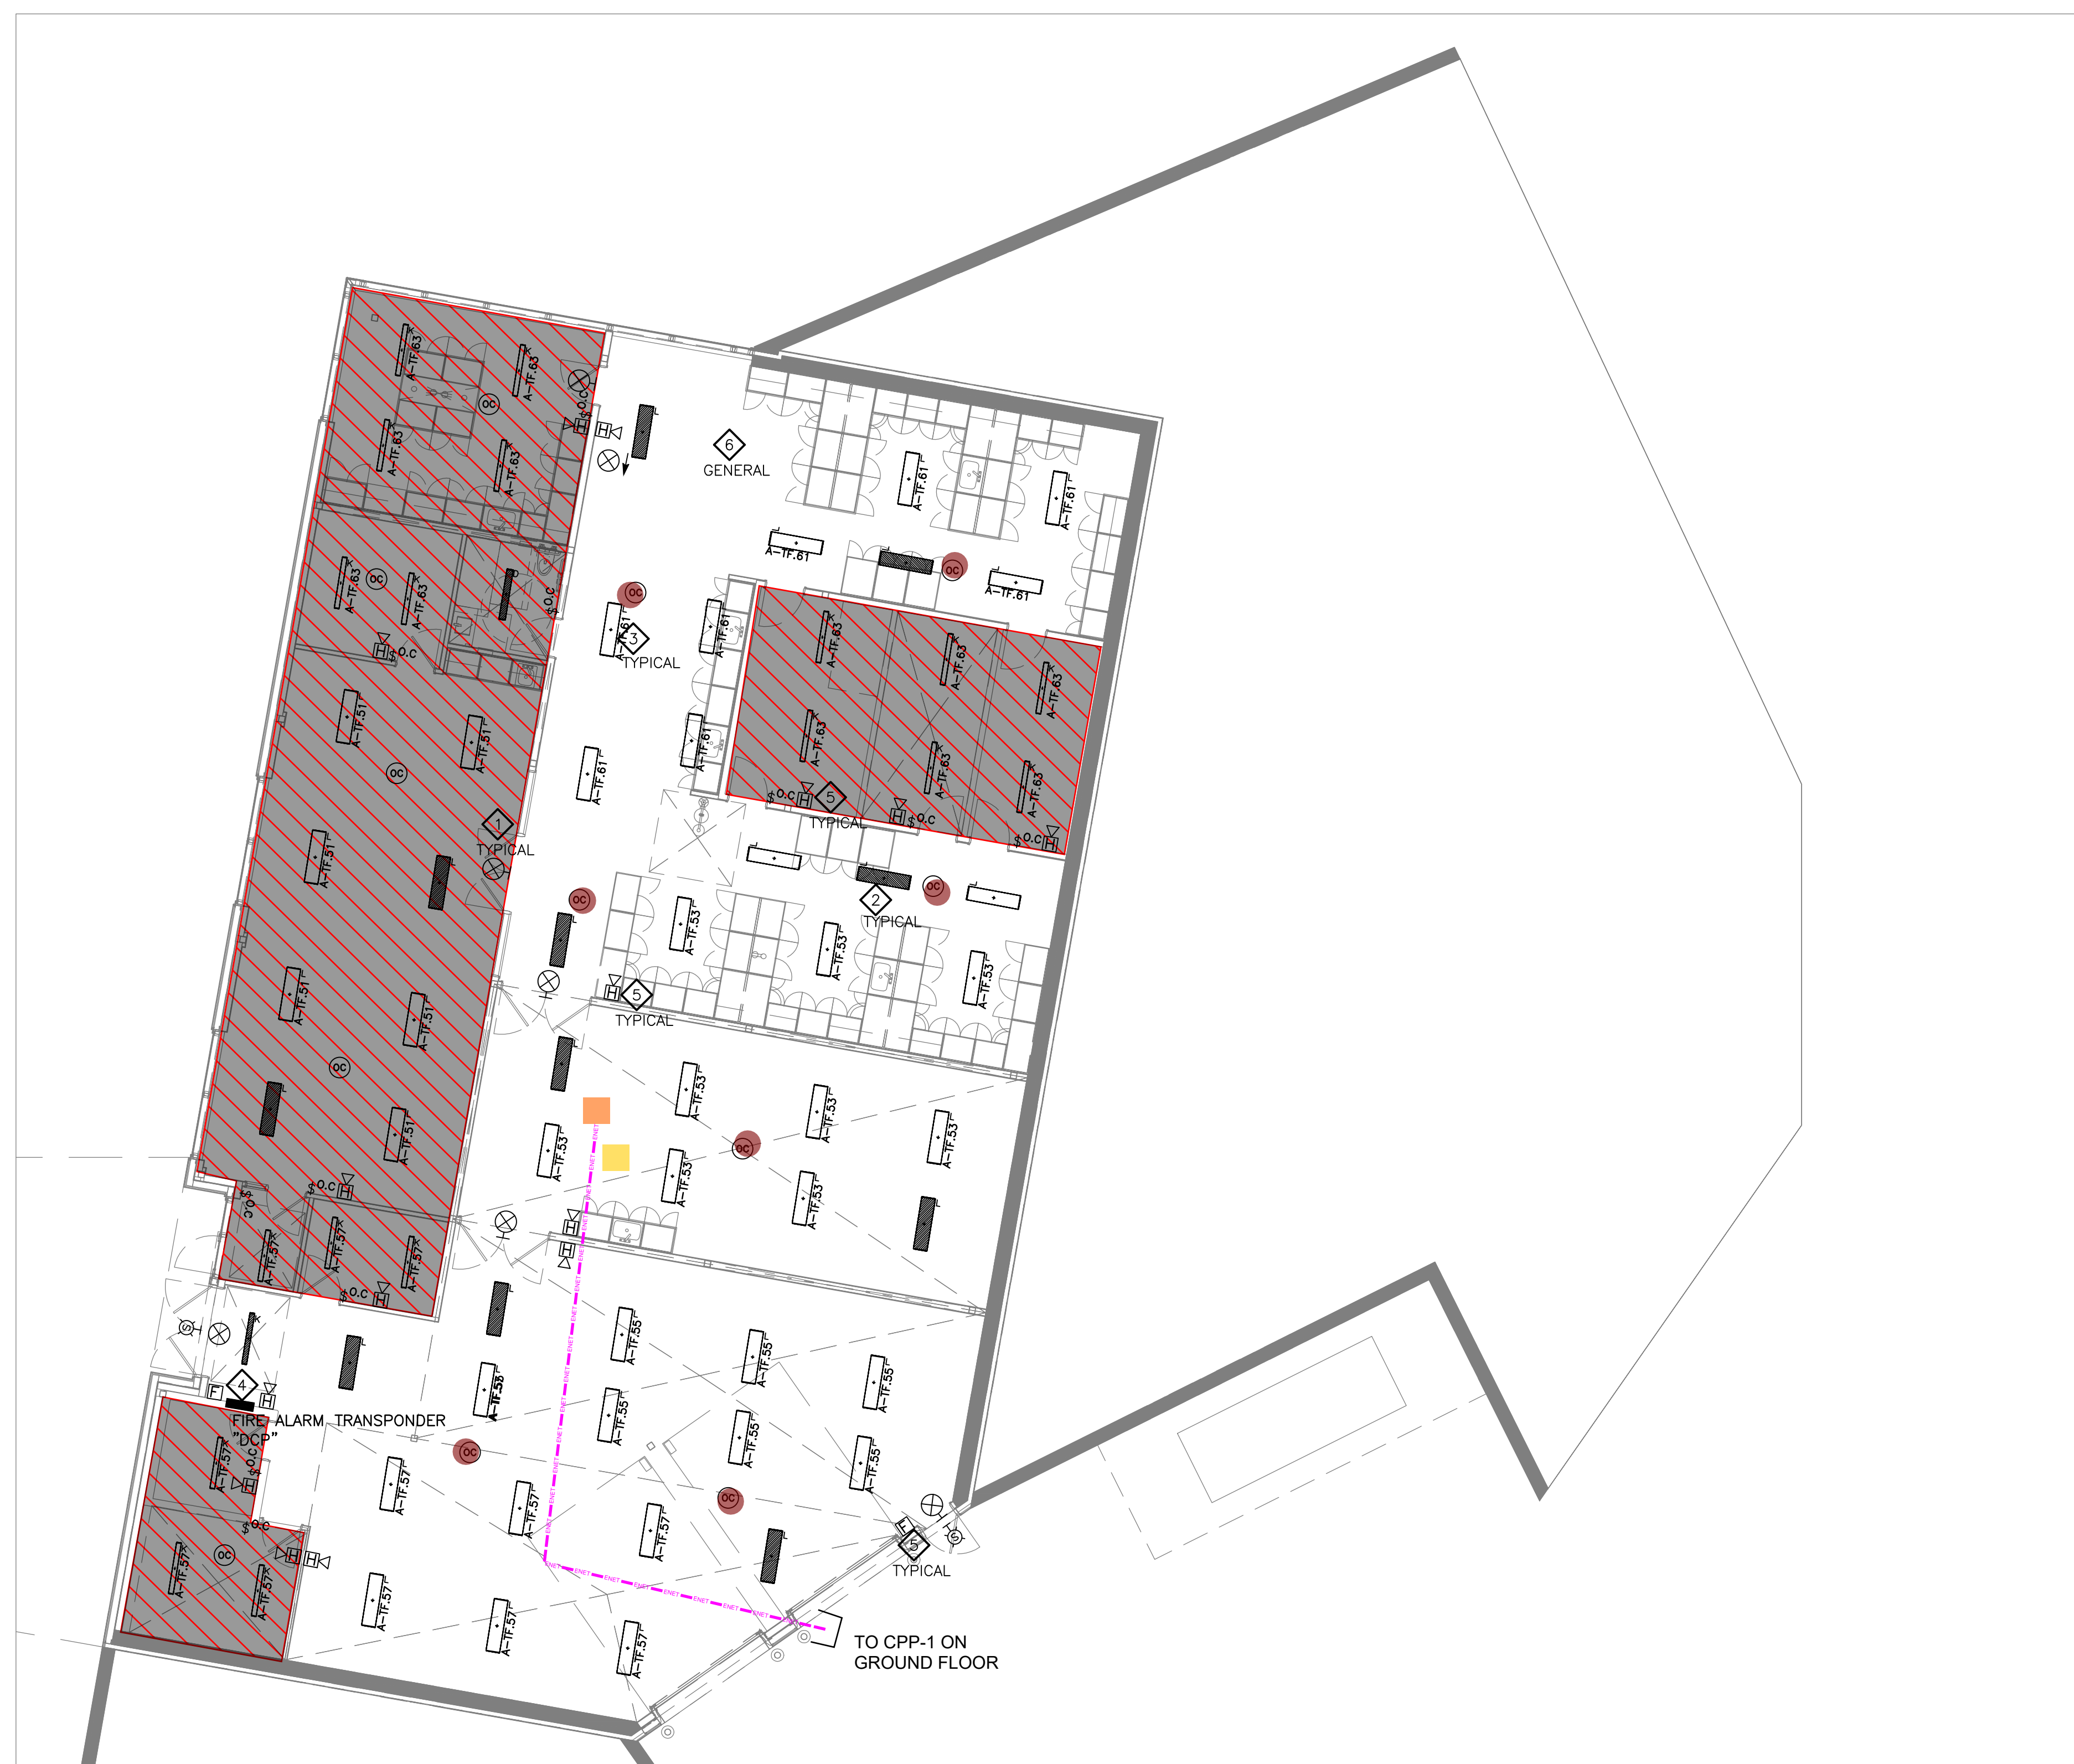

1 TEST FACILITY -- R.C.P.  
E104 SCALE 1:100



- |                          |                  |
|--------------------------|------------------|
| TOUCH SCREEN             | GLPP-1 DIMMING   |
| KEYPAD                   | GLPP-2 DIMMING   |
| WIRELESS KEYPAD          | GLPP-3 DIMMING   |
| WIRELESS DIMMER          | GLPP-1 SWITCHING |
| GLPP KEYPAD              | GLPP-2 SWITCHING |
| TIMER SWITCHES           | GLPP-3 SWITCHING |
| WALL OCC SENSOR SWITCH   | GLPAC-4          |
| DT OCC SENSOR CN         | GLPAC-8          |
| DT OCC SENSOR NS         | CLS-C6 (iLUX)    |
| PIR OCC SENSORS          | CLS-EXP-DIM      |
| HIGH BAY OCC SENSORS     | CLS-EXP-DIMU     |
| WIRELESS OCC SENSORS     | CLS-EXP-DIMFLV   |
| DT WALL OCC SENSORS      | CLS-EXP-DIMFDB   |
| PIR WALL OCC SENSORS     | C2N-IO           |
| EXT PHOTO SENSOR         | C2N-SDC          |
| PHOTO SENSOR             | SIM              |
| CLOSED LOOP PHOTO SENSOR | WIRELESS GATEWAY |
| WIRELESS PHOTO SENSOR    | COUNTER          |
| PARTITION SENSOR         | 0-10V            |
| ESR                      | ELV              |
| GLA-EPC-1D               | 2WIRE            |
|                          | DMX              |
|                          | DALI             |
|                          | EM               |
|                          | SHADES           |

No	DESCRIPTION	DATE
0	ISSUED FOR REVIEW	JUNE 15 2016

REVISIONS	

client:  
**TOMLINSON**  
5597 POWER RD  
OTTAWA, ON  
K1G 3N4

project:  
**TOMLINSON**  
NEW BUILDING  
CITIGATE, OTTAWA

drawing title:  
**R.C.P**  
TEST FACILITY

scale:	AS SHOWN	drawn by:	M.G
designed by:	M.G	reviewed by:	J.R.P.
approved by:	J.R.P.	date:	APR 2016

project no.:	100-16L	drawing no.:	E-104
revision:	0		



BDA Lighting Group
77 Auriga Drive, Unit 6
Ottawa On K2E7Z7
Phone: (613) 727-6223
Toll Free: (855) 606-6223
Website: WWW.BDALG.CA

Project: Tomlinson Head Office - LEVITON
Quote#: BDA17-18161
Location: Ottawa On
To: NEDCO
700 Industrial Ave
Ottawa ON K1G 0Y9
Contact:

REVIEWED
REVIEWED AND MODIFIED
REVISIONS AND RESUBMIT
NOT REVISIONED
From: Eric Seguin
Contact Ph: (613) 727-6223x234
Email: eseguin@bdalg.ca

The review by JRP Engineering is for the sole purpose of ascertaining conformance with the general design concept. This review shall not mean the detail design inherent in the shop drawings are approved, responsibility of which shall remain with the Contractor submitting same and review shall not relieve the Contractor of this responsibility for errors or omissions in the shop drawings or his responsibility for meeting all requirements of the Contract Documents. The Contractor is responsible for dimensions to be confirmed and correlated at the job site for information that pertains solely to fabrication processes or techniques of construction and installation and for co-ordination of the work of all sub-trades.

JRP Engineering
C.McGuire

ATTACHED WE ARE SENDING YOU 1 COPIES OF THE FOLLOWING ITEMS:

- Drawings
Prints
Plans
Specifications
Information
Submittals

THESE ARE TRANSMITTED FOR:

- Prior Approval
Approval
Approval as Submitted
Approval as Noted
Resubmit for Approval
Corrections
Your Use and Comment
Review

Table with 4 columns: Qty, Type, MFG, Part. Rows include OS SWITCH and TIMER SW.

DATE: MAY 17th, 2017

\* MODIFICATIONS:

- 1. Provide more information on the GLA-PWS50 for contractors.
2. Contractor to coordinate installation on site with reference to slab conduits that are currently installed.
3. If changes are required to the network layout shown in this shop drawing, the changes are to be marked up or drawings updated for the final As-Built submission for this project.
4. Electrical to coordinate with system supplier to ensure a complete and operational system is achieved.
5. Coordinate changes to drawings with contractors comments provided to you on May 9th, 2017.

**PRODUCT DATA**

- REVIEWED
- REVIEWED AND MODIFIED
- REVISE AND RESUBMIT
- NOT REVIEWED



# Decora® Wall Switch Multi-Technology Occupancy Sensor



OSSMT-MD/GD

The review by JRP Engineering is for the sole purpose of ascertaining conformance with the general design concept. This review shall not mean the detail design inherent in the shop drawings are approved, responsibility of which shall remain with the Contractor submitting same and review shall not relieve the Contractor of this responsibility for errors or omissions in the shop drawings or his responsibility for meeting all requirements of the Contract Documents. The Contractor is responsible for dimensions to be confirmed and correlated at the job site, for information that pertains solely to fabrication processes or to techniques of construction and installation and for co-ordination of the work of all sub-trades.

JRP Engineering

**BASIC OPERATION**

Occupancy sensors have two tasks: keep the lights ON while the space is occupied and turning the lights OFF when unoccupied.

The PIR sensors provide immunity to false ON through a specialized Fresnel lens which view into sensor zones. When a part of a sensor zone, the sensor switches the lights ON.

The Ultrasonic (U/S) sensors provide sensitivity and range in difficult shaped rooms and partitions the field-of-view. A pair of U/S sensors shifts caused by motion in a space OFF. These sensors are more sensitive since they do not rely on z

**APPLICATIONS**

Leviton's OSSMT Multi-Technology Occupancy Sensor is used to provide control for energy savings a variety of commercial application

- Retrofit
- Private and executive offices
- Conference rooms
- Storage areas
- Restrooms
- Classrooms
- Lounges
- Training areas
- Multi-location switching (similar to 3-way)

C.McGuire

**SELF-ADAPTIVE TECHNOLOGY**

Designed for "install and forget" use, the OSSMT automatically adapts to the environment.

DATE: MAY 17th, 2017

**\* MODIFICATIONS:**

1. Provide more information on the GLA-PWS50 for contractors.
2. Contractor to coordinate installation on site with reference to slab conduits that are currently installed.
3. If changes are required to the network layout shown in this shop drawing, the changes are to be marked up or drawings updated for the final As-Built submission for this project.
4. Electrical to coordinate with system supplier to ensure a complete and operational system is achieved.
5. Coordinate changes to drawings with contractors comments provided to you on May 9th, 2017.

**Leviton Mfg. Co., Inc. Lighting & Energy Solutions**

**PRODUCT DATA**

**FEATURES**


- Fast, simple Installation: Fits in a standard wall box and replaces a single-pole wall-switch; neutral and ground options available. Sensor can be ganged together with other units in a multiple-switch wall plate.
- Low-profile design eliminates obtrusive "scanning-device" look. Elegant Decora wallplates complement the look for sleek aesthetics; uses Decora wallplates and coordinates with Leviton's popular line of Decora wiring devices.
- Convenient Pushbutton provides manual-ON/OFF light switching at any time.
- Segmented Fresnel lens provides optimum sensitivity and performance. Designed with an external "minor motion" area where even slight body movements will be detected.
- Vandal resistant PIR lens.
- Patented Blinders: Adjustable horizontal field-of-view (PIR) may be adjusted between 180° and 60° of arc by using integral blinders located on either side of the sensor masking required.
- Manual-ON/auto-OFF mode for installations where manual-ON switching is required but auto-OFF switching is desired for CEC Title 24 energy savings.
- To comply with CEC Title 24, LED indicator light flashes when sensor detects motion to verify detection status. Green flashes for ultrasonic, red flashes for PIR.
- Time: The delayed OFF time is preset at 30 minutes in the Auto Adapting mode. A choice of four delayed time settings are available: 30-seconds (for walking test purposes only), 10, 20, and 30 minutes for fixed time auto adapting. The LED will flash when the adjusting knob is set to the indicated time value.
- Ambient Light Recognition: Integrated light sensor prevents lights from turning on when the room is adequately illuminated by natural light.
- Self-Adaptive Technology: Callbacks for adjustment eliminated. Time delay and sensitivity settings continually adjusted to occupant patterns of use adapt mode.
- Exclusive Walk-through Feature provides increased energy savings by not leaving the lights ON extended period after only momentary occupancy.
- Vacancy Confirmation: When the time out expires the relays turn OFF, a 30 second (OSSMT-G) or 45 (OSSMT-M) vacancy confirmation exists to turn them back on.
- False detection circuitry.
- Small Motion Sensitivity (U/S): Ultrasonic technology provides excellent minor motion sensitivity.
- Ability to disable U/S (OSSMT-M). For added security OSSMT-G has the ability to disable both PIR and U/S.
- Presentation Mode feature: For slide or film presentations, allows pushbuttons to turn lights OFF and them OFF while the room is occupied.
- Exclusive Leviton H.I.S. Circuitry. Specifically designed to handle today's high inrush electronic ballast loads offer unmatched durability and service.
- True Zero-Cross Relay switches at the zero cross of the AC power curve to ensure maximum contact life and compatibility with electronic ballasts.

- REVIEWED
- REVIEWED AND MODIFIED
- REVISE AND RESUBMIT
- NOT REVIEWED

**FIELD OF VIEW**


The OSSMT provides a 180° field-of-view with a maximum coverage area of approximately 2400 square feet. The maximum sensing distance in front of the sensor is 40 feet, and side to side is 30 feet. The "minor motion" zone detects relatively small body movements and allows the lights to stay on even though a person may not be moving or walking around the room. The remainder of the field-of-view, the "major motion" zone, exhibits a lesser degree of sensitivity and requires larger movements.

The review by JRP Engineering is for the sole purpose of ascertaining conformance with the general design concept. This review shall not mean the detail design inherent in the shop drawings are approved, responsibility of which shall remain with the Contractor submitting same and review shall not relieve the Contractor of this responsibility for errors or omissions in the shop drawings or his responsibility for meeting all requirements of the Contract Documents. The Contractor is responsible for dimensions to be confirmed and correlated at the job site, for information that pertains solely to fabrication processes or to techniques of construction and installation and for co-ordination of the work of all sub-trades.

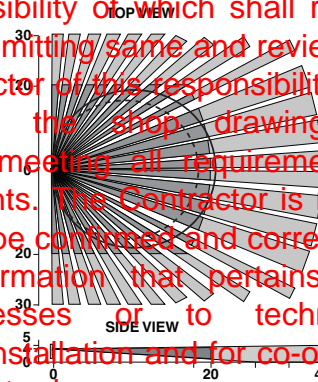

JRP Engineering  
C.McGuire

**MECHANICAL DIAGRAMS**

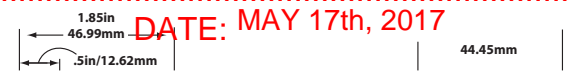


DATE: MAY 17th, 2017

**\* MODIFICATIONS:**

1. Provide more information on the GLA-PWS50 for contractors.
2. Contractor to coordinate installation on site with reference to slab conduits that are currently installed.
3. If changes are required to the network layout shown in this shop drawing, the changes are to be marked up or drawings updated for the final As-Built submission for this project.
4. Electrical to coordinate with system supplier to ensure a complete and operational system is achieved.
5. Coordinate changes to drawings with contractors comments provided to you on May 9th, 2017.

OSSMT

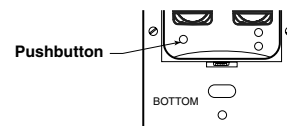


- REVIEWED
- REVIEWED AND MODIFIED
- REVISE AND RESUBMIT
- NOT REVIEWED



**INSTALLATION**

The OSSMT is preset to deliver optimum performance in a wide variety of applications without requiring any adjustments during installation. Exclusive self-adjusting operating features will automatically compensate for real-time occupancy patterns to provide maximum convenience and energy savings. The unit may replace a single-pole wall switch mounted in a standard wall box. The OSSMT-MD must have a neutral wire connected to the unit in order to operate. The OSSMT-GD does not require a neutral for installation. The unit's integral blinders may be used to restrict the field of view to prevent unwanted detection of traffic. It should be positioned at least 6 feet away from HVAC registers. Note that whenever the unit is powered up, it will take approximately 1 minute to begin normal operation.

**WIRING DIAGRAM**

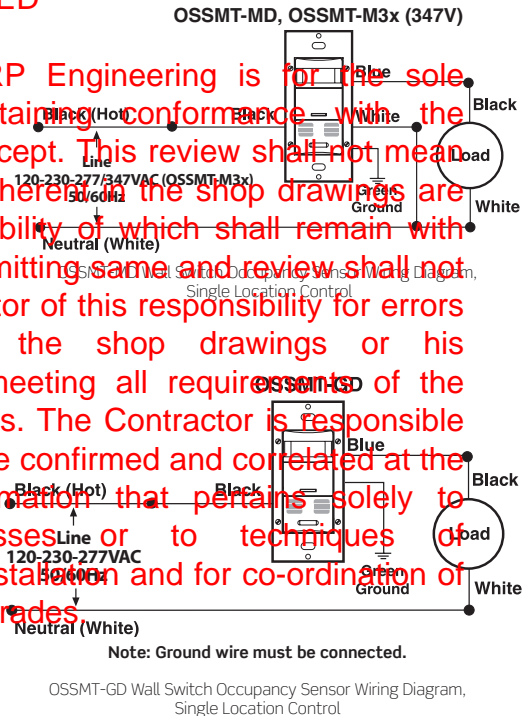

The review by JRP Engineering is for the sole purpose of ascertaining conformance with the general design concept. This review shall not mean the detail design inherent in the shop drawings are approved, responsibility of which shall remain with the Contractor submitting same and review shall not relieve the Contractor of this responsibility for errors or omissions in the shop drawings or his responsibility for meeting all requirements of the Contract Documents. The Contractor is responsible for dimensions to be confirmed and correlated at the job site for information that pertains solely to fabrication processes or to techniques of construction and installation and for co-ordination of the work of all sub-trades.

JRP Engineering  
C.McGuire

DATE: MAY 17th, 2017

**SPECIFICATIONS**

ELECTRICAL	
Line Voltage	120-230-277/347 VAC (OSSMT-M3x)
Power Consumption	U/S & PIR PIR only
OSSMT-MD	120V 180mW 277V 190mW 347V 270mW
OSSMT-M3x	120V 500mW 277V 350mW 347V 350mW
OSSMT-GD	120V 340mW 277V 310mW
Operational Frequency	50/60Hz
Ultrasonic Operating Frequency	40kHz
Wire Designation	Line-Black Neutral-White Load-Blue Ground-Green
Load Rating	Incandescent/Tungsten: 800W @ 120V Fluorescent: 1200VA @ 120V 2700VA @ 277V, 1500VA @ 120V

**ENVIRONMENTAL**

Operating Temperature Range	32°F to
Storage Temperature Range	14°F to
Relative Humidity	20% to

**OTHER**

Listings	OSSMT-MD = UL/cUL OSSMT-M3 = cETL Listed, CSA CEC Title 24 Compliant, FCC Compliant
Warranty	Limited Five-Year Warranty

**ORDERING INFORMATION**

CAT. NO. *	DESCRIPTION
OSSMT-MDx	Multi-Technology Wall Switch
OSSMT-MDx	No Neutral, Multi-Technology Occupancy Sensor
OSSMT-M3x	Multi-Technology Wall Switch 347V

\* Replace x with (-W) White, (-I) Ivory, (-T) Light Almond  
NOTE: OSSMT-M3x model available in (-W) White.  
\* NAFTA compliant and Made in USA models available

OSSMT



**Project Name:**  
Tomlinson Head Office -  
LEVIT

**Product Number:**  
OSSMT-MDW

**Type:**  
**OS SWITCH**

- REVIEWED
- REVIEWED AND MODIFIED
- REVISE AND RESUBMIT
- NOT REVIEWED

Notes:

BDA17-18161

**PRODUCT DATA**



The review by JRP Engineering is for the sole purpose of ascertaining conformance with the general design concept. This review shall not mean the detail design inherent in the shop drawings are approved, responsibility of which shall remain with the Contractor submitting same and review shall not relieve the Contractor of this responsibility for errors or omissions in the shop drawings or his responsibility for meeting all requirements of the Contract Documents. The Contractor is responsible for dimensions to be confirmed and correlated at the job site, for information that pertains solely to fabrication processes or to techniques of construction and installation and for co-ordination of the work of all sub-trades.

JRP Engineering

C.McGuire

DATE: MAY 17th, 2017

**\* MODIFICATIONS:**

1. Provide more infor ont he GLA-PWS50 for contractors.
2. Contractor to coordinate installation on site with reference to slab conduits that are currently installed.
3. If changes are required to the network layout shown in this shop drawing, the changes are to be marked up or drawings updated for the final As-Built submission for this project.
4. Electrical to coordinate with system supplier to ensure a complete and operational system is achieved.
5. Coordinate changes to drawings with contractors comments provided to you on May 9th, 2017.

OSSMT

**LEVITON SPECIFICATION**

JOB NAME: \_\_\_\_\_  
 JOB NUMBER: \_\_\_\_\_

**Leviton Manufacturing Co., Inc. Lighting & Energy Solutions**

201 N. Service Rd. Melville, NY 11747-3138 Tech Line: 1-800-824-3005 Fax: 1-800-832-9538 www.leviton.com/les

**Leviton Manufacturing of Canada, Ltd.**

165 Hymus Boulevard, Pointe Claire, Quebec H9R 1E9 • Telephone: 1-800-469-7890 • FAX: 1-800-563-1853

**Leviton S. de R.L. de C.V.**

Lago Tana 43, Mexico DF, Mexico CP 11290 • Tel. (+52) 55-5082-1040 • FAX: (+52) 5386-1797 • www.leviton.com.mx

**Visit our Website at: [www.leviton.com/les](http://www.leviton.com/les)**

© 2011 Leviton Manufacturing Co., Inc. All rights reserved. Subject to change without notice


G-7357D CDA  
REV NOV 2011

**PROJECT SPECIFICATIONS**

- NOT REVIEWED
- REVIEWED AND MODIFIED
- REVISE AND RESUBMIT
- NOT REVIEWED



**Timer Switches for Energy Management**

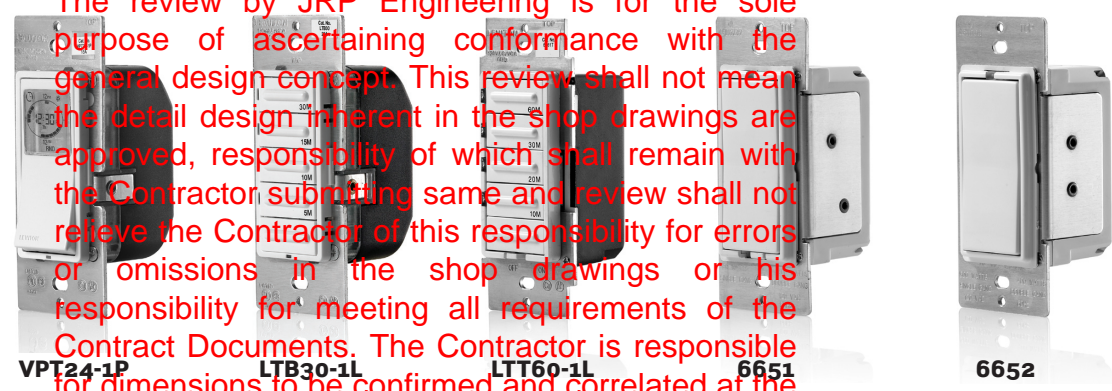

The review by JRP Engineering is for the sole purpose of ascertaining conformance with the general design concept. This review shall not mean the detail design inherent in the shop drawings are approved, responsibility of which shall remain with the Contractor submitting same and review shall not relieve the Contractor of this responsibility for errors or omissions in the shop drawings or his responsibility for meeting all requirements of the Contract Documents. The Contractor is responsible for dimensions to be confirmed and correlated at the job site for information that pertains solely to fabrication processes or to techniques of construction and installation and for coordination of the work of all sub-trades.

Better... with... other... advanced features, superior accuracy and contemporary aesthetics. Our robust selection provides convenient timed control... hotel rooms and other small commercial applications. An easy upgrade, automatic timers help reduce energy costs, improve security... homeowners can set lights to turn on and off for a lived-in look while they are away, or automate control pumps or bathroom fans. Our versatile selection includes... programmable and preset timers in popular styles and colors. All are backed by a long history of quality and reliability.

**As-Built Decora® Timer Switches (neutral required)**  
For lighting, heat lamps, hot tubs, attic and exhaust fans

- Improved 15-, 30-, or 60-minute timers, plus 12- and new
- Four preset buttons and OFF
- Simple press and hold override timer function
- Flexibility to program timer to convert to any other timer interval
- Color/Timer change kits available
- Three colors in one box

**As-Built Decora® Timer Switches**  
For incandescent indoor and outdoor lighting

**APPLICA**

- Resident
- Ventilati
- Heaters,

**FEATURI**

- Single pc
- Replaces for selec
- Soothing
- Coordina

**New Vizia For indoor**

- Easy to p
- Timer se
- Flexibility or any cc
- Astronor sunrise/:
- Automat
- Recharge power ot
- Three co
- Color change kits available

**\* MODIFICATIONS:**

1. Provide more infor ont he GLA-PWS50 for contractors.
2. Contractor to coordinate installation on site with reference to slab conduits that are currently installed.
3. If changes are required to the network layout shown in this shop drawing, the changes are to be marked up or drawings updated for the final As-Built submission for this project.
4. Electrical to coordinate with system supplier to ensure a complete and operational system is achieved.
5. Coordinate changes to drawings with contractors comments provided to you on May 9th, 2017.

**Leviton Mfg. Co., Inc.**

201 North Service Road Melville, NY 11747 Tech Line: 1-800-824-3005 Fax: 1-800-832-9538 www.leviton.com  
© 2009 Leviton Manufacturing Co., Inc. All rights reserved. Subject to change without notice.

**Decora® Timer Switches for Energy Management**

- REVIEWED
- REVIEWED AND MODIFIED
- REVISE AND RESUBMIT
- NOT REVIEWED

**AGENCY STANDARDS AND COMPLIANCE**

- Complies with FCC Part 15, Class B
- CSA Certified (File #152105)
- UL Listed VPT24, LTBxx Series and LTTxx Series (File #E-348909)
- UL Listed 6651 and 6652 (File #E-148771)

**WARRANTY INFORMATION**

- Limited Five-Year Warranty

The review by JRP Engineering is for the sole purpose of ascertaining conformance with the general design concept. This review shall not mean the detail design inherent in the shop drawings are approved, responsibility of which shall remain with the Contractor submitting same and review shall not relieve the Contractor of this responsibility for errors or omissions in the shop drawings or his responsibility for meeting all requirements of the Contract Documents. The Contractor is responsible for dimensions to be confirmed and correlated at the job site, for information that pertains solely to fabrication processes or to techniques of construction and installation and for coordination of the work of all sub-trades.

JRP Engineering  
C.McGuire


DATE: MAY 17th, 2017

**\* MODIFICATIONS:**

1. Provide more info on the GLA-PWS50 for contractors.
2. Contractor to coordinate installation on site with reference to slab conduits that are currently installed.
3. If changes are required to the network layout shown in this shop drawing, the changes are to be marked up or drawings updated for the final As-Built submission for this project.
4. Electrical to coordinate with system supplier to ensure a complete and operational system is achieved.
5. Coordinate changes to drawings with contractors comments provided to you on May 9th, 2017.

Decora® Timer Switches for Energy Management



**DIMENSIONAL DRAWINGS**

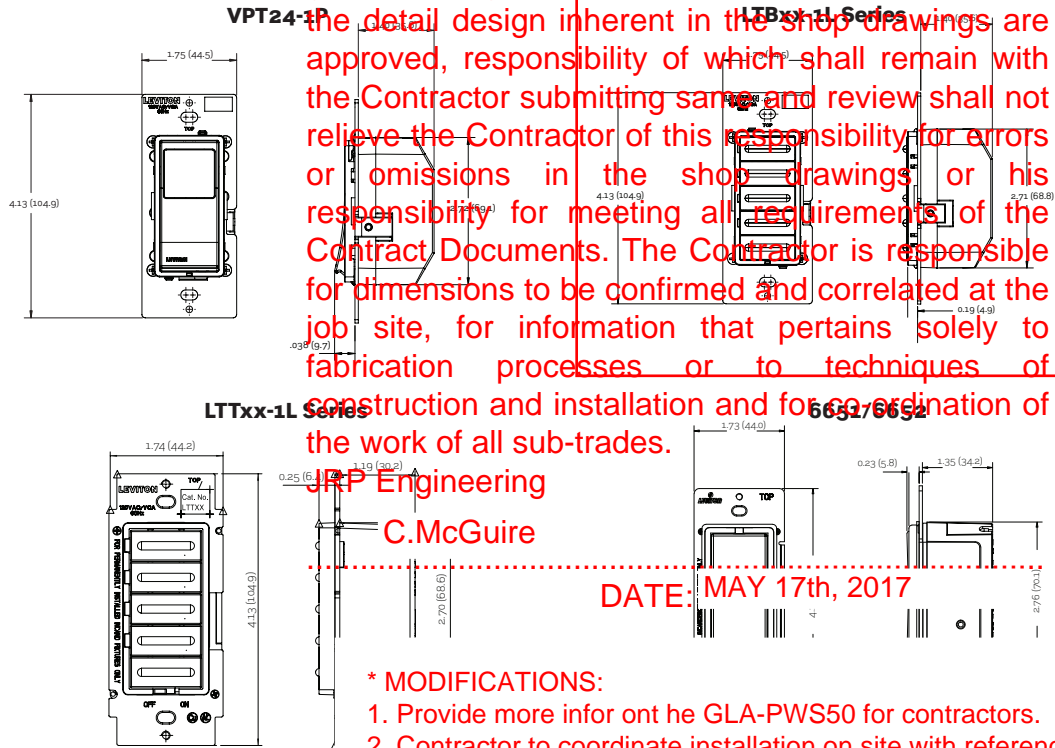

**WIRING DIAGRAMS**

Vizia + Programmable  
Timer Switch

V  
S  
  
Bl:  
W:

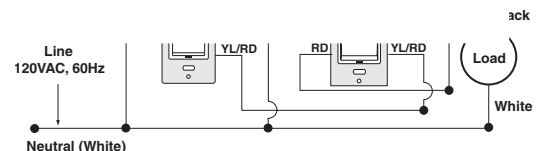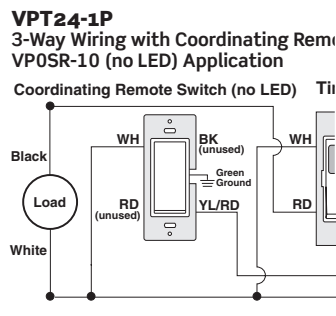




- REVIEWED
- REVIEWED AND MODIFIED
- REVISE AND RESUBMIT
- NOT REVIEWED

**WIRING DIAGRAMS**

5-Button Timer Switch

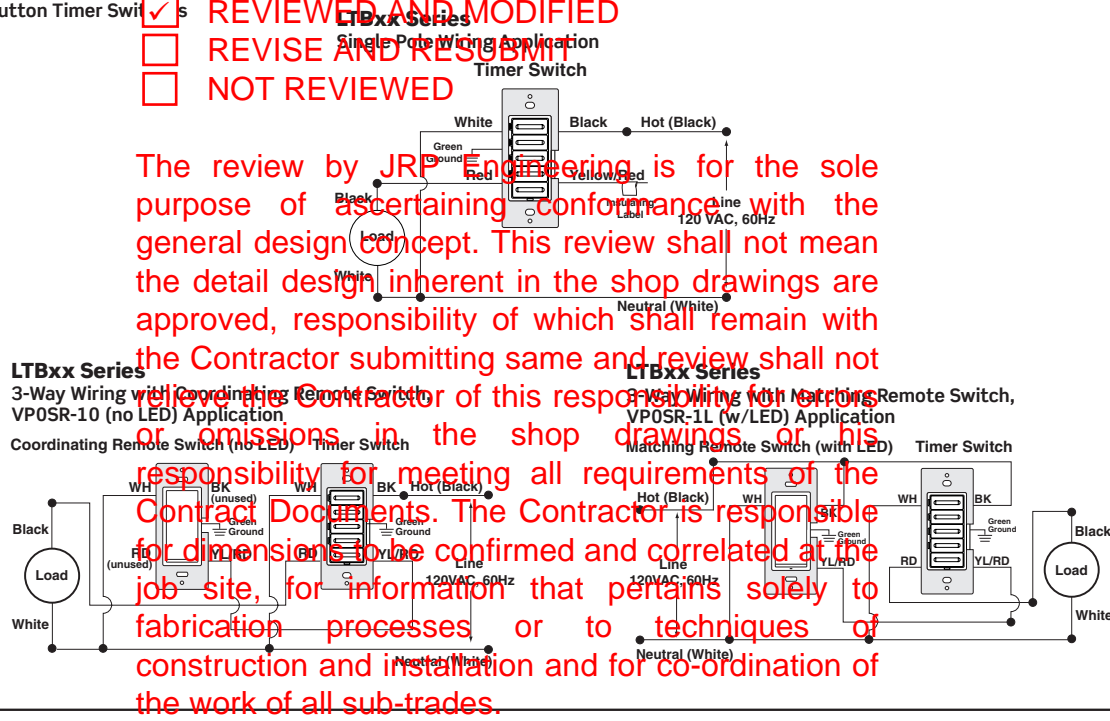

The review by JRP Engineering is for the sole purpose of ascertaining conformance with the general design concept. This review shall not mean the detail design inherent in the shop drawings are approved, responsibility of which shall remain with the Contractor submitting same and review shall not relieve the Contractor of this responsibility for errors or omissions in the shop drawings or his responsibility for meeting all requirements of the Contract Documents. The Contractor is responsible for dimensions to be confirmed and correlated at the job site, for information that pertains solely to fabrication processes or to techniques of construction and installation and for co-ordination of the work of all sub-trades.

JRP Engineering

C.McGuire


DATE: MAY 17th, 2017

**\* MODIFICATIONS:**


1. Provide more information on the GLA-PWS50 for contractors.
2. Contractor to coordinate installation on site with reference to slab conduits that are currently installed.
3. If changes are required to the network layout shown in this shop drawing, the changes are to be marked up or drawings updated for the final As-Built submission for this project.
4. Electrical to coordinate with system supplier to ensure a complete and operational system is achieved.
5. Coordinate changes to drawings with contractors comments provided to you on May 9th, 2017.

6651/6652

Single Pole

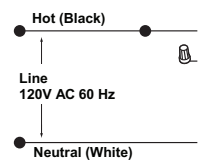

Switch

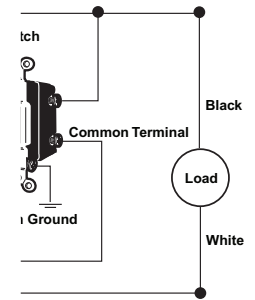

**Leviton Mfg. Co., Inc.**

201 North Service Road Melville, NY 11747 Tech Line: 1-800-824-3005 Fax: 1-800-832-9538 www.leviton.com  
© 2009 Leviton Manufacturing Co., Inc. All rights reserved. Subject to change without notice.

Decora® Timer Switches for Energy Management



**DERATING/MAXIMUM CAPACITY**

In multi-gang installations, all devices must be derated in accordance with the following chart:

Cat. No.	Single Gang	Double Gang	Triple Gang or More
VPT24-1P	No derating required	No derating required	No derating required
6651	No derating required	No derating required	No derating required
6652	No derating required	No derating required	No derating required
LTBxx Series	Resistive: 20A (1800W) Incandescent: 1800W Inductive: 20A (1HP)	Resistive: 16A (1920W) Incandescent: 1800W Inductive: 16A (1HP)	Resistive: 16A (1920W) Incandescent: 1800W Inductive: 16A, Motor: 1HP
LTTxx Series	600W	600W	400W

**ORDERING INFORMATION**

**Decora® Timer Switches** - Programmable Electronic Timer Switches, Single Pole or 3-Way

Cat. No.	Description	Rating	Color
VPT24-1L	Vizia +® 24 Hour, with astronomical clock, neutral required	1800W Incandescent, 16A Resistive/Inductive, 1 HP @ 120VAC	Z
6651	14 hour programmable in 1 hour intervals	500W Incandescent @ 120VAC	W, I
6652	Variable countdown, 1 minute to 18 hour intervals, neutral required	500W Incandescent, 500VA Rapid Start Relay (UL only), 1 HP @ 120VAC	W, I, A

**5-Button Timer Switches** - Four Preset Functions

Single Pole or 3-Way, Neutral Required, 1800W Incandescent, 20A Resistive/Inductive, 1 HP @ 120VAC

Cat. No.	Description	Interval	Color*
LTB15-1L	15 minute	2-5-10-15 minutes	Z
LTB30-1L	30 minute	5-10-15-30 minutes	Z
LTB60-1L	60 minute	5-10-15-30 minutes	Z
LTB02-1L	2 hour, Title 24 Compliant	5-10-15-30 minutes	Z
LTB12-1L	12 hour	5-10-15-30 minutes	Z

Single Pole, Neutral Not Required, 600W Incandescent, 5A Resistive

Cat. No.	Description	Interval	Color*
LTT30	30 minute	5-10-15-30 minutes	I, W, T
LTT60	60 minute	10-20-30-60 minutes	I, W, T

Color Change Kits

Cat. No.	Description	C.McGuire	Color*
VPTKT	Vizia + 24 Hour Timer Color Change Kit		
LTBKT	5-Button Timer Color Change Kit		W, I, I, E, B

\*To order colors, add suffix to basic Cat. No. Products with suffix -Z are packaged 3 per gang.

Color Change Kits in White (-W), Ivory (-I),

**Leviton Manufacturing Co., Inc.**  
201 North Service Road, Melville, NY 11747-3138  
Telephone: 1-800-323-8920 • Fax: 1-800-832-9555

**Leviton Manufacturing of Canada, Inc.**  
165 Hymus Boulevard, Pointe Claire, Quebec H9F 1Y1

**Leviton S. de R.L. de C.V.**  
Lago Tana 43, Mexico DF, Mexico CP 11290 • Tel: 52-55-55-11-11

Decora and Vizia + are registered trademarks of Leviton Manufacturing Co., Inc.

Visit our website at [www.leviton.com](http://www.leviton.com)  
© 2009 Leviton Manufacturing Co., Inc. All rights reserved.

The review by JRP Engineering is for the sole purpose of ascertaining conformance with the general design concept. This review shall not mean the detail design inherent in the shop drawings are approved, responsibility which shall remain with the Contractor submitting same and review shall not relieve the Contractor of this responsibility for errors or omissions in the shop drawings or his responsibility for meeting all requirements of the Contract Documents. The Contractor is responsible for dimensions to be confirmed and correlated at the job site, for information that pertains solely to fabrication processes or to techniques of construction and installation and for co-ordination of the work of all sub-trades.  
JRP Engineering

DATE: MAY 17th, 2017

**\* MODIFICATIONS:**

1. Provide more information on the GLA-PWS50 for contractors.
2. Contractor to coordinate installation on site with reference to slab conduits that are currently installed.
3. If changes are required to the network layout shown in this shop drawing, the changes are to be marked up on drawings updated for the final As-Built submission for this project.
4. Electrical to coordinate with system supplier to ensure a complete and operational system is achieved.
5. Coordinate changes to drawings with contractors comments provided to you on May 9th, 2017.

Decora® Timer Switches for Energy Management

