



SUPPLEMENTAL INSTRUCTION

CONTRACTOR:
Tal-co Building Innovations
Address:
Suite 2, 1341 Coker Street
Greely, Ontario, K4P 1A1

PROJ.: **Boys and Girls Club Prince of Wales**
PROJ. No.: **1716**
DATE: **Feb 05, 2018**
S.I. No. **S.I. - 011**

Supplemental Instructions are issued to the Construction Manager to record a clarification or revision to the previously issued Contract Documentation as reflected by the attached Information Bulletin prepared by the identified Consultant.

The Construction Manager shall review the Supplemental Instruction and the attached Information Bulletin and issue to the effected Trade Contractors identifying the following course of action by the trade contractor:

- Proceed with Instruction. Issued for general information, no change to Contract price or schedule. (Site Instruction)
- Proceed with Instruction and provide a quotation within 10 days, identifying change to Contract price and schedule (Change Directive)
- Do not proceed. Provide quotation identifying change to Contract price and schedule within 10 days. (CCO)

Partners

Barry J. Hobin
OAA, FRAIC, Hon. Fellow AIA

William A. Davis
OAA, MRAIC, Associate AIA

Gordon Lorimer
OAA, FRAIC, Associate AIA

Wendy Brawley
OAA, MRAIC, Associate AIA

Douglas Brooks
Senior Arch. Tech.

Associates

Bryan Bonell
OAA, MRAIC, Associate AIA

Marc Thivierge
OAA, MRAIC

William Ritcey
MRAIC

Reinhard Vogel
Senior Arch. Tech.

1.1 TITLE
Updated Mechanical and Electrical Drawings Issued for Tender

1.2 DESCRIPTION OF THE WORK
.1 Updated mechanical and electrical drawings for tender

1.3 ATTACHMENTS
B&G POW Mech Phase 2 Rev1 TENDER.pdf
B&G POW Elec E-1 to E-8 TENDER 2018-02-06.pdf

1.4 REASON
Drawings revised to reflect demolition and changes to cost savings measures.

Hobin Architecture Incorporated


63 Pamilla Street
Ottawa, Ontario
Canada K1S 3K7

t 613-238-7200
f 613-235-2005

hobinarc.com

Distribution:

- | | | | | |
|--|--|--|----------------------------------|--------------------------------------|
| <input checked="" type="checkbox"/> Owner | <input type="checkbox"/> City Authority | <input checked="" type="checkbox"/> Electrical | <input type="checkbox"/> Struct. | <input type="checkbox"/> Landscaping |
| <input checked="" type="checkbox"/> Contractor | <input checked="" type="checkbox"/> File | <input checked="" type="checkbox"/> Mech. | <input type="checkbox"/> Civil | <input type="checkbox"/> Other |

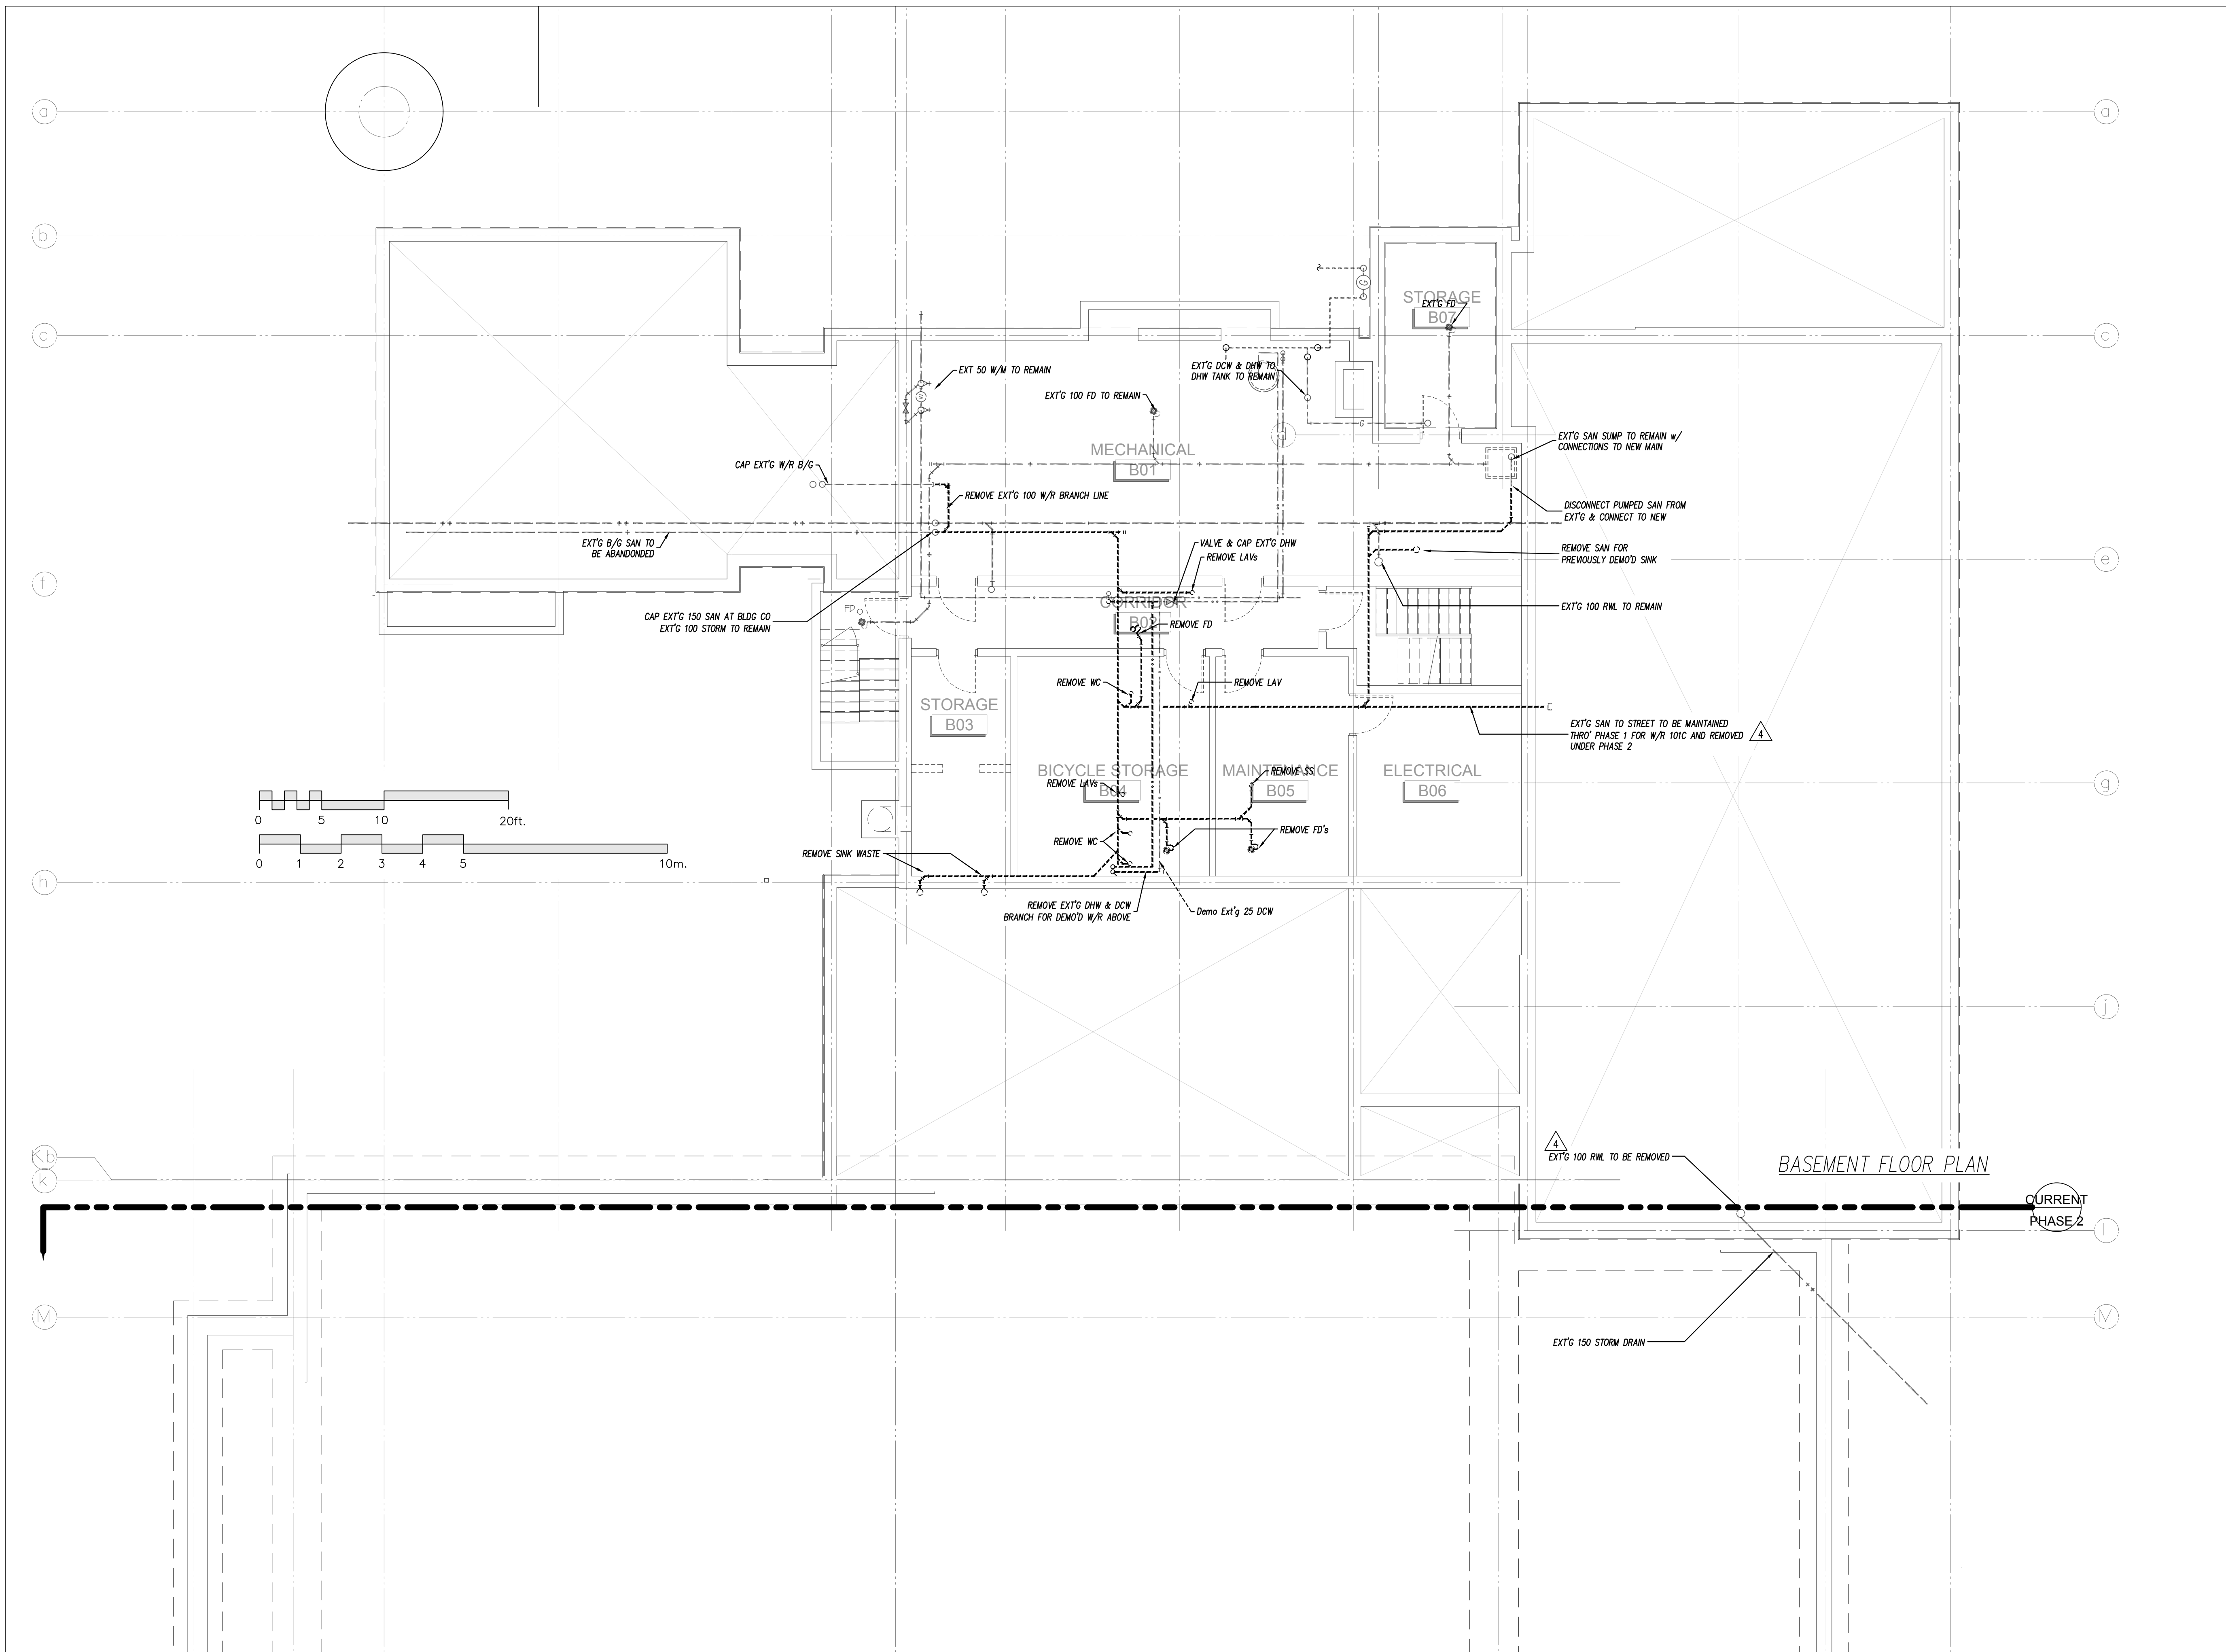

10.		
9.		
8.		
7.		
6.		
5.		
4.	ISSUED FOR TENDER	01-FEB-2018
3.	ISSUED FOR PRICING	22-DEC-2017
2.	ISSUED FOR PHASE II PERMIT	27-OCT-2017
1.	ISSUED FOR PERMIT (CITY PERMIT NUMBER: ??)	2-FEB-18
NO.	REVISIONS	DATE


USE OF THESE DRAWINGS IS RESTRICTED SOLELY TO THE CONSTRUCTION FOR WHICH THEY WERE DEVELOPED. BEKOLAY AND ASSOCIATES LTD. ASSUME NO RESPONSIBILITY FOR ANY SUBSEQUENT USE. DO NOT SCALE THE DRAWINGS BUT RESPECT ANY DIMENSIONS SPECIFICALLY IDENTIFIED IN NOTES OR TEXT. ALL CONTRACTORS MUST VISIT THE SITE AND ARE RESPONSIBLE FOR VERIFYING ANY AND ALL DIMENSIONS THAT RELATE TO THEIR WORK. REPORT ANY DISCREPANCIES IMMEDIATELY TO THE CONSULTANT.

BEKOLAY & Associates, Ltd.
 Consulting Engineers
 200-1827 WOODWARD DR. OTTAWA
 ON K1H 3T6 CANADA
 TEL: 613-735-5400 FAX: 613-735-0884
 EMAIL: jbekolay@bkg.ca


7-Oct-14
 PROJECT: BOYS & GIRLS CLUB RENOVATION
 Prince of Wales
 DRAWING: BASEMENT
 PLUMBING DEMOLITION

DATE: ### SCALE: 1:75
 DRAWN BY: Staff DESIGNED BY: JRB
 JOB NO.: 2017-17 CHECKED BY:
 DRAWING NO.:
 M-2 of 6




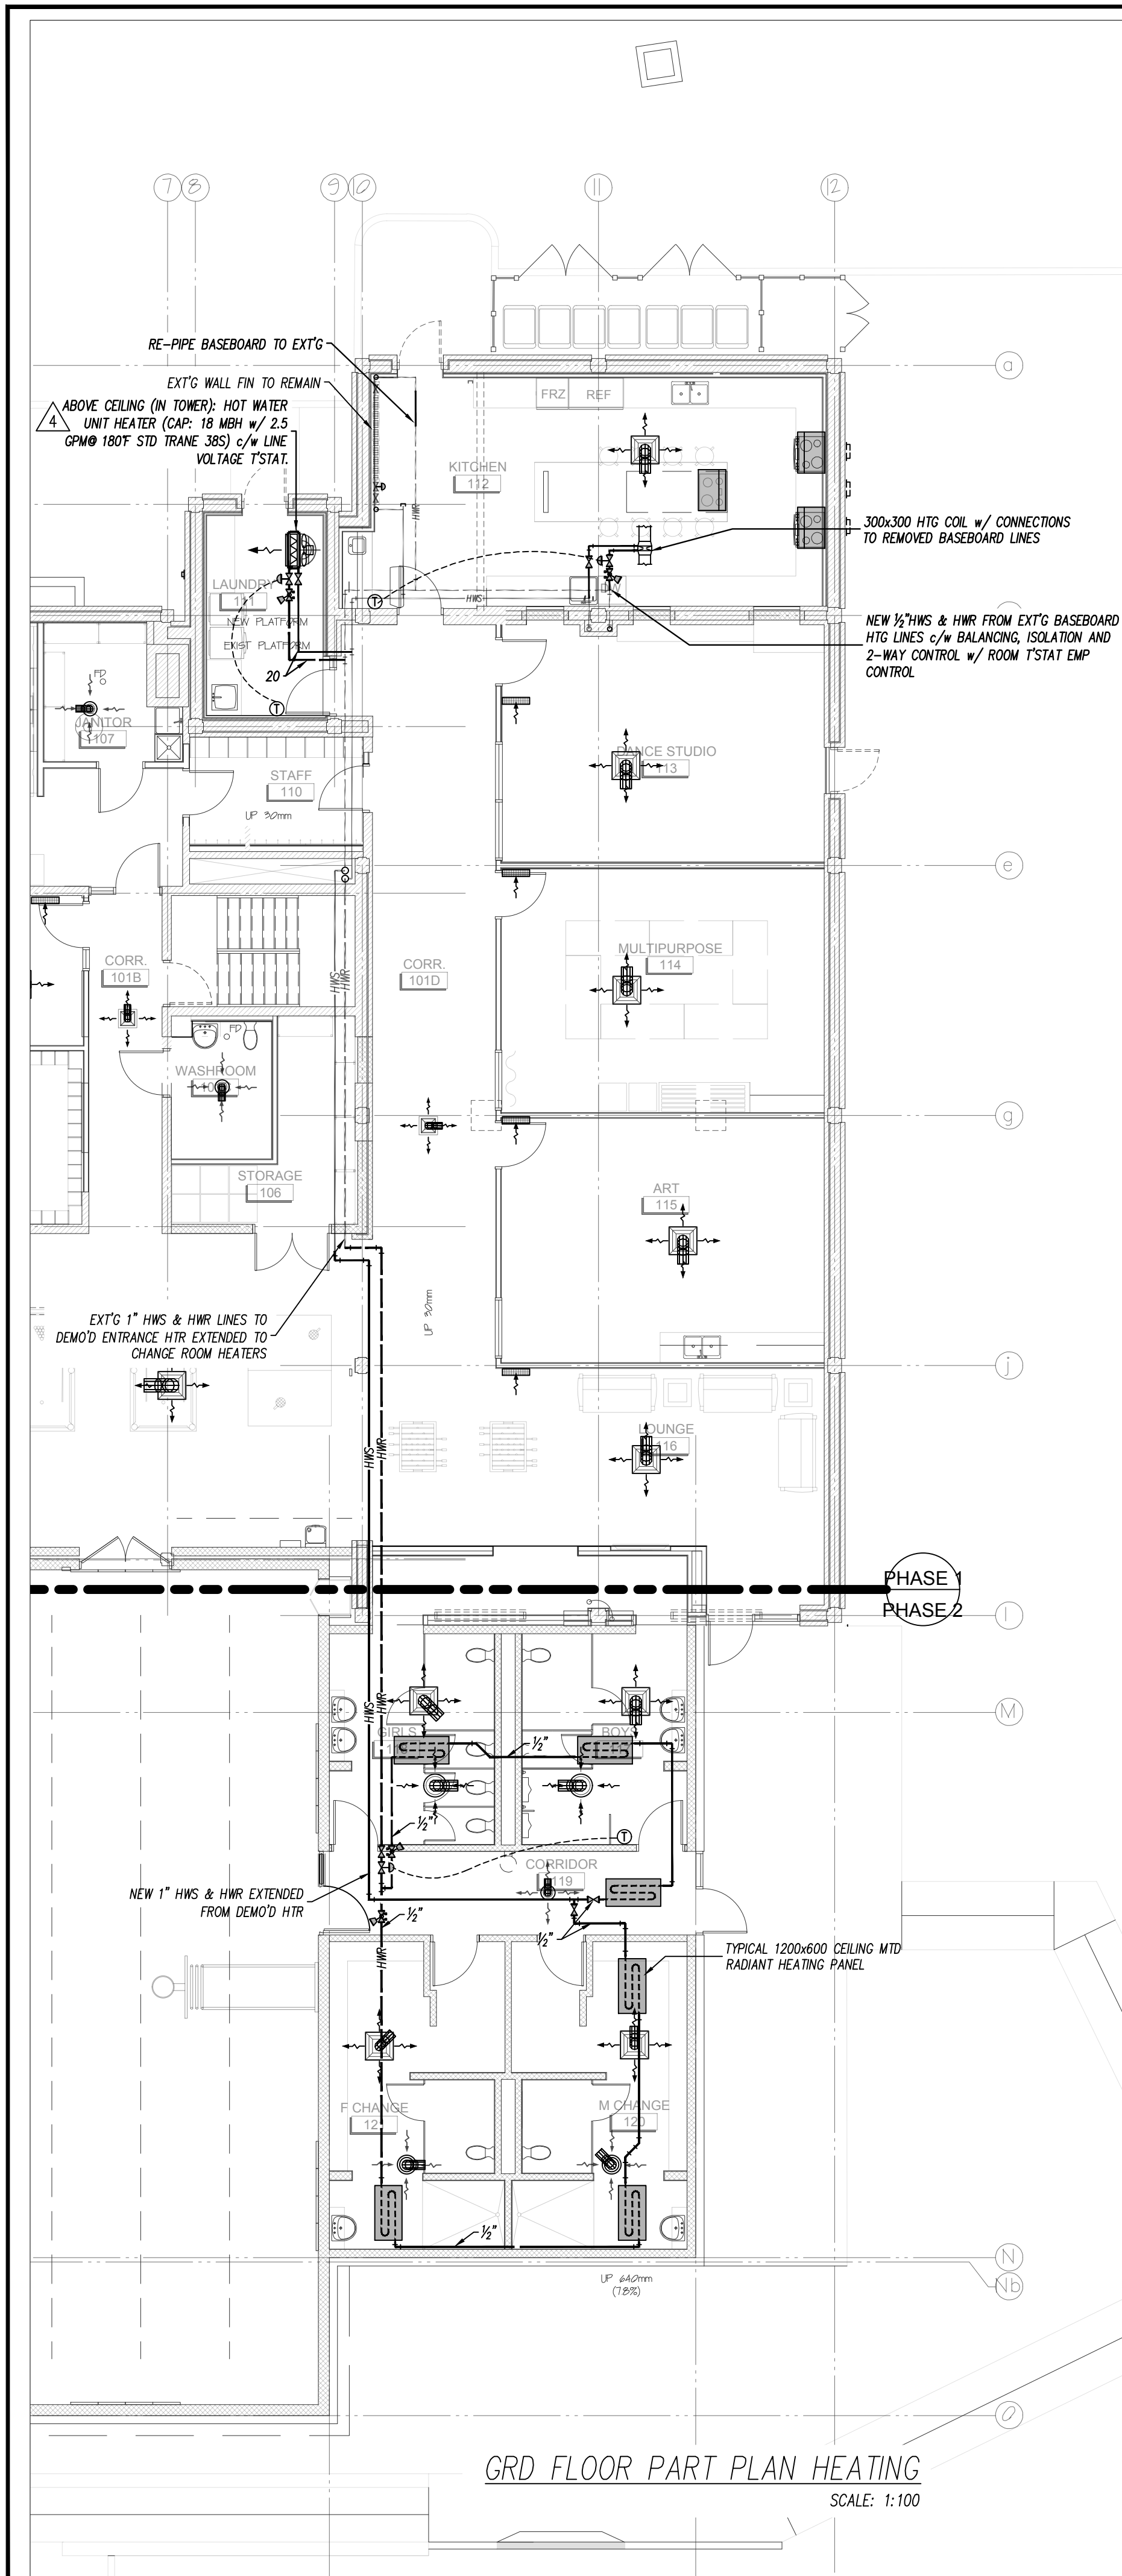

GRD FLOOR PART PLAN HEATING
SCALE: 1:100

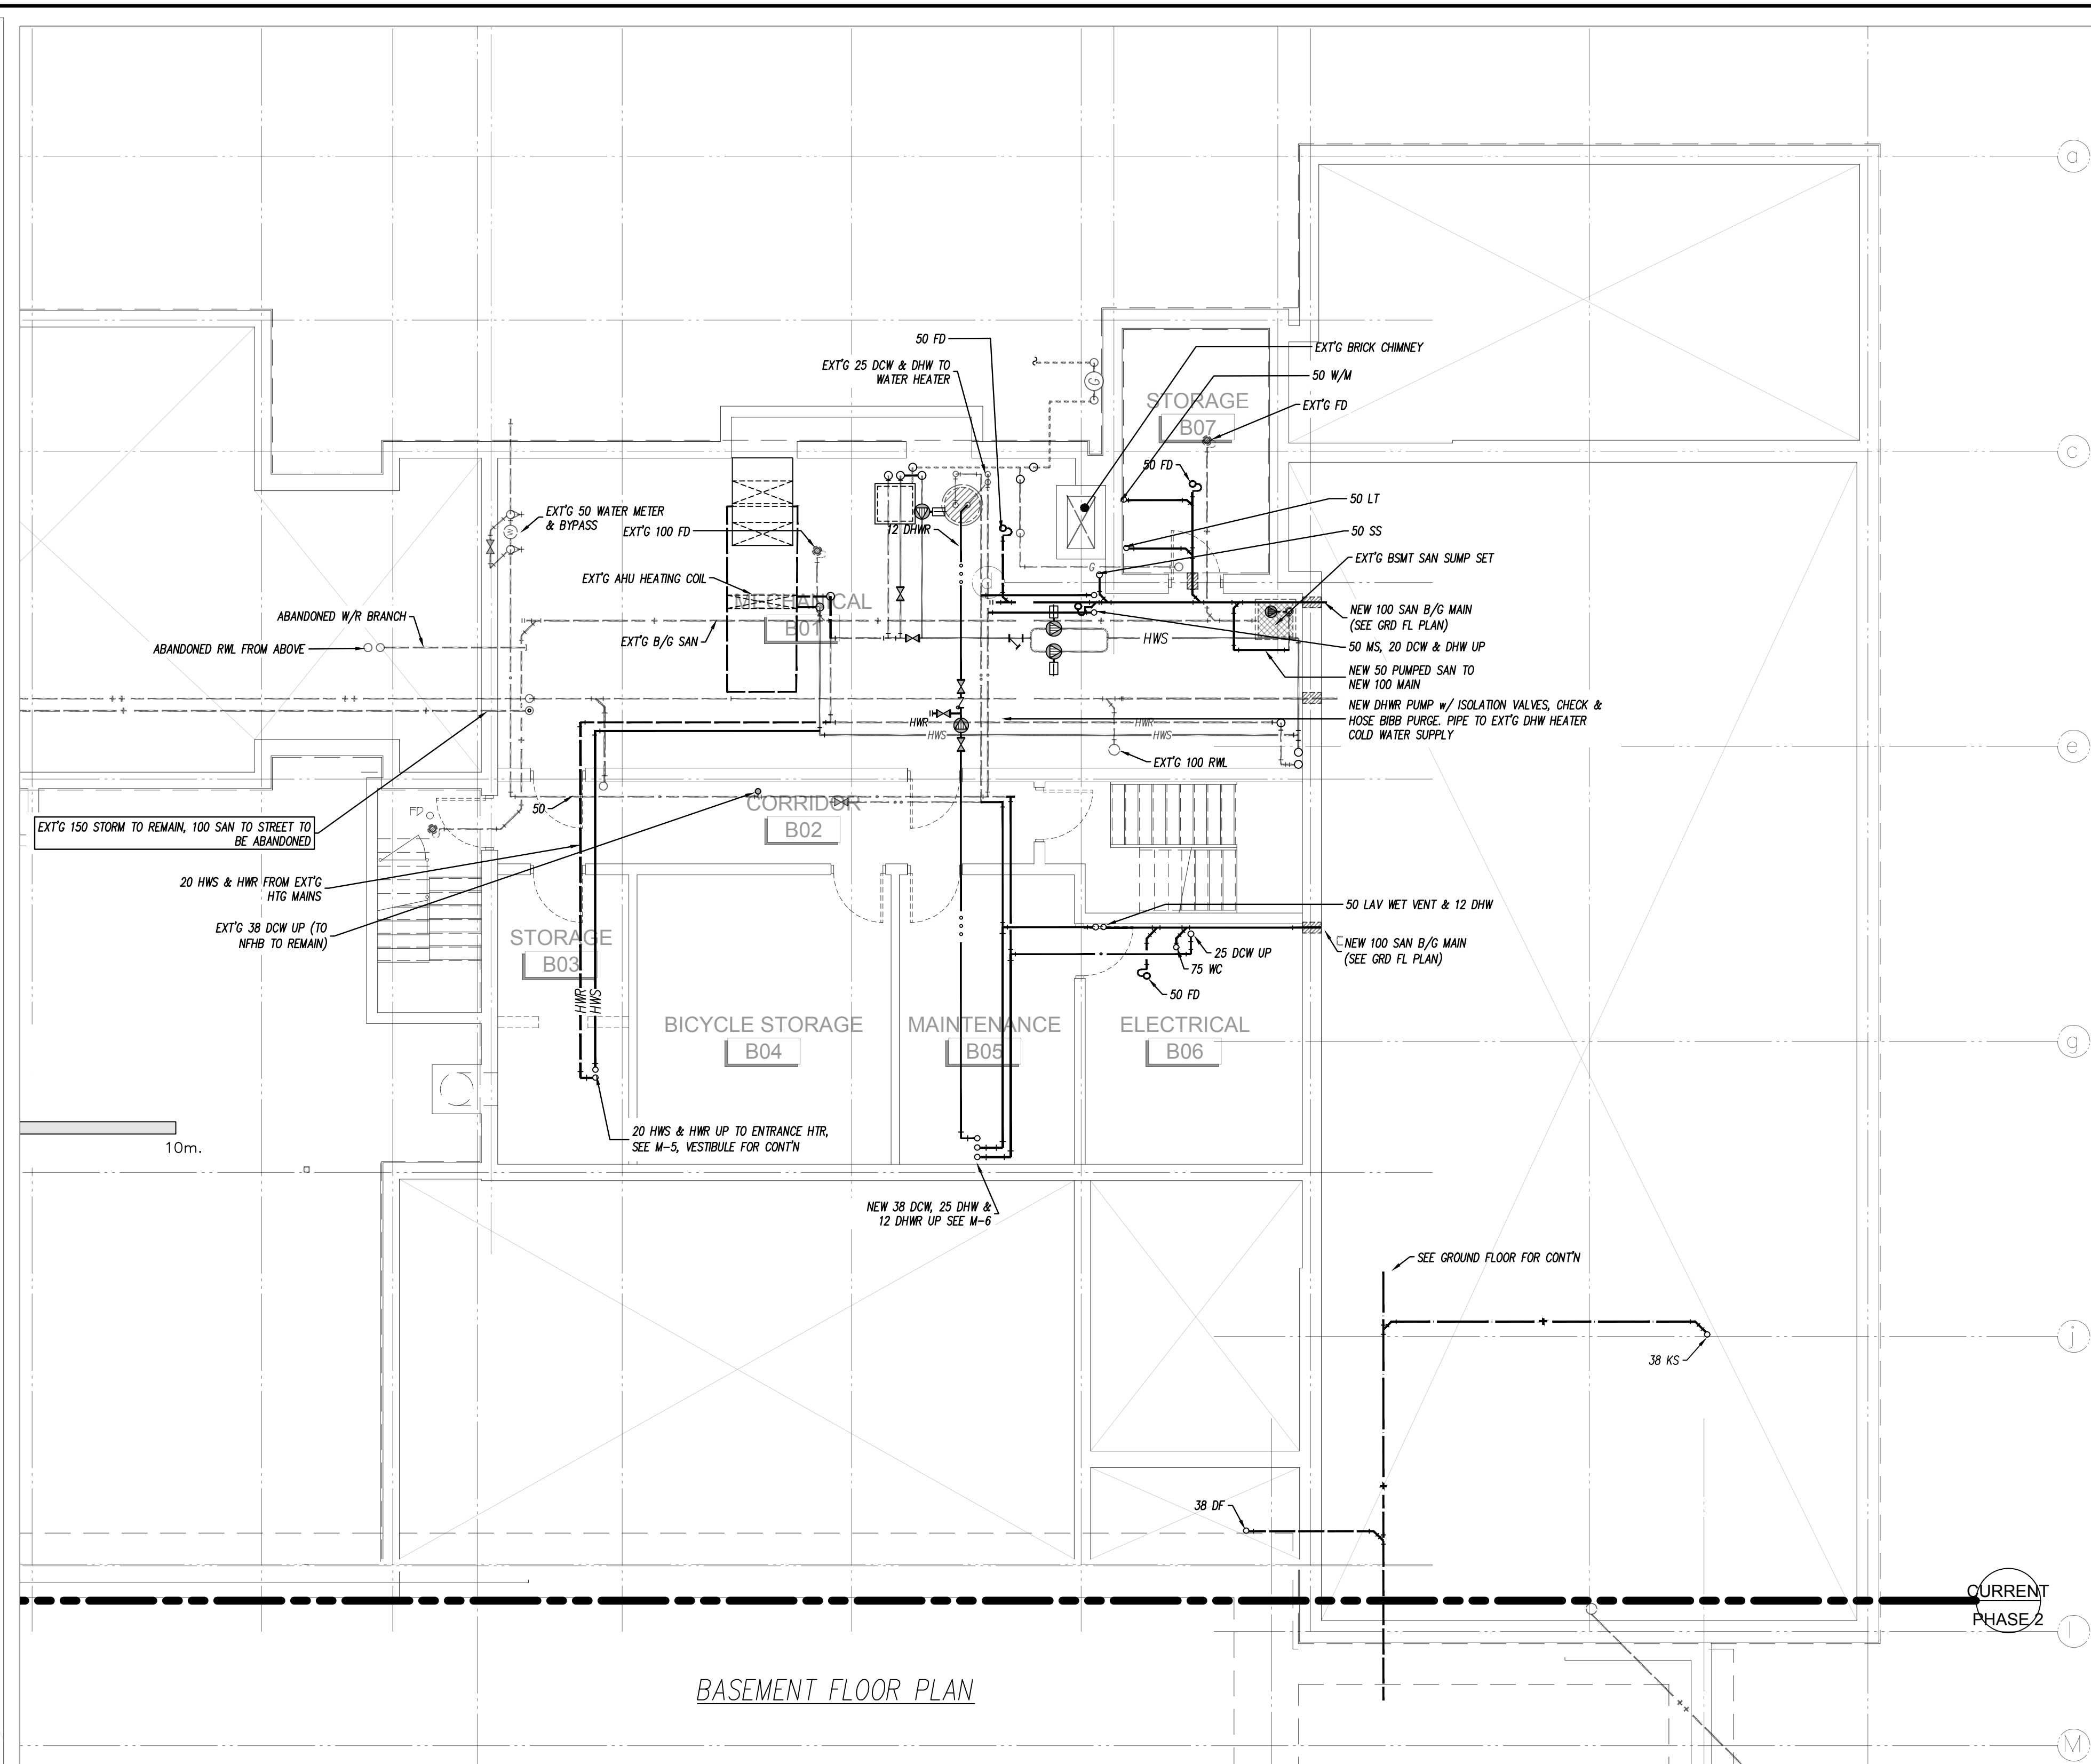

BASEMENT FLOOR PLAN

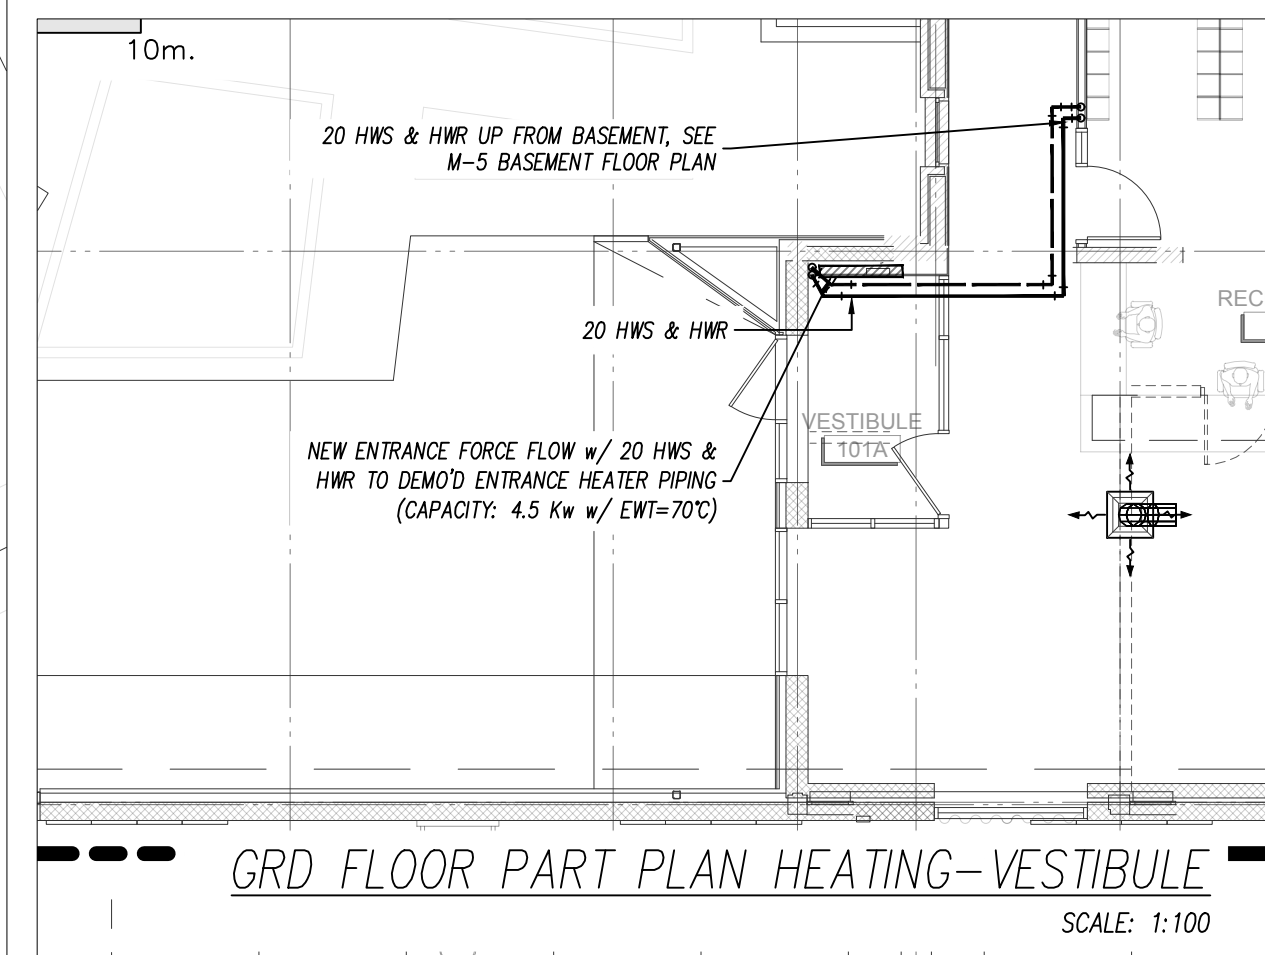

GRD FLOOR PART PLAN HEATING-VESTIBULE
SCALE: 1:100

SPECIFICATIONS CONT'D.

Plumbing & Piping:

19. Water Piping:
 - .1 Potable water piping shall be type 'M' copper with 95-5 lead free solder joints and fittings.
 - .2 Isolating valves: equal to Crane 1324, 438 (gate) or 9322 (ball).
 - .3 Rigidly fasten water supplies to the internal wall structure and secure with wing back elbow. Extend with chrome plated nipple protruding through wall finish and terminate with chrome plated straight or angle ball valve complete with chrome escutcheon. Extend to fixture with braided stainless steel supplies. Copper pipe roughing at this location is not acceptable.
20. Plumbing Piping
 - .1 Plumbing and vent piping above grade:
 - (a) NPS 1-1/2" and smaller DWV copper with solder joints
 - (b) NPS 2" and larger shall be cast iron with MJ neoprene couplings
 - Or
 - (b) System 15-50 PVC DWV solvent weld pipe and fittings with suitable fire stopping. Note regular PVC is not acceptable and shall not be installed.
 - (c) Extend vent piping from all plumbing fixtures to vent stacks through roof complete with weatherproof flashing to comply with OBC.
 - (d) Provide plumbing and vent connections to all fixtures with chrome plate traps with cleanouts. Brass or plastic not acceptable. Provide trap insulation for barrier free sinks.
 - (e) Floor drain trap seal primer: all brass with integral vacuum breaker, NPS 12mm continuous soft copper line drip line connection with tapping on drain body
- .2 Plumbing and vent piping below grade
 - (a) PVC or ABS with solvent weld joints or
 - (b) SRD with ringtile joints
 - (c) Provide 150mm of compacted sand bedding in the bottom of all trenches. After inspection by the Engineer cover and compact at least 150mm of sand over piping. Granular fill in contact with the piping is not acceptable
21. Vent Storm Collar:
 - (a) Spun aluminum collar to be set and caulked at pipe for flashed into the roof by GC.
 - (b) Std: Platinum Technologies series Vent Stack or Storm Collar

21. Washing Machine wall box:

- (a) Single lever, brass shut-off for hot and cold water hose bibb connections
- (b) Plastic wall box with finishing cover, stud support and 38mm brass sanitary drain pan and connection.
- (c) Be advised, hose bibbs in a box will be rejected.
- (d) Std: Symmons "Laundry Mate" or Watts DuoClazure DWB with 2-M2 Shutoff valve

22. Hangers:

- .1 Uninsulated Copper Pipe (Any system):
 - (a) Split Ring metal support ring with integral rod connection and EPDM corrugated pipe ring.
 - (b) Clevis hangers and tape are not acceptable.
 - (c) Std: Caddy Superfix Series 454
 - (d) 32mm and smaller
 - .i Swivel loop hanger with electro-zinc plated band with hanger rod nut
 - .ii Std: Caddy Series 100
 - (e) 38mm and larger
 - .i epoxy coated split black iron clevis
 - .ii Std: Caddy Series 401, 427 or 420

NO.	REVISIONS	DATE
10.		
9.		
8.		
7.		
6.		
5.		
4.	ISSUED FOR TENDER	01-FEB-2018
3.	ISSUED FOR PRICING	22-DEC-2017
2.	ISSUED FOR PHASE II PERMIT	27-OCT-2017
1.	ISSUED FOR PERMIT (CITY PERMIT NUMBER: ??)	2-FEB-18

USE OF THESE DRAWINGS IS RESTRICTED SOLELY TO THE CONSTRUCTION FOR WHICH THEY WERE DEVELOPED. BEKOLAY AND ASSOCIATES LTD. ASSUME NO RESPONSIBILITY FOR ANY SUBSEQUENT USE. DO NOT SCALE THE DRAWINGS BUT RESPECT ANY DIMENSIONS SPECIFICALLY IDENTIFIED IN NOTES OR TEXT. ALL CONTRACTORS MUST VISIT THE SITE AND ARE RESPONSIBLE FOR VERIFYING ANY AND ALL DIMENSIONS THAT RELATE TO THEIR WORK. REPORT ANY DISCREPANCIES IMMEDIATELY TO THE CONSULTANT.

BEKOLAY & Associates, Ltd.
Consulting Engineers
200-1827 WOODWARD DR., OTTAWA
ON K1H 8T9
PH: 613-723-0476, FAX: 613-723-0886
www.bekolay.com

PROJECT: BOYS & GIRLS CLUB RENOVATION
Prince of Wales
DRAWING: GROUND FLOOR HEATING &
BASEMENT PLUMBING


DATE	SCALE
###	1:75
DRAWN BY Staff	DESIGNED BY JRB
JOB NO. 2017-17	CHECKED BY
DRAWING NO. 2-Feb-18	



SPECIFICATIONS CONT'D:

Plumbing & Piping:

- 23. Plumbing Fixtures:**
- .1 Lavatories L-1:
 - (a) Semi-counter vitreous china, universal design, wall-hung sink meeting the requirements for barrier free design c/w insulated trap or knee guard.
 - .i Std: American Std. Mezzo
 - (b) Trim: 1.9 L/min chrome plated, battery operated electronic faucet, single faucet, adjustable sensor set point, 90 second max run time and aerator. Provide chrome plated waste strainer, trap with cleanout.
 - .i Std: Delta Model HDF commercial DEMD 111F Series or Wattec Moen equivalents
 - .2 SS Sinks
 - (a) KS-1
 - .i Double bowl 18-8 stainless steel, 840x560x180mm (33"x22 1/4"x7"), ledge back, kitchen sink with overflow partition, 380x430 (15x17) bowls, basket strainers, rim seal, brass trap with cleanout
 - .ii Std: Kindred, Steel Queen EDL2233
 - (b) KS-2
 - .i Single bowl, 400x350x180mm (16"x14"x7") stainless steel, ledge back, kitchen sinks with strainer, trap and single lever kitchen faucet
 - .ii Std: Kindred, Steel Queen LBS4607
 - (c) Hand Sink:
 - .i Single bowl (bar sink) 285x235x152mm (11.625x9.25"x6") stainless steel, ledge back, kitchen sinks complete with strainer, trap
 - .ii Std: Kindred, Steel Queen LBS9106 with Chicago Faucet 2300-8 Trim
 - (d) Trim: Single lever (barrier free compliant), stainless steel and brass construction chrome finish, pressure balanced replaceable cartridge with integral pull out spray head, high arching spout equal to Delta model 472
 - .3 Water closets
 - (a) Seat: white, open front, molded plastic (with slow close cover for handicapped) and stainless steel check hinge and insert post. Centoco 500 (or 820) or equivalent.
 - (b) 1/2" Chrome plated angle ball valve with chrome nipple & wall escutcheon, braided stainless steel flexible supply.
 - (c) WC-1:
 - .i ADA compliant wall hung vitreous china elongated bowl with 4.2 Lpf, with floor carrier
 - .ii Std: American Std: Afiwall "FluWise"
 - (d) WC-2:
 - .i ADA compliant floor mounted vitreous china elongated bowl with 4.2 Lpf
 - .ii Std: American Std.
 - (e) Flush Valve:
 - .i 4.2 Lpf hard wired A/C powered dual flush with hands free sensor & electronics and manual flush c/w 120 V transformer, wall flange, angle stop w/ BFP, vandal resistant covers, chrome finish
 - .ii Std: American Std: Electronic FluWise Exposed
 - .4 Service Sink:
 - (a) Crane 6-296 enamelled steel single compartment Laundry Tub
 - (b) Baked enamel stand
 - (c) C-5040 rough brass trim and trap
 - .5 Map Sink:
 - (a) Moulded stone, 550x450x300mm deep complete with cast brass outlet strainer, stainless steel rim guard, continuous on three sides, bolted to the rim
 - (b) Std: American Std. AB-7692-0230, Crane 7-525, Fiat TSB-100
 - (c) Trim:
 - .i Built-in elevated vacuum breaker, cast brass spout, 400mm long rubber hose, indexed cross handles, escutcheons, union inlets, heavy cast brass spout with pull hook, braided to the wall, integral stop valves
 - .ii Std: Cambridge Brass S314333, Crane CH-8560, Emco 390 XXBE, Fiat 830 AA, Chicago Faucet
 - .6 Floor drains:
 - (a) General duty, round cast iron body, adjustable head and nickel bronze strainer.
 - (b) Std: Ancon FD-100 or equal
- 24. DHW Re-Circulation Pump**
- .1 Stainless steel body, cartridge type pump with, built in check
 - .2 Capacity: 5 GPM @ 20ft
 - .3 Electrical: 120V/60 w/ 24 hour timer/aquastat combination, and plug in cord.
 - .4 Std: Taco 009-IFC w/ Timer Aquastat.
- 25. Natural Gas Piping**
- .1 Provide natural gas piping from Enbridge meter to building gas fired equipment.
 - .2 Conform to Ontario gas Utilization Code B149. (current version) including installation and testing.
- 26. Heating:**
- .1 Piping: Sch. 40 black with M screwed fittings
 - .2 Coil:
 - (a) 2 row copper tube, aluminum fin
 - (b) Cap. = 75F, LAT= 125 F, APD= 0.15" Wg
20 MBH, EW=175F. LWT= 155F
 - .3 Control: low voltage wall mounted t'stat with 2-way control valve
- 27. Unit Heaters:**
- .1 Direct drive, propeller, horizontal unit heater with copper tube, aluminum fin coils, line voltage thermostats
 - .2 Capacity: 18 MBH w/ 15TDT, 2.5 GPM EWT 180F, 0.04 Ft WPD
 - .3 Electrical: totally enclosed motors -1/20 HP, 110V w/ line voltage t'stat
 - .4 Std: Trand 365
- 28. Fire Extinguishers**
- .1 Recessed, prime coated steel cabinet with 25mm return, glass window in the latched door at each fire exit.
 - .2 Extinguisher ABC-5
 - .3 Std: National Fire Equipment Ltd. Model 102
- 30. Unit Heaters:**
- .1 Direct drive, propeller, horizontal unit heater with copper tube, aluminum fin coils, line voltage thermostats
 - .2 Capacity: 30 MBH w/ 16 GPM 50-50 glycol, EWT 140F, 4 Ft Pressure drop
 - .3 Electrical: totally enclosed motors -1/20 HP, 110V
 - .4 Std: Trand 805

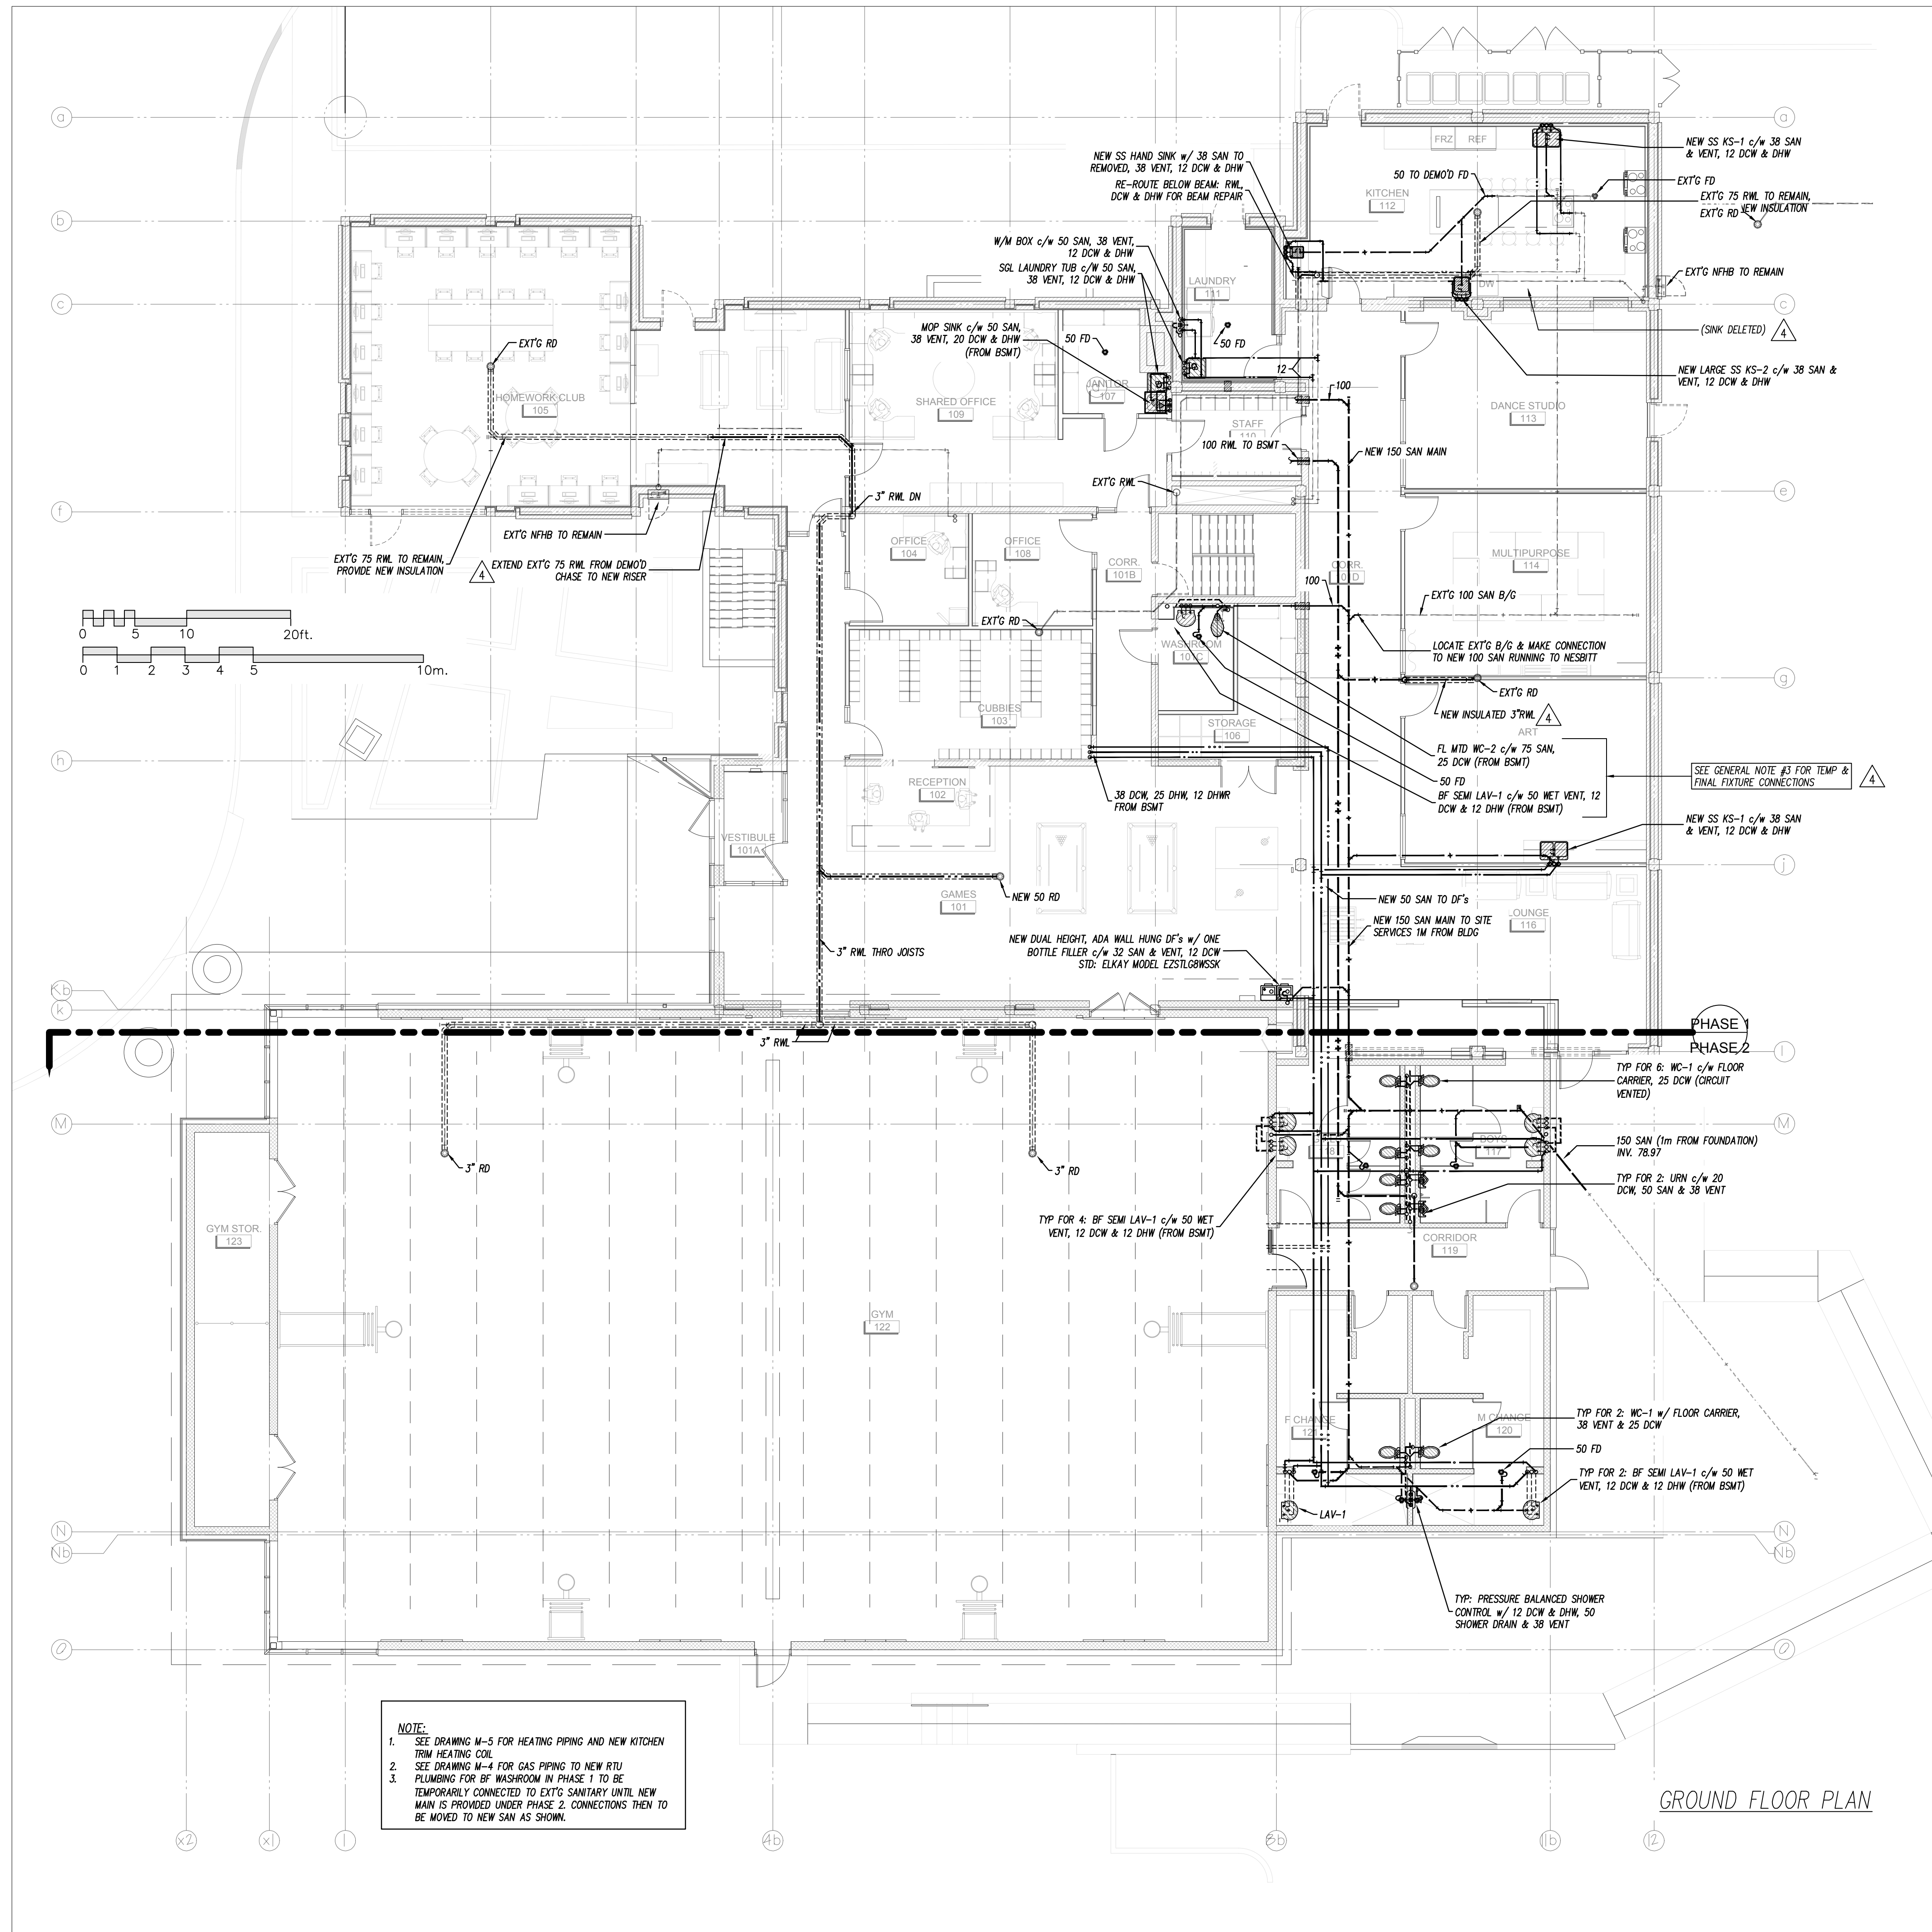

NOTE:

1. SEE DRAWING M-5 FOR HEATING PIPING AND NEW KITCHEN TRIM HEATING COIL
2. SEE DRAWING M-4 FOR GAS PIPING TO NEW RTU
3. PLUMBING FOR BF WASHROOM IN PHASE 1 TO BE TEMPORARILY CONNECTED TO EXT'G SANITARY UNTIL NEW MAIN IS PROVIDED UNDER PHASE 2. CONNECTIONS THEN TO BE MOVED TO NEW SAN AS SHOWN.

GROUND FLOOR PLAN

NO.	REVISIONS	DATE
10.		
9.		
8.		
7.		
6.		
5.		
4.	ISSUED FOR TENDER	01-FEB-2018
3.	ISSUED FOR PRICING	22-DEC-2017
2.	ISSUED FOR PHASE II PERMIT	27-OCT-2017
1.	ISSUED FOR PERMIT	2-FEB-18
	(CITY PERMIT NUMBER: ??)	

USE OF THESE DRAWINGS IS RESTRICTED SOLELY TO THE CONSTRUCTION FOR WHICH THEY WERE DEVELOPED. BEKOLAY AND ASSOCIATES LTD. ASSUME NO RESPONSIBILITY FOR ANY SUBSEQUENT USE. DO NOT SCALE THE DRAWINGS BUT RESPECT ANY DIMENSIONS SPECIFICALLY IDENTIFIED IN NOTES OR TEXT. ALL CONTRACTORS MUST VISIT THE SITE AND ARE RESPONSIBLE FOR VERIFYING ANY AND ALL DIMENSIONS THAT RELATE TO THEIR WORK. REPORT ANY DISCREPANCIES IMMEDIATELY TO THE CONSULTANT.


BEKOLAY & Associates Ltd.
 Consulting Engineers
 200-187 WOODBINE DR. OTTAWA
 ON K1H 3S7 CANADA TEL: 613-238-0866
 email: bekolay@beka.com

7-Oct-14


PROJECT: **BOYS & GIRLS CLUB RENOVATION**
 Prince of Wales

DRAWING: **GROUND PLUMBING MODIFICATIONS**

DATE	###	SCALE
2-Feb-18	J.R. BEKOLAY	1:100
2017-17	Staff	DESIGNED BY JRB
		CHECKED BY
		DRAWING NO.

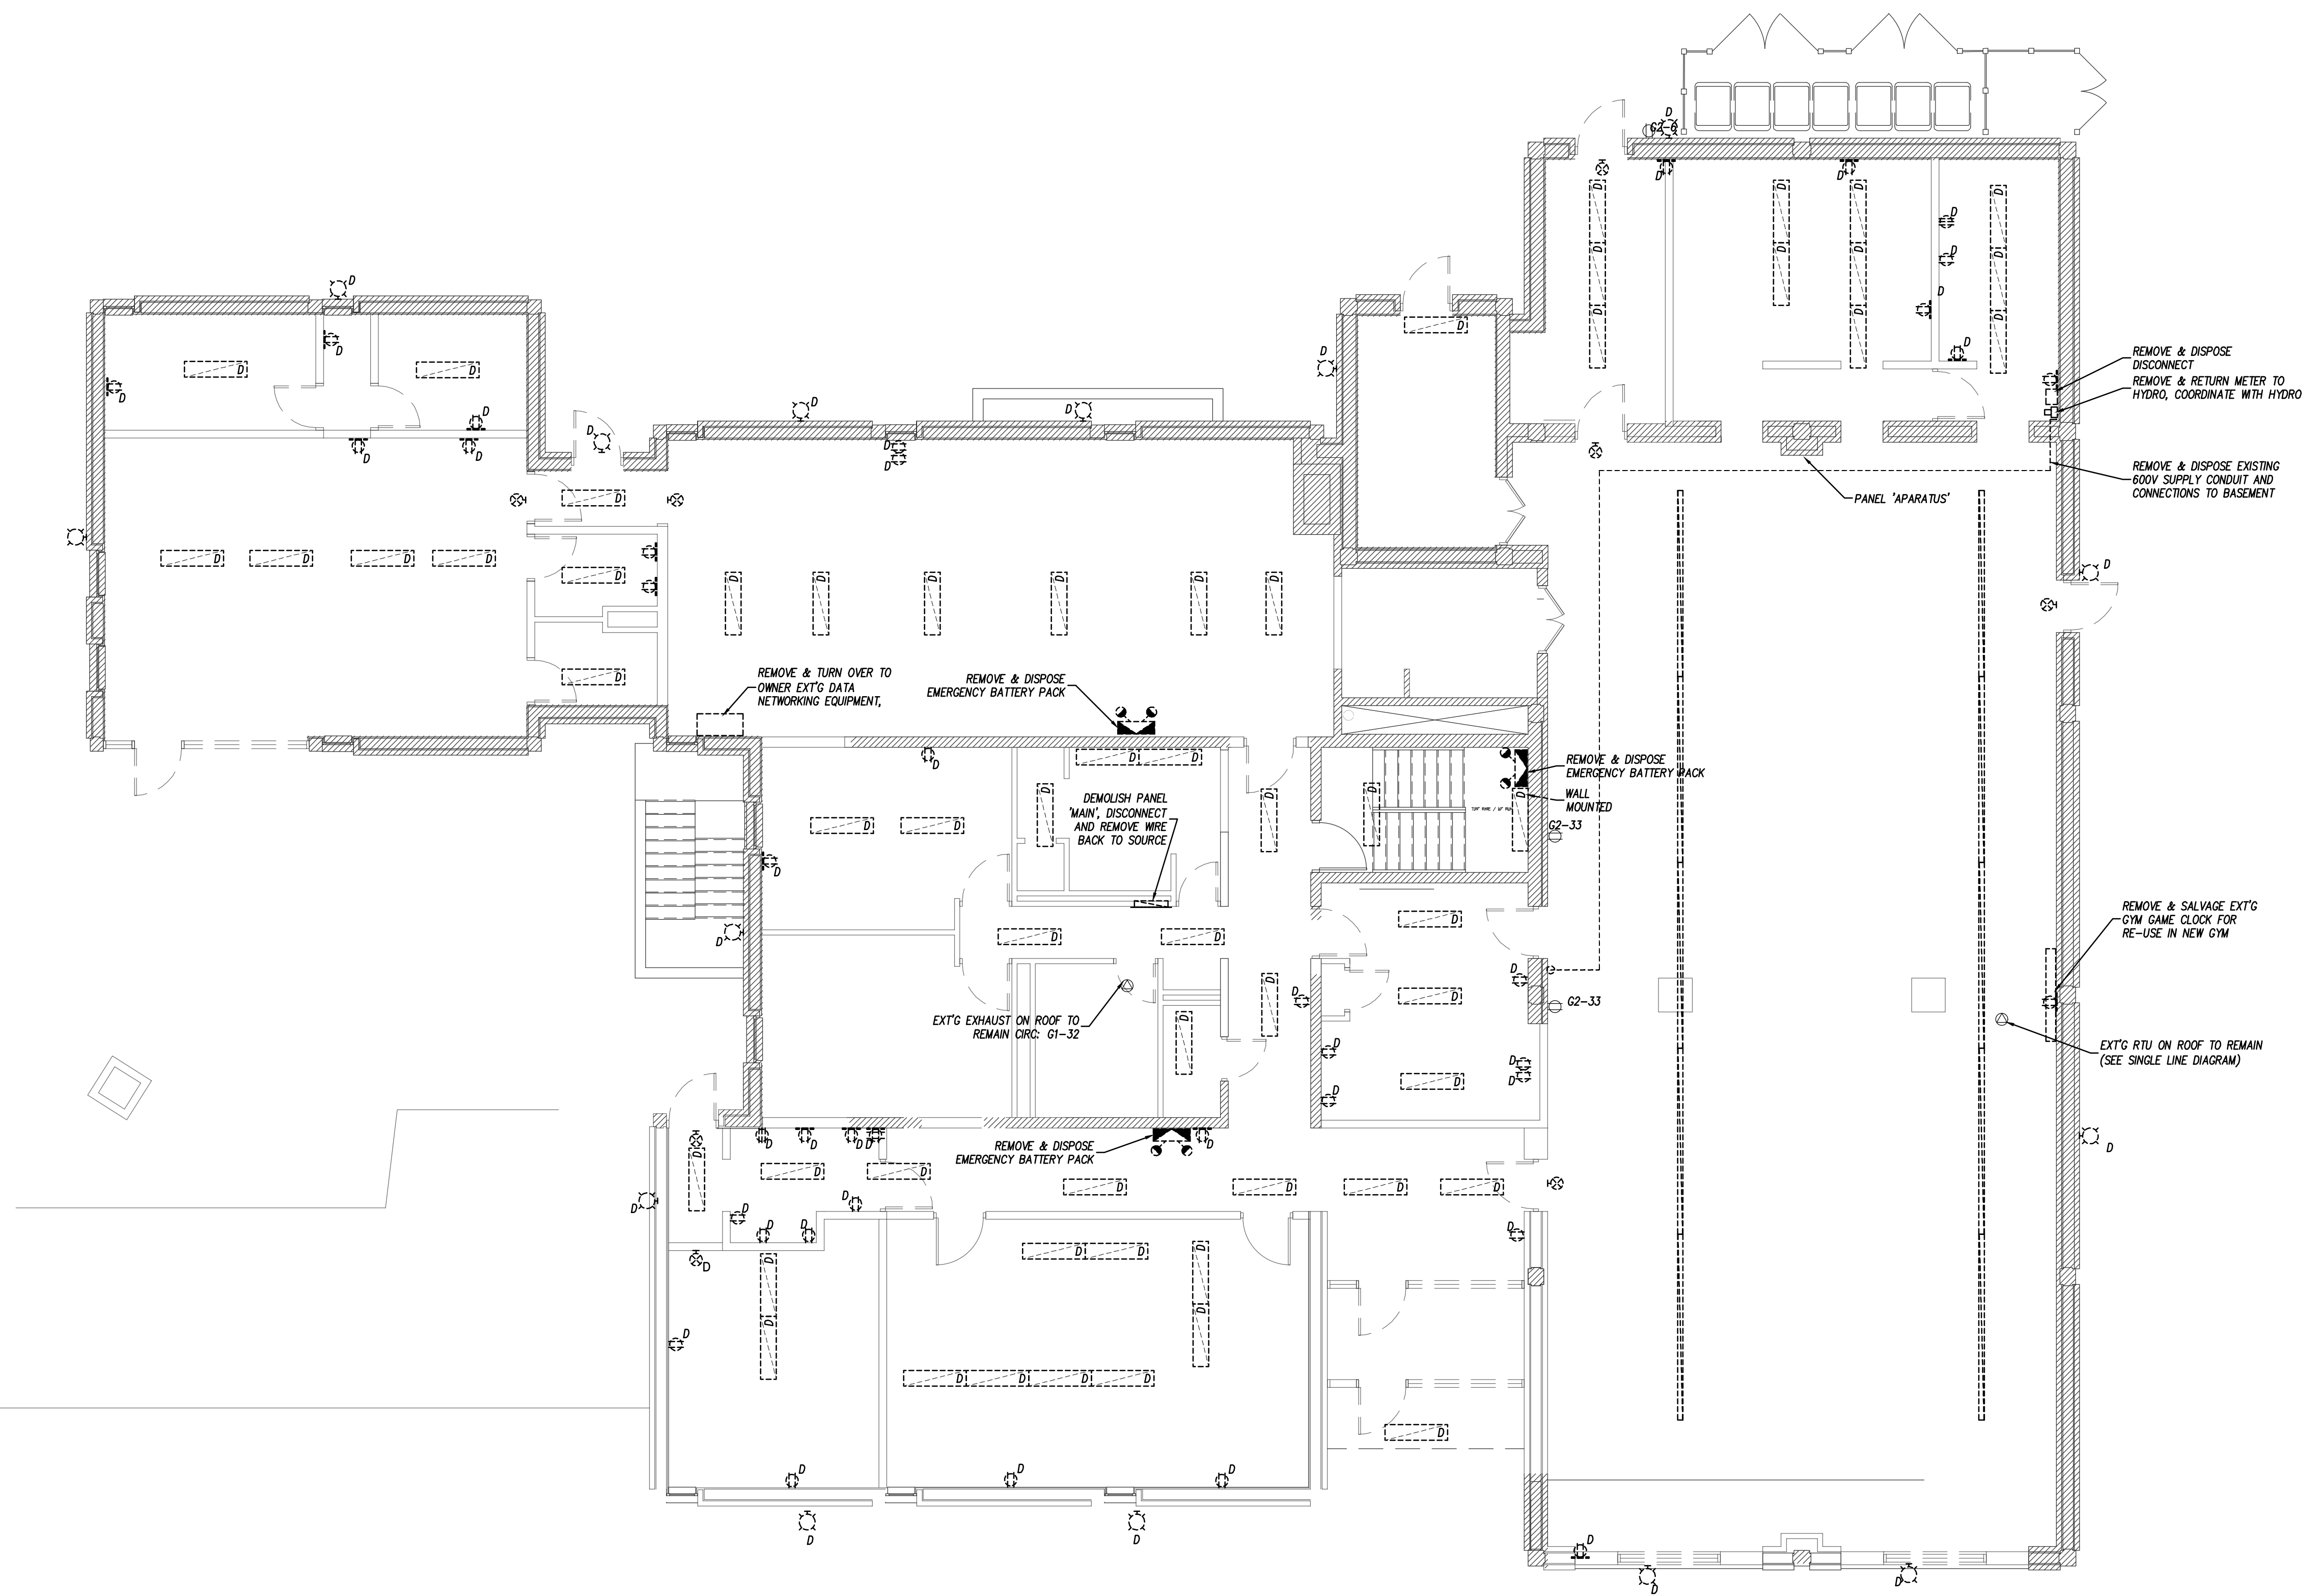

Hobin Architecture Incorporated
 63 Parnilla Street
 Ottawa, Ontario
 Canada K1S 9K7
 T: 613-239-7200
 F: 613-235-2005
 E: mail@hobinarc.com
 hobinarc.com

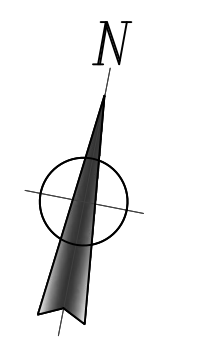

10.		
9.		
8.		
7.		
6.	ISSUED FOR TENDER	2018-02-06
5.	ISSUED FOR LIGHTING SUBSIDY	2018-01-25
4.	ISSUED FOR PRICING	2017-12-22
3.	ISSUED FOR BUILDING PERMIT (PHASE 2)	2017-10-26
2.	ISSUED FOR BUILDING PERMIT (PHASE 1)	2017-10-10
1.	ISSUED FOR REVIEW/COORDINATION	2017-10-05

NO.	REVISIONS	DATE
-----	-----------	------

USE OF THESE DRAWINGS IS RESTRICTED SOLELY TO THE CONSTRUCTION FOR WHICH THEY WERE DEVELOPED. BEKOLAY AND ASSOCIATES LTD. ASSUME NO RESPONSIBILITY FOR ANY SUBSEQUENT USE. DO NOT SCALE THE DRAWINGS BUT RESPECT ANY DIMENSIONS SPECIFICALLY IDENTIFIED IN NOTES OR TEXT. ALL CONTRACTORS MUST VISIT THE SITE AND ARE RESPONSIBLE FOR VERIFYING ANY AND ALL DIMENSIONS THAT RELATE TO THEIR WORK. REPORT ANY DISCREPANCIES IMMEDIATELY TO THE CONSULTANT.

BEKOLAY & Associates. Ltd.
 Consulting Engineers
 200-1827 WOODBINE DR., OTTAWA
 ON K1S 5K7
 PH: 613-723-0474, FAX: 613-723-0884
 email: bekolay@bep.ca


NOTE: GROUND FLOOR DEMOLITION WORK COVERED WITH PHASE 1 (RENOVATION). PLANS PROVIDED WITH PHASE 2 (ADDITION) TO PROVIDE INFORMATION FOR DEMOLITION OF DEVICES ON SOUTH WALL (WALLS BEING REMOVED)

1 GROUND FLOOR POWER & LIGHTING DEMOLITION PLAN
 E-3 1:75


PROJECT: Boys & Girls Club Renovation Prince of Wales Club House
 DRAWING: Ground Floor Power & Lighting Demolition Plan

	DATE: 5-Feb-18	SCALE: AS NOTED
	DRAWN BY: MAG	DESIGNED BY: CLW
	JOB NO.: 2017-17	CHECKED BY: CLW
	DRAWING NO.	


PANEL MAIN FLOOR PANEL

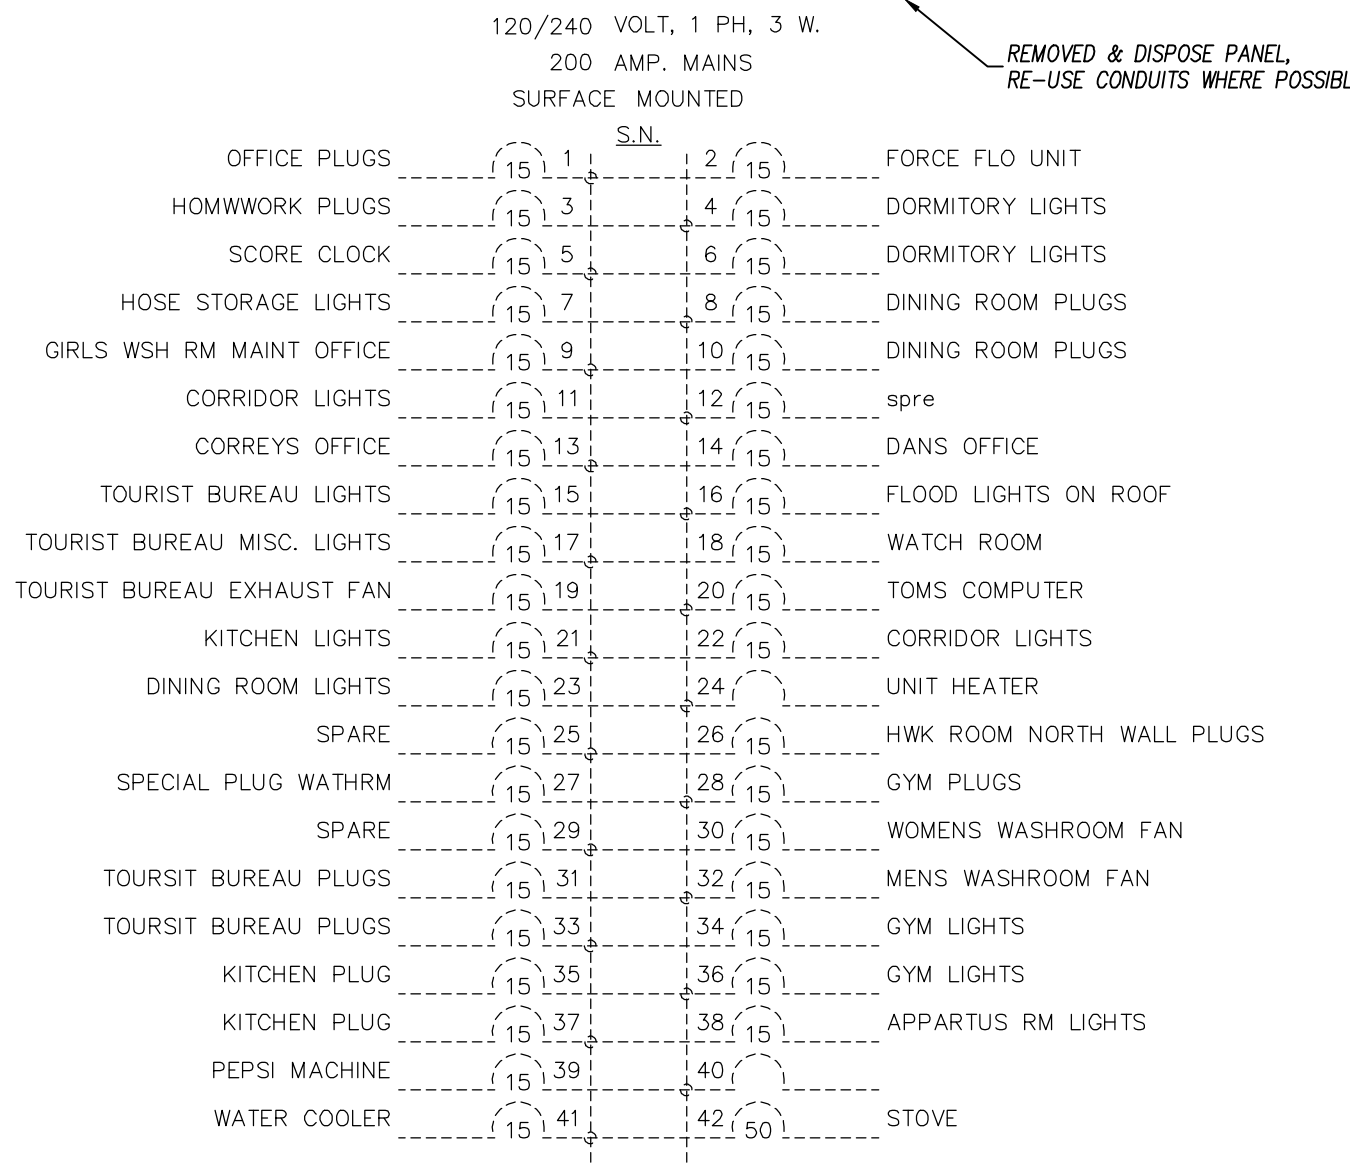


PANEL BASEMENT SWITCH ROOM

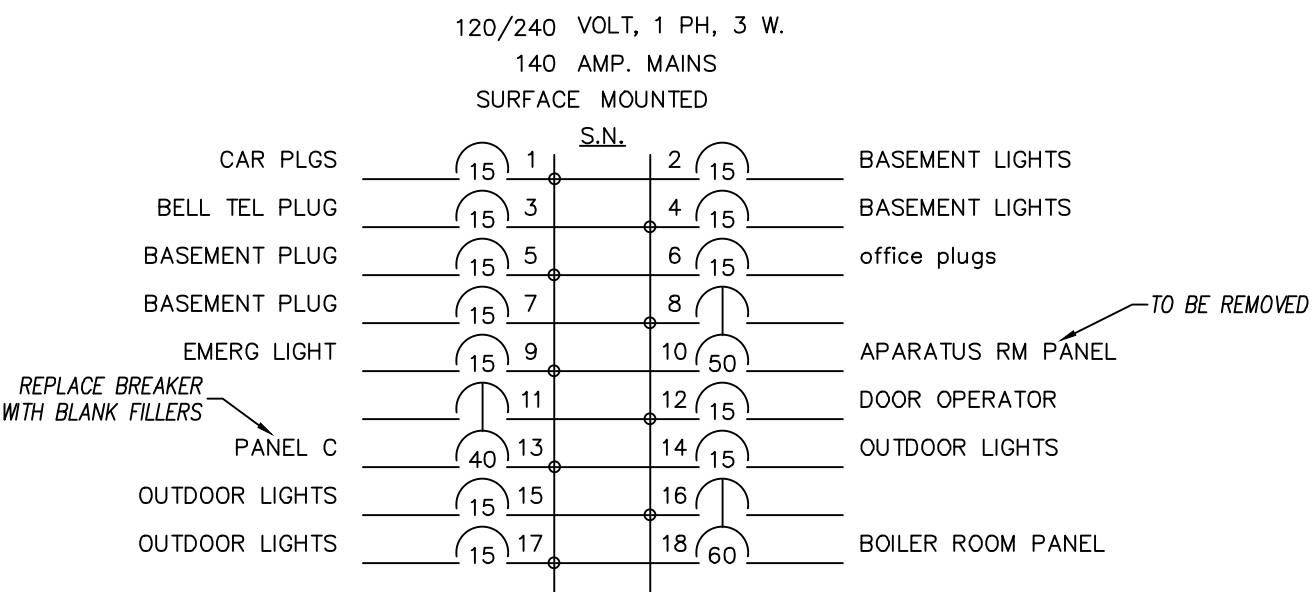

PANEL BOILER ROOM (OLD)

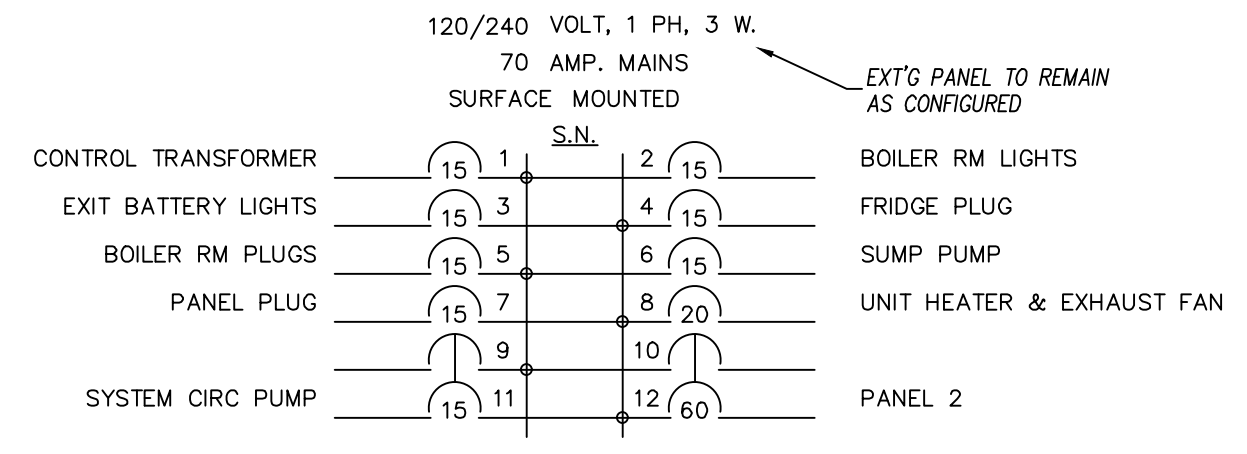


PANEL 2 - BOILER RM

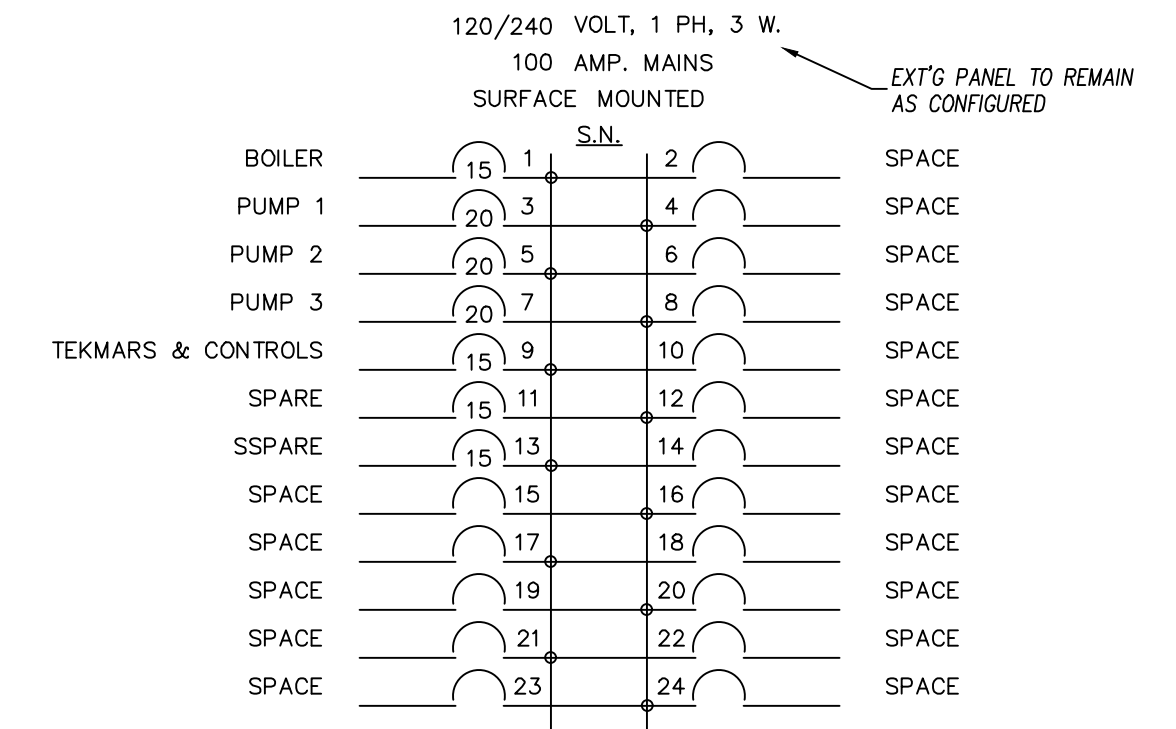


NEW WIRING TO ALL LIGHTING AND POWER IN RENOVATED AREA, REUSE EXISTING CONDUIT WHERE FEASIBLE


PANEL APARATUS RM

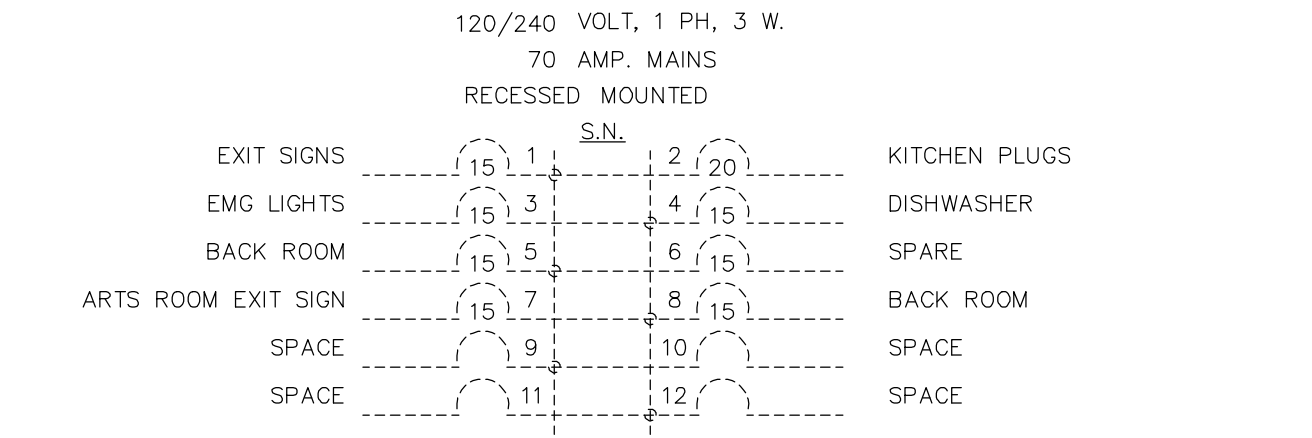


PANEL 'C' EXT'G

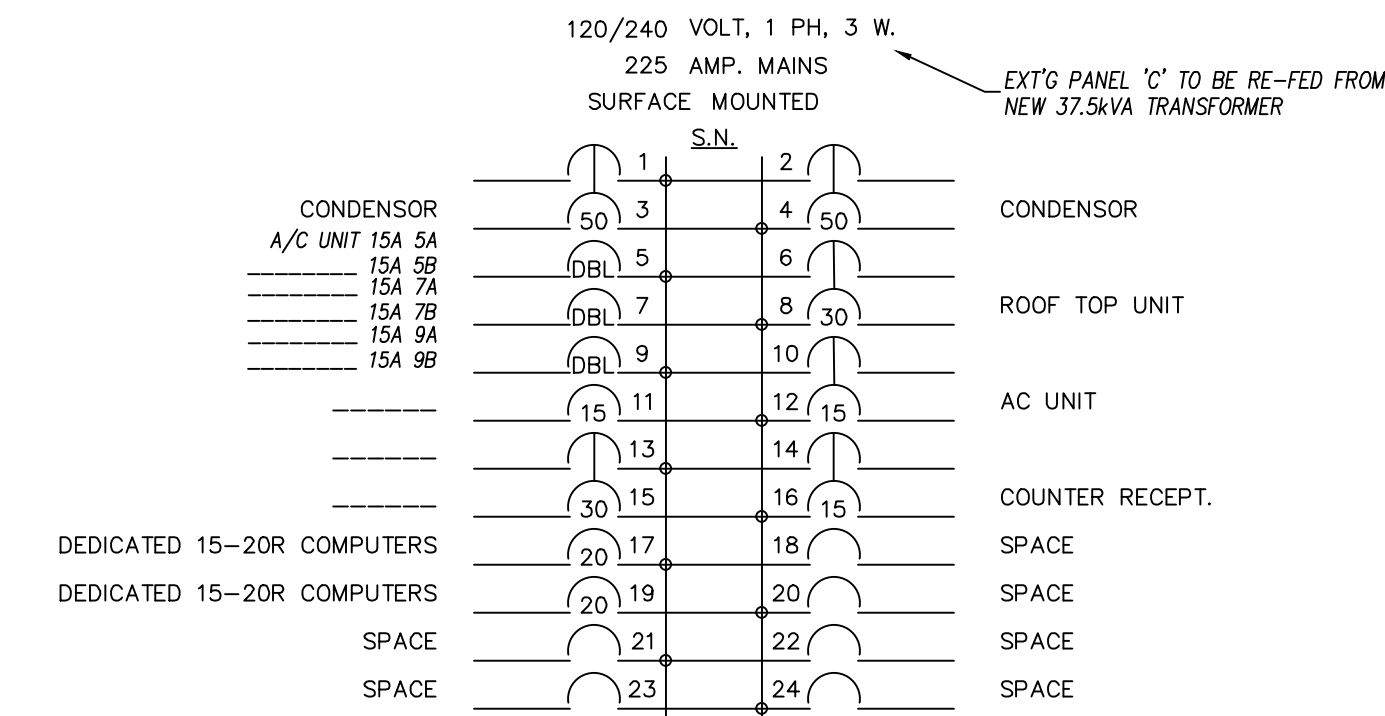


PANEL 'C' REVISED

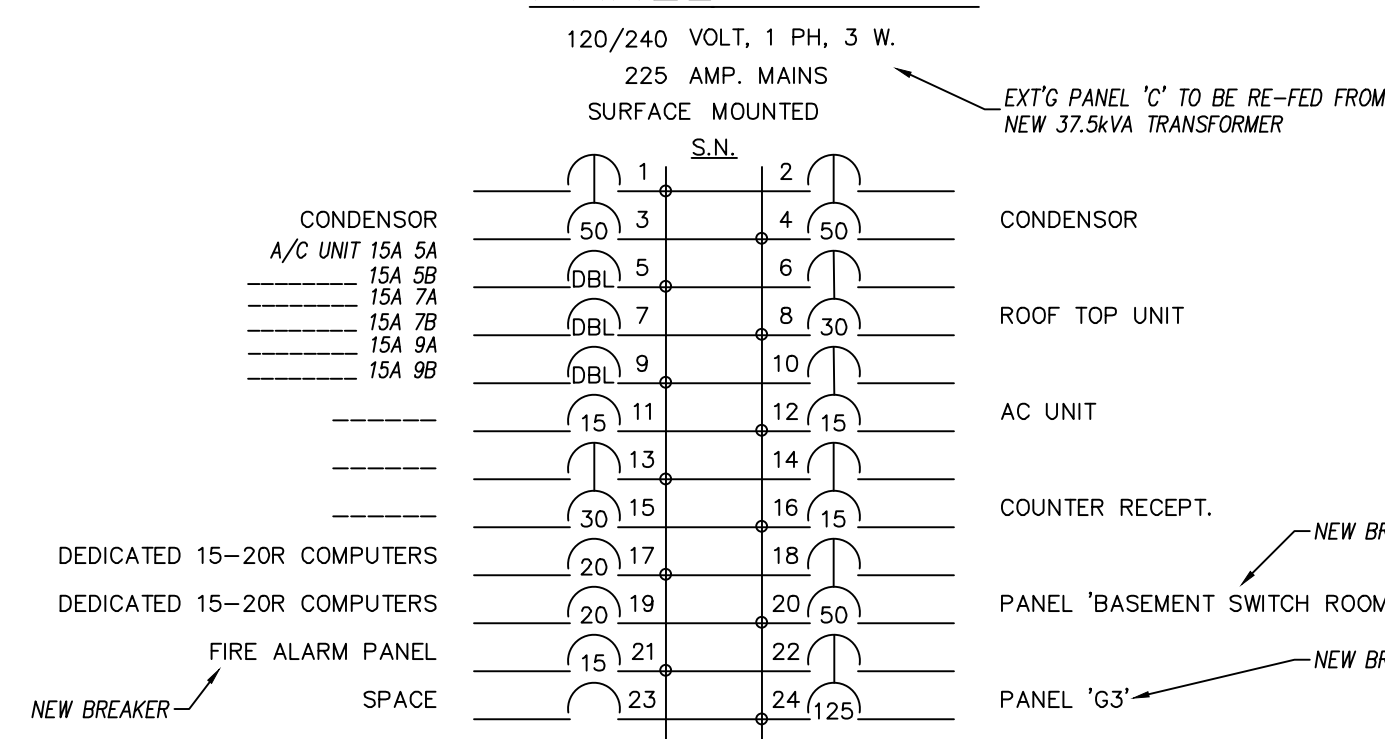




PANEL 'G2'

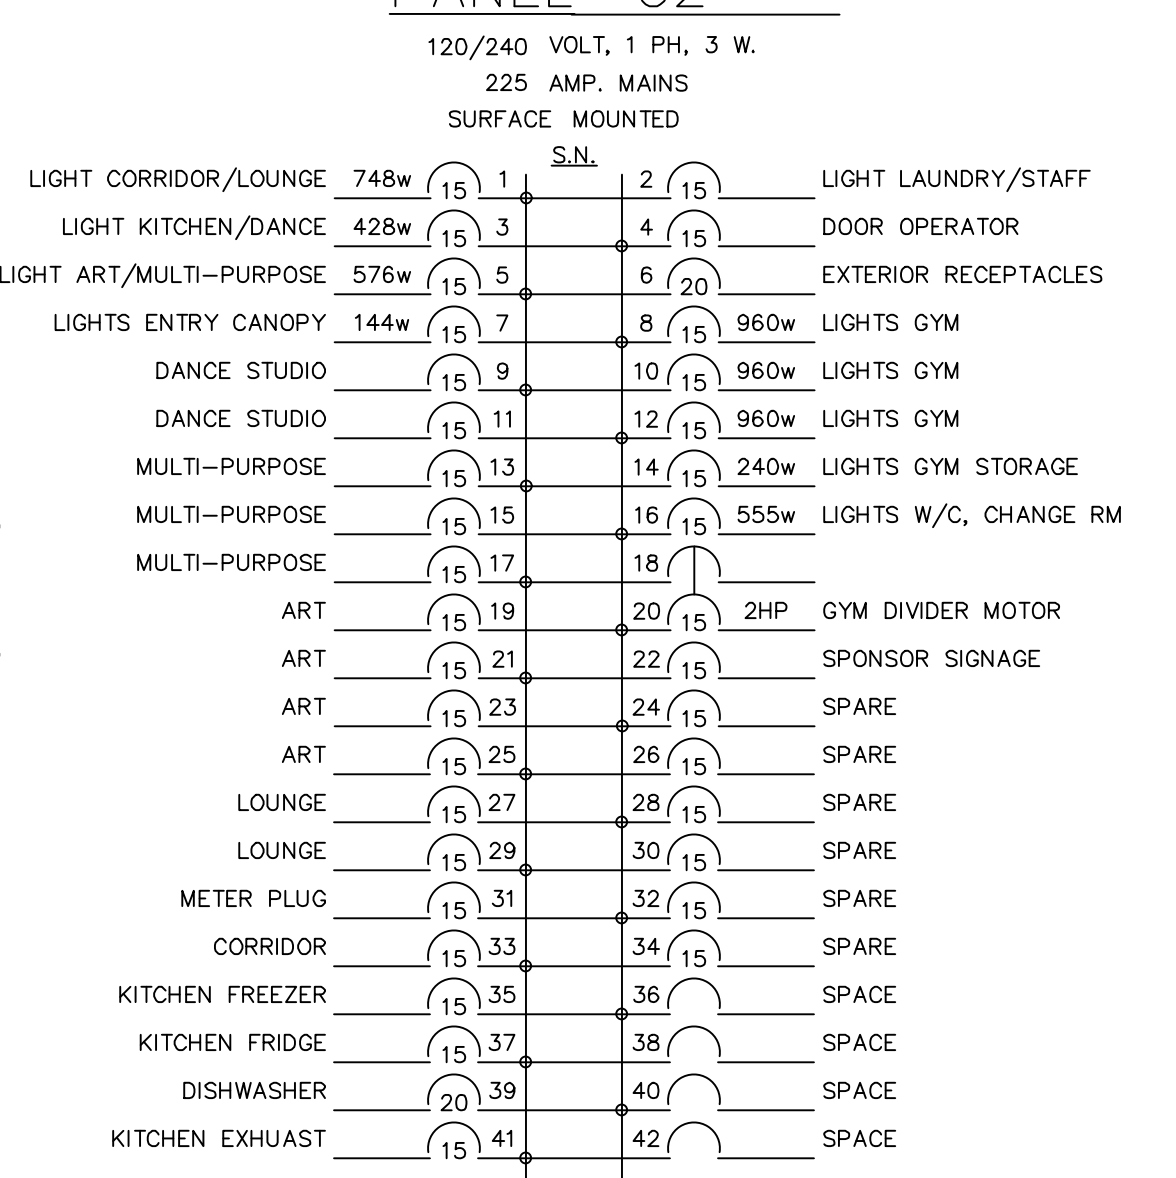


PANEL 'G1'

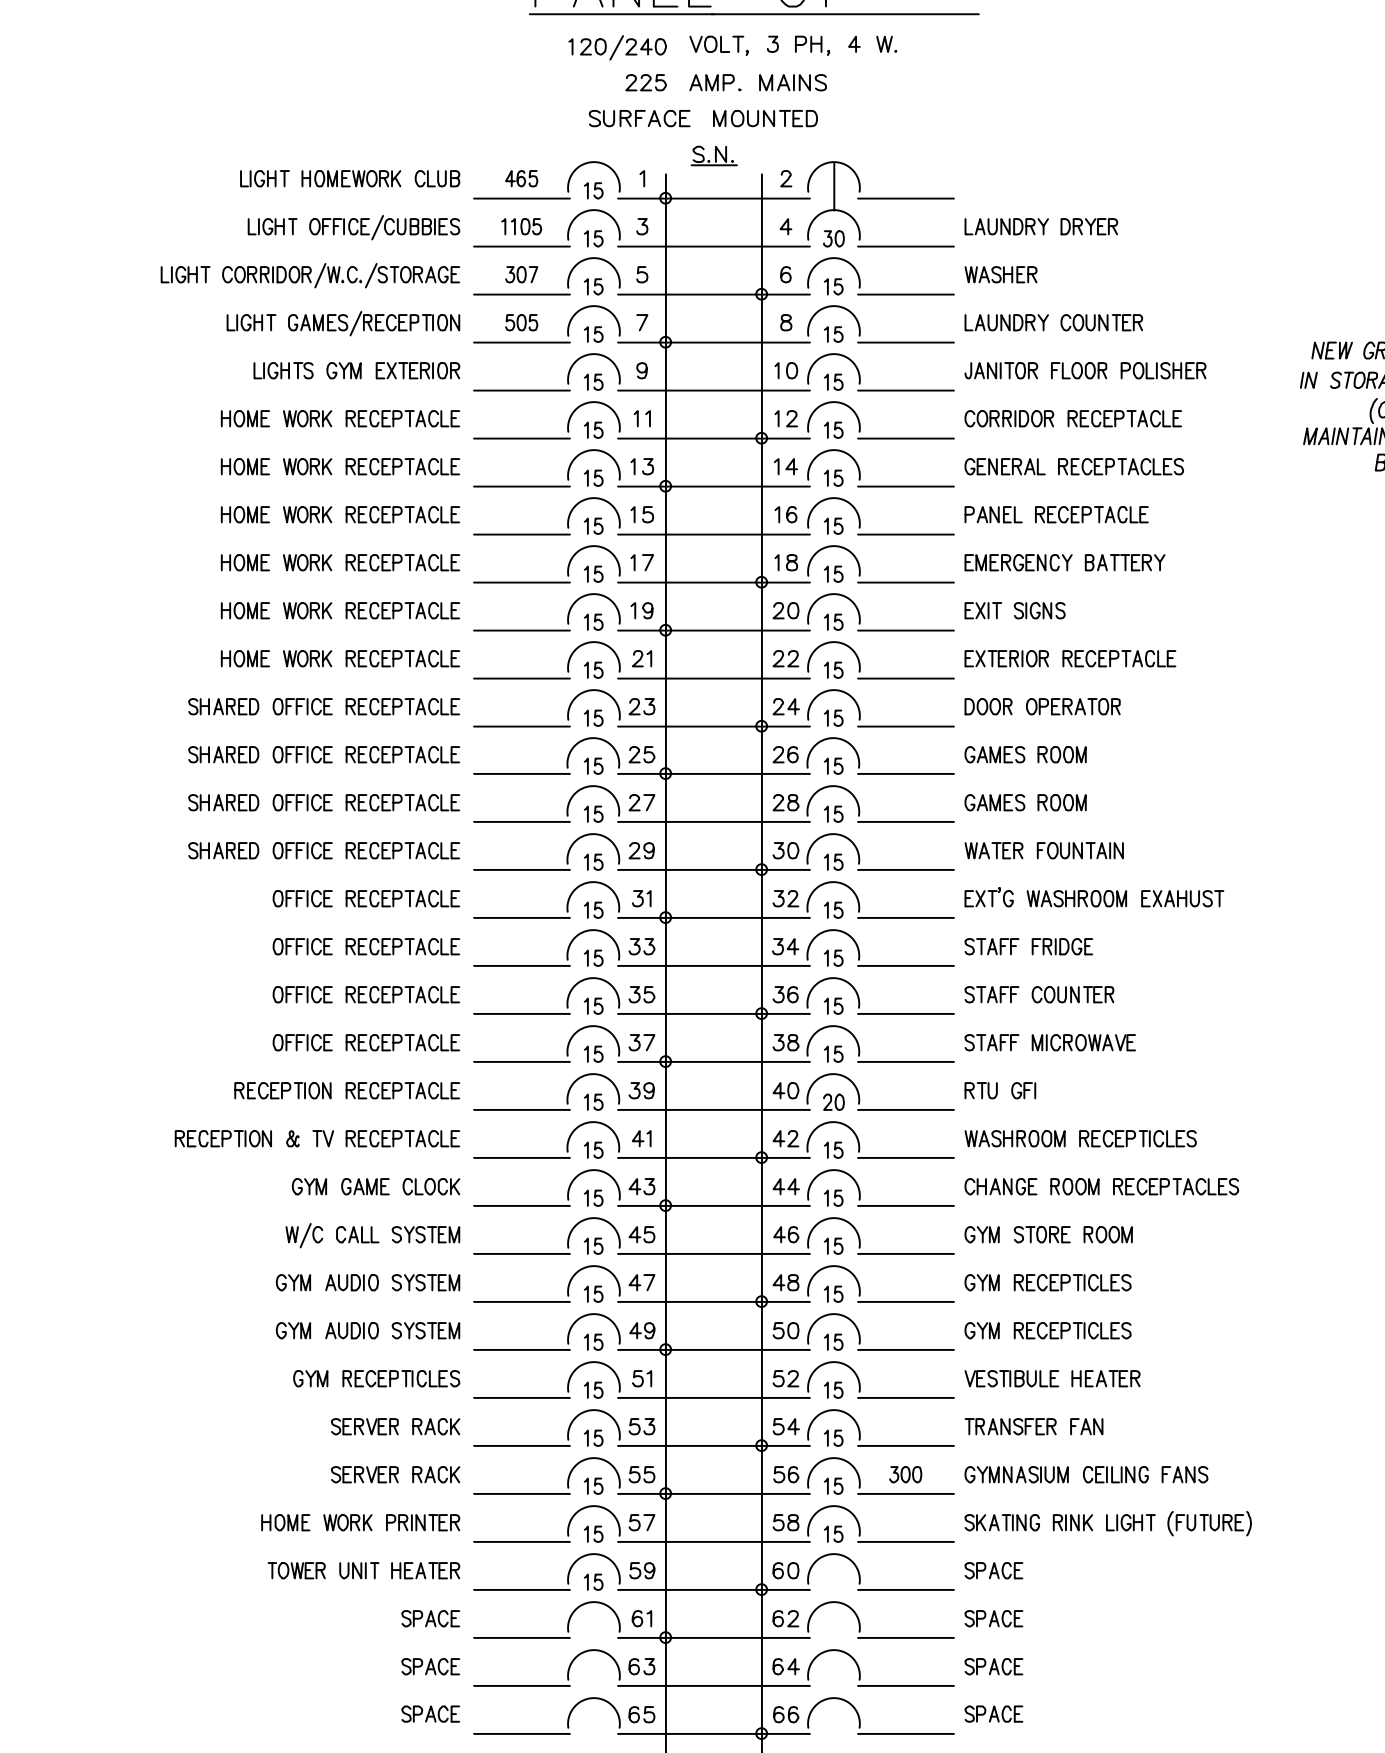

PANEL 'G3'

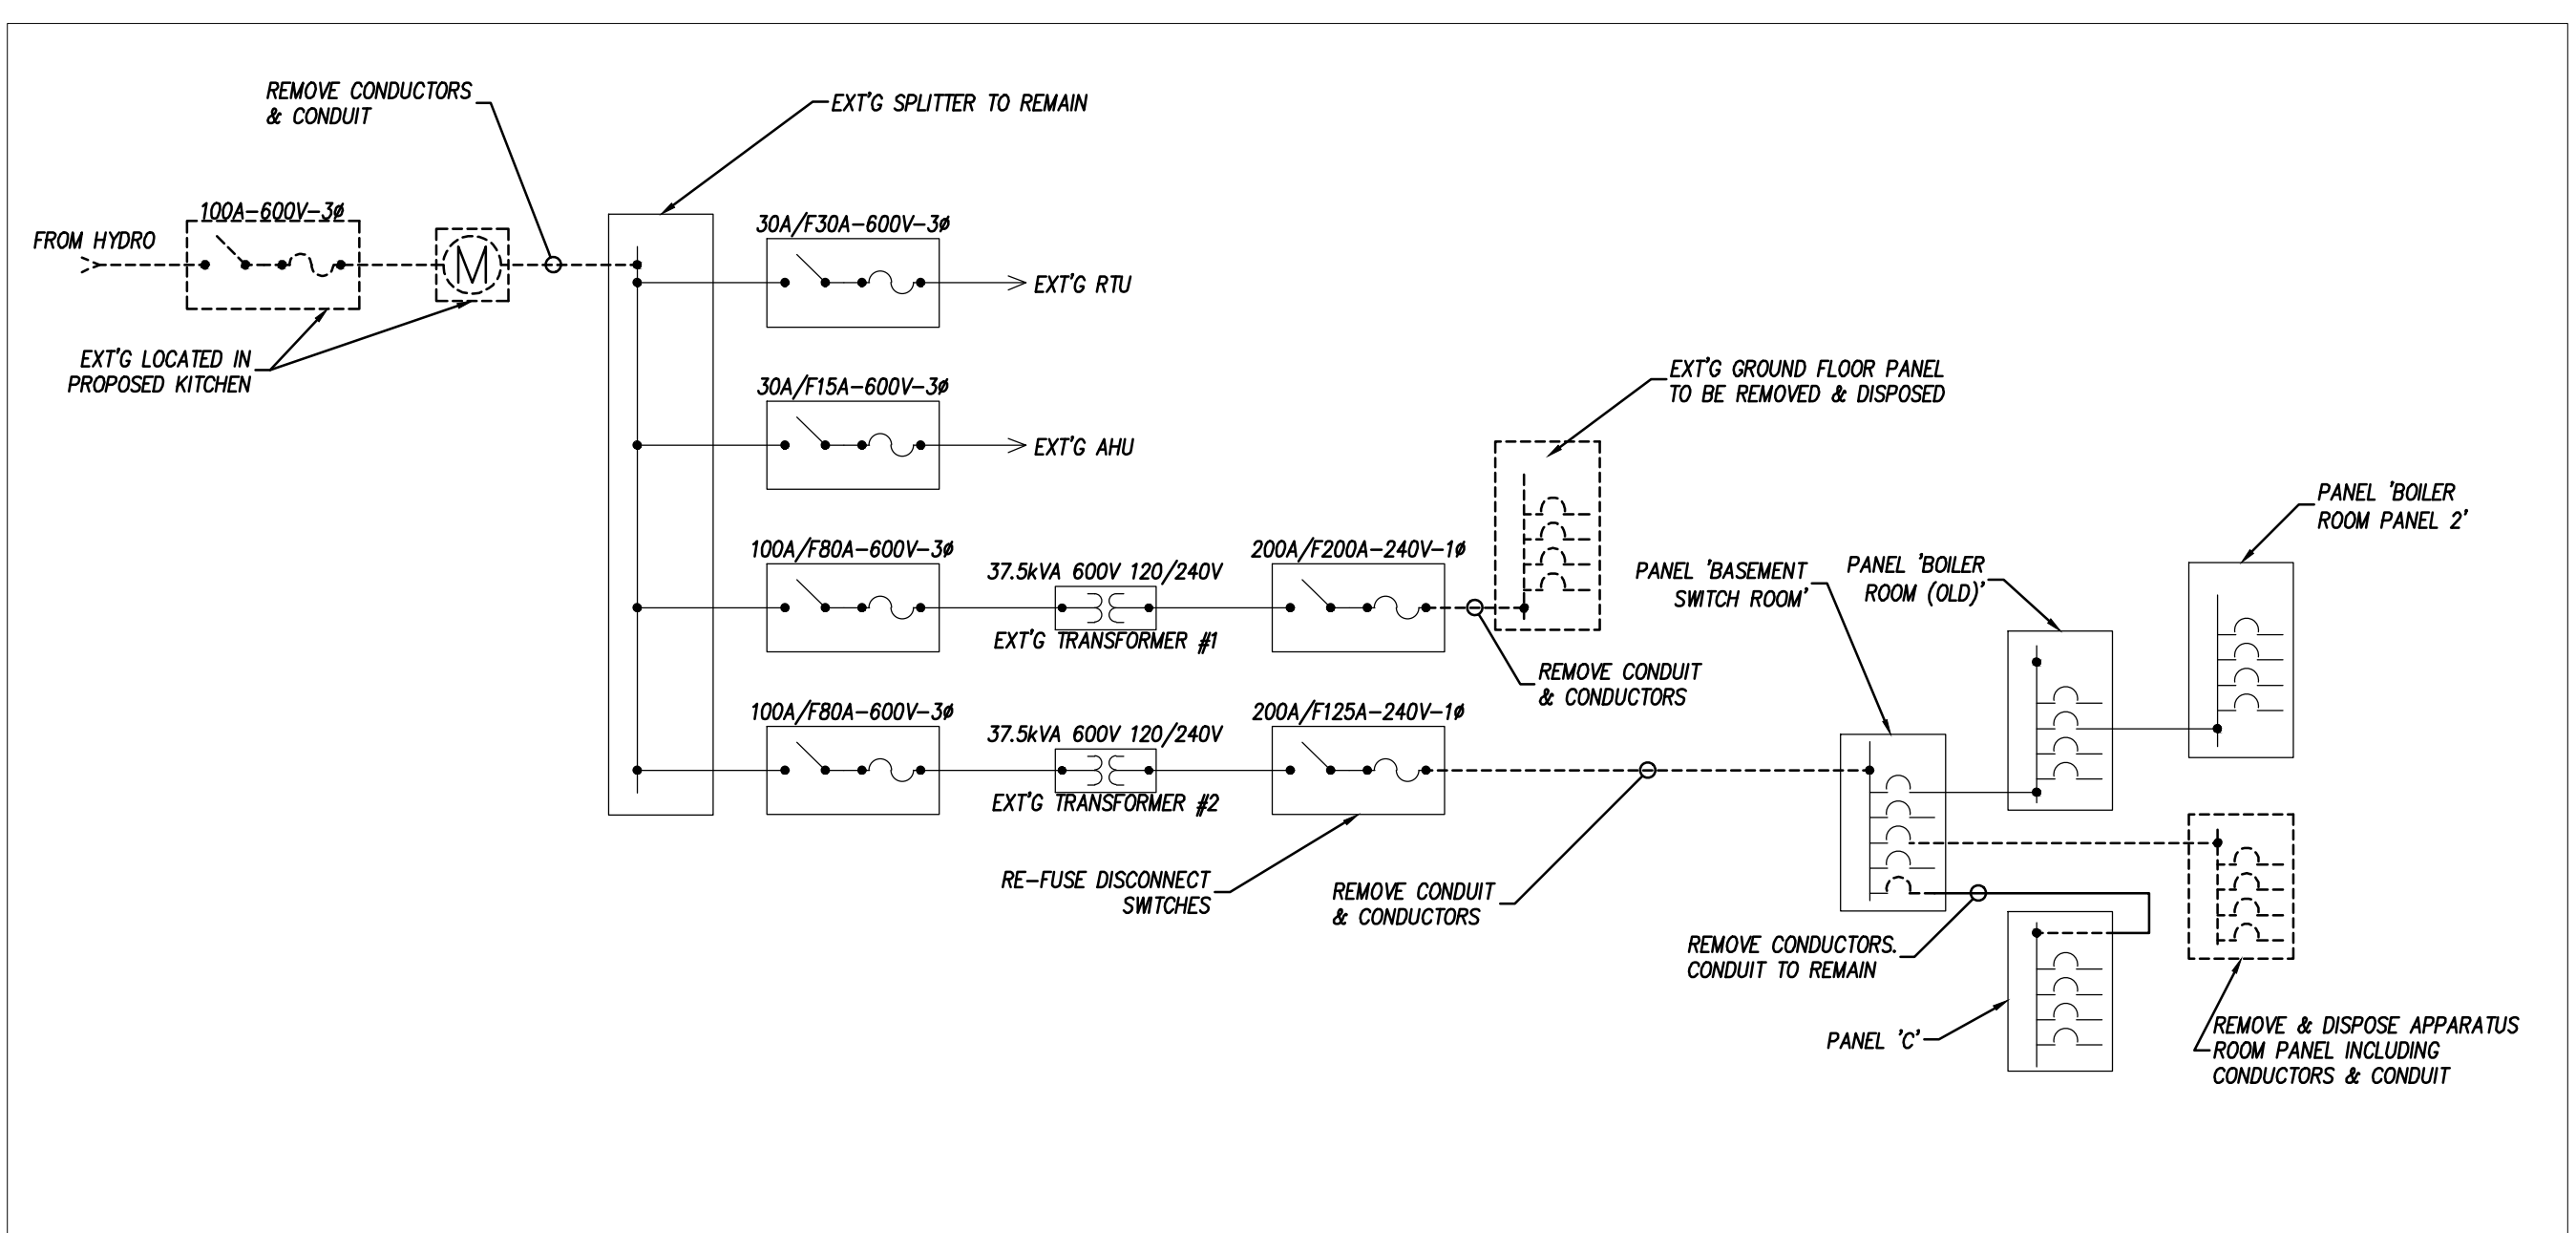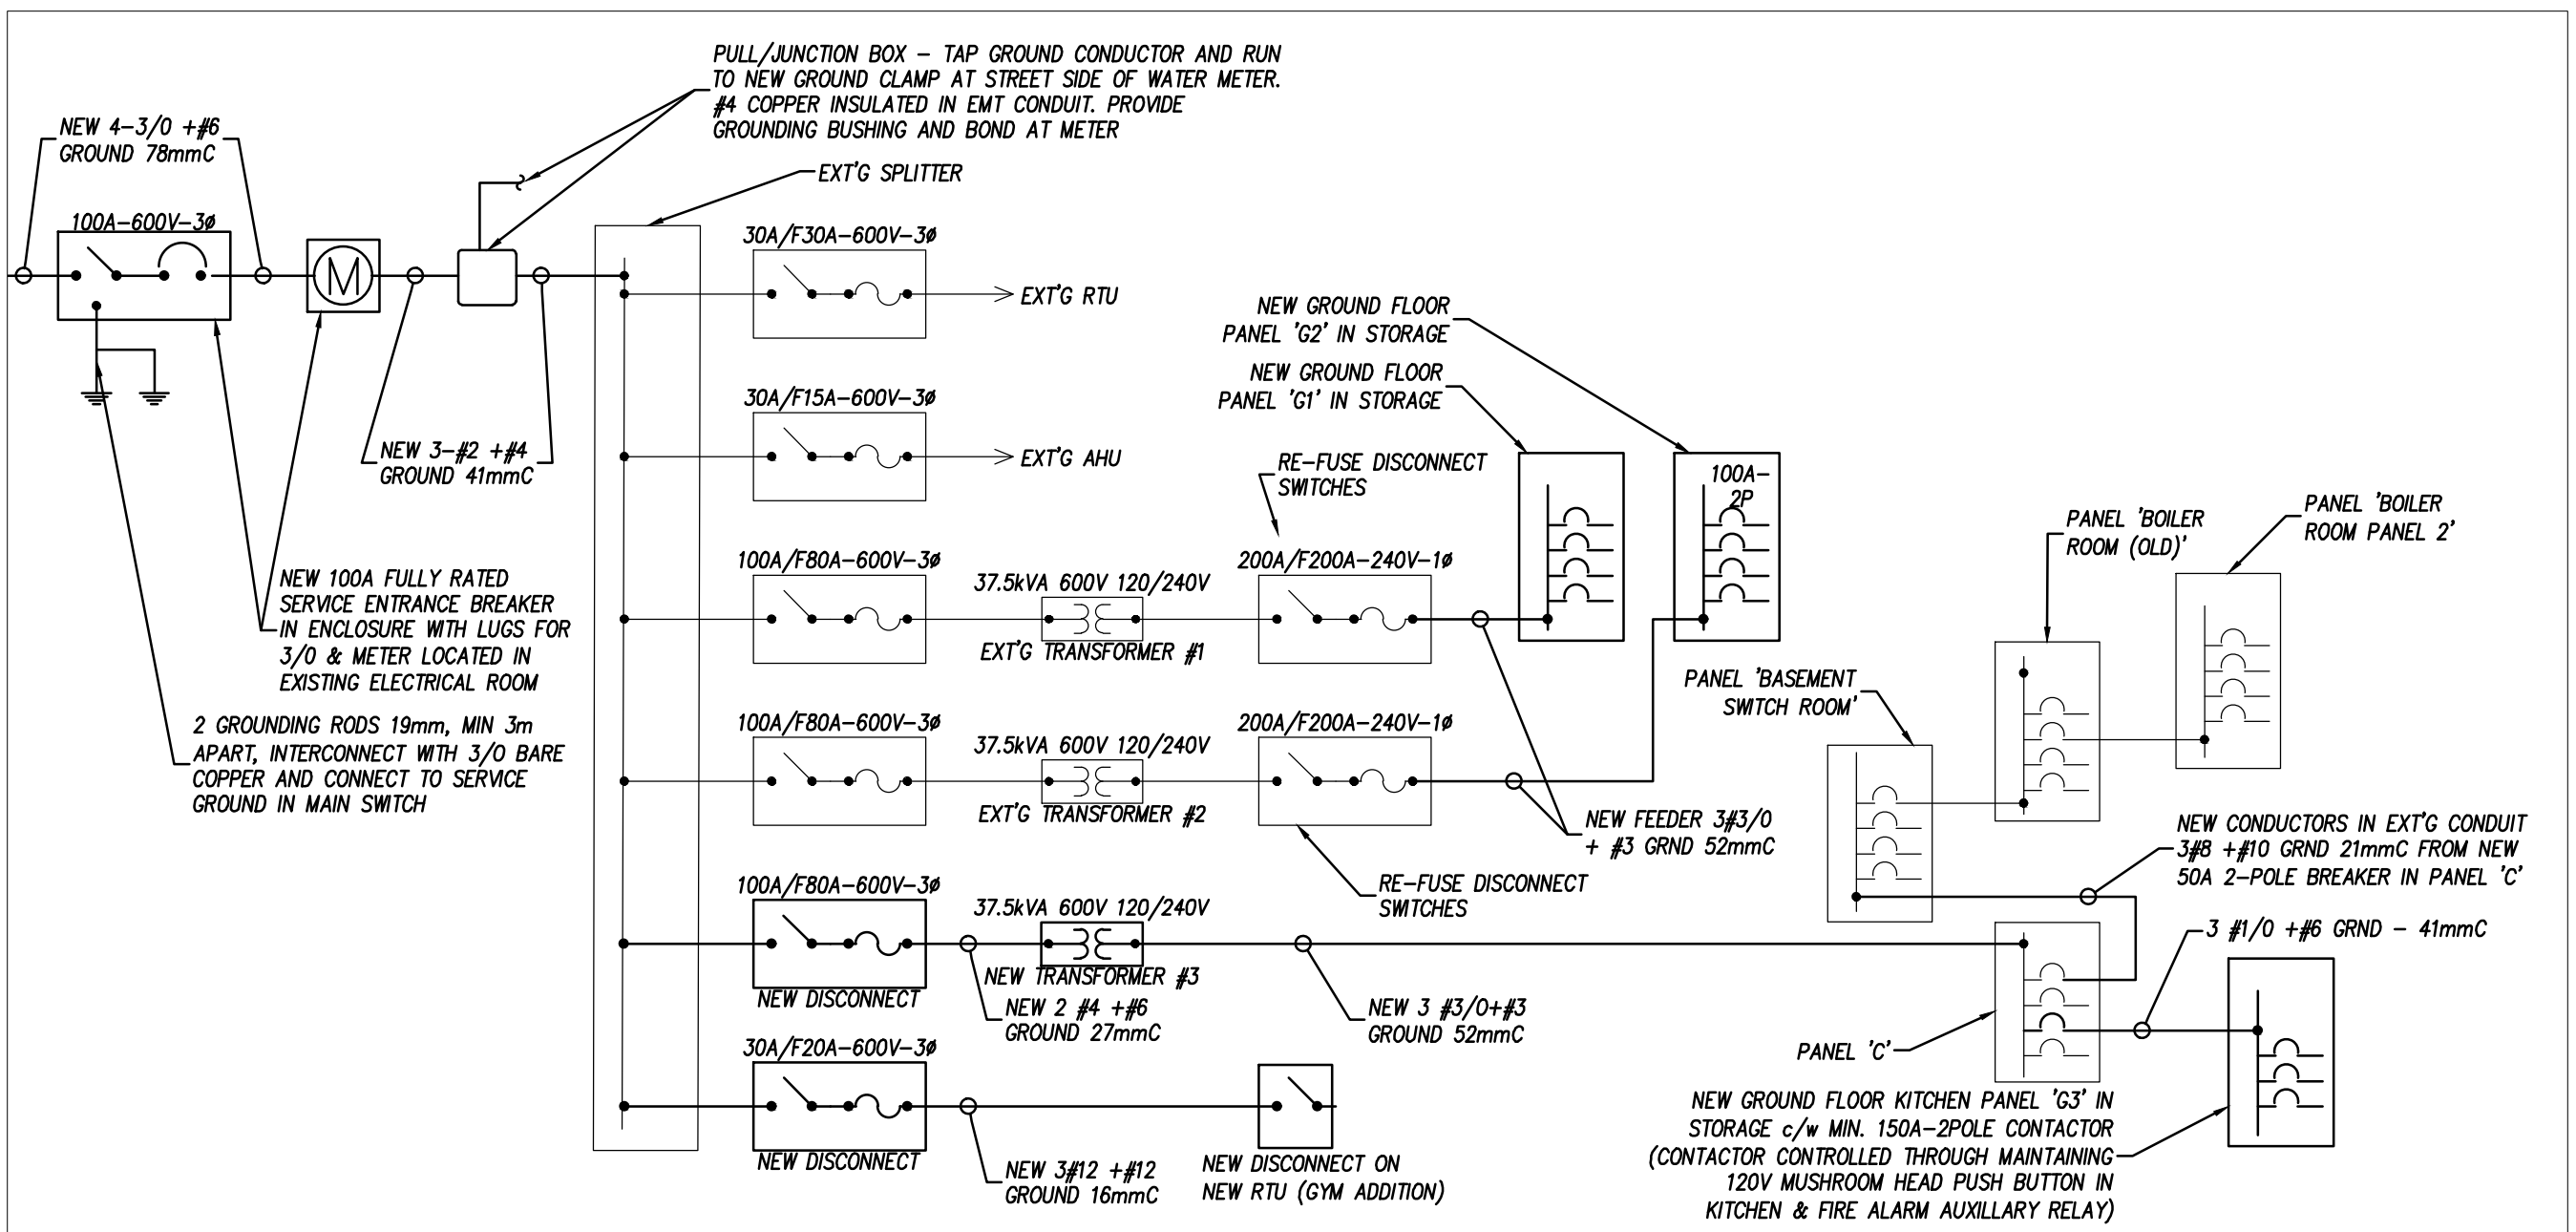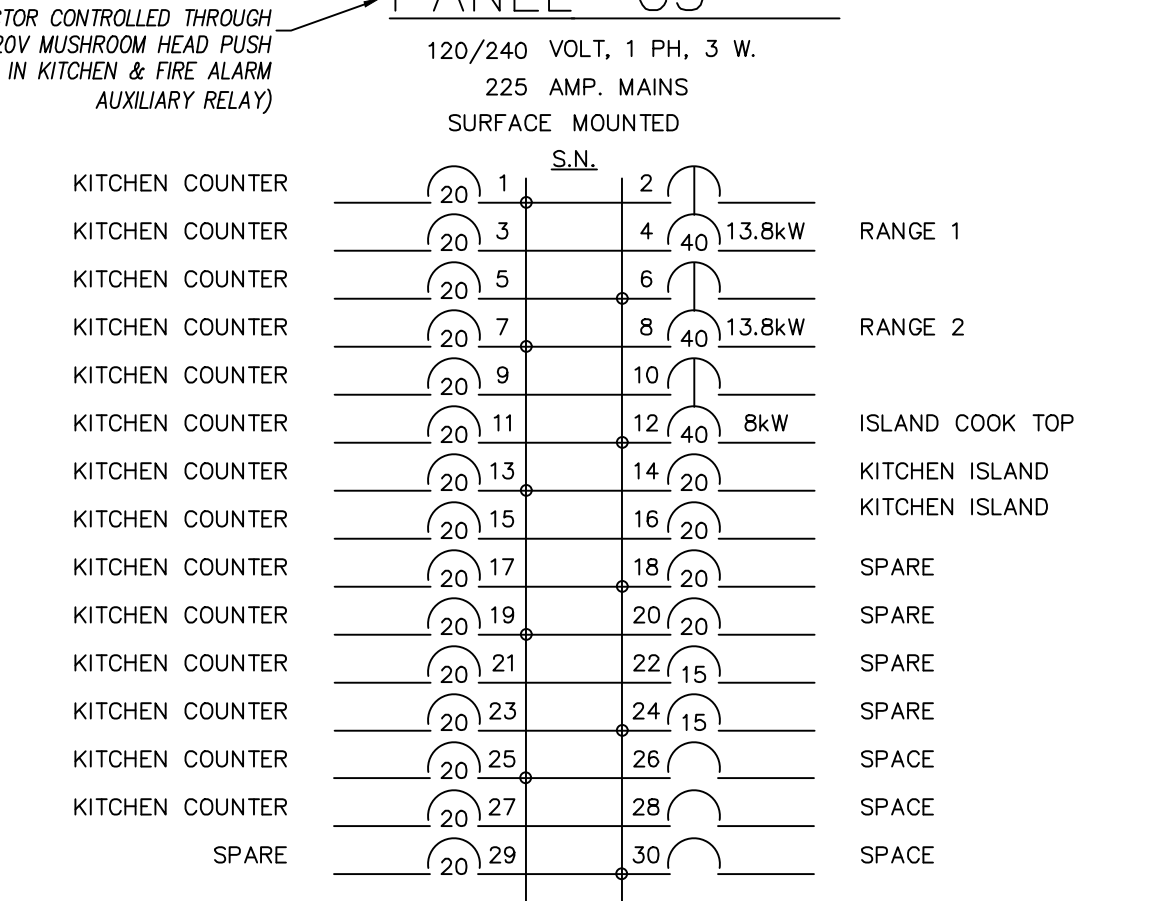

Hobin Architecture Incorporated
63 Parnilla Street
Ottawa, Ontario
Canada K1S 9K7
T: 613-239-7200
F: 613-235-2005
E: info@hobinarc.com
hobinarc.com

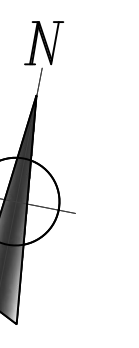

NO.	REVISIONS	DATE
10.		
9.		
8.		
7.		
6.	ISSUED FOR TENDER	2018-02-06
5.	ISSUED FOR LIGHTING SUBSIDY	2018-01-25
4.	ISSUED FOR PRICING	2017-12-22
3.	ISSUED FOR BUILDING PERMIT (PHASE 2)	2017-10-26
2.	ISSUED FOR BUILDING PERMIT (PHASE 1)	2017-10-10
1.	ISSUED FOR REVIEW/COORDINATION	2017-10-05


USE OF THESE DRAWINGS IS RESTRICTED SOLELY TO THE CONSTRUCTION FOR WHICH THEY WERE DEVELOPED. BEKOLAY AND ASSOCIATES LTD. ASSUME NO RESPONSIBILITY FOR ANY SUBSEQUENT USE. DO NOT SCALE THE DRAWINGS BUT RESPECT ANY DIMENSIONS SPECIFICALLY IDENTIFIED IN NOTES OR TEXT. ALL CONTRACTORS MUST VISIT THE SITE AND ARE RESPONSIBLE FOR VERIFYING ANY AND ALL DIMENSIONS THAT RELATE TO THEIR WORK. REPORT ANY DISCREPANCIES IMMEDIATELY TO THE CONSULTANT.

BEKOLAY & Associates Ltd.
Consulting Engineers
300-187 MCDONNELL DR., OTTAWA
ON K1S 2K4, CAN. TEL: 613-722-0884
email: bekolay@bep.ca

PROJECT: **Boys & Girls Club Renovation Prince of Wales Clubhouse**

DRAWING: **Panel Schedules Single Line Diagram**

DATE: 5-Feb-18	SCALE: AS NOTED
DRAWN BY: MAG	DESIGNED BY: CLW
JOB NO.: 2017-017	CHECKED BY: CLW
DRAWING NO.:	

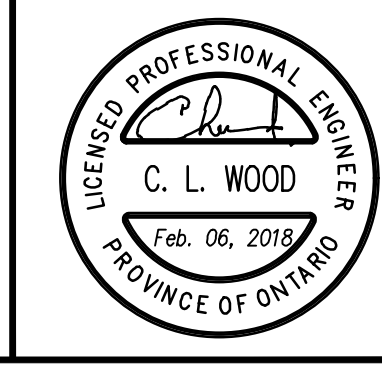

Electrical Specifications Boys & Girls Club

General Instructions:

1. Repair and make good all walls, ceilings, etc. cut under this division.
2. Protect existing work and equipment during construction.
3. Test all system components for proper operation and safety.

General Demolition Notes:

1. Removals include but are not limited to: devices, raceways, outlet boxes, branch wiring and all associated conduit and wire. All associated removals such as wiring, boxes, etc. to be removed back to source.
2. Unless otherwise indicated, all equipment and material removed becomes the property of the contractor and shall be removed from site.
3. Maintain, retain, and make good as required of existing branch wiring, feeders, etc. which pass through the renovation and demolition areas.
4. For abandoned outlets provide suitably size stainless steel blank cover plate.

Specification Notes:

General

1. Do complete installation in accordance with the following: Ontario Building Code, Ontario electrical code, amendments and applicable local regulations. / Inspection certificates for all work.
2. Prior to tender, confirm site conditions and location of existing services.
3. Review all construction documents and be familiar with general construction methods. Make provisions in the form of rated enclosures to maintain all fire separations.
4. Drawings indicate general location, quantity and type of outlets for electrical services only. Do not scale.
5. Review mechanical shop drawings; confirm voltage, current, and connection requirements prior to wiring installation.
6. Submit all plans required by the inspection authority for approval. Furnish inspection certificate, prior to final payment, to show installed work conforms with specification and regulations. Pay all fees and permit costs.
7. Submit shop drawings to the engineer for approval. Provide shop drawings of all equipment and devices. Include details descriptions and instructions fully describing the equipment or system including how it is installed and operated.
8. Upon completion of work mark-up prints describing as-built conditions and 3 copies of operating and maintenance instruction manuals.
9. Allow for relocation of outlets up to 300mm prior to installation at no extra cost. 10. All wiring devices to be specification grade.
11. Install electrical equipment of the following heights unless otherwise indicated or directed otherwise by design drawings:
 - (a) Local switches and dimmer switches: 1200mm
 - (b) General receptacles: 400mm
 - (c) Receptacles above counter: 175mm above backsplash
 - (d) Panelboards: 1900mm from top of panelboard to floor – or as detailed
 - (e) Telecom and cable TV outlets: 400mm
12. As required by CBC Division B Article 4.1.18, Elements of Structures, Non-Structural Components and Equipment, include seismic restraints for all electrical equipment and components, installed under this Contract, where not directly and rigidly attached to the structure. Provide suitable pre-engineered systems and where necessary and required by The Authority Having Jurisdiction, retain and pay for the services of a Professional Structural Engineer (registered in Ontario), to design, sign, and seal drawings for Seismic Restraints.

13 EQUIVALENTS AND ALTERNATES:

1. Manufacturer's materials and workmanship in these specifications set the standard for the material and where applicable energy efficiency requirements to comply with SB-10. They are not intended to exclude other manufacturers from bidding with equivalent products.
2. Products not meeting all design requirements are considered alternatives and they will be rejected until the specified item or equivalent meeting the requirements acceptable to the engineer are provided.

2. Wiring Method

1. Unless otherwise indicated on the drawings, or in this specification, wiring methods shall be:
 - (a) Conductors in electric metallic tubing where exposed and for home runs to panels; for concealed branch local wiring, multi-conductor armored cable is acceptable.
 - (b) Final connection to motors or other rotating equipment with minimum 1000mm liquid tight flexible conduit.
 - (c) For surface wiring in finished masonry walls run conduit vertically from ceiling accessible junction or pull box to surface outlet or multi-outlet wireway.
 - (d) Conceal all new wiring in new construction except where there is no suspended ceiling.
2. Provide pull strings in all empty conduit.
3. Conductor material:
 - (a) Annoved commercial grade, 98% conductivity, copper.
 - (b) No. 14 to No.10 AWG – solid; No. 8 and larger – stranded.
 - (c) 600V RW90, unless otherwise noted.
 - (d) Smallest conductor size allowed no.12 AWG over 50 Volts.
 - (e) In finished areas run wiring concealed.
 - (f) Branch circuits longer than 22.8m (75') utilize conductors to next AWG rating.
4. Run insulated grounding conductor in all conduits with current carrying conductors.

3. Outlet Boxes and Conduit Boxes

1. For recessed installation Electro-galvanized steel single and multi gang flush device boxes for flush installation minimum 102MM square with extension and plaster rings as required.
2. 102MM square or octagonal outlet boxes for lighting fixture outlets.
3. Flush outlet boxes for data and telecommunications to be 102 mm x 102 mm x 78 mm deep with plaster ring to suit.
4. For masonry electrogalvanized steel masonry single and multi gang boxes for devices flush mounted in exposed block walls.
5. Surface mounted installations – For power, data and telecom an existing walls provide cast metal outlet box finished surface applications.

4. Multi-outlet surface wire ways

1. For surface installation above and below work station counters and desks.
2. System to be dual channel with barrier one channel for installation of telephone and data outlets and one channel for 120 volt power outlets.
3. System to be wiremold 4000 or equal.
4. Install with power and telecom/data outlets where indicated.

5. Grounding

1. Grounding equipment to CSA C22.2 No.41. Copper grounding conductors to CSA C22.1, section 10 (latest edition).
2. Non-corroding accessories necessary for grounding system, type, size, material as indicated, including but not necessarily limited to: Grounding and bonding bushings; protective type clamps; bolted type conductor connectors; thermite welded type conductor connectors; bonding jumpers and straps; pressure wire connectors.
3. Install complete permanent, continuous, system and circuit grounding systems.

6. Identification

1. Identify source, voltage and load on all junction boxes. Use of indelible marker for these where concealed or in unfinished areas is acceptable.
2. All conductors to be colour coded in accordance with CSA 22.1 – section 4.036
3. Provide typed, updated schedules in all panelboards.
4. Provide identical identification labels on all equipment.

7. Dry Type Transformers

1. Low voltage, distribution type ANN Single phase with 600V primary and 120/240V-3wire secondary
2. Primary and secondary windings – copper
3. Standard taps – 2x2- 1/2% above and below normal
4. Insulation – 150C rise
5. 10KV BL
6. Efficiency – The higher of CSA standard C802.2 and ASHRAE 90.1
7. Impedance – Minimum Value 2%
8. Sound level – to CSA standard

8. Panelboards

1. Breaker type panelboard to CSA C22.2 No. 29 with the following features:
 - (a) 250V branch panels; bus and breakers rated for 10,000A RMS symmetrical interrupting capacity.
 - (b) Main breaker, main, number of circuits, and number and size of branch circuit breakers as indicated.
 - (c) Tin-plated copper bus with full size neutral.
 - (d) Equipment ground bus to match neutral bus. Bolted directly to panelboard enclosure.
 - (e) Meets suitable for bolt-on breakers.
 - (f) Finish: trim and door – baked grey enamel.
 - (g) Installation/mounting: flush or surface trim as indicated.
 - (h) Mount panelboards to 1980mm (6'-6") to or as detailed.
 - (i) Connect loads to circuits as indicated.
 - (j) Connect neutral conductors to common neutral bus with respective circuit(s) identified.
2. Standard of acceptance: Eaton, GE, Siemens, Schneider

9. Moulded Case Circuit Breakers

1. Provide moulded case circuit breakers to CSA 22.2 No. 5.1, with the following features:
 - (a) Provide automatic moulded case circuit breakers in panelboards as indicated. Breaker sizes and trips as scheduled, or indicated on the one-line diagram.
 - (b) Use bolt-on moulded case circuit breakers, quick-make, quick-break type for manual and automatic operation with temperature compensation for 40°C (104°F) ambient.
 - (c) Breakers shall be common trips with single handle for multi-pole application.
 - (d) In panelboards, moulded case circuit breakers to operate automatically by means of thermal and magnetic tripping devices to provide inverse time current tripping under overload conditions, and instantaneous magnetic tripping for circuit protection.
 - (e) Magnetic instantaneous trip elements to operate only when the value of current reaches 10 to 12 times the breaker trip setting.
 - (f) Breaker minimum interrupting capacity (symmetrical RMS values) shall be not less than the following: 240V – 10KA.
 - (g) Motor control magnetic starters shall be provided with motor circuit interrupter breakers – 250V, 3 pole, 10KA interrupting capacity, magnetic trip only, adjustable (8 settings), with locking pins.
2. Standard of acceptance: CSA approved for panelboard.

10. Wiring Devices

1. Manually operated general purpose ac switches to CSA C22.2 No. 111. – Decorator style
2. Snap switches to CSA C22.2 No. 55-M1986 (R2003).
3. Receptacles, plugs and similar devices to CSA C22.2 No. 42-99 (R2004).
4. Coverplates to CSA C22.2 No. 42.1-00 (R2004).
5. Switches:
 - (a) 15A, 120V single pole, three-way, four-way specification grade switches as indicated.
 - (b) Toggle operated, fully rated for tungsten filament and fluorescent lamps, and up to 80% of rated capacity of motor loads.
 - (c) Switches of one manufacturer throughout project. Equal to Hubbell 1200 series for 120V.
 - (d) Install single throw switches with handle in the 'UP' position when switch is closed.
 - (e) Install switches in gang type outlet box when more than one switch is required in one location.
6. For light switching with automatic control features forming part of a lighting control system refer to the lighting control specification
7. Receptacles:
 - (a) Duplex receptacles throughout – shall be CSA type 5-15R, 125V, 15A, or 20A with U ground
 - (b) Provide coverplates for all wiring devices.
 - (c) Colour of coverplates to match wiring devices – shall be stainless steel or brushed aluminum – Switchplates to be decorator style to match wall mount occupancy sensors and dimming controls
8. Wiring devices to be white

11. Lighting Fixtures

1. Fixture types:
 - (a) Refer to fixture schedule.
 - (b) LED lamps shall be 4100K or as indicated; efficacy (Lumens/Watt) as indicated for the fixture. Drivers (power supplies) to match LED Type. Rates life (50% failure) for LED and driver systems minimum 50,000 Hours.
 - (c) Ceiling mounted fixtures to be supported from the structure by auxiliary chain hangers.
2. Lighting Control System
 1. Lighting controls for all new lighting to be in accordance with Ontario Building Code SB-10 and the relevant mandatory provisions of ASHRAE 90.1 2013 – Part 9 – Section 9.4
 2. Refer to lighting control legend for system component types and function.
 3. Wall mounted lighting control stations low voltage shall be decorator type. Multiple units shall be ganged together, and installed at the local switch height specified.
 4. In offices and similar spaces requiring 2-level A/B and dimming control, the occupancy sensors shall be low voltage, ceiling mounted, passive infrared, with wall mounted 2-pole with manual control push button and relay for the 2nd (B) level.
 5. Where indicated as required due to obstructions sensors to be dual technology.
 6. Line voltage control systems both single and dual channel shall have minimum 800 Watts load capacity per channel at 120 Volt.
 7. Where indicated provide low voltage DC control systems consisting of a wall mounted station and remote low voltage ceiling or wall mounted occupancy sensor. Each system shall include the necessary junction box mounted devices consisting of a 120V to low voltage DC power supply and auxiliary line and low voltage output relays to achieve the functions and control systems indicated. Provide dimming control capability.
 8. Low voltage control systems shall be single or 2 channel as indicated. Their line voltage control capacity shall be 1600 Watts per channel at 120V.
 9. Low voltage DC systems control wiring shall be carried out utilizing Category 5 Enhanced (Cat5e) FTE rated wiring with terminal connections suited for the devices.
 10. Install low voltage wiring in EMT conduit drops in walls to ceilings where they are accessible, run open in accessible ceilings, neatly supported and securely fastened in inaccessible ceilings install control wiring in complete EMT raceway system between all devices. Provide access door to equipment in ceilings where required.
 11. At least 6 weeks prior to scheduled installation prepare and submit complete and detailed shop drawings for all components, include drawings showing the method of installation for each device. Include detailed wiring diagrams for each type of system to be installed.
 12. Prior to rough in for installation, confer with the manufacturer's qualified technical representative and determine the placement, sensitivity and time out requirements for the devices selected for compliance with these specifications in the areas where they are shown.
 13. Arrange and pay for field programming by the manufacturer's technician.
 14. Following completion of the lighting controls installation, retain and pay for the services of the manufacturer's qualified technical representative who shall test and confirm the correct functional performance for each device. The technical representative shall prepare and submit a report confirming that each device meets the control requirements, include copies in the instruction and maintenance manuals.
 15. Devices shall be Lutron or DLM System by Wattstopper or equivalent.
 16. Time Switch
 - (a) Input voltage 120V
 - (b) Scheduling: 56 ON & OFF set points provide individual programs for each day of the week. Minimum setting is 1 minute.
 - (c) Block Holiday: 9 holiday blocks can be set for individual days or for duration of any number of days.
 - (d) Automatic compensation for Daylight Saving, Leap Year
 - (e) Manual Override: Until the next regularly scheduled ON or OFF, automatic operation then resumes.
 - (f) Clock Format: AM/PM or 24 Hour format.
 - (g) Power Outage Backup: Permanent schedule retention. Supercapacitor provides 7 days of real time backup.
 17. Photocell:
 - (a) Outdoor photocontroller with the following characteristics:
 - (i) Sensitive base to rotate 180° on single axis
 - (ii) Load rating: 1000VA
 - (iii) Operating temp: -40° to 70°C
 - (iv) Standard of acceptance: Sensorswitch SMP

12. Lighting Control System

1. Lighting controls for all new lighting to be in accordance with Ontario Building Code SB-10 and the relevant mandatory provisions of ASHRAE 90.1 2013 – Part 9 – Section 9.4
2. Refer to lighting control legend for system component types and function.
3. Wall mounted lighting control stations low voltage shall be decorator type. Multiple units shall be ganged together, and installed at the local switch height specified.
4. In offices and similar spaces requiring 2-level A/B and dimming control, the occupancy sensors shall be low voltage, ceiling mounted, passive infrared, with wall mounted 2-pole with manual control push button and relay for the 2nd (B) level.
5. Where indicated as required due to obstructions sensors to be dual technology.
6. Line voltage control systems both single and dual channel shall have minimum 800 Watts load capacity per channel at 120 Volt.
7. Where indicated provide low voltage DC control systems consisting of a wall mounted station and remote low voltage ceiling or wall mounted occupancy sensor. Each system shall include the necessary junction box mounted devices consisting of a 120V to low voltage DC power supply and auxiliary line and low voltage output relays to achieve the functions and control systems indicated. Provide dimming control capability.
8. Low voltage control systems shall be single or 2 channel as indicated. Their line voltage control capacity shall be 1600 Watts per channel at 120V.
9. Low voltage DC systems control wiring shall be carried out utilizing Category 5 Enhanced (Cat5e) FTE rated wiring with terminal connections suited for the devices.
10. Install low voltage wiring in EMT conduit drops in walls to ceilings where they are accessible, run open in accessible ceilings, neatly supported and securely fastened in inaccessible ceilings install control wiring in complete EMT raceway system between all devices. Provide access door to equipment in ceilings where required.
11. At least 6 weeks prior to scheduled installation prepare and submit complete and detailed shop drawings for all components, include drawings showing the method of installation for each device. Include detailed wiring diagrams for each type of system to be installed.
12. Prior to rough in for installation, confer with the manufacturer's qualified technical representative and determine the placement, sensitivity and time out requirements for the devices selected for compliance with these specifications in the areas where they are shown.
13. Arrange and pay for field programming by the manufacturer's technician.
14. Following completion of the lighting controls installation, retain and pay for the services of the manufacturer's qualified technical representative who shall test and confirm the correct functional performance for each device. The technical representative shall prepare and submit a report confirming that each device meets the control requirements, include copies in the instruction and maintenance manuals.
15. Devices shall be Lutron or DLM System by Wattstopper or equivalent.
16. Time Switch
 - (a) Input voltage 120V
 - (b) Scheduling: 56 ON & OFF set points provide individual programs for each day of the week. Minimum setting is 1 minute.
 - (c) Block Holiday: 9 holiday blocks can be set for individual days or for duration of any number of days.
 - (d) Automatic compensation for Daylight Saving, Leap Year
 - (e) Manual Override: Until the next regularly scheduled ON or OFF, automatic operation then resumes.
 - (f) Clock Format: AM/PM or 24 Hour format.
 - (g) Power Outage Backup: Permanent schedule retention. Supercapacitor provides 7 days of real time backup.
17. Photocell:
 - (a) Outdoor photocontroller with the following characteristics:
 - (i) Sensitive base to rotate 180° on single axis
 - (ii) Load rating: 1000VA
 - (iii) Operating temp: -40° to 70°C
 - (iv) Standard of acceptance: Sensorswitch SMP

13. Exit Lights

1. Exit signs to OBC 3.4.5.1(2):
 - (a) consist of a green pictogram and white graphic symbol meeting the visibility specifications referred to in ISO 3984-1.
 - (b) Graphic Symbols – Safety Colours and Safety Signs – Part 1: Design Principles for Safety Signs in Workplaces and Public Areas, and conform to the dimensions indicated in ISO 7010. Graphical Symbols – Safety Colours and Safety Signs – Safety Signs – to be used in Workplaces and Public Areas for the following symbols:
 - (i) E01 Emergency exit left
 - (ii) E02 Emergency exit right
 - (iii) E05 90-degree directional arrow, and
 - (iv) E06 45-degree directional arrow.
2. Design features:
 - (a) Wall, end-to-wall or ceiling mounting as indicated. Field adaptable, universal mount.
 - (b) Single or double faced as indicated. Facetype to remain coplanar for maintenance.
 - (c) Connections-120V normal; provision for emergency 12 volt DC connection.
 - (d) Housing to be extruded aluminum- white in colour. Optical diffuser for even illumination.
 - (e) Solid-state design. Long life, non-protruding, high brightness LED's. Minimum 25 year life. Maximum of 5 watts per unit (double faced). Acrylic barrier to protect LEDs.

Standard of acceptance: Beggell Micro RM series or equal.

14. Emergency Lighting

1. Provide new battery unit – 24V DC:
 - (a) Rated 720 watts for 30 minutes; voltage to be consistent with as indicated. Breaker sizes and trips as scheduled, or indicated in accordance with CSA-141.
 - (b) Certified in accordance with CSA-141.
 - (c) Mount on new wall bracket.
2. Field testable for rate of rise element by application of heated air:
 - (a) 24V DC operation, VRLA 6W LED each unless otherwise indicated – verify existing voltage before ordering.
 - (b) Plastic/composite body and plate, adjustable mounting, swing type complete with tungsten composite lamp. Suitable for mounting on surface mounted outdoor box.
3. Equip to: Amilite RMMD

15. Telecom, Data, and CATV

1. Provide 4" (100mm) square recessed outlet boxes with suitable plaster ring to accommodate telecom and data connection devices. Provide conduit in partition to ceiling space. For multiple outlet assemblies – provide 3/4" (21mm) Conduit to be EMT set screw connectors at box. Devices, plates and wiring to be by owner's contractor.

16. Surface Mounted Installations

1. For installation of power and data outlets on existing walls provide surface mounted EMT conduit to surface mounted outlet box. Leviton Type 4277 series. Provide matching SS coverplate.

17. Underground Systems

1. Provide underground ducts for power, telecom and communication system
2. Ducts to be type 'DB' approved for direct burial
3. Install ducts in sand bedded founded on undisturbed soil.
4. Provide suitable spacers and fasteners to maintain duct configuration during covering

18. Fire Alarm System Specification:

1. The fire alarm system shall be a fully electrically supervised, zoned, non coded, single stage Data Communication Link Type. The complete installation shall comply with ULC S524 Standard for Installation of Fire Alarm Systems, and all related reference standards, The Ontario Building Code, and the Ontario Electrical Code including Section 32.
2. Control Panel
 1. The fire alarm control panel shall be microprocessor based – DCLA with minimum, 4 Class B signal circuits. 4 auxiliary output relays with double throw normally open; normally closed contacts rated to 3 Amp minimum; 120V.
 2. Automatic fire detection smoke type detector zones shall be capable of monitoring self-diagnostics alarm type.
 3. Alarm and signal circuits to be class B. Provide end of line resistors adjacent to the control panel.
 4. The control panel shall include a central station connection output.
 5. The control panel shall connect to a 120V single phase power circuit 15 Amp rated. It shall operate at 24V DC. Backup power to support the system shall be with an approved battery system mounted externally or internally to the panel.
3. Audible signals (outputs) configurable for steady, temporal code, California code, and march time (selectable by user following installation).
4. Synchronization capability for signal circuits.
5. Configurable signal signal, one person walk test.
6. Subsequent alarm supervisory and trouble operation.
7. Audible trouble signal:
8. Alarm silence
9. Trouble silence
10. Reset
11. Drill
12. Auxiliary relay by-pass
13. Indicators – Visual
 - (a) Power on
 - (b) Power trouble
 - (c) Ground trouble
 - (d) System trouble
 - (e) Remote annunciator trouble
 - (f) Signals silenced
14. Signal to open door
15. Conforms to CAN/ULC S527 Standard Control Units for Fire Alarm Systems
16. Data Fault Isolators
17. Provide fault isolators in the data communication link at each zone to ensure a short fault in one alarm zone will not prevent normal operation of the data communication link in all other zones.
18. Remote Annunciator
 1. The remote annunciator will be recessed.
 2. Enclosure fabricated from 16 gauge steel – finished white
 3. Include visual indication of all zones
 4. Include common controls – system reset signal silence, fire drill, buzzer, buzzer silence, and lamp test.
 5. Passive Graphic Panel
 - (a) In glazed frame surface mounted adjacent to the remote annunciator
 - (b) Include layouts for each floor with all walls and internal details.
 - (c) Each device indicated with the discrete identifier beside each
 - (d) Signal devices to indicate circuit number.
 6. System Operation
 - (a) Alarm – Upon activation of any manual or automatic initiating device the following shall occur:
 - (i) Evacuation alarm devices operate continuously
 - (ii) Transmitt alarm signal to central station
 - (iii) Alarm device and location to be indicated on the control panel and remote annunciator
 - (b) Log the event
 - (c) The signal devices shall continue to operate until silenced
 - (d) Trouble – Upon occurrence of open or fault on wiring or system device the following shall occur:
 - (i) Trouble signal will sound at the control panel and remote annunciator
 - (ii) The trouble light will illuminate on the affected zone at the control panel and remote annunciator
 - (iii) A subsequent alarm will override and cause the evacuation signal to operate
 - (iv) After the alarm condition has been addressed the reset button can be activated, causing the complete system to reset and the trouble signal will sound until the alarm silence switch is returned to normal.
 9. Trouble silence – Operation of the trouble silence switch will cause:
 - (a) The audible trouble alarm signal will be silenced at the control panel and remote annunciator
 - (b) The trouble light will continue to indicate
 - (c) Upon correction of the trouble the audible signals will again sound until the silencing switch is returned to normal
 10. Manual Alarm Initiating Stations
 1. Non coded, single pole normally open addressable device
 2. Colour: Red
 3. Visible indication of operation
 4. Installation with proprietary tool or key – identical throughout
 5. Cast aluminum construction

Conform to CAN/ULC S528 Standard – Manual Stations for Fire Alarm Systems Including Accessories

1. Automatic Heat Activated Fire Detection Alarm Devices
 1. Combination fixed temperature and rate of rise; addressable device
 2. Rate of rise 80C/Minute, with 50% delay
 3. Fixed temperature upper limit 57°
 4. Field testable for rate of rise element by application of heated air
2. Rate of rise 80C/Minute, with 50% delay
3. Fixed temperature upper limit 57°
4. Field testable for rate of rise element by application of heated air

10. Install combination visual and audible signal devices in the sanctuary at 2559mm (8'-6") above finished floor to top of the device

1. Install audible signal devices throughout building at 2400mm above finished floor to top or where necessary where restricted by ceiling height install wall mounted signal devices at 150mm below the ceiling measured to the top edge of the device.
2. Cut and repair wall for cable connection from ceiling space.
3. Install duct mounted smoke detectors at air handling unit where shown in accordance with manufacturers recommendations. Prior to placing order co-ordinate with the HVAC contractor to establish and agree upon location for the detector. Confirm air handling unit control circuit has terminals for low voltage connection. Connect auxiliary output contact into air handling unit fan shutdown circuit.

16. Wiring Methods

1. All fire alarm initiating circuit DCLA Type, returning to the control panel in separate conduit.
2. Alarm and signal circuit wiring shall be unshielded cable. Cable assemblies shall consist of FAS Rated 300V/UT insulated conductors. Conductors shall be color coded including shield in accordance with manufacturer's recommendations.
3. Make terminations and bending radii in accordance with the electrical code
4. Connections between the control panel and annunciator shall be the manufacturers recommended cable assembly installed in EMT
5. Connection from fire alarm control panel and premises security central station agency panel shall be 5 conductors in EMT exposed in electrical room
6. 24 Volt wiring to the door hold open units shall be 300 Volt insulated multi-conductor cable in conduit as specified for fire alarm wiring. Where exposed in the electrical rooms install vertically in a straight line. Provide 50 Volt-Amp 120 to 24 Volt transformer and connect from single-pole 15A-120V breaker in panel indicated. Connections between the electrical panel, transformer and fire alarm control panel where exposed shall be 600 Volt insulated conductors in electric metallic tubing with the 24 Volt wiring through contacts of auxiliary relay in control panel. Contacts normally closed; open on alarm.
7. Fan shutdown wiring shall be 600V insulated conductors in EMT or multi-conductor 600 Volt insulated armored cable. Where exposed final connection unit to be with liquidtight flex from a junction box in ceiling below the roof
17. Concealed wiring
 1. Conceal all wiring in finished areas.
 2. Exceptions are service rooms and storage rooms.
 3. Cut slots and opening neatly; repair surfaces to their original condition.
 4. White finish
 5. Wall mounting
18. Verification Testing
 1. All verification testing to be performed in accordance with the CAN/ULC-S537 standard by individuals with qualifications recognized by the local authority at the time of testing.
 2. All devices to be tested as per the standard and the results recorded on the verification report forms.
 3. All panel and annunciator tests to be performed as per the standard and the results recorded.
 4. During verification, compliance with the approved project plans shall be confirmed.
 5. Following verification arrange for and demonstrate the proper operation and conformance to the ULC/CAN S524 standard to the municipal building official.
 6. A verification certificate, along with the report, shall be issued only upon compliance with the CAN/ULC S537 standard and the project plans.
19. Training
 1. After submission of the verification certificate and report, review the system operating and maintenance manual with owner's facility management staff. Demonstrate and instruct the staff in procedures for all operating modes.

LIGHT CONTROL METHOD SCHEDULE											
TYPE	ROOM FUNCTION	MANUAL		AUTOMATIC		ON LEVEL		ON LEVEL CONTROL		DAYLIGHT HARVEST	
		ON	OFF	ON	OFF	Full	50%	DIMMER	A / B		YES
L1	STORAGE & SERVICE ROOMS	X	X		X	X				X	
L2	REST ROOMS			X	X	X				X	
L3	VESTIBULE			X	X	X				X	
L4	SMALL ROOM	X	X	X	X		X	X		X	
L5	CORRIDOR AUTO			X	X	X				X	
L6	ASSEMBLY OCCUPANCY (LARGER ROOM)	X	X	X	X		X	X		X	X

NOTES: 1. AUTO ON AVAILABLE, CLIENT DECISION

65 OCCUPANT SENSOR SCHEDULE		
TYPE	DESCRIPTION	COMMENTS
S1	Integrated sensor, Dimmer, & Controller	0-10 Volt Dimming, on/off/Dim control with Occupant Sensor. Programmable: ON level, PIR Sensitivity, power loss mode, dim mode Std of acceptance: Wattstopper DW-311
S2	Ceiling mounted standard range	Low voltage Ceiling mounted Occupancy Sensor. Programmable: sensitivity, time delay Coverage: 360', 1000 sq ft apx Std of acceptance: Wattstopper LMC0-100
S3	Ceiling mounted Extended range	Low voltage Ceiling mounted Extended Range Occupancy Sensor. Programmable: sensitivity, time delay Coverage: 360', 3600 sq ft Std of acceptance: Wattstopper LMP0-100
S4	Ceiling mounted standard range 120V	120V Ceiling mounted Occupancy Sensor. Programmable: sensitivity, time delay Coverage: 360', 1000 sq ft apx Std of acceptance: Wattstopper DT-355

68 USER LIGHT CONTROLLER SCHEDULE		
TYPE	DESCRIPTION	COMMENTS
C1	Dimming wall Controller	0-10 Volt Dimming, on/off/Dim control with 7-LED level indicator Std of acceptance: Wattstopper LMM-101
C2	5-Button scene Controller	5-Button configurable IR control user interface 0-10 volt controller Std of acceptance: Wattstopper LMSW-105
C3	Integrated sensor, Dimmer, & Controller	0-10 Volt Dimming, on/off/Dim control with Occupant Sensor. Programmable: ON level, PIR Sensitivity, power loss mode, dim mode Std of acceptance: Wattstopper DW-311
C4	4-Button scene Controller	4-Button configurable IR control user interface 0-10 volt controller Std of acceptance: Wattstopper LMSW-104

69 ROOM CONTROLLER DEVICE SCHEDULE		
TYPE	DESCRIPTION	COMMENTS
R1	Room controller, 0-10V w/ 1 Relay (Output)	Room Controller: On/off/0-10 Volt Dimming controller (Interface) with single 120V relay & 0-10 Volt Dimming control out Std of acceptance: Wattstopper LMR0-211
R2	Room controller, 120V w/ 1 Relay (Output)	Room Controller: On/off controller (Interface) 120V Single relay output Std of acceptance: Wattstopper LMR0-211
R3	Room controller, 0-10	

30 PARKING

EXISTING PRIVATE APPROACH

1463 Prince of Wales Drive
 OTTAWA BOYS AND GIRLS CLUB
 EXISTING 1 STOREY BRICK BUILDING
 FFL 82.27

NEW GYMNASIUM
 FFL 82.27

NEW 1 STOREY ADDITION

Symbol	Qty	Label	Manufacturer	Description	Dimming	Watts/Fixture	Total Watts	Lumens/Fixture	LLF
●	1	BT	LUMINUS	CL843-L3W30-CLP843-120V-BKT	0-10V	90	90	8190	0.900
○	5	C	LUMINUS	SY600-L1W18V1-120-BKT-R60	0-10V	18	90	1686	0.900
○	11	D	CONTRAST	A4RAR-111140M + REA4V2	0-10V	23	253	1923	0.900
⊥	3	L1	ECOSENSE	LS0-E-12-04-40-80-MULT-15x35	ELV	4	12	302	0.900
⊥	14	L4	ECOSENSE	LS0-E-48-04-40-80-MULT-15x35	ELV	16	224	1208	0.900
⊥	5	Wp-2S	CREE	SEC-EDG-2S-WM-02-E-UL-BK-700-DIM	0-10V	50	100	3656	0.900
⊥	3	Wp-4M	CREE	SEC-EDG-4M-WM-06-E-UL-BK-700-DIM	0-10V	134	402	10842	0.900
						Total Exterior lighting:		1171	

No.	REVISIONS	DATE
10.		
9.		
8.		
7.		
6.		
5.	ISSUED FOR TENDER	2018-02-06
4.	ISSUED FOR LIGHTING SUBSIDY	2018-01-25
3.	ISSUED FOR PRICING	2017-12-22
2.	ISSUED FOR BUILDING PERMIT (PHASE 2)	2017-10-26
1.	ISSUED FOR REVIEW/COORDINATION	2017-10-05


USE OF THESE DRAWINGS IS RESTRICTED SOLELY TO THE CONSTRUCTION FOR WHICH THEY WERE DEVELOPED. BEKOLAY AND ASSOCIATES LTD. ASSUME NO RESPONSIBILITY FOR ANY SUBSEQUENT USE. DO NOT SCALE THE DRAWINGS BUT RESPECT ANY DIMENSIONS SPECIFICALLY IDENTIFIED IN NOTES OR TEXT. ALL CONTRACTORS MUST VISIT THE SITE AND ARE RESPONSIBLE FOR VERIFYING ANY AND ALL DIMENSIONS THAT RELATE TO THEIR WORK. REPORT ANY DISCREPANCIES IMMEDIATELY TO THE CONSULTANT.

BEKOLAY & Associates. Ltd.
 Consulting Engineers
 200 1817 WOODWARD DR. OTTAWA
 ON K1H 8L4
 Tel: 613-723-0474 Fax: 613-723-0844
 Email: j.parkley@bekolay.ca

PROJECT Prince of Wales Clubhouse
 Boys and Girls Club Renovation

DRAWING Electrical Site Plan

DATE 5-Feb-18 SCALE AS NOTED
 DRAWN BY MAG DESIGNED BY CLW
 JOB NO. 2017-17 CHECKED BY CLW
 DRAWING NO.

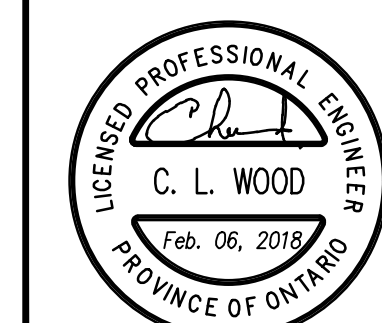

E-8 of 8

Hobin Architecture Incorporated
 63 Pamela Street
 Ottawa, Ontario
 Canada K1S 9K7
 T: 613-238-7200
 F: 613-235-2005
 E: mail@hobinarc.com
 hobinarc.com

HOBIN ARCHITECTURE