



SUPPLEMENTAL INSTRUCTION

CONTRACTOR:
Tal-co Building Innovations
Address:
Suite 2, 1341 Coker Street
Greely, Ontario, K4P 1A1

PROJ.: **Boys and Girls Club Prince of Wales**
PROJ. No.: **1716**
DATE: **July 11, 2018**
S.I. No. **S.I. - 036**

Supplemental Instructions are issued to the Construction Manager to record a clarification or revision to the previously issued Contract Documentation as reflected by the attached Information Bulletin prepared by the identified Consultant.

The Construction Manager shall review the Supplemental Instruction and the attached Information Bulletin and issue to the effected Trade Contractors identifying the following course of action by the trade contractor:

- Proceed with Instruction. Issued for general information, no change to Contract price or schedule. (Site Instruction)
- Proceed with Instruction and provide a quotation within 10 days, identifying change to Contract price and schedule (Change Directive)
- Do not proceed. Provide quotation identifying change to Contract price and schedule within 10 days. (CCO)

Partners

Barry J. Hobin
OAA, FRAIC, Hon. Fellow AIA

William A. Davis
OAA, MRAIC, Associate AIA

Gordon Lorimer
OAA, FRAIC, Associate AIA

Wendy Brawley
OAA, MRAIC, Associate AIA

Douglas Brooks
Senior Arch. Tech.

Associates

Bryan Bonell
OAA, MRAIC, Associate AIA

Marc Thivierge
OAA, MRAIC

William Ritcey
MRAIC

Reinhard Vogel
Senior Arch. Tech.

1.1 TITLE

Filling of block course at Grid K, Phase 2

1.2 DESCRIPTION OF THE WORK

.1 Refer to attached IB-S05-A providing information about filling block courses in location where concrete block overhangs the foundation wall by more than 10mm.

1.3 ATTACHMENTS

IB-S05-A, and SK6 Sections 1 and 1A revised.

1.4 REASON

To accommodate as built conditions.

Hobin Architecture Incorporated

63 Pamilla Street
Ottawa, Ontario
Canada K1S 3K7

t 613-238-7200
f 613-235-2005

hobinarc.com

Distribution:

- | | | | | |
|--|--|-------------------------------------|---|--------------------------------------|
| <input checked="" type="checkbox"/> Owner | <input type="checkbox"/> City Authority | <input type="checkbox"/> Electrical | <input checked="" type="checkbox"/> Struct. | <input type="checkbox"/> Landscaping |
| <input checked="" type="checkbox"/> Contractor | <input checked="" type="checkbox"/> File | <input type="checkbox"/> Mech. | <input type="checkbox"/> Civil | <input type="checkbox"/> Other |



Information Bulletin S05-A

Issued to: Hobin Architecture
Inc

JULY 10, 2018

Project: BOYS & GIRLS CLUB OF OTTAWA-ADDITION-1463 PRINCE OF WALES DR

Project No.: 17-007

Architect: Hobin Architecture Inc.

The following clarification and revision items are noted, as they relate to the specifications and drawings previously issued.

STRUCTURAL ITEMS

1. Title: STRUCTURAL REVISIONS

2. Attachments:

.1 SK6


3. Description:

.1 SK6 SECTIONS 1 & 1A-REVISED TO SUIT AS-BUILT CONDITIONS (REF: DWG S300)


4. Comments:

The face of the foundation wall on the Phase 2 side of sections 1 & 1A is constructed such that, when the new 240 mm block is installed, the block overhangs the concrete by between 15 mm & 25 mm instead of the originally noted 10 mm. The grouting of the bottom 2 courses of block as noted in SK6 is necessary to accommodate the aforementioned block overhang.

END OF BULLETIN

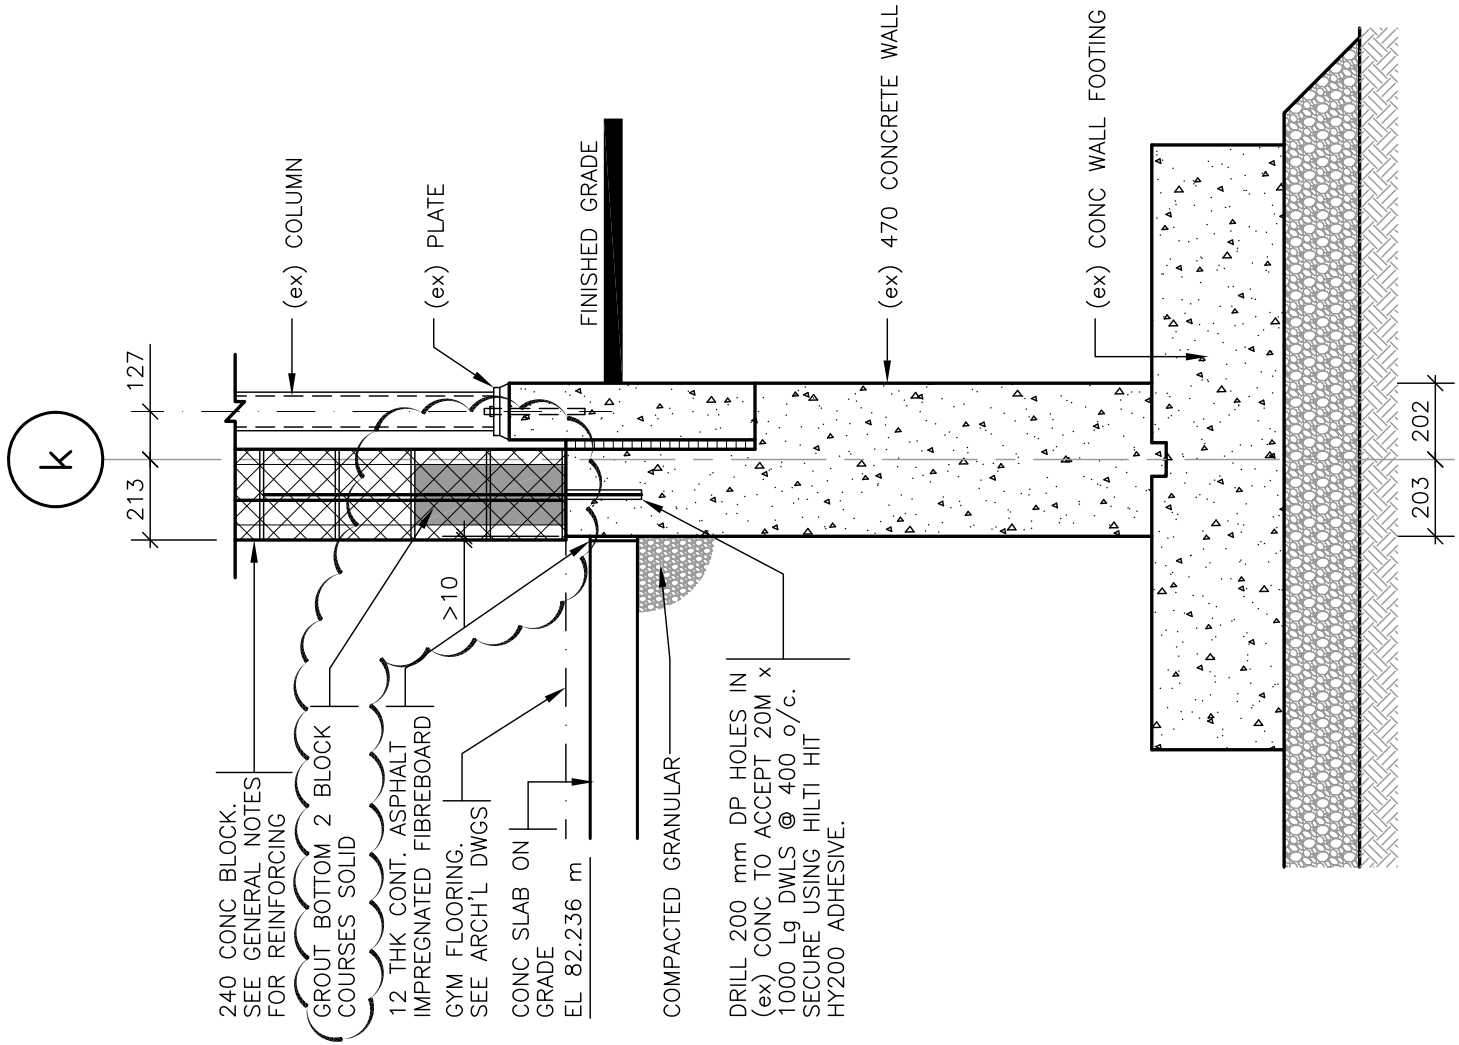

1A SECTION
1 : 20
S100

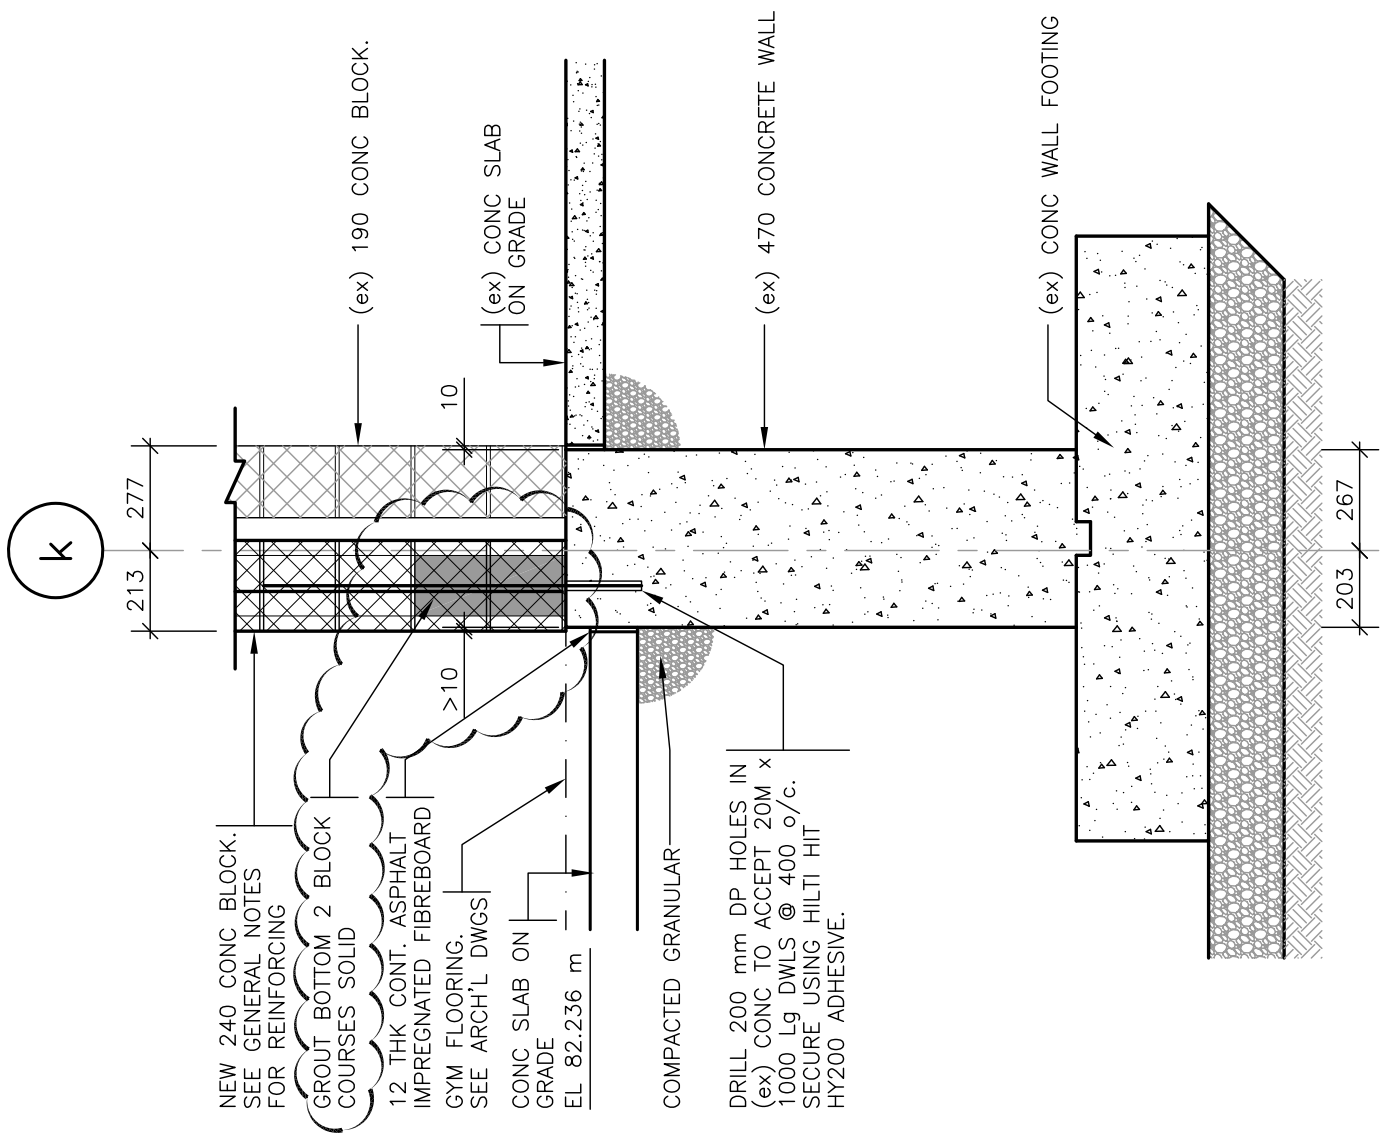

1 SECTION
1 : 20
S100

STAMP

LICENSED PROFESSIONAL ENGINEER
7/10/2018
R. I. CUNLIFFE
Province of Ontario

TITLE:	SECTIONS 1 & 1A-REVISED TO SUIT AS-BUILT CONDITIONS (REF: DWG S300)
PROJECT:	BOYS & GIRLS CLUB OF OTTAWA-ADDITION-1463 PRINCE OF WALES DR
CLIENT:	HOBIN ARCHITECTURE INC.

CUNLIFFE & ASSOCIATES
CONSULTING STRUCTURAL ENGINEERS
102-1737 WOODWARD DR OTTAWA K2C 0P9

TEL 729-7242
FAX 728-1461

DATE:	JULY 10/2018
PROJ No.:	17-007
DWG. No.:	IB-S05-A-SK6