



SUPPLEMENTAL INSTRUCTION

CONTRACTOR:
Tal-co Building Innovations
Address:
Suite 2, 1341 Coker Street
Greely, Ontario, K4P 1A1

PROJ.: **Boys and Girls Club Prince of Wales**
PROJ. No.: **1716**
DATE: **September 05, 2018**
S.I. No. **S.I. - 042**

Supplemental Instructions are issued to the Construction Manager to record a clarification or revision to the previously issued Contract Documentation as reflected by the attached Information Bulletin prepared by the identified Consultant.

The Construction Manager shall review the Supplemental Instruction and the attached Information Bulletin and issue to the effected Trade Contractors identifying the following course of action by the trade contractor:

- Proceed with Instruction. Issued for general information, no change to Contract price or schedule. (Site Instruction)
- Proceed with Instruction and provide a quotation within 10 days, identifying change to Contract price and schedule (Change Directive)
- Do not proceed. Provide quotation identifying change to Contract price and schedule within 10 days. (CCO)

Partners

Barry J. Hobin
OAA, FRAIC, Hon. Fellow AIA

William A. Davis
OAA, MRAIC, Associate AIA

Gordon Lorimer
OAA, FRAIC, Associate AIA

Wendy Brawley
OAA, MRAIC, Associate AIA

Douglas Brooks
Senior Arch. Tech.

Associates

Bryan Bonell
OAA, MRAIC, Associate AIA

Marc Thivierge
OAA, MRAIC

William Ritcey
MRAIC

Reinhard Vogel
Senior Arch. Tech.

1.1 TITLE
Revision to Parapet detail at Grid x2

1.2 DESCRIPTION OF THE WORK
.1 Please refer to attached IB-A019 providing a revised detail for the parapet along Grid x2.

1.3 ATTACHMENTS
BGCO-IB-A019

1.4 REASON
To accommodate as built concrete block not extending to full parapet height at grid x2.

Hobin Architecture Incorporated

63 Pamilla Street
Ottawa, Ontario
Canada K1S 3K7

t 613-238-7200
f 613-235-2005

hobinarc.com

Distribution:

- | | | | | |
|--|--|-------------------------------------|----------------------------------|--------------------------------------|
| <input checked="" type="checkbox"/> Owner | <input type="checkbox"/> City Authority | <input type="checkbox"/> Electrical | <input type="checkbox"/> Struct. | <input type="checkbox"/> Landscaping |
| <input checked="" type="checkbox"/> Contractor | <input checked="" type="checkbox"/> File | <input type="checkbox"/> Mech. | <input type="checkbox"/> Civil | <input type="checkbox"/> Other |



INFORMATION BULLETIN

CONSTRUCTION MANAGER:

Tal-co Building Innovations

Address:

Suite 2, 1341 Coker Street
Greely, Ontario, K4P 1A1

PROJ.:

**Boys and Girls Club Prince
of Wales**

PROJ. No.:

1716

DATE:

September 5, 2018

I.B. No.

IB-A019

The following Information Bulletin is issued to the Construction Manager to describe additional information, or a revision to, previously issued documentation.

Partners

Barry J. Hobin
OAA, FRAIC, Hon. Fellow AIA

William A. Davis
OAA, MRAIC, Associate AIA

Gordon Lorimer
OAA, FRAIC, Associate AIA

Wendy Brawley
OAA, MRAIC, Associate AIA

Douglas Brooks
Senior Arch. Tech.

Associates

Bryan Bonell
OAA, MRAIC, Associate AIA

Marc Thivierge
OAA, MRAIC

William Ritcey
MRAIC

Reinhard Vogel
Senior Arch. Tech.

1.1 TITLE

Revision to Parapet detail at Grid x2

1.2 REFERENCE

Architectural Drawings A5.02, ASK-015

1.3 DESCRIPTION OF WORK

.1 Revise parapet detail at grid x2 from being block to being wood frame to accommodate as-built block condition and to make parapet similar to x2 at corners above the windows.

1.4 ATTACHMENT

ASK-015 – Parapet At Grid x2

1.5 REASON

To accommodate as-built concrete block at parapet.

Issued by:
Doug van den Ham


Hobin Architecture Incorporated

63 Pamilla Street
Ottawa, Ontario
Canada K1S 3K7

t 613-238-7200

f 613-235-2005


hobinarc.com

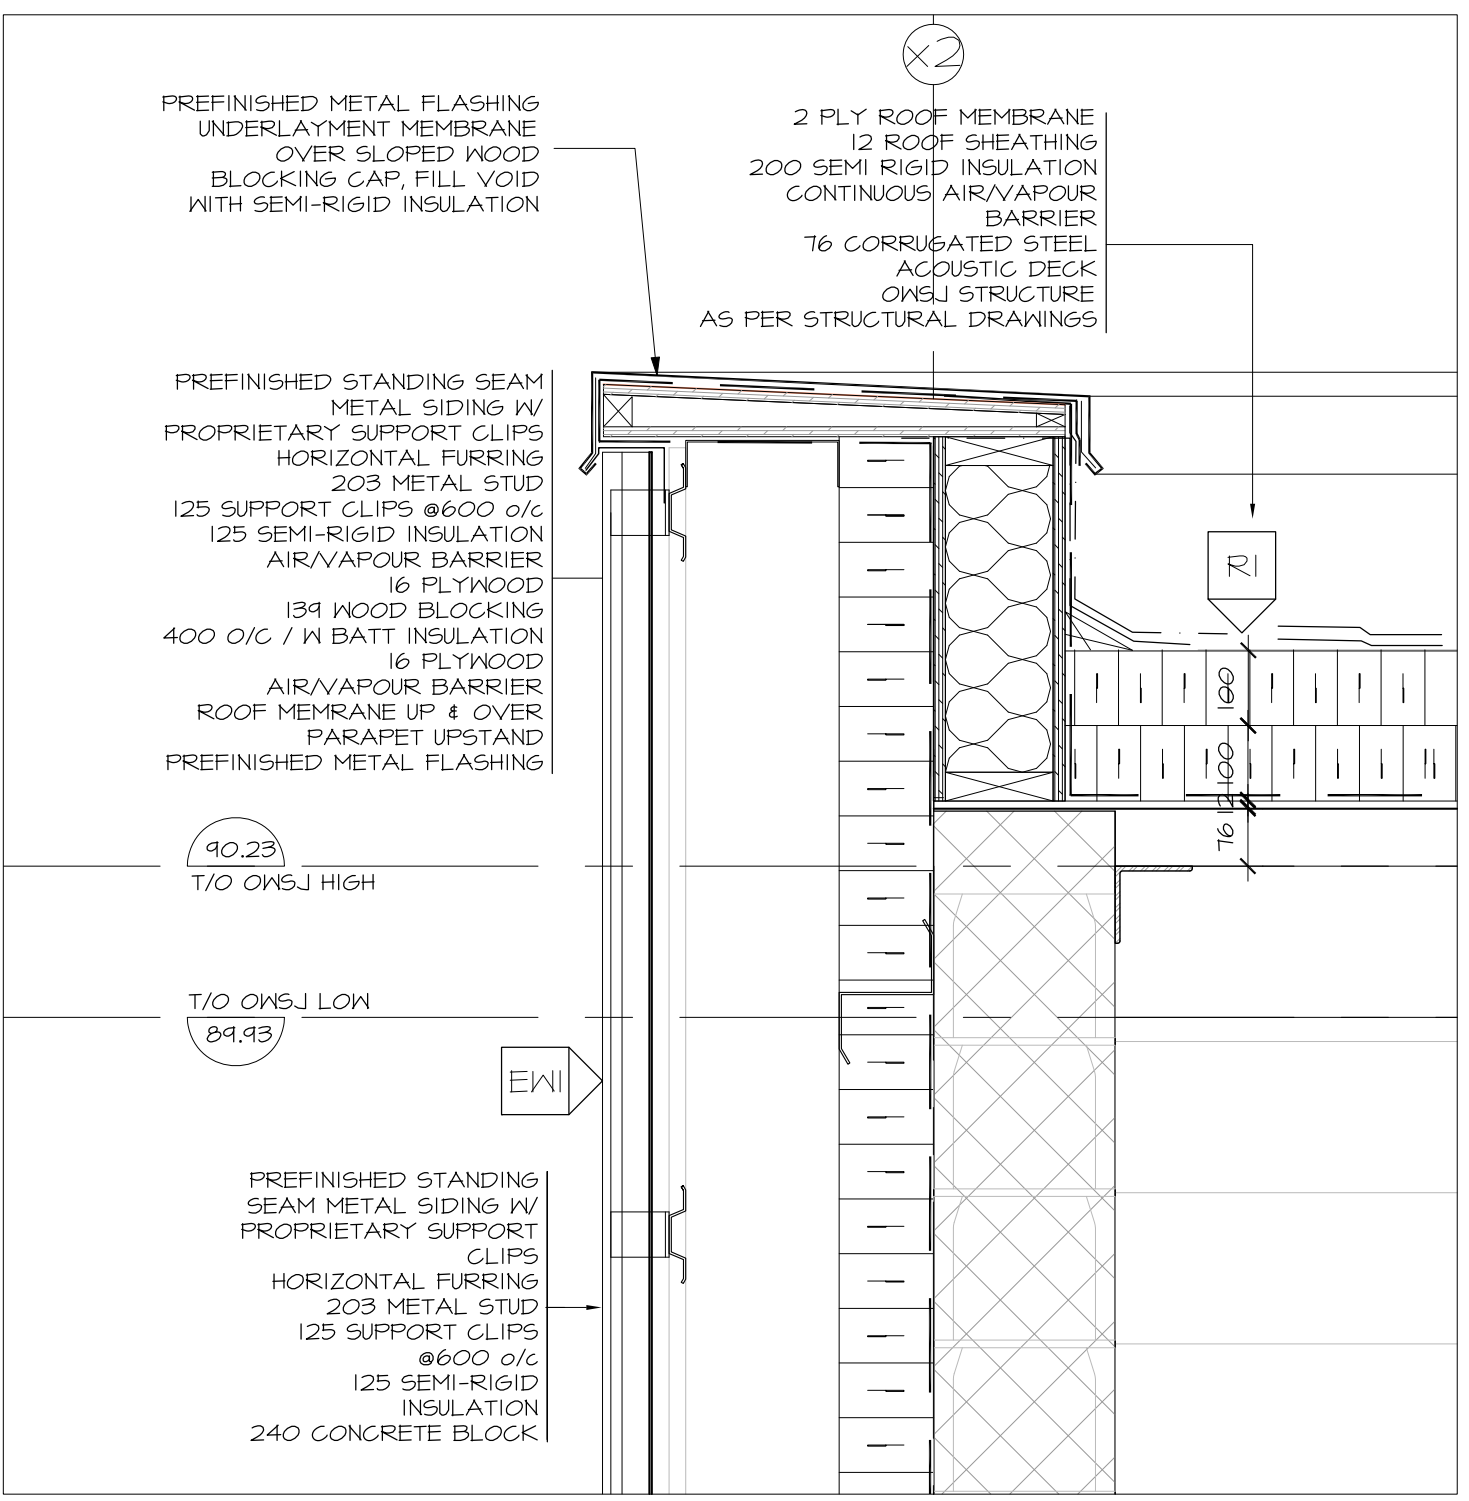

5
A5.02

REVISED PARAPET AT WEST END OF GYM

SCALE 1:10

 <p>HOBIN ARCHITECTURE</p>	<p>PROJECT / LOCATION: BOYS & GIRLS CLUB OTTAWA PRINCE OF WALES</p>	<p>DRAWING NAME: REVISED 5/A5.02 PARAPET AT GRID X2 (GYM ROOF)</p>	<p>DATE: 2018/09/05</p>	<p>DRAWN BY: DVDH</p>	<p>SCALE: 1:10</p>
	<p>Hobin Architecture Incorporated 63 Pamilla Street T: 613-238-7200 Ottawa, ON K1S 3K7 F: 613-235-2005 hobinarc.com E: mail@hobinarc.com</p>		<p>PROJECT NO.: 1716</p>	<p>ASK NO. ASK-015</p>	