

SHOP DRAWING TRANSMITTAL



Project: Turnbull School Music Room Addition Project No: 1705
Date: October 22, 2018
To: TALCO Building Innovations Ltd.
Attn: Farah Bano (fbano@tal-co.com)
From: Reinhard Vogel

- | | |
|--------------------------------------------------|--------------------------------------------|
| <input type="checkbox"/> Approval | <input type="checkbox"/> Courier |
| <input checked="" type="checkbox"/> Distribution | <input type="checkbox"/> By Hand |
| <input type="checkbox"/> Information and Use | <input type="checkbox"/> Fax |
| <input type="checkbox"/> Review and Comment | <input type="checkbox"/> To Be Picked Up |
| <input type="checkbox"/> Other | <input checked="" type="checkbox"/> e-mail |

Partners

Barry J. Hobin
OAA, FRAIC, Hon. Fellow AIA
William A. Davis
OAA, MRAIC, Associate AIA
Gordon Lorimer
OAA, FRAIC, Associate AIA
Wendy Brawley
OAA, MRAIC, Associate AIA
Douglas Brooks
Senior Arch. Tech.

Directors

Marc Thivierge
OAA, MRAIC
Reinhard Vogel
Senior Arch. Tech.

Associates

Bryan Bonell
OAA, MRAIC, Associate AIA
William Ritcey
MRAIC
Dan Henhoeffter
Senior Arch. Tech.

Hobin Architecture Incorporated

63 Pamilla Street
Ottawa, Ontario
Canada K1S 3K7

t 613-238-7200
f 613-235-2005

hobinarc.com

Shop Drawing Submittal: Division 05 - Metals
Submitted by: CANAM
Drawing Title: Steel Deck and Joist Shop Drawings
Revision No. a
Dated: 3/10/18

Comments:

Reviewed as noted.

Project Comments :

Grid Line A - Minimum Seat t = 7.9 mm
 Grid Line C - Minimum Seat t = 9.5 mm
 All seats - Minimum Edge Distance = 32 mm

Design Enclosed :

M100, M101, M102, M103, M104

Design Comments :

There is no comment.

SHOP DRAWING REVIEW

REVIEWED

REVIEWED AS NOTED

REVISE AND RESUBMIT



"This review is for the sole purpose of ascertaining conformance with the general design concept for architectural features only, and does not in any way constitute review of the design of engineering elements which form part of the Contract Documents prepared by others. This review shall not mean that the Architect approves the detail design inherent in the shop drawings. This responsibility shall remain with the Contractor submitting same, and such review shall not relieve the Contractor of his responsibility for errors or omissions in the shop drawings or of his responsibility for meeting all requirements of the Contract Documents. The Contractor is responsible for dimensions to be confirmed and correlated at the job site, for information that pertains solely to fabrication processes, or to techniques of construction and installation and for co-ordination for the work of all trades."

By: Reinhard Vogel Date: 10/22/2018
 HOBIN ARCHITECTURE INCORPORATED


SHOP DRAWING REVIEW	
CUNLIFFE & ASSOCIATES	
This review is for the sole purpose of determining general conformance with the Structural Drawings. This review does not mean that Cunliffe & Associates approves the detail design inherent in the shop drawings. The responsibility for which remains with the Contractor submitting the shop drawings. Our review does not relieve the contractor of his responsibility for errors or omissions in the shop drawings or meeting the requirements of the Contract Documents. The Contractor is responsible for dimensions to be confirmed and correlated at the job site and information that pertains solely to fabrication processes or to techniques of construction installation and for co-ordination of the work of all subtrades.	
<input type="checkbox"/> REVIEWED AS NOTED <input checked="" type="checkbox"/> REVIEWED <input type="checkbox"/> RESUBMIT	CHK'D BY NH DATE 10/22/18



Project: TURNBULL MUSIC ROOM ADDITION

JOIST CALCULATION ACCORDING TO S16-09, S136-07 & NBC 2010 (rev 2017)

Mark : M100 (Hybrid Mid-Span, Symmetrical,, Free ends)

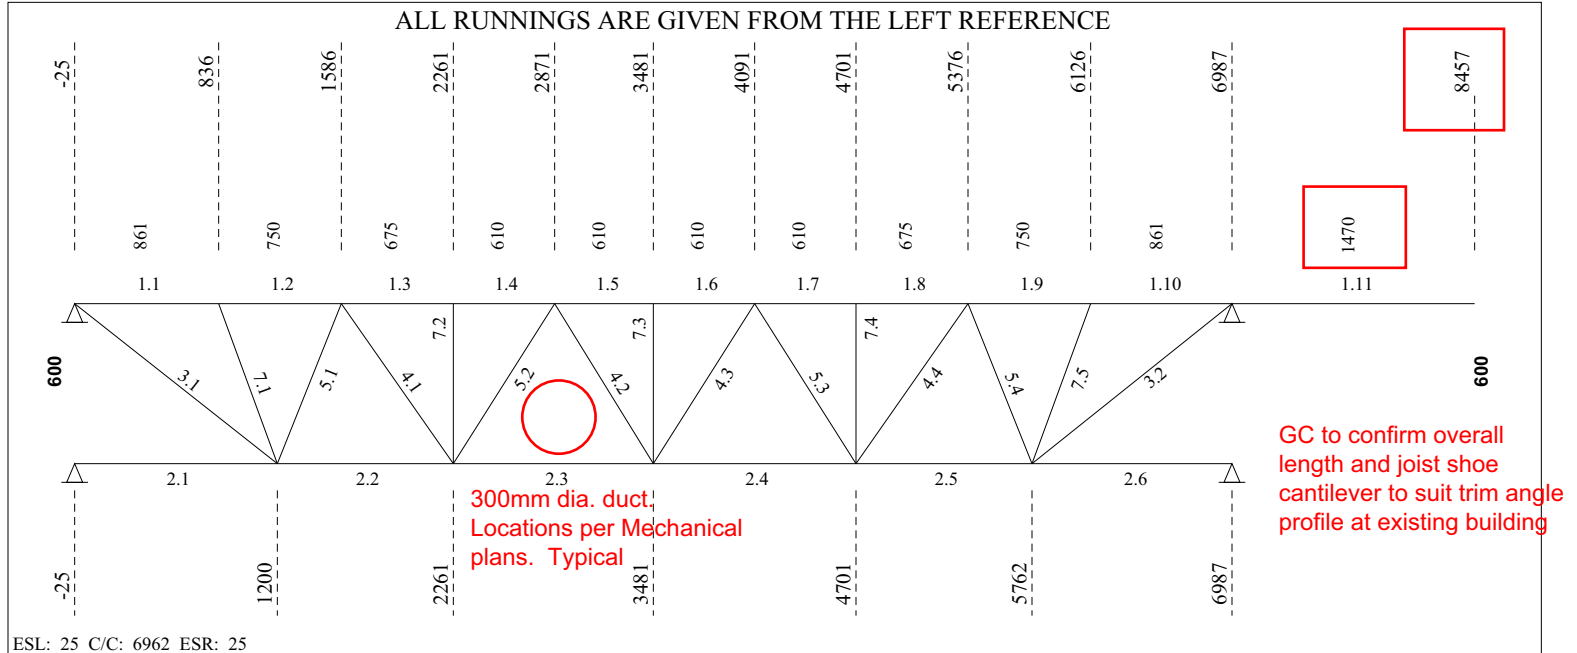

LOADING CONDITIONS

(THE SHOWN VALUES ARE UN-FACTORED)

(D) DEAD LOAD.....:	1.55 kN/m ² (1.47 kN/m)	SPACING....:	0.95 m
(L) LIVE LOAD.....:	0.00 kN/m ² (0.00 kN/m)	Companion load factor (live)....:	1.0
(S) SNOW LOAD.....:	3.50 kN/m ² (3.33 kN/m)		
(W) GROSS WIND UPLIFT:	1.37 kN/m ² (1.30 kN/m)		

EXTENSION

RIGHT: Length.. = 1470 mm	-----LOADS [kN/m]-----			
Depth... = 200 mm	Dead (D)	Live (L)	Snow (S)	Wind (W)
Type.... = N[S]	1.47	0.00	3.33	1.30
Mf..... = -18.699 kN-m (0.557)	-----END DEFLECTIONS [mm (L/xxx)]-----			
I..... = 9.37 x10 ⁶ mm ⁴	Required		Calculated	
Top Splice...: LL 5 x 5 x 1/2 x 3156 mm	L+0.9S	: 8.17 (L/180)	4.76 (L/309)	
	Total	: 16.33 (L/90)	4.64 (L/317)	

CONCENTRATED LOADS (From Axis)

No	Sp	Hole	Dead Load [kN]	Live load [kN]	Snow Load [kN]	Gross Uplift [kN]	Position [mm]	Spacing [mm]	Cat. 0-9	Chord 1/2	Incl. [deg]
1	1	No	0.50	0.00	0.00	0.00	0				
2	1	No	0.00	0.00	0.00	-19.00	2226*	22			



2018-10-18

----- PARTIAL LOADS (From Axis) -----

No	Span	Left		Right		Start [mm]	Length [mm]	Chord Cat.	
		[kN/m ²]	[kN/m]	[kN/m ²]	[kN/m]				
1	1	0.00	0.00	5.91	5.61	0	6962	1	8
2	3	5.91	5.61	7.11	6.75	0	1470	1	8

----- END MOMENTS [kN-m] & AXIAL LOADS [kN] -----

	MOMENTS				AXIAL LOADS			
	--- <th colspan="2">---R---</th> <th colspan="2"><<< Top Chord >>></th> <th colspan="2"><< Bottom Chord >></th>		---R---		<<< Top Chord >>>		<< Bottom Chord >>	
	L	R	L	R	L	R	L	R
(W) Wind (case 1).....:	0.00	0.00	-5.00	5.00	0.00	0.00	0.00	0.00
(case 2).....:	0.00	0.00	5.00	-5.00	0.00	0.00	0.00	0.00
(L) Live Load.....:	0.00	0.00	0.00	0.00	0.00	0.00	0.00	0.00
(S) Snow Load.....:	0.00	0.00	0.00	0.00	0.00	0.00	0.00	0.00
(D) Dead Load.....:	0.00	0.00	0.00	0.00	0.00	0.00	0.00	0.00
(E) Seism (case 1).....:	0.00	0.00	-7.00	7.00	0.00	0.00	0.00	0.00
(case 2).....:	0.00	0.00	7.00	-7.00	0.00	0.00	0.00	0.00

Axial Force Transf.By.: at left: Weld Plate at right: Seat
 Reinforcement Type....: at left: C at right: 7 [0]
 Bearing Depth [mm]: at left: 100 at right: 200
 Splice [Yes/No].....: Yes Imposed Rows of Bridging Y/N...: No

----- (REAL) DEFLECTION -----

Allowed deflection under live and snow load..... = 19.20 mm (L/ 360)
 Calculated deflection under combined loads (L + 0.9S) = 6.51 mm (L/ 1062)
 Gross joist inertia..... = 128.55 x10⁶ mm⁴
 Required camber..... = 14.02 mm
 Use of the joist (Ref. S16-09, art.16.5.1)..... = Roof

===== LOAD NO 2 (M100#02) =====

----- LOADING CONDITIONS -----

(THE SHOWN VALUES ARE UN-FACTORED)

(D) DEAD LOAD.....: 1.55 kN/m² (1.47 kN/m) SPACING...: 0.95 m
 (L) LIVE LOAD.....: 0.00 kN/m² (0.00 kN/m) Companion load factor (live)...: 1.0
 (S) SNOW LOAD.....: 3.50 kN/m² (3.33 kN/m)
 (W) GROSS WIND UPLIFT: 1.37 kN/m² (1.30 kN/m)

----- EXTENSION -----

RIGHT:	Length.. = 1470 mm	-----LOADS [kN/m]-----			
	Depth... = 200 mm	Dead (D)	Live (L)	Snow (S)	Wind (W)
	Type.... = N[S]	1.47	0.00	3.33	1.30
	Mf..... = -18.699 kN-m	-----END DEFLECTIONS [mm (L/xxx)]-----			
		Required		Calculated	
		L+0.9S	: 8.17 (L/180)	4.76 (L/309)	
		Total	: 16.33 (L/90)	4.64 (L/317)	

----- CONCENTRATED LOADS (From Axis) -----

No	Sp	Hole	Dead Load [kN]	Live load [kN]	Snow Load [kN]	Gross Uplift [kN]	Position [mm]	Spacing [mm]	Cat.	Chord	Incl. [deg]
1	1	No	0.50	0.00	0.00	0.00	0	0	4	2	90
2	1	No	0.00	0.00	0.00	-19.00	2226*	2226	1	1	90

----- PARTIAL LOADS (From Axis) -----

No	Span	Left		Right		Start [mm]	Length [mm]	Chord Cat.	
		[kN/m ²]	[kN/m]	[kN/m ²]	[kN/m]				
1	1	0.00	0.00	5.91	5.61	0	6962	1	8
2	3	5.91	5.61	7.11	6.75	0	1470	1	8

----- END MOMENTS [kN-m] & AXIAL LOADS [kN] -----

	MOMENTS				AXIAL LOADS			
	--- <th colspan="2">---R---</th> <th colspan="2"><<< Top Chord >>></th> <th colspan="2"><< Bottom Chord >></th>		---R---		<<< Top Chord >>>		<< Bottom Chord >>	
	L	R	L	R	L	R	L	R
(W) Wind (case 1).....:	0.00	0.00	-5.00	5.00	0.00	0.00	0.00	0.00
(W) Wind (case 2).....:	0.00	0.00	5.00	-5.00	0.00	0.00	0.00	0.00
(L) Live Load.....:	0.00	0.00	0.00	0.00	0.00	0.00	0.00	0.00
(S) Snow Load.....:	0.00	0.00	0.00	0.00	0.00	0.00	0.00	0.00
(D) Dead Load.....:	0.00	0.00	0.00	0.00	0.00	0.00	0.00	0.00
(E) Seism (case 1).....:	0.00	0.00	-7.00	7.00	0.00	0.00	0.00	0.00
(E) Seism (case 2).....:	0.00	0.00	7.00	-7.00	0.00	0.00	0.00	0.00

Axial Force Transf.By.: at left: Weld Plate at right: Seat
 Reinforcement Type....: at left: C at right: 7 [0]
 Bearing Depth [mm]: at left: 100 at right: 200
 Splice [Yes/No].....: Yes Imposed Rows of Bridging Y/N...: No

----- (REAL) DEFLECTION -----

Allowed deflection under live and snow load..... = 19.20 mm (L/ 360)
 Calculated deflection under combined loads (L + 0.9S) = 6.51 mm (L/ 1062)
 Use of the joist (Ref. S16-09, art.16.5.1)..... = Roof

===== LOAD NO 3 (M100#03) =====

----- LOADING CONDITIONS -----

(THE SHOWN VALUES ARE UN-FACTORED)

(D) DEAD LOAD.....:	1.55 kN/m ² (1.47 kN/m)	SPACING....:	0.95 m
(L) LIVE LOAD.....:	0.00 kN/m ² (0.00 kN/m)	Companion load factor (live)....:	1.0
(S) SNOW LOAD.....:	3.50 kN/m ² (3.33 kN/m)		
(W) GROSS WIND UPLIFT:	1.37 kN/m ² (1.30 kN/m)		

----- EXTENSION -----

RIGHT:	Length.. = 1470 mm	-----LOADS [kN/m]-----			
Depth... = 200 mm		Dead (D)	Live (L)	Snow (S)	Wind (W)
Type.... = N[S]		1.47	0.00	3.33	1.30
Mf..... = -18.699 kN-m		-----END DEFLECTIONS [mm (L/xxx)]-----			
		Required		Calculated	
		L+0.9S	: 8.17 (L/180)	4.76 (L/309)	
		Total	: 16.33 (L/90)	4.64 (L/317)	

----- CONCENTRATED LOADS (From Axis) -----

No	Sp	Hole	Dead Load [kN]	Live load [kN]	Snow Load [kN]	Gross Uplift [kN]	Position [mm]	Spacing [mm]	Cat.	Chord 1/2	Incl. [deg]
1	1	No	0.50	0.00	0.00	0.00	0	0	4	2	90
2	1	No	0.00	0.00	0.00	19.00	2226*	2226	1	1	90

----- PARTIAL LOADS (From Axis) -----

No	Span	Left		Right		Start [mm]	Length [mm]	Chord Cat.	
		[kN/m ²]	[kN/m]	[kN/m ²]	[kN/m]				
1	1	0.00	0.00	5.91	5.61	0	6962	1	8
2	3	5.91	5.61	7.11	6.75	0	1470	1	8

----- END MOMENTS [kN-m] & AXIAL LOADS [kN] -----

	MOMENTS				AXIAL LOADS			
	--- <th colspan="2">---R---</th> <th colspan="2"><<< Top Chord >>></th> <th colspan="2"><< Bottom Chord >></th>		---R---		<<< Top Chord >>>		<< Bottom Chord >>	
	L	R	L	R	L	R	L	R
(W) Wind (case 1).....:	0.00	0.00	-5.00	5.00	0.00	0.00	0.00	0.00
(W) Wind (case 2).....:	0.00	0.00	5.00	-5.00	0.00	0.00	0.00	0.00
(L) Live Load.....:	0.00	0.00	0.00	0.00	0.00	0.00	0.00	0.00
(S) Snow Load.....:	0.00	0.00	0.00	0.00	0.00	0.00	0.00	0.00
(D) Dead Load.....:	0.00	0.00	0.00	0.00	0.00	0.00	0.00	0.00
(E) Seism (case 1).....:	0.00	0.00	-7.00	7.00	0.00	0.00	0.00	0.00
(E) Seism (case 2).....:	0.00	0.00	7.00	-7.00	0.00	0.00	0.00	0.00

Axial Force Transf.By.: at left: Weld Plate at right: Seat
 Reinforcement Type....: at left: C at right: 7 [0]
 Bearing Depth [mm]: at left: 100 at right: 200
 Splice [Yes/No].....: Yes Imposed Rows of Bridging Y/N...: No

----- (REAL) DEFLECTION -----

Allowed deflection under live and snow load..... = 19.20 mm (L/ 360)
 Calculated deflection under combined loads (L + 0.9S) = 6.51 mm (L/ 1062)
 Use of the joist (Ref. S16-09, art.16.5.1)..... = Roof

===== LOAD NO 4 (M100#04) =====

----- LOADING CONDITIONS -----

(THE SHOWN VALUES ARE UN-FACTORED)

(D) DEAD LOAD.....:	1.55 kN/m ² (1.47 kN/m)	SPACING....:	0.95 m
(L) LIVE LOAD.....:	0.00 kN/m ² (0.00 kN/m)	Companion load factor (live)....:	1.0
(S) SNOW LOAD.....:	3.50 kN/m ² (3.33 kN/m)		
(W) GROSS WIND UPLIFT:	1.37 kN/m ² (1.30 kN/m)		

----- EXTENSION -----

RIGHT: Length.. = 1470 mm Depth... = 200 mm Type.... = N[S] Mf..... = -18.699 kN-m	LOADS [kN/m]			
	Dead (D)	Live (L)	Snow (S)	Wind (W)
	1.47	0.00	3.33	1.30
-----END DEFLECTIONS [mm (L/xxx)]-----				
	Required		Calculated	
L+0.9S	: 8.17	(L/180)	4.76	(L/309)
Total	: 16.33	(L/90)	4.64	(L/317)

----- CONCENTRATED LOADS (From Axis) -----

No	Sp	Hole	Dead Load [kN]	Live load [kN]	Snow Load [kN]	Gross Uplift [kN]	Position [mm]	Spacing [mm]	Cat.	Chord 1/2	Incl. [deg]
1	1	No	0.50	0.00	0.00	0.00	0	0	4	1	90
2	1	No	0.00	0.00	0.00	19.00	2226*	2226	1	1	90

----- PARTIAL LOADS (From Axis) -----

No	Span	Left		Right		Start [mm]	Length [mm]	Chord Cat.	
		[kN/m ²]	[kN/m]	[kN/m ²]	[kN/m]				
1	1	0.00	0.00	5.91	5.61	0	6962	1	8
2	3	5.91	5.61	7.11	6.75	0	1470	1	8

----- END MOMENTS [kN-m] & AXIAL LOADS [kN] -----

	MOMENTS				AXIAL LOADS			
	---L---		---R---		<<< Top Chord >>>		<< Bottom Chord >>	
(W) Wind (case 1).....:	0.00	0.00	-5.00	5.00	0.00	0.00	0.00	0.00
(W) Wind (case 2).....:	0.00	0.00	5.00	-5.00	0.00	0.00	0.00	0.00
(L) Live Load.....:	0.00	0.00	0.00	0.00	0.00	0.00	0.00	0.00
(S) Snow Load.....:	0.00	0.00	0.00	0.00	0.00	0.00	0.00	0.00
(D) Dead Load.....:	0.00	0.00	0.00	0.00	0.00	0.00	0.00	0.00
(E) Seism (case 1).....:	0.00	0.00	-7.00	7.00	0.00	0.00	0.00	0.00
(E) Seism (case 2).....:	0.00	0.00	7.00	-7.00	0.00	0.00	0.00	0.00

Axial Force Transf.By.: at left: Weld Plate at right: Seat
 Reinforcement Type....: at left: C at right: 7 [0]
 Bearing Depth [mm]: at left: 100 at right: 200
 Splice [Yes/No].....: Yes Imposed Rows of Bridging Y/N...: No

----- (REAL) DEFLECTION -----

Allowed deflection under live and snow load..... = 19.20 mm (L/ 360)
 Calculated deflection under combined loads (L + 0.9S) = 6.51 mm (L/ 1062)
 Use of the joist (Ref. S16-09, art.16.5.1)..... = Roof

===== End of multiple loads =====

----- F O R C E S I N M E M B E R S [kN] -----

(THE SHOWN FORCES ARE FACTORED)

Gap.....: 25.4 / 34.925 (Fy = 380 MPa U/N) (Eff. depth = 573.99 mm)

Left Reaction = 36.65/ -19.71 kN Right Reaction = 70.14/ -11.13 kN

REQUIRED MATERIAL

REQUIRED WELD

No	Tension	Compres.	x = tied at mid-length	Slend. Util.	Length	Weld-Ea.Side	Remarks
Top Chord							
1.1	47.26	-70.22	LL 2 x 2 x 1/4	z 73 0.38	861		
1.2	47.02	-66.54	do	z 68 0.41	750		
1.3	81.95	-110.23	do	z 61 0.52	675		
1.4	81.95	-110.23	do	z 55 0.48	610		
1.5	64.31	-120.70	do	z 55 0.43	do		
1.6	64.31	-120.70	do	z 55 0.47	do		
1.7	45.39	-103.15	do	z 55 0.47	610		
1.8	45.39	-103.15	LL 2 x 2 x 1/4	z 61 0.94	675		
1.9	28.90	-62.08	LL 5 x 5 x 1/2	z 27 0.14	750		
1.10	33.69	-57.64	do	z 29 0.56	861		
1.11	0.00	0.00	LL 5 x 5 x 1/2	z 59 0.56	1470		
Bottom Chord							
2.1	0.00	0.00	LL 1 1/2 x 1 1/2 x 5/32	z 157 0.51	1225		
2.2	82.89	-52.56 x	do	xx 91 0.82	1061		
2.3	116.62	-65.98 x	do	xx104 0.92	1220		
2.4	113.80	-47.69 x	do	xx104 0.70	1220		
2.5	79.70	-27.04	do	z 142 0.68	1061		
2.6	0.00	0.00	LL 1 1/2 x 1 1/2 x 5/32	z 157 0.51	1225		

F O R C E S I N M E M B E R S (Cont.) [kN]

No	Tension	Compres.	REQUIRED MATERIAL			REQUIRED WELD		Remarks
			x = tied at mid-length	Slend.	Util.	Length	Weld-Ea.Side	
End Diagonal								
3.1	73.18	-42.91	1"RB + U 1 3/8 x 0.118 (50%)	z 168	0.94	1319	5.84 - 41	
3.2	60.98	-30.60	SB 1 (50W)	z 180	0.93	1319	6.35 - 38	
Diagonal Towards End								
4.1	35.38	-28.47	U 1 x 1 1/4 x 0.136	z 93	0.94	903	3.45 - 38	
4.2	16.02	-14.00	U 1 x 0.091	z 91	0.73	856	2.29 - 38	
4.3	15.65	-14.19	U 1 x 0.091	z 91	0.74	856	2.29 - 38	
4.4	29.80	-14.33	U 1 x 1 1/4 x 0.136	z 93	0.47	903	3.45 - 38	
Diagonal Towards Center								
5.1	22.87	-33.05	d U 1 3/8 x 0.136	z 59	0.63	713	3.45 - 38	
5.2	13.21	-21.00	U 1 x 1 1/8 x 0.118	z 88	0.77	856	3.00 - 38	
5.3	13.35	-23.20	U 1 x 1 1/8 x 0.118	z 88	0.86	856	3.00 - 38	
5.4	12.10	-45.42	d U 1 3/8 x 0.136	z 59	0.87	713	3.45 - 43	
Secondary Web Member								
7.1	0.46	-9.34	U 1 x 7/8 x 0.091	z 96	0.46	702	2.30 - 25	
7.2	26.92	-31.20	U 1 x 1 1/8 x 0.118	z 61	0.81	600	3.00 - 34	
7.3	0.30	-9.75	U 1 x 7/8 x 0.091	z 82	0.40	do	2.30 - 25	
7.4	0.32	-9.07	U 1 x 1 1/8 x 0.118	z 61	0.24	600	3.00 - 25	
7.5	36.74	-5.22	i U 1 3/8 x 1 1/4 x 0.118	z 62	0.40	702	3.00 - 40	

BRIDGING

Maximum spacing between rows of bridging

@ Top Chord:	5342.36 ==>	1 Row(s) Minimum	Lateral Supports Deck (304.8)
@ Bottom Chord:	4436.18 ==>	3 Row(s) Minimum	Acc. to the code

POSITION	@ Top Chord	@ Bottom Chord
	3481	1200
		3481
		5762

v1.43.0

Fabrication code unless noted

-LL = 2 angles short legs back to back,	-BL = 2 angles welded in box,	-BR = Round bar
-U = 1 U profile,	-UU = 2 U profiles one inside the other,	-CL = Crimped angle

CONCENTRATED LOADS (* indicates that the conc. load is not directly on the panel point.)

Span: 1 = Main Joist, 2 = Left Extension, 3 = Right Extension

Hole: Top Chord with Holes at Conc. Loads

Definition of the categories (Cat.):

 1 = within a panel with no reinforcement
 4 = anywhere along the joist

Chord: 1 = Top, 2 = Bottom

Inclination (Incl.): 90 = Vertical, 0 = Horizontal

PARTIAL LOADS

Span: 1 = Main Joist, 2 = Left Extension, 3 = Right Extension

Chord: 1 = Top, 2 = Bottom

Load Category (Cat.): 1 = Dead, 2 = Live, 3 = Wind, 5 = Non-Composite Dead, 6 = Non-Composite Live 8 = Snow

Project no.:	U07664	Designer:	Emilie Pellerin	Shop:	Canam Group Inc. Toronto [Production]
260	/	269	Area to Paint	:	9.63 m2
					Material Sort : Cost


The Web-Fitting has Problems

This mark has been edited

Project: TURNBULL MUSIC ROOM ADDITION

JOIST CALCULATION ACCORDING TO S16-09, S136-07 & NBC 2010 (rev 2017)

Mark : M101 (Hybrid Mid-Span, Symmetrical,, Free ends) aligned on M100

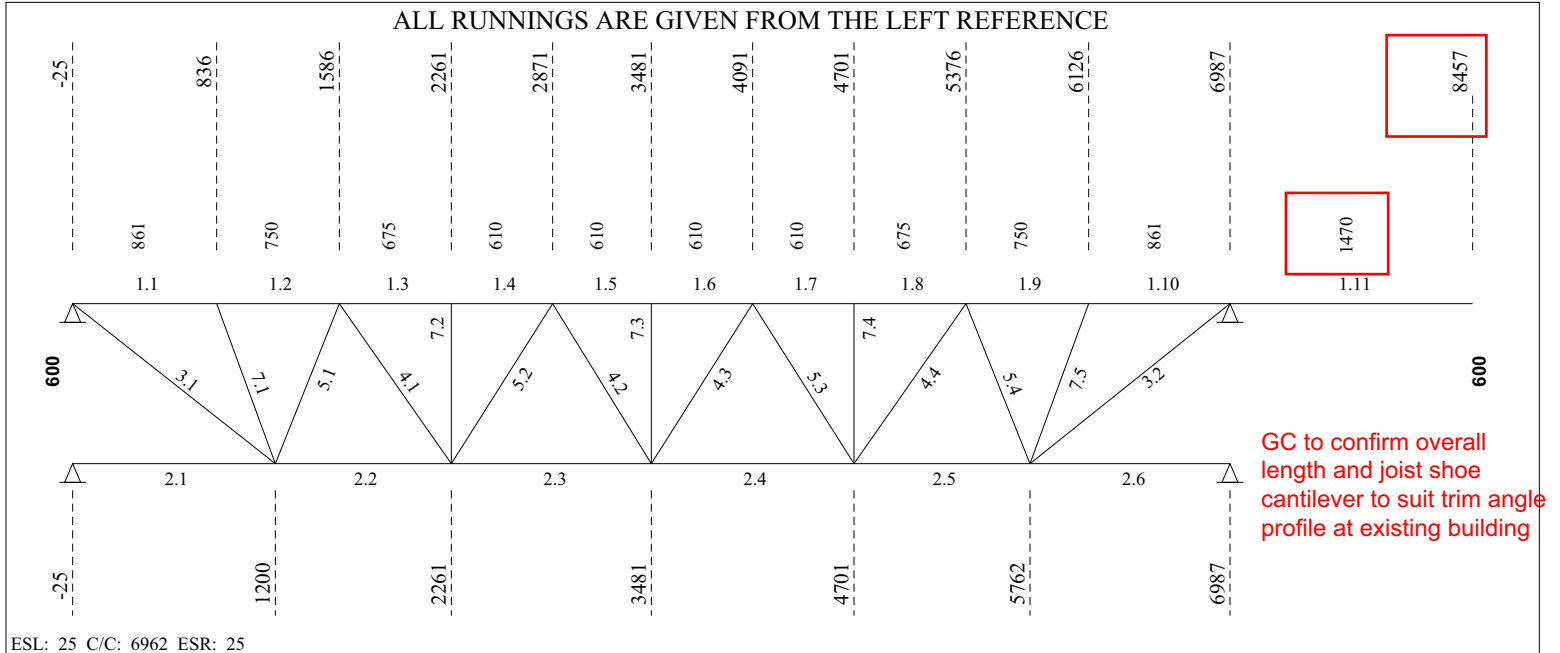
LOADING CONDITIONS

(THE SHOWN VALUES ARE UN-FACTORED)

(D) DEAD LOAD.....:	1.55 kN/m ² (1.51 kN/m)	SPACING....:	0.98 m
(L) LIVE LOAD.....:	0.00 kN/m ² (0.00 kN/m)	Companion load factor (live)....:	1.0
(S) SNOW LOAD.....:	3.50 kN/m ² (3.41 kN/m)		
(W) GROSS WIND UPLIFT:	1.37 kN/m ² (1.34 kN/m)		

EXTENSION

RIGHT: Length.. = 1470 mm				
Depth... = 200 mm				
Type.... = N[S]				
Mf..... = -19.210 kN-m (0.570)				
I..... = 9.37 x10 ⁶ mm ⁴				
Top Splice...: LL 5 x 5 x 1/2 x 3156 mm				
			LOADS [kN/m]	
			Dead (D)	Live (L)
			1.51	0.00
			Snow (S)	Wind (W)
			3.41	1.34
			END DEFLECTIONS [mm (L/xxx)]	
			Required	
			Calculated	
			L+0.9S	: 8.17 (L/180)
			Total	: 16.33 (L/90)
				4.46 (L/330)

CONCENTRATED LOADS (From Axis)

No	Sp	Hole	Dead Load [kN]	Live load [kN]	Snow Load [kN]	Gross Uplift [kN]	Position [mm]	Spacing [mm]	Cat. 0-9	Chord 1/2	Incl. [deg]
1	1	No	0.50	0.00	0.00	0.00	0				



2018-10-18

----- PARTIAL LOADS (From Axis) -----

No	Span	Left		Right		Start [mm]	Length [mm]	Chord Cat.	
		[kN/m ²]	[kN/m]	[kN/m ²]	[kN/m]				
1	1	0.00	0.00	5.91	5.76	0	6962	1	8
2	3	5.91	5.76	7.11	6.93	0	1470	1	8

----- END MOMENTS [kN-m] & AXIAL LOADS [kN] -----

	MOMENTS				AXIAL LOADS			
	--- <th colspan="2">---R---</th> <th colspan="2"><<< Top Chord >>></th> <th colspan="2"><< Bottom Chord >></th>		---R---		<<< Top Chord >>>		<< Bottom Chord >>	
	L	R	L	R	L	R	L	R
(W) Wind (case 1).....:	0.00	0.00	-5.20	5.20	0.00	0.00	0.00	0.00
(case 2).....:	0.00	0.00	5.20	-5.20	0.00	0.00	0.00	0.00
(L) Live Load.....:	0.00	0.00	0.00	0.00	0.00	0.00	0.00	0.00
(S) Snow Load.....:	0.00	0.00	0.00	0.00	0.00	0.00	0.00	0.00
(D) Dead Load.....:	0.00	0.00	0.00	0.00	0.00	0.00	0.00	0.00
(E) Seism (case 1).....:	0.00	0.00	-7.20	7.20	0.00	0.00	0.00	0.00
(case 2).....:	0.00	0.00	7.20	-7.20	0.00	0.00	0.00	0.00

Axial Force Transf.By.: at left: Weld Plate at right: Seat
 Reinforcement Type....: at left: C at right: 7 [0]
 Bearing Depth [mm]: at left: 100 at right: 200
 Splice [Yes/No].....: Yes Imposed Rows of Bridging Y/N...: No

----- (REAL) DEFLECTION -----

Allowed deflection under live and snow load..... = 19.20 mm (L/ 360)
 Calculated deflection under combined loads (L + 0.9S) = 7.84 mm (L/ 881)
 Gross joist inertia..... = 110.90 x10⁶ mm⁴
 Required camber..... = 14.02 mm
 Use of the joist (Ref. S16-09, art.16.5.1)..... = Roof

===== LOAD NO 2 (M101#02) =====

----- LOADING CONDITIONS -----

(THE SHOWN VALUES ARE UN-FACTORED)

(D) DEAD LOAD.....: 1.55 kN/m² (1.51 kN/m) SPACING...: 0.98 m
 (L) LIVE LOAD.....: 0.00 kN/m² (0.00 kN/m) Companion load factor (live)...: 1.0
 (S) SNOW LOAD.....: 3.50 kN/m² (3.41 kN/m)
 (W) GROSS WIND UPLIFT: 1.37 kN/m² (1.34 kN/m)

----- EXTENSION -----

RIGHT:	Length.. = 1470 mm	-----LOADS [kN/m]-----			
	Depth... = 200 mm	Dead (D)	Live (L)	Snow (S)	Wind (W)
	Type.... = N[S]	1.51	0.00	3.41	1.34
	Mf..... = -19.210 kN-m	-----END DEFLECTIONS [mm (L/xxx)]-----			
		Required		Calculated	
		L+0.9S	: 8.17 (L/180)	4.72 (L/311)	
		Total	: 16.33 (L/90)	4.46 (L/330)	

----- CONCENTRATED LOADS (From Axis) -----

No	Sp	Hole	Dead Load [kN]	Live load [kN]	Snow Load [kN]	Gross Uplift [kN]	Position [mm]	Spacing [mm]	Cat.	Chord	Incl. [deg]
1	1	No	0.50	0.00	0.00	0.00	0	0	4	2	90

----- PARTIAL LOADS (From Axis) -----

No	Span	Left		Right		Start [mm]	Length [mm]	Chord Cat.	
		[kN/m ²]	[kN/m]	[kN/m ²]	[kN/m]				
1	1	0.00	0.00	5.91	5.76	0	6962	1	8
2	3	5.91	5.76	7.11	6.93	0	1470	1	8

----- END MOMENTS [kN-m] & AXIAL LOADS [kN] -----

	MOMENTS				AXIAL LOADS			
	---L---		---R---		<<< Top Chord >>>		<< Bottom Chord >>	
					---L---	---R---	---L---	---R---
(W) Wind (case 1).....:	0.00	0.00	-5.20	5.20	0.00	0.00	0.00	0.00
(W) Wind (case 2).....:	0.00	0.00	5.20	-5.20	0.00	0.00	0.00	0.00
(L) Live Load.....:	0.00	0.00	0.00	0.00	0.00	0.00	0.00	0.00
(S) Snow Load.....:	0.00	0.00	0.00	0.00	0.00	0.00	0.00	0.00
(D) Dead Load.....:	0.00	0.00	0.00	0.00	0.00	0.00	0.00	0.00
(E) Seism (case 1).....:	0.00	0.00	-7.20	7.20	0.00	0.00	0.00	0.00
(E) Seism (case 2).....:	0.00	0.00	7.20	-7.20	0.00	0.00	0.00	0.00

Axial Force Transf.By.: at left: Weld Plate at right: Seat
 Reinforcement Type....: at left: C at right: 7 [0]
 Bearing Depth [mm]: at left: 100 at right: 200
 Splice [Yes/No].....: Yes Imposed Rows of Bridging Y/N...: No

----- (REAL) DEFLECTION -----

Allowed deflection under live and snow load..... = 19.20 mm (L/ 360)
 Calculated deflection under combined loads (L + 0.9S) = 7.84 mm (L/ 881)
 Use of the joist (Ref. S16-09, art.16.5.1)..... = Roof

===== End of multiple loads =====

----- F O R C E S I N M E M B E R S [kN] -----

(THE SHOWN FORCES ARE FACTORED)

Gap.....: 25.4 / 34.925 (Fy = 380 MPa U/N) (Eff. depth = 574.27 mm)

Left Reaction = 34.07/ -1.77 kN Right Reaction = 71.95/ -2.59 kN

REQUIRED MATERIAL

REQUIRED WELD

No	Tension	Compres.	x = tied at mid-length	Slend. Util.	Length	Weld-Ea.Side	Remarks
Top Chord							
1.1	10.79	-62.22	LL 2 x 2 x 1/4	z 73 0.36	861		
1.2	10.54	-58.19	do	z 68 0.37	750		
1.3	12.26	-94.88	do	z 61 0.37	675		
1.4	12.26	-94.88	do	z 55 0.40	610		
1.5	12.93	-111.49	do	z 55 0.41	do		
1.6	12.93	-111.49	do	z 55 0.45	do		
1.7	12.27	-97.96	do	z 55 0.45	610		
1.8	12.27	-97.96	LL 2 x 2 x 1/4	z 61 0.94	675		
1.9	10.98	-58.31	LL 5 x 5 x 1/2	z 27 0.13	750		
1.10	15.90	-53.76	do	z 29 0.57	861		
1.11	0.00	0.00	LL 5 x 5 x 1/2	z 59 0.57	1470		
Bottom Chord							
2.1	0.00	0.00	LL 1 1/2 x 1 1/2 x 1/8	z 156 0.61	1225		
2.2	74.31	-3.72	do	z 127 0.79	1061		
2.3	106.69	-5.15	do	z 146 0.82	1220		
2.4	108.98	-5.16	do	z 146 0.82	1220		
2.5	78.05	-3.73	do	z 127 0.83	1061		
2.6	0.00	0.00	LL 1 1/2 x 1 1/2 x 1/8	z 156 0.66	1225		

F O R C E S I N M E M B E R S (Cont.) [kN]

No	Tension	Compres.	REQUIRED MATERIAL			REQUIRED WELD		Remarks
			x = tied at mid-length	Slend.	Util.	Length	Weld-Ea.Side	
End Diagonal								
3.1	66.87	-3.43	SB 1 (50W)	z 180	0.34	1319	6.35 - 38	
3.2	58.82	-17.20	SB 1 (50W)	z 180	0.52	1319	6.35 - 38	
Diagonal Towards End								
4.1	27.84	-1.41	U 1 x 7/8 x 0.091	z 123	0.60	903	2.30 - 40	
4.2	10.74	-3.82	do	z 116	0.27	856	2.30 - 38	
4.3	10.86	-3.64	do	z 116	0.26	856	2.30 - 38	
4.4	28.02	-1.41	U 1 x 7/8 x 0.091	z 123	0.60	903	2.30 - 40	
Diagonal Towards Center								
5.1	1.51	-28.97	d U 1 3/8 x 0.136	z 59	0.56	713	3.45 - 38	
5.2	0.96	-18.52	U 1 x 1 1/8 x 0.118	z 88	0.68	856	3.00 - 38	
5.3	1.10	-21.05	U 1 x 1 1/8 x 0.118	z 88	0.78	856	3.00 - 38	
5.4	1.91	-45.47	d U 1 3/8 x 0.136	z 59	0.87	713	3.45 - 43	
Secondary Web Member								
7.1	0.47	-9.36	U 1 x 7/8 x 0.091	z 96	0.47	702	2.30 - 25	
7.2	0.33	-8.90	do	z 82	0.36	600	do	
7.3	0.31	-9.74	do	z 82	0.40	do	do	
7.4	0.33	-9.13	U 1 x 7/8 x 0.091	z 82	0.37	600	2.30 - 25	
7.5	37.73	-5.26	i U 1 3/8 x 1 1/4 x 0.118	z 62	0.41	702	3.00 - 41	

BRIDGING

Maximum spacing between rows of bridging

@ Top Chord:	5342.92 ==>	1 Row(s) Minimum	Lateral Supports Deck (304.8)
@ Bottom Chord:	4400.87 ==>	3 Row(s) Minimum	Acc. to the code

POSITION	@ Top Chord	@ Bottom Chord
	3481	1200
		3481
		5762

v1.43.0

Fabrication code unless noted

-LL = 2 angles short legs back to back,	-BL = 2 angles welded in box,	-BR = Round bar
-U = 1 U profile,	-UU = 2 U profiles one inside the other,	-CL = Crimped angle

CONCENTRATED LOADS (* indicates that the conc. load is not directly on the panel point.)

Span: 1 = Main Joist, 2 = Left Extension, 3 = Right Extension

Hole: Top Chord with Holes at Conc. Loads

Definition of the categories (Cat.):

4 = anywhere along the joist

Chord: 1 = Top, 2 = Bottom

Inclination (Incl.): 90 = Vertical, 0 = Horizontal

PARTIAL LOADS

Span: 1 = Main Joist, 2 = Left Extension, 3 = Right Extension

Chord: 1 = Top, 2 = Bottom

Load Category (Cat.): 1 = Dead, 2 = Live, 3 = Wind, 5 = Non-Composite Dead, 6 = Non-Composite Live 8 = Snow

Project no.:	U07664	Designer:	Emilie Pellerin	Shop:	Canam Group Inc. Toronto [Production]
252	/	260	Area to Paint	:	9.33 m2
					Material Sort : Cost


The Web-Fitting has Problems

This mark has been edited

Project: TURNBULL MUSIC ROOM ADDITION

JOIST CALCULATION ACCORDING TO S16-09, S136-07 & NBC 2010 (rev 2017)

Mark : M102 (Hybrid Mid-Span, Symmetrical,, Free ends) aligned on M100

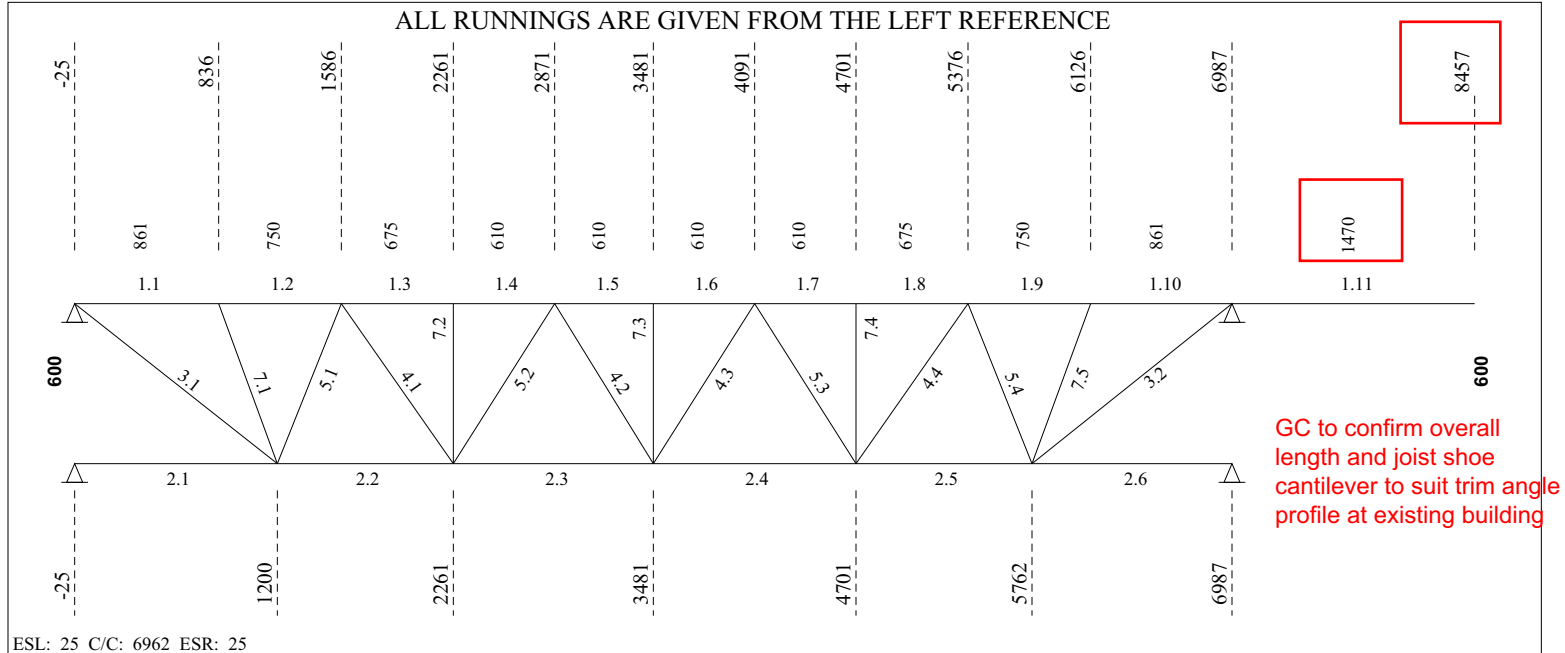
LOADING CONDITIONS

(THE SHOWN VALUES ARE UN-FACTORED)

(D) DEAD LOAD.....:	1.55 kN/m ² (1.51 kN/m)	SPACING....:	0.98 m
(L) LIVE LOAD.....:	0.00 kN/m ² (0.00 kN/m)	Companion load factor (live)....:	1.0
(S) SNOW LOAD.....:	3.50 kN/m ² (3.41 kN/m)		
(W) GROSS WIND UPLIFT:	1.37 kN/m ² (1.34 kN/m)		

EXTENSION

RIGHT: Length.. = 1470 mm	-----LOADS [kN/m]-----			
Depth... = 200 mm	Dead (D)	Live (L)	Snow (S)	Wind (W)
Type.... = N[S]	1.51	0.00	3.41	1.34
Mf..... = -19.543 kN-m (0.597)	-----END DEFLECTIONS [mm (L/xxx)]-----			
I..... = 9.37 x10 ⁶ mm ⁴	Required		Calculated	
Top Splice...: LL 5 x 5 x 1/2 x 3156 mm	L+0.9S	: 8.17 (L/180)	4.93 (L/298)	
	Total	: 16.33 (L/90)	1.92 (L/766)	

CONCENTRATED LOADS (From Axis)

No	Sp	Hole	Dead Load [kN]	Live load [kN]	Snow Load [kN]	Gross Uplift [kN]	Position [mm]	Spacing [mm]	Cat. 0-9	Chord 1/2	Incl. [deg]
1	1	No	0.50	0.00	0.00	0.00	0				
2	1	No	2.00	0.00	0.00	0.00	0				



2018-10-18

-----CONCENTRATED LOADS (From Axis) (Cont.)-----

No	Sp	Hole	Dead Load [kN]	Live load [kN]	Snow Load [kN]	Gross Uplift [kN]	Position [mm]	Spacing [mm]	Cat. 0-9	Chord 1/2	Incl. [deg]
3	1	No	2.00	0.00	0.00	0.00	0	0	4	1	90

----- PARTIAL LOADS (From Axis) -----

No	Span	Left		Right		Start [mm]	Length [mm]	Chord	Cat.
		[kN/m ²]	[kN/m]	[kN/m ²]	[kN/m]				
1	1	5.60	5.46	5.60	5.46	4085	2465	1	1
2	1	0.00	0.00	5.91	5.76	0	6962	1	8
3	3	5.91	5.76	7.11	6.93	0	1470	1	8

----- END MOMENTS [kN-m] & AXIAL LOADS [kN] -----

	MOMENTS				AXIAL LOADS			
	---L---		---R---		<<< Top Chord >>>		<< Bottom Chord >>	
	---	---	---	---	---	---	---	---
(W) Wind (case 1).....:	0.00	0.00	-6.50	6.50	0.00	0.00	0.00	0.00
(case 2).....:	0.00	0.00	6.50	-6.50	0.00	0.00	0.00	0.00
(L) Live Load.....:	0.00	0.00	0.00	0.00	0.00	0.00	0.00	0.00
(S) Snow Load.....:	0.00	0.00	0.00	0.00	0.00	0.00	0.00	0.00
(D) Dead Load.....:	0.00	0.00	0.00	0.00	0.00	0.00	0.00	0.00
(E) Seism (case 1).....:	0.00	0.00	-9.00	9.00	0.00	0.00	0.00	0.00
(case 2).....:	0.00	0.00	9.00	-9.00	0.00	0.00	0.00	0.00

Axial Force Transf.By.: at left: Weld Plate at right: Seat
 Reinforcement Type....: at left: C at right: 7 [0]
 Bearing Depth [mm]: at left: 100 at right: 200
 Splice [Yes/No].....: Yes Imposed Rows of Bridging Y/N...: No

----- (REAL) DEFLECTION -----

Allowed deflection under live and snow load..... = 19.20 mm (L/ 360)
 Calculated deflection under combined loads (L + 0.9S) = 6.74 mm (L/ 1026)
 Gross joist inertia..... = 130.96 x10⁶ mm⁴
 Required camber..... = 14.02 mm
 Use of the joist (Ref. S16-09, art.16.5.1)..... = Roof

===== LOAD NO 2 (M102#02) =====

----- LOADING CONDITIONS -----

(THE SHOWN VALUES ARE UN-FACTORED)

(D) DEAD LOAD.....:	1.55 kN/m ² (1.51 kN/m)	SPACING...:	0.98 m
(L) LIVE LOAD.....:	0.00 kN/m ² (0.00 kN/m)	Companion load factor (live)....:	1.0
(S) SNOW LOAD.....:	3.50 kN/m ² (3.41 kN/m)		
(W) GROSS WIND UPLIFT:	1.37 kN/m ² (1.34 kN/m)		

----- EXTENSION -----

RIGHT:	Length.. = 1470 mm	-----LOADS [kN/m]-----			
	Depth... = 200 mm	Dead (D)	Live (L)	Snow (S)	Wind (W)
	Type.... = N[S]	1.51	0.00	3.41	1.34
	Mf..... = -19.543 kN-m	-----END DEFLECTIONS [mm (L/xxx)]-----			
		Required		Calculated	
		L+0.9S	: 8.17 (L/180)	4.93 (L/298)	
		Total	: 16.33 (L/90)	1.92 (L/766)	

----- CONCENTRATED LOADS (From Axis) -----

No	Sp	Hole	Dead Load [kN]	Live load [kN]	Snow Load [kN]	Gross Uplift [kN]	Position [mm]	Spacing [mm]	Cat. 0-9	Chord 1/2	Incl. [deg]
1	1	No	0.50	0.00	0.00	0.00	0	0	4	2	90

-----CONCENTRATED LOADS (From Axis) (Cont.)-----

No	Sp	Hole	Dead Load [kN]	Live load [kN]	Snow Load [kN]	Gross Uplift [kN]	Position [mm]	Spacing [mm]	Cat. 0-9	Chord 1/2	Incl. [deg]
2	1	No	2.00	0.00	0.00	0.00	0	0	4	1	90
3	1	No	2.00	0.00	0.00	0.00	0	0	4	1	90

----- PARTIAL LOADS (From Axis) -----

No	Span	Left [kN/m ²]	Left [kN/m]	Right [kN/m ²]	Right [kN/m]	Start [mm]	Length [mm]	Chord	Cat.
1	1	5.60	5.46	5.60	5.46	4085	2465	1	1
2	1	0.00	0.00	5.91	5.76	0	6962	1	8
3	3	5.91	5.76	7.11	6.93	0	1470	1	8

----- END MOMENTS [kN-m] & AXIAL LOADS [kN] -----

	MOMENTS		AXIAL LOADS			
	---L---	---R---	<<< Top ---L---	Chord >>> ---R---	<< Bottom ---L---	Chord >>> ---R---
(W) Wind (case 1).....:	0.00	0.00	-6.50	6.50	0.00	0.00
(W) Wind (case 2).....:	0.00	0.00	6.50	-6.50	0.00	0.00
(L) Live Load.....:	0.00	0.00	0.00	0.00	0.00	0.00
(S) Snow Load.....:	0.00	0.00	0.00	0.00	0.00	0.00
(D) Dead Load.....:	0.00	0.00	0.00	0.00	0.00	0.00
(E) Seism (case 1).....:	0.00	0.00	-9.00	9.00	0.00	0.00
(E) Seism (case 2).....:	0.00	0.00	9.00	-9.00	0.00	0.00

Axial Force Transf.By.: at left: Weld Plate at right: Seat
 Reinforcement Type....: at left: C at right: 7 [0]
 Bearing Depth [mm]: at left: 100 at right: 200
 Splice [Yes/No].....: Yes Imposed Rows of Bridging Y/N...: No

----- (REAL) DEFLECTION -----

Allowed deflection under live and snow load..... = 19.20 mm (L/ 360)
 Calculated deflection under combined loads (L + 0.9S) = 6.74 mm (L/ 1026)
 Use of the joist (Ref. S16-09, art.16.5.1)..... = Roof

===== End of multiple loads =====

----- F O R C E S I N M E M B E R S [kN] -----

(THE SHOWN FORCES ARE FACTORED)

Gap.....: 25.4 / 34.925 (Fy = 380 MPa U/N) (Eff. depth = 569.50 mm)
 Left Reaction = 43.01/ 0.00 kN Right Reaction = 89.83/ 0.00 kN

REQUIRED MATERIAL

REQUIRED WELD

No	Tension	Compres.	x = tied at mid-length	Slend. Util.	Length	Weld-Ea.Side	Remarks
Top Chord							
1.1	6.95	-79.98	LL 2 1/2 x 2 1/2 x 1/4	z 58 0.32	861		
1.2	6.69	-74.80	do	z 54 0.36	750		
1.3	3.14	-124.44	do	z 49 0.36	675		
1.4	3.14	-124.44	do	z 44 0.39	610		
1.5	0.00	-151.51	do	z 44 0.39	do		
1.6	0.00	-151.51	do	z 44 0.45	do		
1.7	0.00	-142.15	do	z 44 0.47	610		
1.8	0.00	-142.15	LL 2 1/2 x 2 1/2 x 1/4	z 49 0.81	675		
1.9	0.00	-90.04	LL 5 x 5 x 1/2	z 27 0.14	750		
1.10	0.00	-89.73	do	z 29 0.60	861		
1.11	0.00	0.00	LL 5 x 5 x 1/2	z 59 0.60	1470		

FORCES IN MEMBERS (Cont.) [kN]

No	Tension	Compres.	REQUIRED MATERIAL			REQUIRED WELD		Remarks
			x = tied at mid-length	Slend.	Util.	Length	Weld-Ea.Side	
Bottom Chord								
2.1	0.00	0.00	LL 1 3/4 x 1 3/4 x 1/8	z 133	0.66	1225		
2.2	96.34	0.00	do	z 120	0.88	1061		
2.3	141.98	0.00	do	z 138	0.93	1220		
2.4	152.74	0.00	do	z 138	0.94	1220		
2.5	120.21	0.00	do	z 120	0.97	1061		
2.6	0.00	0.00	LL 1 3/4 x 1 3/4 x 1/8	z 133	0.79	1225		
End Diagonal								
3.1	85.24	0.00	SB 1 (50W)	z 180	0.43	1319	6.35 - 44	
3.2	96.09	-4.67	SB 1 (50W)	z 180	0.48	1319	6.35 - 49	
Diagonal Towards End								
4.1	38.86	0.00	U 1 x 7/8 x 0.091	z 137	0.83	903	2.30 - 55	
4.2	19.93	-2.71	do	z 116	0.43	856	2.30 - 38	
4.3	10.25	-11.97	do	z 116	0.85	856	2.30 - 38	
4.4	36.97	-0.33	U 1 x 7/8 x 0.091	z 123	0.79	903	2.30 - 53	
Diagonal Towards Center								
5.1	0.00	-38.26	d U 1 3/8 x 0.157	z 57	0.59	713	4.00 - 38	
5.2	0.00	-28.33	U 1 x 1 1/4 x 0.136	z 88	0.86	856	3.45 - 38	
5.3	5.31	-22.84	U 1 x 1 1/4 x 0.136	z 88	0.70	856	3.45 - 38	
5.4	0.00	-58.91	d U 1 3/8 x 0.157	z 57	0.91	713	4.00 - 48	
Secondary Web Member								
7.1	0.47	-15.57	U 1 x 7/8 x 0.091	z 96	0.77	702	2.30 - 25	
7.2	0.33	-14.50	do	z 82	0.59	600	do	
7.3	0.31	-15.55	do	z 82	0.64	do	2.30 - 25	
7.4	0.00	-19.42	U 1 x 7/8 x 0.091	z 82	0.79	600	2.30 - 28	
7.5	34.26	-17.71	i U 1 3/8 x 1 1/4 x 0.118	z 62	0.37	702	3.00 - 38	

BRIDGING

Maximum spacing between rows of bridging

@ Top Chord:	6164.09 ==>	1 Row(s) Minimum	Lateral Supports
@ Bottom Chord:	6791.19 ==>	3 Row(s) Minimum	Deck (304.8)
			Acc. to the code

POSITION	@ Top Chord	@ Bottom Chord
	3481	1200
		3481
		5762

v1.43.0

Fabrication code unless noted

-LL = 2 angles short legs back to back,	-BL = 2 angles welded in box,	-BR = Round bar
-U = 1 U profile,	-UU = 2 U profiles one inside the other,	-CL = Crimped angle

CONCENTRATED LOADS (* indicates that the conc. load is not directly on the panel point.)

Span: 1 = Main Joist, 2 = Left Extension, 3 = Right Extension

Hole: Top Chord with Holes at Conc. Loads

Definition of the categories (Cat.):

4 = anywhere along the joist

Chord: 1 = Top, 2 = Bottom

Inclination (Incl.): 90 = Vertical, 0 = Horizontal

PARTIAL LOADS

Span: 1 = Main Joist, 2 = Left Extension, 3 = Right Extension

Chord: 1 = Top, 2 = Bottom

Load Category (Cat.): 1 = Dead, 2 = Live, 3 = Wind, 5 = Non-Composite Dead, 6 = Non-Composite Live 8 = Snow

Project no.: U07664 Designer: Emilie Pellerin Shop: Canam Group Inc. Toronto [Production]
272 / 281 Area to Paint : 10.25 m2 Material Sort : Cost


The Web-Fitting has Problems

This mark has been edited

Project: TURNBULL MUSIC ROOM ADDITION

JOIST CALCULATION ACCORDING TO S16-09, S136-07 & NBC 2010 (rev 2017)

Mark : M103 (Hybrid Mid-Span, Symmetrical,, Free ends) aligned on M100

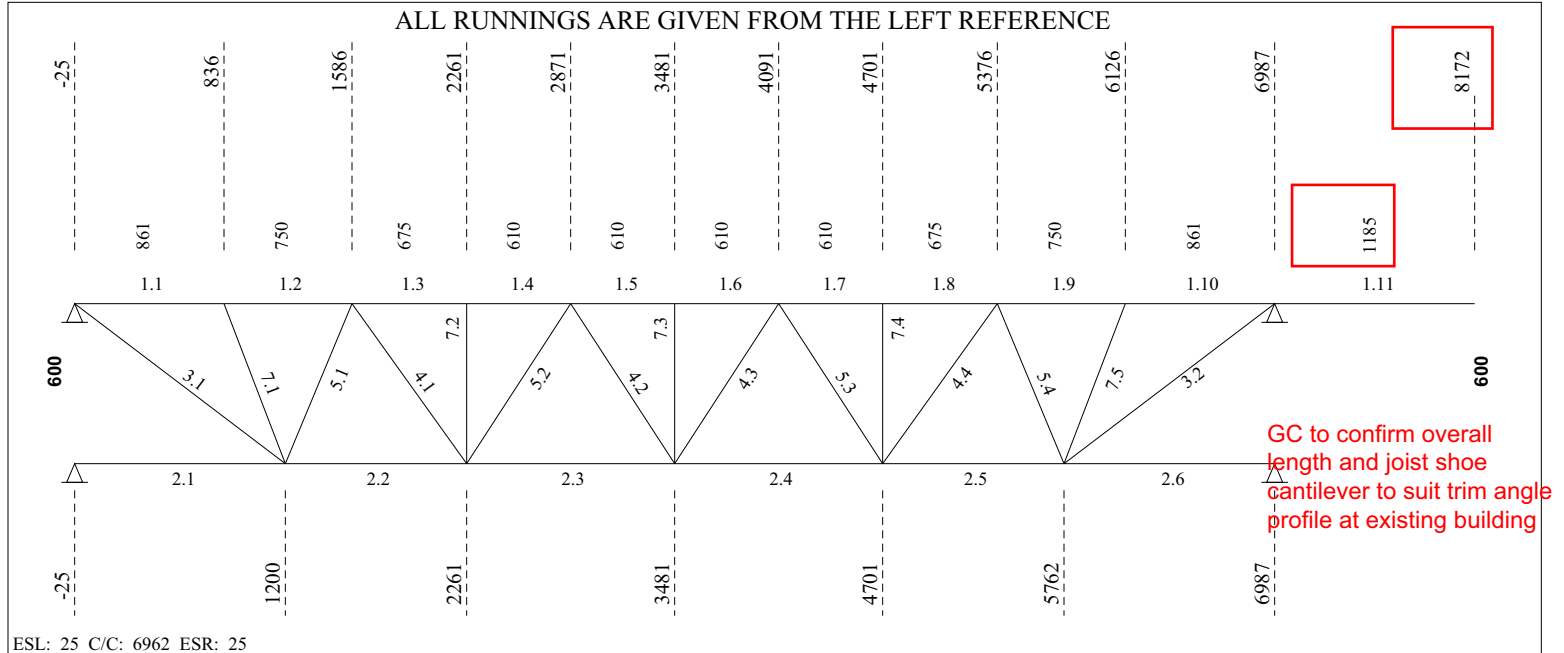
LOADING CONDITIONS

(THE SHOWN VALUES ARE UN-FACTORED)

(D) DEAD LOAD.....:	1.45 kN/m ² (1.41 kN/m)	SPACING....:	0.98 m
(L) LIVE LOAD.....:	0.00 kN/m ² (0.00 kN/m)	Companion load factor (live)....:	1.0
(S) SNOW LOAD.....:	3.50 kN/m ² (3.41 kN/m)		
(W) GROSS WIND UPLIFT:	1.37 kN/m ² (1.34 kN/m)		

EXTENSION

RIGHT: Length.. = 1185 mm	-----LOADS [kN/m]-----
Depth... = 200 mm	Dead (D) Live (L) Snow (S) Wind (W)
Type.... = N[S]	1.41 0.00 3.41 1.34
Mf..... = -12.894 kN-m (0.900)	-----END DEFLECTIONS [mm (L/xxx)]-----
I..... = 3.63 x10 ⁶ mm ⁴	Required Calculated
Top Splice...: LL 4 x 4 x 3/8 x 2121 mm	L+0.9S : 6.58 (L/180) 5.27 (L/225)
	Total : 13.17 (L/90) 2.72 (L/435)

CONCENTRATED LOADS (From Axis)

No	Sp	Hole	Dead Load [kN]	Live load [kN]	Snow Load [kN]	Gross Uplift [kN]	Position [mm]	Spacing [mm]	Cat. 0-9	Chord 1/2	Incl. [deg]
1	1	No	0.50	0.00	0.00	0.00	0				
2	1	No	2.00	0.00	0.00	0.00	0				



2018-10-18

-----CONCENTRATED LOADS (From Axis) (Cont.)-----

No	Sp	Hole	Dead Load [kN]	Live load [kN]	Snow Load [kN]	Gross Uplift [kN]	Position [mm]	Spacing [mm]	Cat. 0-9	Chord 1/2	Incl. [deg]
3	1	No	2.00	0.00	0.00	0.00	0	0	4	1	90

----- PARTIAL LOADS (From Axis) -----

No	Span	Left		Right		Start [mm]	Length [mm]	Chord	Cat.
		[kN/m ²]	[kN/m]	[kN/m ²]	[kN/m]				
1	1	5.60	5.46	5.60	5.46	4085	2465	1	1
2	1	0.00	0.00	5.91	5.76	0	6962	1	8
3	3	5.90	5.75	6.90	6.73	0	1185	1	8

----- END MOMENTS [kN-m] & AXIAL LOADS [kN] -----

	MOMENTS				AXIAL LOADS			
	---L---		---R---		<<< Top Chord >>>		<< Bottom Chord >>	
	---	---	---	---	---	---	---	---
(W) Wind (case 1).....:	0.00	0.00	-6.00	6.00	0.00	0.00	0.00	0.00
(case 2).....:	0.00	0.00	6.00	-6.00	0.00	0.00	0.00	0.00
(L) Live Load.....:	0.00	0.00	0.00	0.00	0.00	0.00	0.00	0.00
(S) Snow Load.....:	0.00	0.00	0.00	0.00	0.00	0.00	0.00	0.00
(D) Dead Load.....:	0.00	0.00	0.00	0.00	0.00	0.00	0.00	0.00
(E) Seism (case 1).....:	0.00	0.00	-8.40	8.40	0.00	0.00	0.00	0.00
(case 2).....:	0.00	0.00	8.40	-8.40	0.00	0.00	0.00	0.00

Axial Force Transf.By.: at left: Weld Plate at right: Seat
 Reinforcement Type....: at left: C at right: 7 [0]
 Bearing Depth [mm]: at left: 100 at right: 200
 Splice [Yes/No].....: Yes Imposed Rows of Bridging Y/N...: No

----- (REAL) DEFLECTION -----

Allowed deflection under live and snow load..... = 19.20 mm (L/ 360)
 Calculated deflection under combined loads (L + 0.9S) = 7.24 mm (L/ 955)
 Gross joist inertia..... = 128.25 x10⁶ mm⁴
 Required camber..... = 14.02 mm
 Use of the joist (Ref. S16-09, art.16.5.1)..... = Roof

===== LOAD NO 2 (M103#02) =====

----- LOADING CONDITIONS -----

(THE SHOWN VALUES ARE UN-FACTORED)

(D) DEAD LOAD.....:	1.45 kN/m ² (1.41 kN/m)	SPACING...:	0.98 m
(L) LIVE LOAD.....:	0.00 kN/m ² (0.00 kN/m)	Companion load factor (live)....:	1.0
(S) SNOW LOAD.....:	3.50 kN/m ² (3.41 kN/m)		
(W) GROSS WIND UPLIFT:	1.37 kN/m ² (1.34 kN/m)		

----- EXTENSION -----

RIGHT:	Length.. = 1185 mm	-----LOADS [kN/m]-----			
	Depth... = 200 mm	Dead (D)	Live (L)	Snow (S)	Wind (W)
	Type.... = N[S]	1.41	0.00	3.41	1.34
	Mf..... = -12.894 kN-m	-----END DEFLECTIONS [mm (L/xxx)]-----			
		Required		Calculated	
		L+0.9S	: 6.58 (L/180)	5.27 (L/225)	
		Total	: 13.17 (L/90)	2.72 (L/435)	

----- CONCENTRATED LOADS (From Axis) -----

No	Sp	Hole	Dead Load [kN]	Live load [kN]	Snow Load [kN]	Gross Uplift [kN]	Position [mm]	Spacing [mm]	Cat. 0-9	Chord 1/2	Incl. [deg]
1	1	No	0.50	0.00	0.00	0.00	0	0	4	2	90

-----CONCENTRATED LOADS (From Axis) (Cont.)-----

No	Sp	Hole	Dead Load [kN]	Live load [kN]	Snow Load [kN]	Gross Uplift [kN]	Position [mm]	Spacing [mm]	Cat. 0-9	Chord 1/2	Incl. [deg]
2	1	No	2.00	0.00	0.00	0.00	0	0	4	1	90
3	1	No	2.00	0.00	0.00	0.00	0	0	4	1	90

----- PARTIAL LOADS (From Axis) -----

No	Span	Left [kN/m2]	Left [kN/m]	Right [kN/m2]	Right [kN/m]	Start [mm]	Length [mm]	Chord	Cat.
1	1	5.60	5.46	5.60	5.46	4085	2465	1	1
2	1	0.00	0.00	5.91	5.76	0	6962	1	8
3	3	5.90	5.75	6.90	6.73	0	1185	1	8

----- END MOMENTS [kN-m] & AXIAL LOADS [kN] -----

	MOMENTS		AXIAL LOADS			
	---L---	---R---	<<< Top ---L---	Chord >>> ---R---	<< Bottom ---L---	Chord >>> ---R---
(W) Wind (case 1).....:	0.00	0.00	-6.00	6.00	0.00	0.00
(W) Wind (case 2).....:	0.00	0.00	6.00	-6.00	0.00	0.00
(L) Live Load.....:	0.00	0.00	0.00	0.00	0.00	0.00
(S) Snow Load.....:	0.00	0.00	0.00	0.00	0.00	0.00
(D) Dead Load.....:	0.00	0.00	0.00	0.00	0.00	0.00
(E) Seism (case 1).....:	0.00	0.00	-8.40	8.40	0.00	0.00
(E) Seism (case 2).....:	0.00	0.00	8.40	-8.40	0.00	0.00

Axial Force Transf.By.: at left: Weld Plate at right: Seat
 Reinforcement Type....: at left: C at right: 7 [0]
 Bearing Depth [mm]: at left: 100 at right: 200
 Splice [Yes/No].....: Yes Imposed Rows of Bridging Y/N...: No

----- (REAL) DEFLECTION -----

Allowed deflection under live and snow load..... = 19.20 mm (L/ 360)
 Calculated deflection under combined loads (L + 0.9S) = 7.24 mm (L/ 955)
 Use of the joist (Ref. S16-09, art.16.5.1)..... = Roof

===== End of multiple loads =====

----- FORCES IN MEMBERS [kN] -----

(THE SHOWN FORCES ARE FACTORED)

Gap.....: 25.4 / 34.925 (Fy = 380 MPa U/N) (Eff. depth = 569.68 mm)
 Left Reaction = 43.09/ 0.00 kN Right Reaction = 83.43/ 0.00 kN

REQUIRED MATERIAL

REQUIRED WELD

No	Tension	Compres.	x = tied at mid-length	Slend. Util.	Length	Weld-Ea.Side	Remarks
Top Chord							
1.1	6.73	-80.21	LLV 2 1/2 x 2 1/2 x .230 (55)	z 58 0.39	861		
1.2	6.43	-75.09	do	z 54 0.43	750		
1.3	3.15	-125.23	do	z 49 0.43	675		
1.4	3.15	-125.23	do	z 44 0.48	610		
1.5	0.00	-153.21	do	z 44 0.48	do		
1.6	0.00	-153.21	do	z 44 0.54	do		
1.7	0.00	-145.20	do	z 44 0.57	610		
1.8	0.00	-145.20	do	z 49 0.84	675		
1.9	0.00	-91.52	LLV 2 1/2 x 2 1/2 x .230 (55)	z 54 0.84	750		
1.10	0.00	-97.26	LL 4 x 4 x 3/8	z 36 0.90	861		
1.11	0.00	0.00	LL 4 x 4 x 3/8	z 59 0.90	1185		

FORCES IN MEMBERS (Cont.) [kN]

No	Tension	Compres.	REQUIRED MATERIAL			REQUIRED WELD		Remarks
			x = tied at mid-length	Slend.	Util.	Length	Weld-Ea.Side	
Bottom Chord								
2.1	0.00	0.00	LL 1 3/4 x 1 3/4 x 1/8	z 133	0.66	1225		
2.2	96.78	0.00	do	z 120	0.89	1061		
2.3	143.18	0.00	do	z 138	0.94	1220		
2.4	154.96	0.00	do	z 138	0.95	1220		
2.5	119.62	0.00	do	z 120	0.95	1061		
2.6	0.00	0.00	LL 1 3/4 x 1 3/4 x 1/8	z 133	0.80	1225		
End Diagonal								
3.1	85.51	0.00	BR 15/16 (50W)	z 222	0.62	1319	5.00 - 40	
3.2	105.72	-4.31	SB 1 (50W)	z 180	0.53	1319	6.35 - 54	
Diagonal Towards End								
4.1	39.33	0.00	U 1 x 0.091	z 107	0.71	903	2.29 - 56	
4.2	20.60	-1.42	U 1 x 7/8 x 0.091	z 116	0.44	856	2.30 - 38	
4.3	8.98	-12.63	U 1 x 7/8 x 0.091	z 116	0.89	856	2.30 - 38	
4.4	36.71	-0.53	U 1 x 0.091	z 96	0.67	903	2.29 - 52	
Diagonal Towards Center								
5.1	0.00	-38.52	d U 1 3/8 x 0.157	z 57	0.60	713	4.00 - 38	
5.2	0.00	-28.88	U 1 x 1 1/4 x 0.136	z 88	0.88	856	3.45 - 38	
5.3	5.44	-20.96	U 1 x 1 1/4 x 0.136	z 88	0.64	856	3.45 - 38	
5.4	0.00	-53.94	d U 1 3/8 x 0.157	z 57	0.83	713	4.00 - 44	
Secondary Web Member								
7.1	0.55	-15.46	U 1 x 7/8 x 0.091	z 96	0.77	702	2.30 - 25	
7.2	0.38	-14.44	do	z 82	0.59	600	do	
7.3	0.36	-15.57	do	z 82	0.64	do	2.30 - 25	
7.4	0.00	-20.08	U 1 x 7/8 x 0.091	z 82	0.82	600	2.30 - 29	
7.5	18.50	-18.11	i U 1 3/8 x 1 1/4 x 0.118	z 62	0.37	702	3.00 - 38	

BRIDGING

Maximum spacing between rows of bridging

@ Top Chord:	6059.41 ==>	1 Row(s) Minimum
@ Bottom Chord:	6791.19 ==>	3 Row(s) Minimum

 Lateral Supports
 Deck (304.8)
 Acc. to the code

POSITION

@ Top Chord	@ Bottom Chord
3481	1200
	3481
	5762

v1.43.0

Fabrication code unless noted

-LL = 2 angles short legs back to back,	-BL = 2 angles welded in box,	-BR = Round bar
-U = 1 U profile,	-UU = 2 U profiles one inside the other,	-CL = Crimped angle

CONCENTRATED LOADS (* indicates that the conc. load is not directly on the panel point.)

Span: 1 = Main Joist, 2 = Left Extension, 3 = Right Extension

Hole: Top Chord with Holes at Conc. Loads

Definition of the categories (Cat.):

4 = anywhere along the joist

Chord: 1 = Top, 2 = Bottom

Inclination (Incl.): 90 = Vertical, 0 = Horizontal

PARTIAL LOADS

Span: 1 = Main Joist, 2 = Left Extension, 3 = Right Extension

Chord: 1 = Top, 2 = Bottom

Load Category (Cat.): 1 = Dead, 2 = Live, 3 = Wind, 5 = Non-Composite Dead, 6 = Non-Composite Live 8 = Snow

Project no.: U07664 Designer: Emilie Pellerin Shop: Canam Group Inc. Toronto [Production]
183 / 192 Area to Paint : 9.18 m2 Material Sort : Cost


The Web-Fitting has Problems

This mark has been edited

Project: TURNBULL MUSIC ROOM ADDITION

JOIST CALCULATION ACCORDING TO S16-09, S136-07 & NBC 2010 (rev 2017)

Mark : M104 (Hybrid Mid-Span, Symmetrical,, Free ends) aligned on M100

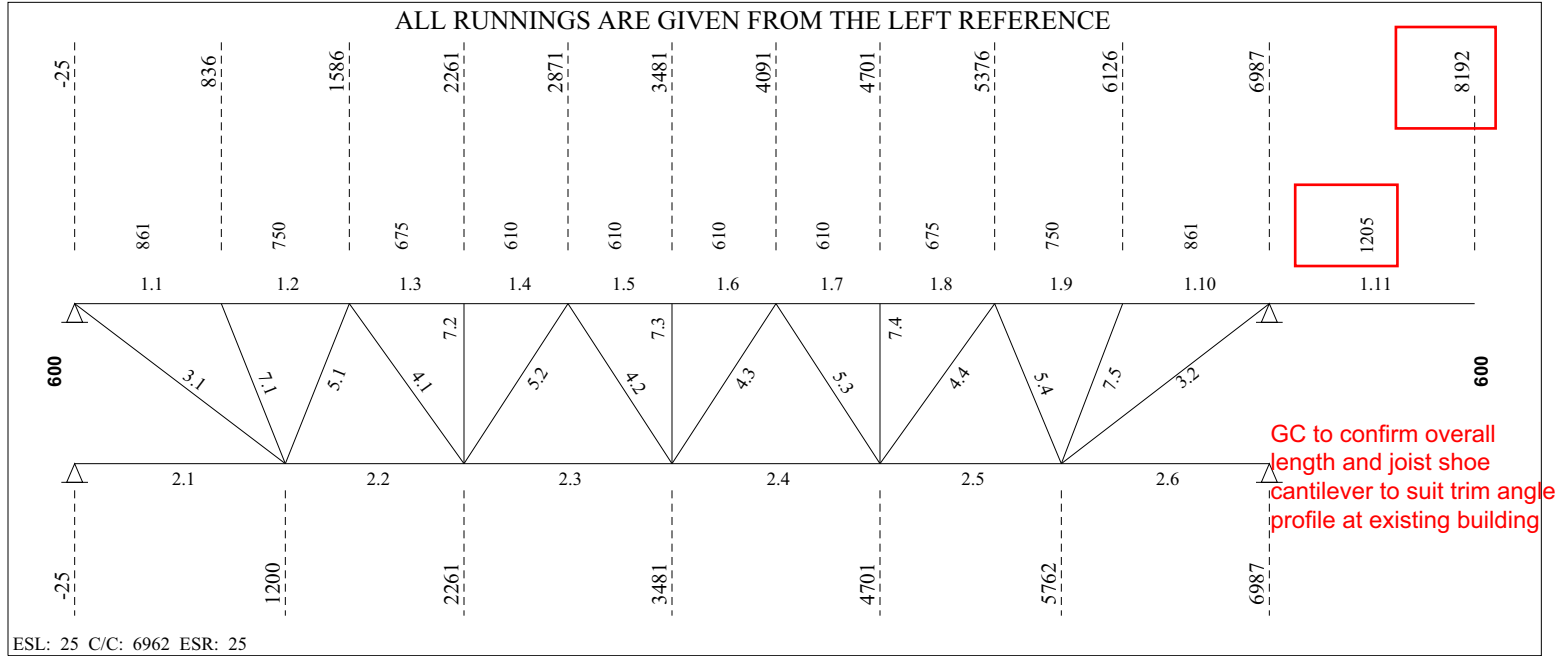

LOADING CONDITIONS

(THE SHOWN VALUES ARE UN-FACTORED)

(D) DEAD LOAD.....:	1.45 kN/m ² (1.38 kN/m)	SPACING....:	0.95 m
(L) LIVE LOAD.....:	0.00 kN/m ² (0.00 kN/m)	Companion load factor (live)....:	1.0
(S) SNOW LOAD.....:	3.50 kN/m ² (3.33 kN/m)		
(W) GROSS WIND UPLIFT:	1.37 kN/m ² (1.30 kN/m)		

EXTENSION

RIGHT: Length.. = 1205 mm	-----LOADS [kN/m]-----
Depth... = 200 mm	Dead (D) Live (L) Snow (S) Wind (W)
Type.... = N[S]	1.38 0.00 3.33 1.30
Mf..... = -12.547 kN-m (0.846)	-----END DEFLECTIONS [mm (L/xxx)]-----
I..... = 3.63 x10 ⁶ mm ⁴	Required Calculated
Top Splice...: LL 4 x 4 x 3/8 x 2141 mm	L+0.9S : 6.69 (L/180) 5.40 (L/223)
	Total : 13.39 (L/90) 5.43 (L/222)

CONCENTRATED LOADS (From Axis)

No	Sp	Hole	Dead Load [kN]	Live load [kN]	Snow Load [kN]	Gross Uplift [kN]	Position [mm]	Spacing [mm]	Cat. 0-9	Chord 1/2	Incl. [deg]
1	1	No	0.50	0.00	0.00	0.00	0				



2018-10-18

----- PARTIAL LOADS (From Axis) -----

No	Span	Left		Right		Start [mm]	Length [mm]	Chord Cat.	
		[kN/m ²]	[kN/m]	[kN/m ²]	[kN/m]				
1	1	0.00	0.00	5.91	5.61	0	6962	1	8
2	3	5.91	5.61	6.91	6.56	0	1205	1	8

----- END MOMENTS [kN-m] & AXIAL LOADS [kN] -----

	MOMENTS				AXIAL LOADS			
	--- <th colspan="2">---R---</th> <th colspan="2"><<< Top Chord >>></th> <th colspan="2"><< Bottom Chord >></th>		---R---		<<< Top Chord >>>		<< Bottom Chord >>	
	L	R	L	R	L	R	L	R
(W) Wind (case 1).....:	0.00	0.00	-4.30	4.30	0.00	0.00	0.00	0.00
(case 2).....:	0.00	0.00	4.30	-4.30	0.00	0.00	0.00	0.00
(L) Live Load.....:	0.00	0.00	0.00	0.00	0.00	0.00	0.00	0.00
(S) Snow Load.....:	0.00	0.00	0.00	0.00	0.00	0.00	0.00	0.00
(D) Dead Load.....:	0.00	0.00	0.00	0.00	0.00	0.00	0.00	0.00
(E) Seism (case 1).....:	0.00	0.00	-5.90	5.90	0.00	0.00	0.00	0.00
(case 2).....:	0.00	0.00	5.90	-5.90	0.00	0.00	0.00	0.00

Axial Force Transf.By.: at left: Weld Plate at right: Seat
 Reinforcement Type....: at left: C at right: 7 [0]
 Bearing Depth [mm]: at left: 100 at right: 200
 Splice [Yes/No].....: Yes Imposed Rows of Bridging Y/N...: No

----- (REAL) DEFLECTION -----

Allowed deflection under live and snow load..... = 19.20 mm (L/ 360)
 Calculated deflection under combined loads (L + 0.9S) = 8.08 mm (L/ 855)
 Gross joist inertia..... = 110.90 x10⁶ mm⁴
 Required camber..... = 14.02 mm
 Use of the joist (Ref. S16-09, art.16.5.1)..... = Roof

===== LOAD NO 2 (M104#02) =====

----- LOADING CONDITIONS -----

(THE SHOWN VALUES ARE UN-FACTORED)

(D) DEAD LOAD.....: 1.45 kN/m² (1.38 kN/m) SPACING...: 0.95 m
 (L) LIVE LOAD.....: 0.00 kN/m² (0.00 kN/m) Companion load factor (live)...: 1.0
 (S) SNOW LOAD.....: 3.50 kN/m² (3.33 kN/m)
 (W) GROSS WIND UPLIFT: 1.37 kN/m² (1.30 kN/m)

----- EXTENSION -----

RIGHT:	Length.. = 1205 mm	-----LOADS [kN/m]-----			
	Depth... = 200 mm	Dead (D)	Live (L)	Snow (S)	Wind (W)
	Type.... = N[S]	1.38	0.00	3.33	1.30
	Mf..... = -12.547 kN-m	-----END DEFLECTIONS [mm (L/xxx)]-----			
		Required		Calculated	
		L+0.9S	: 6.69 (L/180)	5.40 (L/223)	
		Total	: 13.39 (L/90)	5.43 (L/222)	

----- CONCENTRATED LOADS (From Axis) -----

No	Sp	Hole	Dead Load [kN]	Live load [kN]	Snow Load [kN]	Gross Uplift [kN]	Position [mm]	Spacing [mm]	Cat.	Chord	Incl. [deg]
1	1	No	0.50	0.00	0.00	0.00	0	0	4	2	90

----- PARTIAL LOADS (From Axis) -----

No	Span	Left		Right		Start [mm]	Length [mm]	Chord Cat.	
		[kN/m ²]	[kN/m]	[kN/m ²]	[kN/m]				
1	1	0.00	0.00	5.91	5.61	0	6962	1	8
2	3	5.91	5.61	6.91	6.56	0	1205	1	8

----- END MOMENTS [kN-m] & AXIAL LOADS [kN] -----

	MOMENTS				AXIAL LOADS			
	--- <th colspan="2">---R---</th> <th colspan="2"><<< Top Chord >>></th> <th colspan="2"><< Bottom Chord >></th>		---R---		<<< Top Chord >>>		<< Bottom Chord >>	
	L	R	L	R	L	R	L	R
(W) Wind (case 1).....:	0.00	0.00	-4.30	4.30	0.00	0.00	0.00	0.00
(W) Wind (case 2).....:	0.00	0.00	4.30	-4.30	0.00	0.00	0.00	0.00
(L) Live Load.....:	0.00	0.00	0.00	0.00	0.00	0.00	0.00	0.00
(S) Snow Load.....:	0.00	0.00	0.00	0.00	0.00	0.00	0.00	0.00
(D) Dead Load.....:	0.00	0.00	0.00	0.00	0.00	0.00	0.00	0.00
(E) Seism (case 1).....:	0.00	0.00	-5.90	5.90	0.00	0.00	0.00	0.00
(E) Seism (case 2).....:	0.00	0.00	5.90	-5.90	0.00	0.00	0.00	0.00

Axial Force Transf.By.: at left: Weld Plate at right: Seat
 Reinforcement Type....: at left: C at right: 7 [0]
 Bearing Depth [mm]: at left: 100 at right: 200
 Splice [Yes/No].....: Yes Imposed Rows of Bridging Y/N...: No

----- (REAL) DEFLECTION -----

Allowed deflection under live and snow load..... = 19.20 mm (L/ 360)
 Calculated deflection under combined loads (L + 0.9S) = 8.08 mm (L/ 855)
 Use of the joist (Ref. S16-09, art.16.5.1)..... = Roof

===== End of multiple loads =====

----- F O R C E S I N M E M B E R S [kN] -----

(THE SHOWN FORCES ARE FACTORED) (Eff. depth = 574.27 mm)
 Gap.....: 25.4 / 34.925 (Fy = 380 MPa U/N)
 Left Reaction = 33.27/ -2.00 kN Right Reaction = 64.28/ -2.78 kN

No	TENSION		COMPRESSION		REQUIRED MATERIAL x = tied at mid-length	Slend. Util.	Length	REQUIRED WELD Weld-Ea.Side	Remarks
Top Chord									
1.1	9.90	-60.84			LL 2 x 2 x 1/4	z 73 0.35	861		
1.2	9.61	-56.97			do	z 68 0.36	750		
1.3	11.55	-93.18			do	z 61 0.37	675		
1.4	11.55	-93.18			do	z 55 0.39	610		
1.5	12.28	-110.19			do	z 55 0.40	do		
1.6	12.28	-110.19			do	z 55 0.43	do		
1.7	11.50	-98.23			do	z 55 0.43	610		
1.8	11.50	-98.23			do	z 61 0.76	675		
1.9	9.52	-59.13			LL 2 x 2 x 1/4	z 68 0.93	750		
1.10	9.95	-59.86			LL 4 x 4 x 3/8	z 36 0.85	861		
1.11	0.00	0.00			LL 4 x 4 x 3/8	z 60 0.85	1205		
Bottom Chord									
2.1	0.00	0.00			LL 1 1/2 x 1 1/2 x 1/8	z 156 0.60	1225		
2.2	72.81	-4.21			do	z 127 0.78	1061		
2.3	105.06	-5.82			do	z 146 0.81	1220		
2.4	108.23	-5.79			do	z 146 0.81	1220		
2.5	79.02	-4.15			do	z 127 0.80	1061		
2.6	0.00	0.00			LL 1 1/2 x 1 1/2 x 1/8	z 156 0.66	1225		

F O R C E S I N M E M B E R S (Cont.) [kN]

No	Tension	Compres.	REQUIRED MATERIAL			REQUIRED WELD		Remarks
			x = tied at mid-length	Slend.	Util.	Length	Weld-Ea.Side	
End Diagonal								
3.1	65.39	-3.88	SB 1 (50W)	z 180	0.33	1319	6.35 - 38	
3.2	65.89	-6.79	SB 1 (50W)	z 180	0.33	1319	6.35 - 38	
Diagonal Towards End								
4.1	27.55	-1.56	U 1 x 7/8 x 0.091	z 123	0.59	903	2.30 - 39	
4.2	11.09	-2.55	do	z 116	0.24	856	2.30 - 38	
4.3	9.45	-4.16	do	z 116	0.29	856	do	
4.4	27.06	-1.58	U 1 x 7/8 x 0.091	z 123	0.58	903	2.30 - 38	
Diagonal Towards Center								
5.1	1.69	-28.47	d U 1 3/8 x 1 1/4 x 0.118	z 63	0.68	713	3.00 - 38	
5.2	1.03	-18.55	U 1 x 0.091	z 91	0.96	856	2.29 - 38	
5.3	1.16	-18.80	U 1 x 0.091	z 91	0.97	856	2.29 - 38	
5.4	2.01	-39.75	d U 1 3/8 x 1 1/4 x 0.118	z 63	0.95	713	3.00 - 43	
Secondary Web Member								
7.1	0.53	-9.03	U 1 x 7/8 x 0.091	z 96	0.45	702	2.30 - 25	
7.2	0.37	-8.63	do	z 82	0.35	600	do	
7.3	0.35	-9.51	do	z 82	0.39	do	do	
7.4	0.36	-9.51	U 1 x 7/8 x 0.091	z 82	0.39	600	2.30 - 25	
7.5	22.22	-5.32	i U 1 3/8 x 1 1/4 x 0.118	z 62	0.24	702	3.00 - 38	

BRIDGING

Maximum spacing between rows of bridging

@ Top Chord:	5342.92 ==>	1 Row(s) Minimum	Lateral Supports Deck (304.8)
@ Bottom Chord:	4400.87 ==>	3 Row(s) Minimum	Acc. to the code

POSITION	@ Top Chord	@ Bottom Chord
	3481	1200
		3481
		5762

v1.43.0

Fabrication code unless noted

-LL = 2 angles short legs back to back,	-BL = 2 angles welded in box,	-BR = Round bar
-U = 1 U profile,	-UU = 2 U profiles one inside the other,	-CL = Crimped angle

CONCENTRATED LOADS (* indicates that the conc. load is not directly on the panel point.)

Span: 1 = Main Joist, 2 = Left Extension, 3 = Right Extension

Hole: Top Chord with Holes at Conc. Loads

Definition of the categories (Cat.):

4 = anywhere along the joist

Chord: 1 = Top, 2 = Bottom

Inclination (Incl.): 90 = Vertical, 0 = Horizontal

PARTIAL LOADS

Span: 1 = Main Joist, 2 = Left Extension, 3 = Right Extension

Chord: 1 = Top, 2 = Bottom

Load Category (Cat.): 1 = Dead, 2 = Live, 3 = Wind, 5 = Non-Composite Dead, 6 = Non-Composite Live 8 = Snow

Project no.:	U07664	Designer:	Emilie Pellerin	Shop:	Canam Group Inc. Toronto [Production]
169	/	177	Area to Paint	:	8.18 m2
					Material Sort : Cost

The Web-Fitting has Problems

This mark has been edited

GENERAL NOTES:

- WHEN THE STEEL DECK IS WELDED, STRUCTURAL SUPPORTS MUST HAVE A MINIMUM THICKNESS EQUAL TO 2.5 TIMES THE TOTAL THICKNESS OF THE STEEL DECK TO BE WELDED AND A MINIMUM WIDTH OF 38mm (1 1/2") WHERE THE WELD WILL BE ACHIEVED. OTHERWISE, THE STEEL DECK MUST BE MECHANICALLY ATTACHED USING AN APPROPRIATE CONNECTOR. (EX. NAILS OR SCREWS)
- THE STEEL DECK SHEETS ARE MADE OF STRUCTURAL GRADE STEEL WITH ZINC COATING ACCORDING TO THE REQUIREMENTS OF ASTM A653M. THE STEEL DECK SHEETS ARE DESIGNED ACCORDING TO THE REQUIREMENTS OF CAN / CSA S106-12, CAN / CSA S100-12, CSSBI-10M-13, 12M-15 AND 20M-15.
- FOR OPENINGS OF 150mm (6") OR LESS ACROSS THE FLUTES, NO REINFORCEMENT IS NECESSARY PROVIDED THAT NO MORE THAN TWO VERTICAL WEBS ARE REMOVED. FOR OPENINGS OF MORE THAN 150mm (6") ACROSS THE FLUTES, PROVIDE SUITABLE REINFORCEMENT BASED ON STRUCTURAL ANALYSIS OF THE LOADS INVOLVED BY THE STRUCTURAL ENGINEER OF THE PROJECT.
- ALL WELDS TO BE PAINTED WITH GALVACON. (NOT PROVIDED BY CANAM GROUP INC.)
- CANAM GROUP INC. INCLUDES THE SERVICE OF CHECKING THE STEEL DECK GAUGE ONLY UNDER GRAVITY LOADS SHOWN ON THE STRUCTURAL DRAWINGS. ACCORDING TO STANDARD CAN / CSA S16-14 CLAUSE 4.2.2(i) AND CSSBI SSF-28, THE STRUCTURAL ENGINEER OF THE PROJECT IS RESPONSIBLE FOR THE STEEL DECK DIAPHRAGM DESIGN. THE STEEL DECK FASTENING PATTERNS SHOWN ON PLANS WERE PROVIDED BY THE STRUCTURAL ENGINEER OF PROJECT STRUCTURE REMAIN ITS RESPONSIBILITY.


CONTRACTOR NOTES:

CANAM GROUP INC. STEEL DECK IS PRODUCED FROM PRIME MATERIAL AS PER APPROVED DRAWINGS. THE DECK IS SHIPPED TO THE JOB SITE IN DRY AND CLEAN CONDITION, READY FOR INSTALLATION.
 GENERAL CONTRACTOR IS RESPONSIBLE FOR DECK STORAGE ON THE JOBSITE AS PER CSSBI 10M-13 AND 12M-15 STANDARDS.
 WARNING: ZF75 GALVANNEAL COATING CAN DISCOLOR DUE TO HIGH HUMIDITY, TEMPERATURE CYCLING, OR SITE STORAGE. DISCOLORATION DOES NOT AFFECT THE STRUCTURAL INTEGRITY OF THE PRODUCT AND CAN BE PRIMED OR PAINTED IF NECESSARY FOR AESTHETIC PURPOSES. GREEN BUILDING / LEED CERTIFICATION REQUIREMENTS MAY RESTRICT CERTAIN TYPES OF PAINTS TO BE APPLIED ON SITE. GENERAL CONTRACTOR IS TO MAKE SURE THE DECK PROPERLY PROTECTED AS PER CANAM GROUP INC. WARNING LABEL. REFER TO CSSBI 10M-13 (SECTION 8.10) AND 12M-15 (SECTION 7.11) STANDARDS FOR CONFIRMATION OF THE ABOVE NOTES.
 CANAM GROUP INC. IS NOT RESPONSIBLE AND WILL NOT ACCEPT ANY CHARGES FOR PRIMING OR PAINTING ON SITE.

APPROVAL NOTES: (IF APPLICABLE)

- PLEASE REVIEW THESE DRAWINGS CAREFULLY. IT REPRESENTS OUR INTERPRETATION OF THE CONTRACT DOCUMENTS.
- SUBSEQUENT CHANGES TO INFORMATION SHOWN ON THESE DRAWINGS AFTER FIRST SUBMISSION COULD BE CONSIDERED AS CONTRACT CHANGES. IF CONSIDERED A CONTRACT CHANGE THE ARCHITECT / ENGINEER SHOULD BE INFORMED IN WRITING.
- UNLESS NOTED TO THE CONTRARY ON THESE DRAWINGS WHEN RETURNED FROM APPROVAL, IT WILL BE CONSIDERED THAT THE INFORMATION SHOWN HEREIN HAS BEEN ACCEPTED BY ALL PARTIES.
- ACCORDING TO STANDARD CAN / CSA S16-14 CLAUSE 4.2.2(i) AND CSSBI SSF-28 THE STEEL DECK DIAPHRAGM AND FASTENING PATTERN NEED TO BE DESIGNED AND PROVIDED BY THE STRUCTURAL ENGINEER OF THE PROJECT.
- TO MEET DELIVERY REQUIREMENTS THIS PROJECT WILL BE ISSUED FOR FABRICATION WITH THIS RETURNED APPROVAL. DECK REINFORCING OR ADDITIONAL MATERIAL REQUIRED DUE TO MISSING LOADS SUCH AS SNOW LOADING RECEIVED AFTER ISSUE FOR FABRICATION WILL BE CONSIDERED AT OWNERS EXPENSE.
- APPROVER TO CONFIRM OR SUPPLY ALL CLOUDED INFORMATION WHERE SHOWN ON PLAN.

DECK BOX DESCRIPTION: END LAP DETAIL:

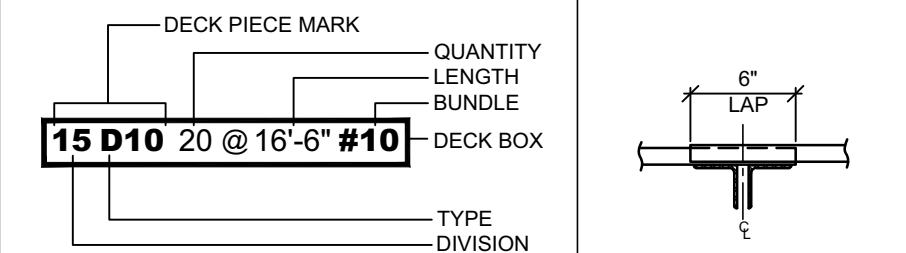

SIDE LAP CONNECTIONS:




TYPE OF JOINT	PROFILE	CONNECTOR AT SIDE LAP	CONNECTOR AT SUPPORT
INTERLOCK JOINT	• P-3615 • P-2436 • P-3623 • P-2432	• BUTTON PUNCH • WELD	• WELD* • POWER DRIVEN FASTENER
OVERLAPPING JOINT	• P-3606 • P-2404 • P-3012	• SCREW • WELD**	• SCREW

* WELDS AT SUPPORT REQ. WELDING WASHERS WHEN DECK THICKNESS IS < 0.71mm
 ** WELDING OF SIDE LAPS IS NOT RECOMMENDED FOR MATERIAL ≤ 0.71mm
 *** AT SUPPORTS, STEEL DECK TO BE CONNECTED EACH SIDE OF THE INTERLOCKING JOINT. IF WELDED, 1 x 20mm(3/4") DIAMETER SPOT WELD IS REQUIRED ON THE MALE END AND 2 x 16mm(5/8") DIAMETER SPOT WELDS ON THE FEMALE END.

DECK FASTENING PATTERN AT SUPPORT:


IN CASE OF MECHANICAL FASTENERS TO SUPPORTS, THE ERECTOR IS TO FOLLOW THE MANUFACTURERS SPECIFICATION. IN THE CASE OF WELDED FASTENERS, THE ERECTOR SHALL TAKE CARE IN THE SELECTION OF ELECTRODES AND AMPERAGE TO PROVIDE POSITIVE TIE TO THE SUPPORT WITHOUT CAUSING ANY HIGH AMPERAGE BLOW HOLES.

MATERIAL THICK. (t)	PINS
1/8"(3mm) ≤ t ≤ 3/8"(10mm)	X-HSN 24
t > 1/4" (6mm)	X-ENP-19 L15

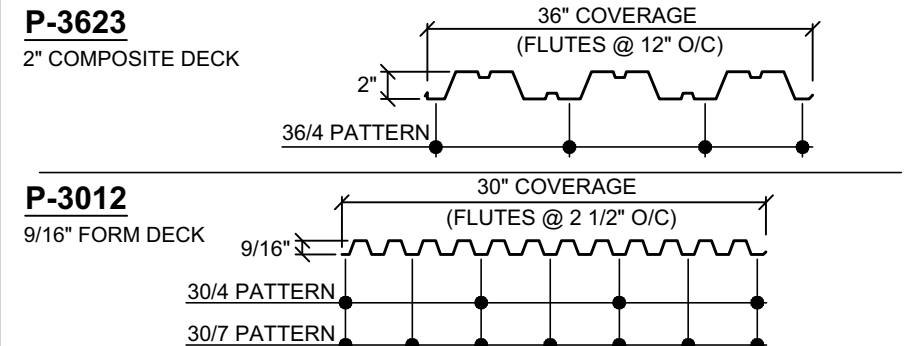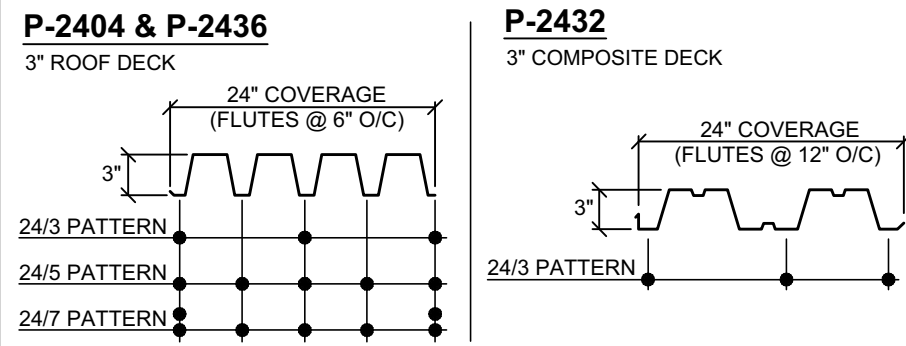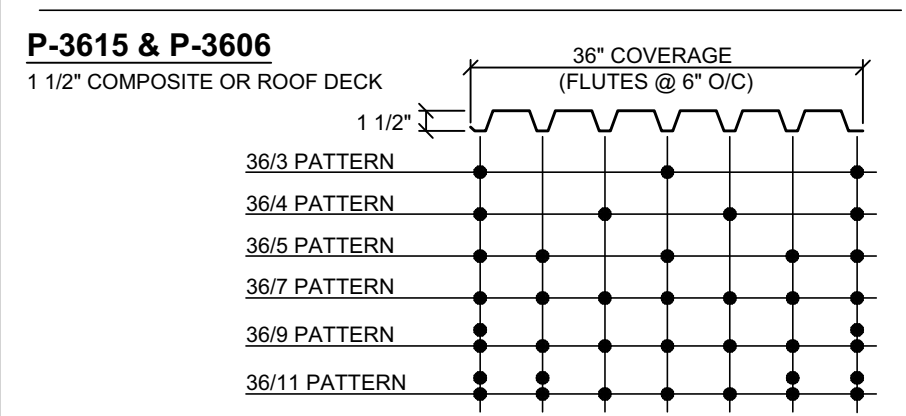

STANDARD / TYPICAL EDGE OF DECK CONDITIONS

NOTE: CLOSURE ANGLES AND EMBEDDED MATERIALS MAY VARY DEPENDING ON PROJECT SPECIFICATIONS. REFER TO STRUCTURAL DRAWINGS OR CANAM GROUP INC. DETAILS FOR MORE SPECIFIC INFORMATION IF REQUIRED.

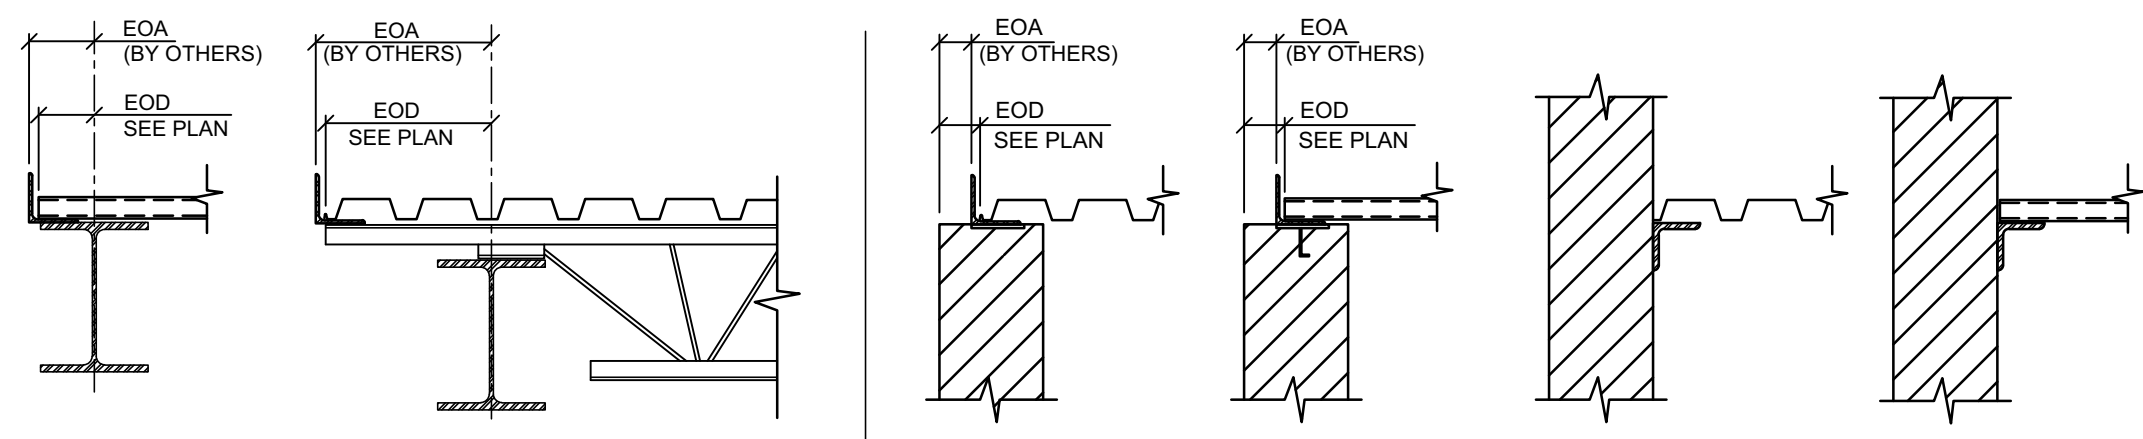


EDGE OF DECK AT PERIMETER ANGLE
 1. CLOSURE ANGLES BY OTHERS

EDGE OF DECK AT CONCRETE / BLOCK WALL
 1. EMBEDDED MATERIALS BY OTHERS

ROOF DECK FRAMING PLAN

REFERENCE DWG: S100 REV. 1

- U/S DECK ELEVATION : 3600mm U.N.O. ON PLAN. **HIGH POINT**
- UNIFORM ROOF LOADS:
 - DEAD = 1.45 kPa
 - LIVE = 3.5 kPa + SNOW DRIFT

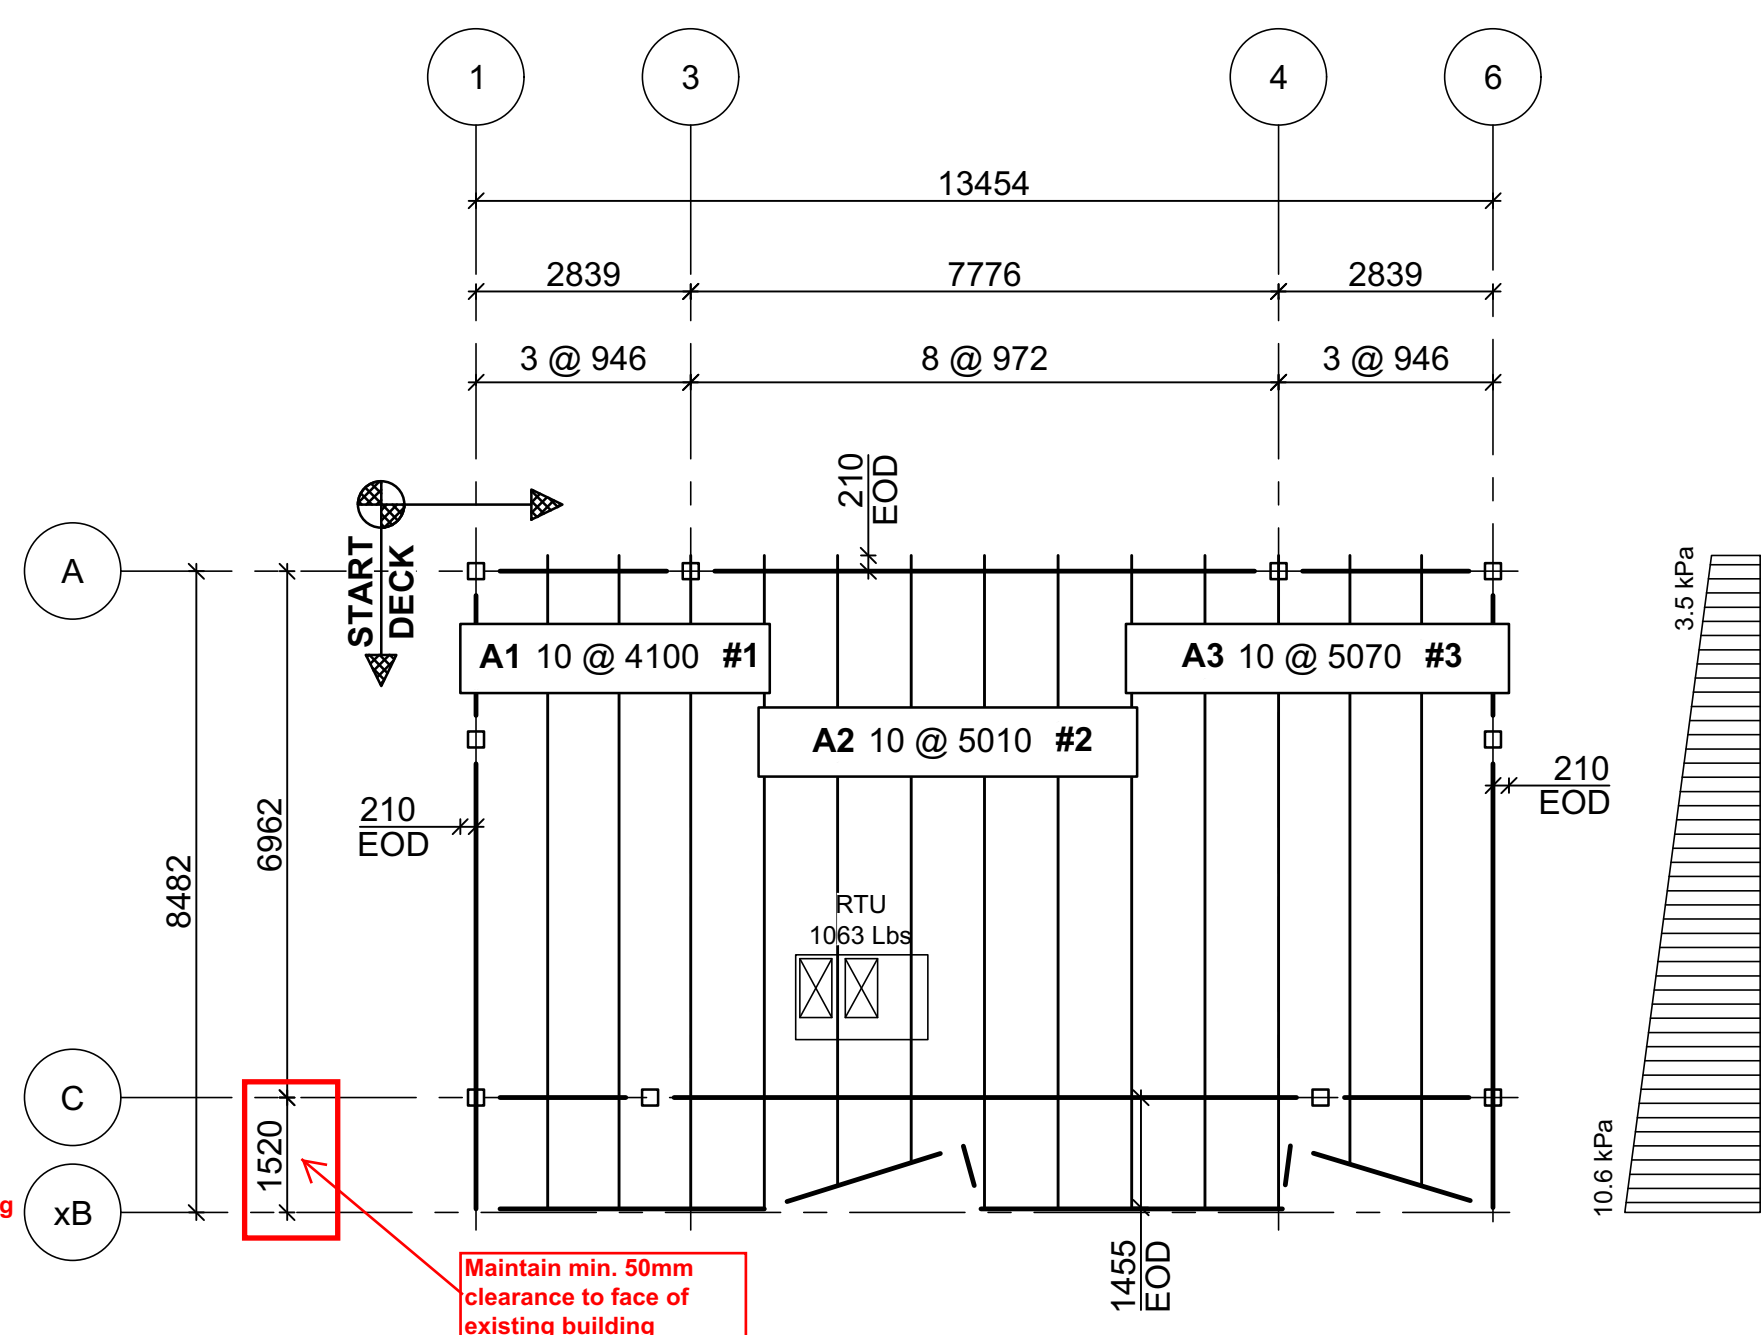

SHOP DRAWING REVIEW

- REVIEWED
- REVIEWED AS NOTED
- REVISE AND RESUBMIT



*This review is for the sole purpose of ascertaining conformance with the general design concept for architectural features only, and does not in any way constitute review of the design of engineering elements which form part of the Contract Documents prepared by others. This review shall not mean that the Architect approves the detail design inherent in the shop drawings. This responsibility shall remain with the Contractor submitting same, and such review shall not relieve the Contractor of his responsibility for errors or omissions in the shop drawings or of his responsibility for meeting all requirements of the Contract Documents. The Contractor is responsible for dimensions to be confirmed and correlated at the job site, for information that pertains solely to fabrication processes, or to techniques of construction and installation and for co-ordination for the work of all trades.

By: Reinhard Vogel Date: 10/22/2018
 HOBIN ARCHITECTURE INCORPORATED

DECK FASTENING PATTERN

BUTTON PUNCH @ 150 o/c
 36/9 FASTENER PATTERN
 19mm PUDDLE WELDS TO SUPPORTING MEMBERS
 FASTENER SPACING AROUND PERIMETER & OPENINGS TO BE 150 o/c
 DECK BE 3 SPAN MINIMUM

SHOP DRAWING REVIEW

CUNLIFFE & ASSOCIATES

This review is for the sole purpose of determining general conformance with the Structural Drawings. This review does not mean that Cunliffe & Associates approves the detail design inherent in the shop drawings. The responsibility for which remains with the Contractor submitting the shop drawings. Our review does not relieve the Contractor of his responsibility for errors or omissions in the shop drawings or meeting the requirements of the Contract Documents. The Contractor is responsible for dimensions to be confirmed and correlated at the job site and information that pertains solely to fabrication processes or to techniques of construction installation and for co-ordination of the work of all subtrades.

- REVIEWED AS NOTED
- REVIEWED
- RESUBMIT

CHK'D BY **NH**
 DATE **10/22/18**

FOR APPROVAL ONLY
DON'T USE FOR CONSTRUCTION
OR FOR ERECTION

DECK GAUGE & FINISH

MARK	CANAM DECK TYPE	GAUGE	FINISH	COVER
A	P3615 - 38mm	18GA	GALVD	914

LEGEND

BS	--- BUTT STRIP
C/C	--- CENTER TO CENTER
CL	--- COLUMN CLOSURE
(A)	--- CHANGE IN ELEVATION
CS	--- CLOSURE STRIP
EOA	--- EDGE OF ANGLE
EOD	--- EDGE OF DECK
EOS	--- EDGE OF SLAB
FOW	--- FACE OF WALL
GALVD	--- G90 / Z-275
LZC	--- A25 / ZF-75
MCS	--- METAL CLOSURE SMALL
MCL	--- METAL CLOSURE LARGE
O/A	--- OVER ALL
PS	--- POUR STOP
RTU	--- ROOF TOP UNIT
RCL	--- RIDGE CLOSURE LARGE
RCS	--- RIDGE CLOSURE SMALL
RV	--- RIDGE & VALLEY
SC	--- SUPPORT CHANNEL
SIM	--- SIMILAR
TOS	--- TOP OF STEEL
TYP	--- TYPICAL
U/S	--- UNDER SIDE
UNO	--- UNLESS NOTED OTHERWISE
VIF	--- VERIFY IN FIELD
ZS	--- Z- CLOSURE
ZES	--- Z- EDGE STRIP

REVISION NO.	DATE	DESCRIPTION
A	Oct-18-2018	ISSUED FOR APPROVAL ONLY



ST. GEORGE (QC) 1-888-849-5910 - email: gordon.draw@canamgroupinc.com
 MISSISSAUGA (ON) 1-800-446-8897 - email: toronto.drafting@canamgroupinc.com
 MONCTON (NB) 1-800-210-7833 - email: moncton.draw@canamgroupinc.com
 CALGARY (AB) 1-866-203-2001 - email: calgary.drafting@canamgroupinc.com

PROJECT NAME:	TURNBULL MUSIC ROOM ADDITION	
LOCATION:	OTTAWA, ON	
TITLE:	ROOF DECK FRAMING PLAN	
CUSTOMER:	FORTRAN STEEL INC	
ENGINEER:	CANAM GROUP INC. ENGINEER SEAL(S):	
DRAWN BY:	IDO/AG	PLANT: MONCTON
DATE:	Oct-09-2018	DRAWING NO: DE1

GENERAL NOTES:

- ALL PRODUCTS PROVIDED BY CANAM GROUP Inc. IN CONNECTION WITH THIS DRAWING ARE SUBJECT TO CANAM GROUP Inc. STANDARD TERMS AND CONDITIONS FOR JOIST SALES. BY ACCEPTING THE PRODUCT, THE PURCHASER ACKNOWLEDGES THAT THEY HAVE RECEIVED AND REVIEWED THESE TERMS AND CONDITIONS.
- MINIMUM DESIGN REQUIREMENTS TO BE PER CAN/CSA S16.0 STANDARD (AND CSSSI SPECIFICATION WHEN DECK IS SUPPLIED BY CANAM GROUP Inc.) LATEST EDITION, UNLESS OTHERWISE NOTED HEREIN.
- PAINT: GREY PRIMER U.N.O. ON PLAN (SPECIFICATIONS PROVIDED UPON REQUEST)
- THE ISSUANCE OF THIS DRAWING DOES NOT CONSTITUTE THE ACCEPTANCE OF A CUSTOMER'S ORDER.
- THE DESIGN IS BASED UPON LOAD INFORMATION SPECIFICALLY SUBMITTED TO CANAM GROUP Inc. NO SPECIAL LOADS OR OTHER FORCES HAVE BEEN PROVIDED FOR UNLESS PURCHASER HAS REQUESTED THEM IN WRITING. SUCH SPECIAL LOADS OR OTHER FORCES SHALL INCLUDE, WITHOUT LIMITATION: UPLIFT, CONCENTRATED LOADS FROM ROOF TOP UNITS, AXIAL LOADS FROM KICKER ANGLES, ETC.
- CANAM GROUP Inc. ERECTION DRAWINGS HEREIN WERE PREPARED USING THE STRUCTURAL PORTION OF THE CONTRACT DRAWINGS AS ITS PRIMARY GUIDE USING THE ARCHITECTURAL DRAWINGS (WHEN PROVIDED) ONLY FOR MISSING INFORMATION OR FOR CLARIFICATION. CANAM GROUP Inc. DOES NOT ACCEPT ANY RESPONSIBILITY FOR DISCREPANCIES BETWEEN THE STRUCTURAL AND ARCHITECTURAL DRAWINGS.

CONTRACTOR NOTES:


- OWSJ TOP CHORDS AND SEAT WIDTHS MAY VARY.
- FOR A COMPLETE PACKAGE OF CANAM GROUP Inc. STANDARDS & CONNECTION DETAILS GO TO "www.canamgroupinc.com" OR CONTACT YOUR CANAM GROUP Inc. OFFICE.
- CONFIRM ALL JOIST SHOE DEPTHS WITH CANAM GROUP Inc. PRIOR TO DETAILING OF SUPPORTING STEEL.
- REVIEW ENCLOSED LAYOUT FOR CONFORMANCE AND CONNECTION METHODS. INFORM CANAM GROUP Inc. OF ANY MISINTERPRETED CONNECTION DETAILS OR DIMENSIONAL DISCREPANCIES TO ENSURE AS BUILT CONDITIONS ARE SATISFIED.
- CONTRACTOR TO CONFIRM OR SUPPLY ALL CLOUDED INFORMATION WHERE SHOWN ON PLAN.

APPROVAL NOTES: (IF APPLICABLE)

- PLEASE REVIEW THESE DRAWINGS CAREFULLY, IT REPRESENTS OUR INTERPRETATION OF THE CONTRACT DOCUMENTS.
- THE GENERAL CONTRACTOR IS TO INFORM CANAM GROUP Inc. OF ANY INTERFERENCE BETWEEN MECHANICAL UNITS, DUCTWORK AND JOIST/BRIDGING.
- SUBSEQUENT CHANGES TO INFORMATION SHOWN ON THESE DRAWINGS AFTER FIRST SUBMISSION COULD BE CONSIDERED AS CONTRACT CHANGES. IF CONSIDERED A CONTRACT CHANGE THE ARCHITECT / ENGINEER SHOULD BE INFORMED IN WRITING.
- UNLESS NOTED TO THE CONTRARY ON THESE DRAWINGS WHEN RETURNED FROM APPROVAL, IT WILL BE CONSIDERED THAT THE INFORMATION SHOWN HEREIN HAS BEEN ACCEPTED BY ALL PARTIES.
- TO MEET DELIVERY REQUIREMENTS THIS PROJECT WILL BE ISSUED FOR FABRICATION WITH THIS RETURNED APPROVAL. JOIST REINFORCING OR ADDITIONAL MATERIAL REQUIRED DUE TO MISSING LOADS SUCH AS MECHANICAL UNITS AND SPRINKLER INFORMATION RECEIVED AFTER ISSUE FOR FABRICATIONS WILL BE CONSIDERED AT OWNERS EXPENSE.
- APPROVER TO CONFIRM OR SUPPLY ALL CLOUDED INFORMATION WHERE SHOWN ON PLAN.
- ESFR SPRINKLER SYSTEMS - DOCUMENTS INCLUDING DIMENSIONED LOCATIONS OF ALL SPRINKLER LINES TO BE PROVIDED TO CANAM GROUP Inc. TO ENSURE INTERFERENCE REQUIREMENTS ARE RESPECTED. IF THIS CANNOT BE PROVIDED WHEN FABRICATION COMMENCES, CANAM GROUP Inc. WILL PROVIDE THE REQUIRED DOCUMENTS SHOWING THE EXACT LOCATIONS OF ALL MEMBERS INCLUDED.


ERECTOR NOTES:

- THIS DRAWING IS TO BE USED ONLY FOR THE ERECTION OF PRODUCTS SUPPLIED BY CANAM GROUP Inc. AS INDICATED BY AN ERECTION MARK ON THE PLANS AND/OR SECTIONS.
- CANAM GROUP Inc. IS NOT RESPONSIBLE FOR THE HANDLING AND ERECTION OF MATERIALS IT SUPPLIES. THE DESIGN AND MANUFACTURE OF THE MATERIALS ASSUMES THAT THEY ARE HANDLED IN ACCORDANCE WITH ALL APPLICABLE LAWS AND REGULATIONS. CANAM GROUP Inc. IS NOT RESPONSIBLE FOR ANY MISHANDLING OR FAILURE TO PROPERLY ERECT THE MATERIALS.
- CANAM GROUP Inc. HAS NOT EXAMINED ANY FIELD CONDITIONS AND ASSUMES NO RESPONSIBILITY FOR ANY SITE CONDITIONS. THE PURCHASER MUST NOTIFY CANAM GROUP Inc. OF ANY DISCREPANCIES BETWEEN THE FIELD CONDITIONS AND CANAM GROUP Inc. FILE AND FIELD USE DRAWINGS.
- ANY MODIFICATION OF MATERIAL SUPPLIED BY CANAM GROUP Inc. WITHOUT PRIOR WRITTEN CONSENT WILL AUTOMATICALLY RELEASE CANAM GROUP Inc. FROM ALL LIABILITY WITH RESPECT TO SUCH MATERIAL.
- OWSJs MUST BE PERMANENTLY FASTENED IN PLACE AND BRIDGING ATTACHED BY WELDING OR BOLTING AS SHOWN BEFORE ANY CONSTRUCTION LOADS ARE APPLIED. ALL FIELD WELDING TO BE CARRIED OUT BY WELDERS APPROVED BY C.W.B. TO THE REQUIREMENTS OF C.S.A. -W47 AND W59
- BOLTED CONNECTIONS (BRIDGING AND JOISTS) SHALL BE "SNUG TIGHT". THE 2004 RCSC SPECIFICATION DEFINES IT AS A JOINT IN WHICH THE BOLTS HAVE BEEN INSTALLED IN ACCORDANCE WITH SECTION 8.1. NOTE THAT NO SPECIFIC LEVEL OF INSTALLED TENSION IS REQUIRED TO ACHIEVE THIS CONDITION, WHICH IS COMMONLY ATTAINED AFTER A FEW IMPACTS OF AN IMPACT WRENCH OR THE FULL EFFORT OF AN IRONWORKER WITH AN ORDINARY SPUD WRENCH. THE PLYS SHOULD BE IN FIRM CONTACT, A CONDITION THAT MEANS THE PLYS ARE SOLIDLY SEATED AGAINST EACH OTHER, BUT NOT NECESSARILY IN CONTINUOUS CONTACT.
- BACK CHARGES FOR REPAIRS OR ALTERATION TO CANAM GROUP Inc. PRODUCTS WILL NOT BE ACCEPTED UNLESS APPROVED PRIOR BY CANAM GROUP Inc.
- JOISTS TO BE ERECTED SO THAT THE METAL TAG AT ONE END CORRESPONDS WITH THE END OF THE JOIST WHERE THE MARK IS LOCATED ON THE PLAN THUS:

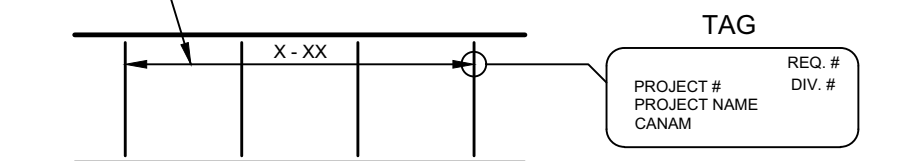

BRIDGING INTERFERENCE/REMOVAL

- REMOVE BRIDGING FROM LOCATION OF DESIRED OPENING.
- RELOCATE REMOVED BRIDGING MEMBERS AS SHOWN BELOW.
- BOLT BRIDGING @ JOIST BOTTOM CHORD NEAR OPENING AND FIX THE OTHER END TO ADJACENT JOIST AS PER PICTURE BELOW.

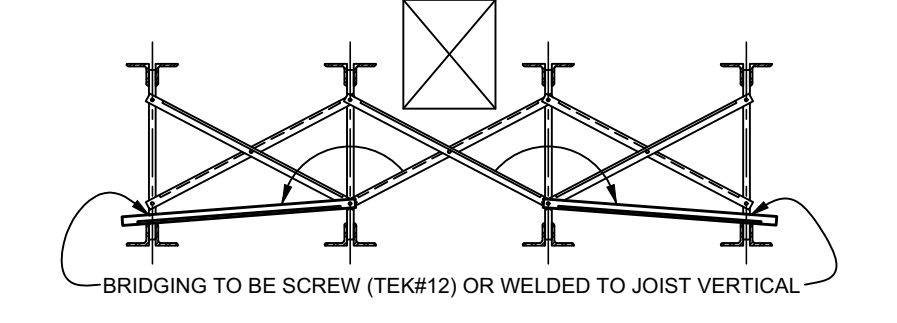

MAX. JOIST SPACING	MIN. HORIZ. BRIDGING SIZE
≤ 1720 / 5' - 7"	L 1 1/2" x 1 1/2"
≤ 2240 / 7' - 4"	L 1 1/2" x 1 1/2"
≤ 2620 / 8' - 7"	L 1 3/4" x 1 1/2"
≤ 2970 / 9' - 9"	L 2" x 2"


- IF SPACING IS GREATER THAN SHOWN, CONTACT CANAM GROUP Inc.
- SIMILAR CONCEPT TO BE APPLIED FOR WELDED BRIDGING

GENERAL JOIST/GIRDER SHOE INFORMATION:

NOTE: ALL ENCLOSED DETAILS AND INFORMATION MUST BE VERIFIED ON PLAN IF NOTED OTHERWISE. DETAILS ARE INTENDED AS STANDARD BUT MAY VARY WITH SPECIFIC CONTRACTOR PROJECTS AND/OR CONDITIONS. ANY DISCREPANCIES BETWEEN GENERAL INFORMATION AND THE PLAN, THE PLAN WILL BE CONSIDERED AS CORRECT.


CANAM STANDARD CONNECTION DETAILS

TO ACCESS THE CANAM STANDARD CONNECTION DETAILS, CLICK ON THE FOLLOWING INTERNET LINK OR SCAN THE QR CODE

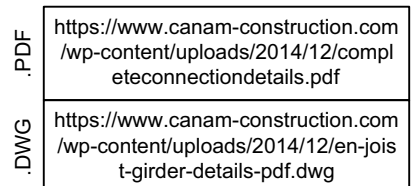



STANDARD GAUGES - CANAM

- WHEN ONE JOIST BEARS AT THE JUNCTION OF TWO DIFFERENT BEAMS, THE SMALLER GAUGE IS TO BE USED.
- DESIGN CONDITIONS CAN DICTATE VARIANCES FOR THESE CONNECTIONS. FOR COORDINATION CONTACT CANAM GROUP Inc.
- USE A325 3/4" Ø BOLTS TYP. U.N.O.

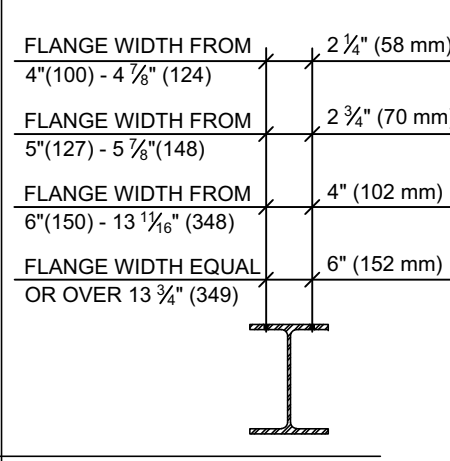



STANDARD WELDED SHOE

- ONLY IF APPLICABLE - SEE PLAN
- U.N.O. ON PLAN

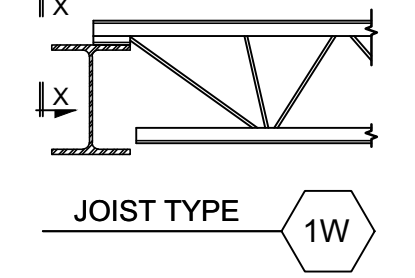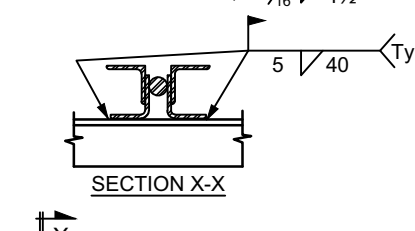

STANDARD BOLTED SHOE

- ONLY IF APPLICABLE - SEE PLAN
- U.N.O. ON PLAN
- BOLTS NOT SUPPLIED BY CANAM GROUP Inc.

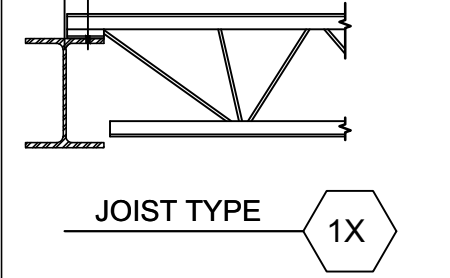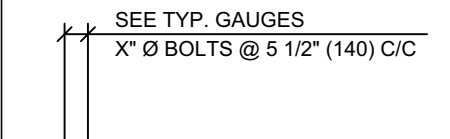

* GIRDERS - 1/2" Ø BOLTS @ 6" (152) C/C *


STANDARD BRIDGING DETAILS:

IMPORTANT NOTE: SEE PLAN FOR ADDITIONAL BRIDGING/BRACING DETAILS AND INSTRUCTIONS IF APPLICABLE.

TYP. BOLTED BRIDGING

- ONLY IF APPLICABLE - SEE PLAN
- CANAM GROUP Inc. WILL PROVIDE MATERIAL SPECIFICATIONS UPON REQUEST.
- LOCATIONS OF X-BRIDGING NOT TO BE SCALED ON PLAN, EXACT LOCATIONS CAN BE REQUESTED IF REQUIRED.

JOIST TO BEAM

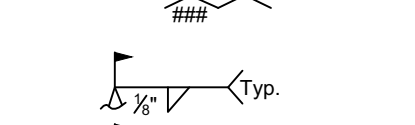

END BAY - JOIST TO JOIST




* BOLTS BY CANAM GROUP Inc. *


TYP. WELDED HORIZONTAL BRIDGING

- SEE PLAN FOR MATERIAL SIZES AND SPECIFICATIONS.
- SEE PLAN FOR LOCATIONS OF WELDED HORIZONTAL BRIDGING. DO NOT SCALE THE PLAN.
- HORIZONTAL BRIDGING CAN BE REQUIRED ON THE TOP AND/OR BOTTOM CHORDS. SEE PLAN SHOWN THUS: T & B
- BRIDGING SPLICE/LAP TO BE MAXIMUM 100 mm (4").
- QUANTITIES OF HORIZONTAL BRIDGING DETERMINED USING (O/A LENGTH (x) # ROWS) (+) 4%

JOIST TO BEAM

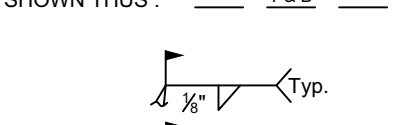


END BAY - JOIST TO JOIST

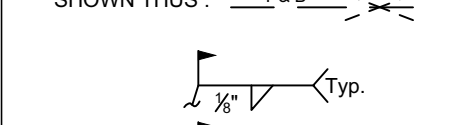


TYP. WELDED HORIZONTAL UPLIFT BRIDGING

- SEE PLAN FOR MATERIAL SIZES AND SPECIFICATIONS.
- SEE PLAN FOR LOCATIONS OF WELDED HORIZONTAL UPLIFT BRIDGING. LOCATED AT FIRST AND LAST PANEL POINTS TYP. U.N.O. ON PLAN.
- FOR INSTALLATION PROCEDURE SEE TYP. WELDED HORIZONTAL BRIDGING DETAILS ABOVE AND SUBTRACT TOP ROW EXCEPT AT JOIST TO JOIST END BAYS.

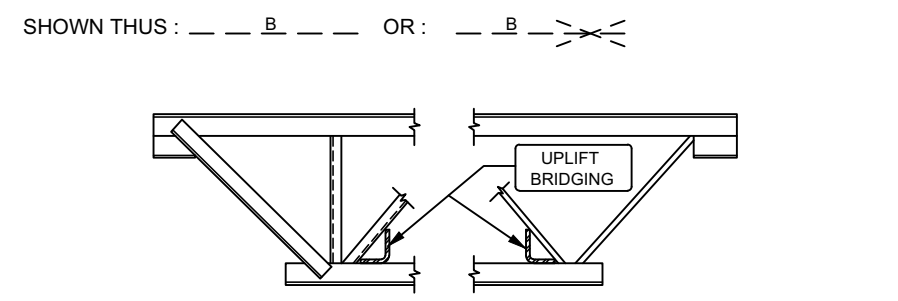


BRIDGING BUNDLING

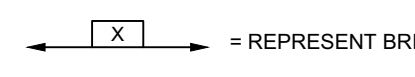

STANDARD TYPICAL OWSJ BEARING CONDITIONS


NOTE: TYPICAL UNLESS NOTED OTHERWISE ON PLAN OR SECTION DETAILS.

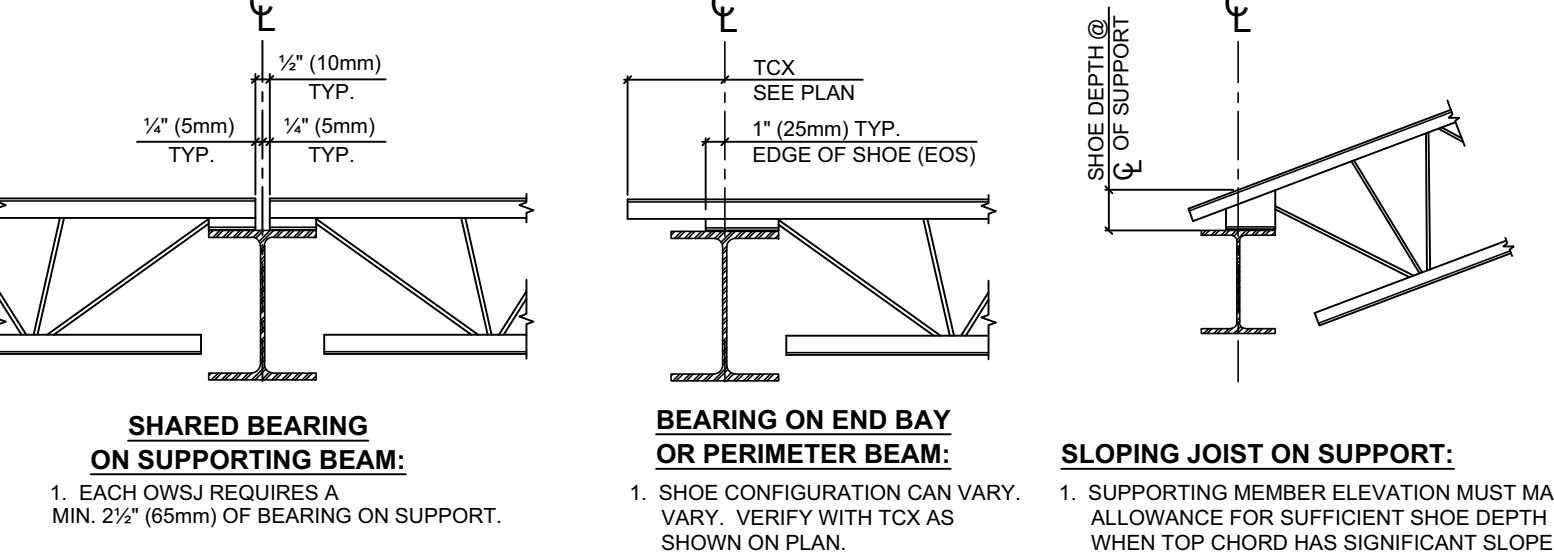

ROOF JOIST FRAMING PLAN

REFERENCE DWG: S100 REV. 1

- U/S DECK ELEVATION : 3600mm U.N.O. ON PLAN.
- STANDARD SHOE DEPTH IS 100mm TYP. U.N.O..
- 600mm DEEP O.W.S.J. TYP. U.N.O..
- TIE JOIST CONNECTIONS ARE (X) TYP. U.N.O..
- REGULAR JOIST CONNECTIONS ARE TYPE (X) TYP. U.N.O..
- JOIST CONNECTIONS SHOWN ARE CANAM GROUP Inc. STANDARDS TYP. U.N.O..
- REGULAR BRIDGING TO BE - BOLTED CROSS
- UPLIFT BRIDGING TO BE - BOLTED CROSS
- ALL COLUMNS SUPPORTING JOISTS/GIRDERS ARE HSS152x152 TYP. U.N.O.

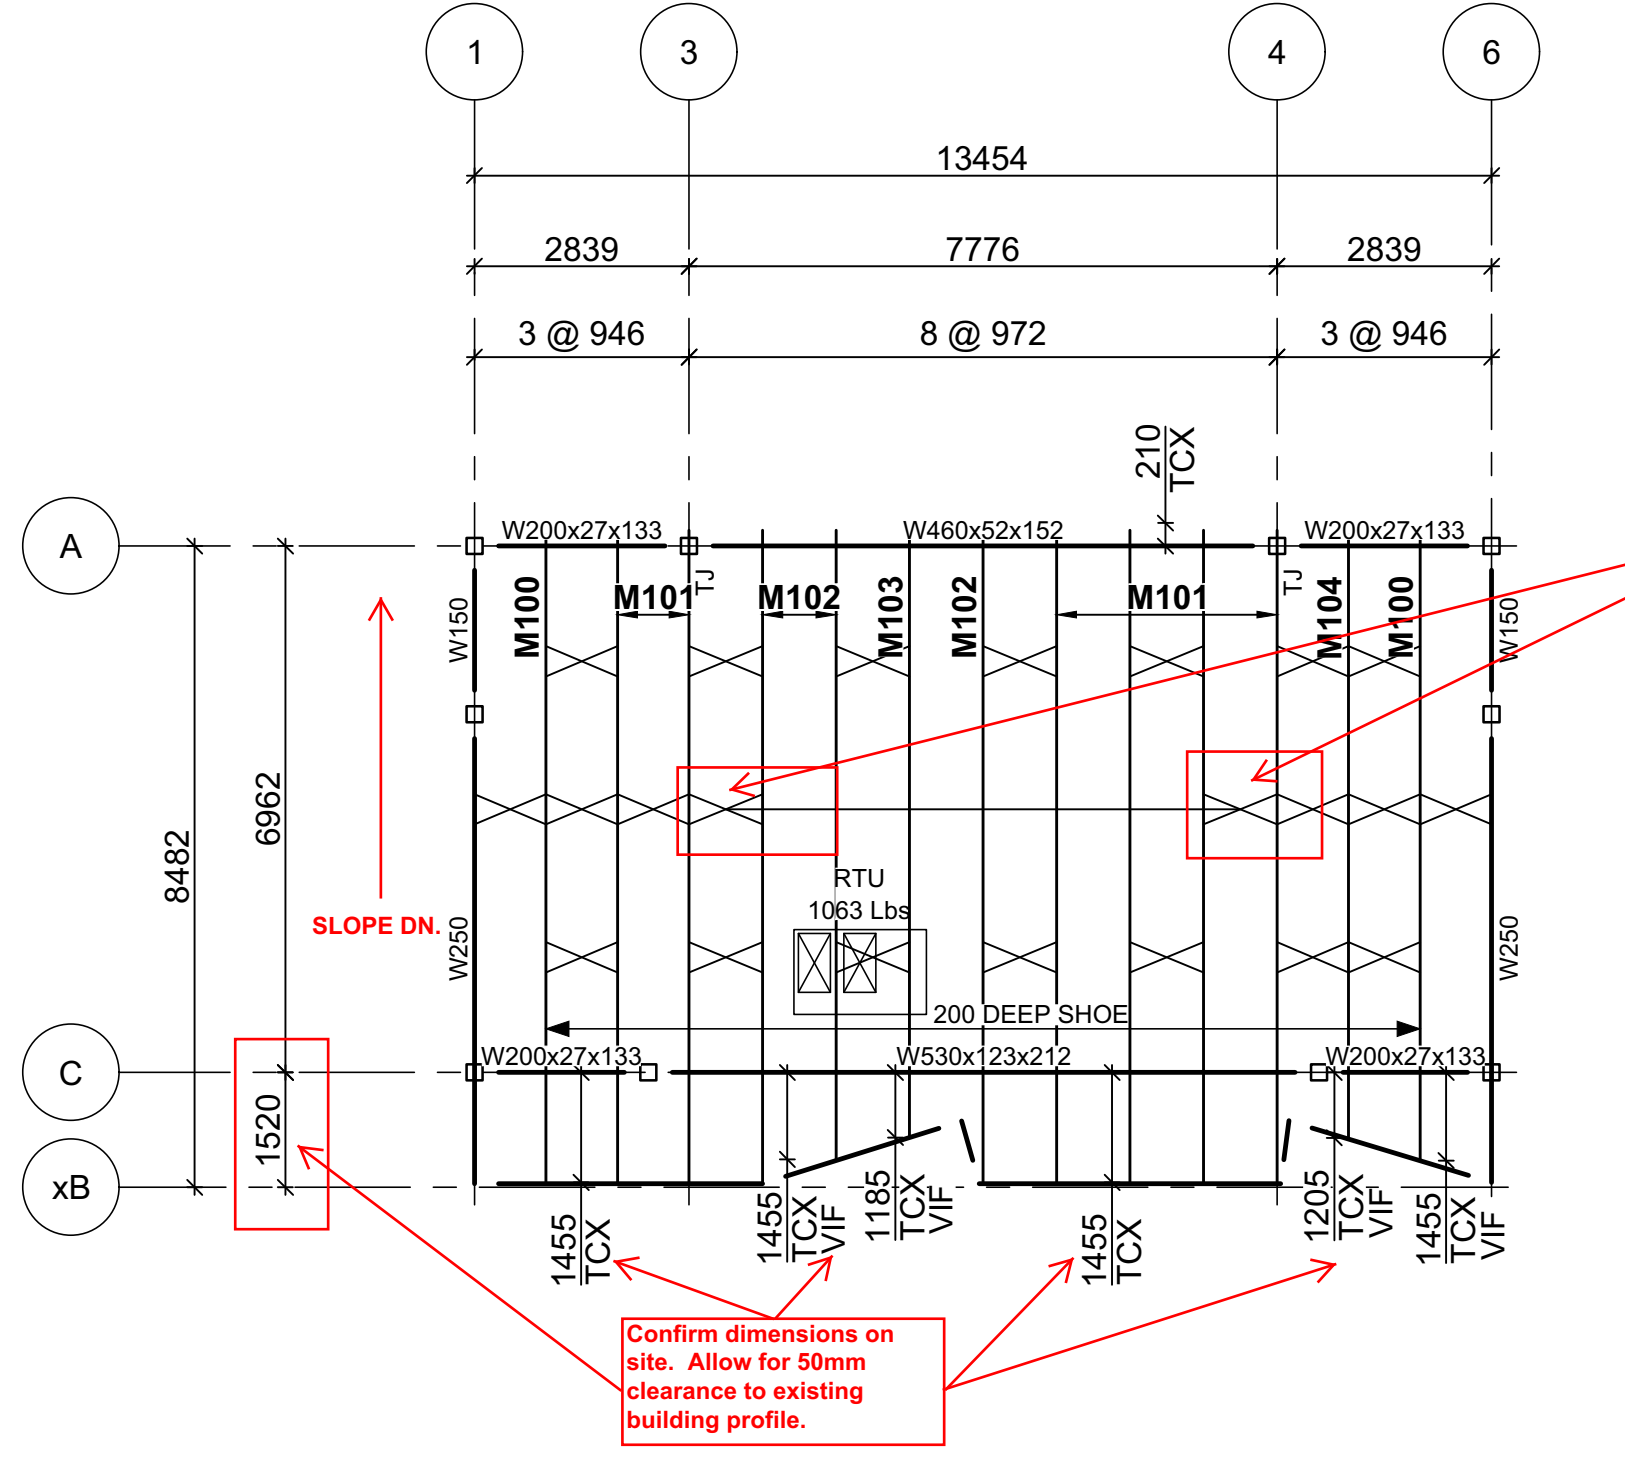

Can bridging be relocated to allow for 300mm dia. ducts running parallel to joists?

Coordinate size and location of RTU with mechanical trade

Confirm dimensions on site. Allow for 50mm clearance to existing building profile.

xB represents face of existing building

SHOP DRAWING REVIEW
CUNLIFFE & ASSOCIATES

This review is for the sole purpose of determining general conformance with the Structural Drawings. This review does not mean that Cunliffe & Associates approve the detail design inherent in the shop drawings. The responsibility for which remains with the Contractor submitting the shop drawings. Our review does not relieve the contractor of his responsibility for errors or omissions in the shop drawings or meeting the requirements of the Contract Documents. The Contractor is responsible for dimensions to be confirmed and corrected at the job site and information that pertains solely to fabrication processes or to techniques of construction installation and for co-ordination of the work of all subtrades.

REVIEWED AS NOTED
 REVIEWED
 RESUBMIT

CHK'D BY: NH
DATE: 10/22/18

FOR APPROVAL ONLY
DON'T USE FOR CONSTRUCTION
OR FOR ERECTION

REVISION NO.	DATE	DESCRIPTION
A	Oct-18-2018	ISSUED FOR APPROVAL ONLY

CANAM GROUP Inc. ENGINEER SEAL(S):		
2018-10-18		

PROJECT NAME:	TURNBULL MUSIC ROOM ADDITION
LOCATION:	OTTAWA, ON
TITLE:	ROOF JOIST FRAMING PLAN
CUSTOMER:	FORSTAL STEEL INC
ENGINEER:	

DRAWN BY:	IDO/AG	PLANT:	MONCTON	DRAWING NO.:	JE1
DATE:	Oct-03-2018	DATE:	U07664		



ST. GEORGE (QC) 1-888-849-5910 - email: geodeon.draw@canamgroupinc.com
MISSISSAUGA (ON) 1-800-446-8897 - email: toronto.drafting@canamgroupinc.com
MONCTON (NB) 1-800-210-7833 - email: moncton.draw@canamgroupinc.com
CALGARY (AB) 1-866-203-2001 - email: calgary.drafting@canamgroupinc.com