

SHOP DRAWING TRANSMITTAL



Project: Turnbull School Music Room Addition Project No: 1705
Date: November 12, 2018
To: TALCO Building Innovations Ltd.
Attn: Farah Bano (fbano@tal-co.com)
From: Michelle Cataldo

- | | |
|--|--|
| <input type="checkbox"/> Approval | <input type="checkbox"/> Courier |
| <input checked="" type="checkbox"/> Distribution | <input type="checkbox"/> By Hand |
| <input type="checkbox"/> Information and Use | <input type="checkbox"/> Fax |
| <input type="checkbox"/> Review and Comment | <input type="checkbox"/> To Be Picked Up |
| <input type="checkbox"/> Other | <input checked="" type="checkbox"/> e-mail |

Partners

Barry J. Hobin
OAA, FRAIC, Hon. Fellow AIA
William A. Davis
OAA, MRAIC, Associate AIA
Gordon Lorimer
OAA, FRAIC, Associate AIA
Wendy Brawley
OAA, MRAIC, Associate AIA
Douglas Brooks
Senior Arch. Tech.

Directors

Marc Thivierge
OAA, MRAIC
Reinhard Vogel
Senior Arch. Tech.

Associates

Bryan Bonell
OAA, MRAIC, Associate AIA
William Ritcey
MRAIC
Dan Henhoefffer
Senior Arch. Tech.


Hobin Architecture Incorporated

63 Pamilla Street
Ottawa, Ontario
Canada K1S 3K7


t 613-238-7200
f 613-235-2005

hobinarc.com


Shop Drawing Submittal: Division 05 - Metals
Submitted by: Fortran Steel Contracting Ltd.
Drawing Title: Guardrail at Retaining Wall
Revision No. N/A
Dated: 9/11/18
Comments:
Reviewed as noted.

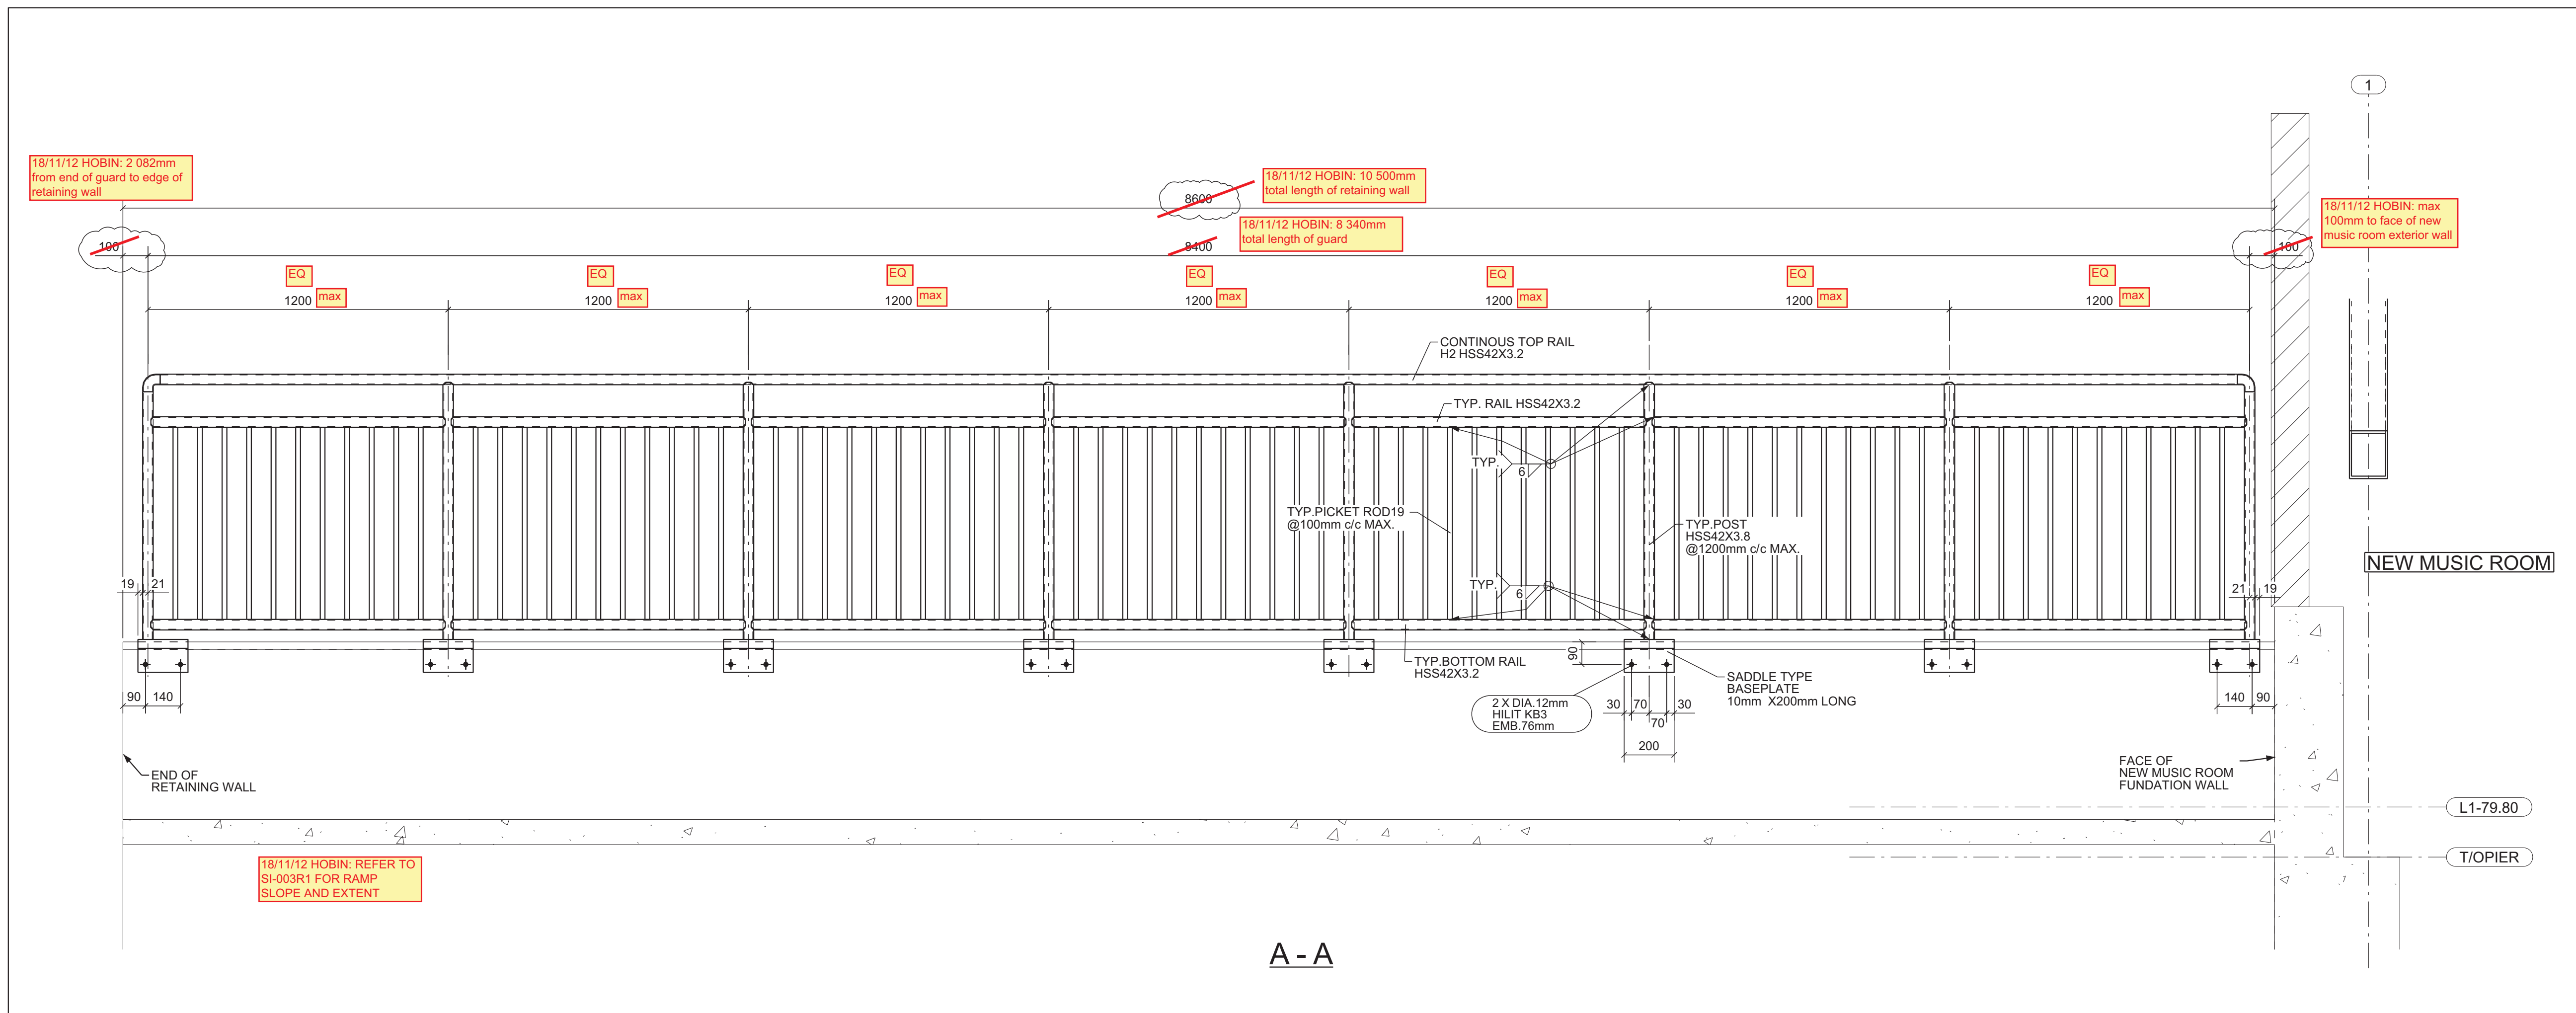

A - A

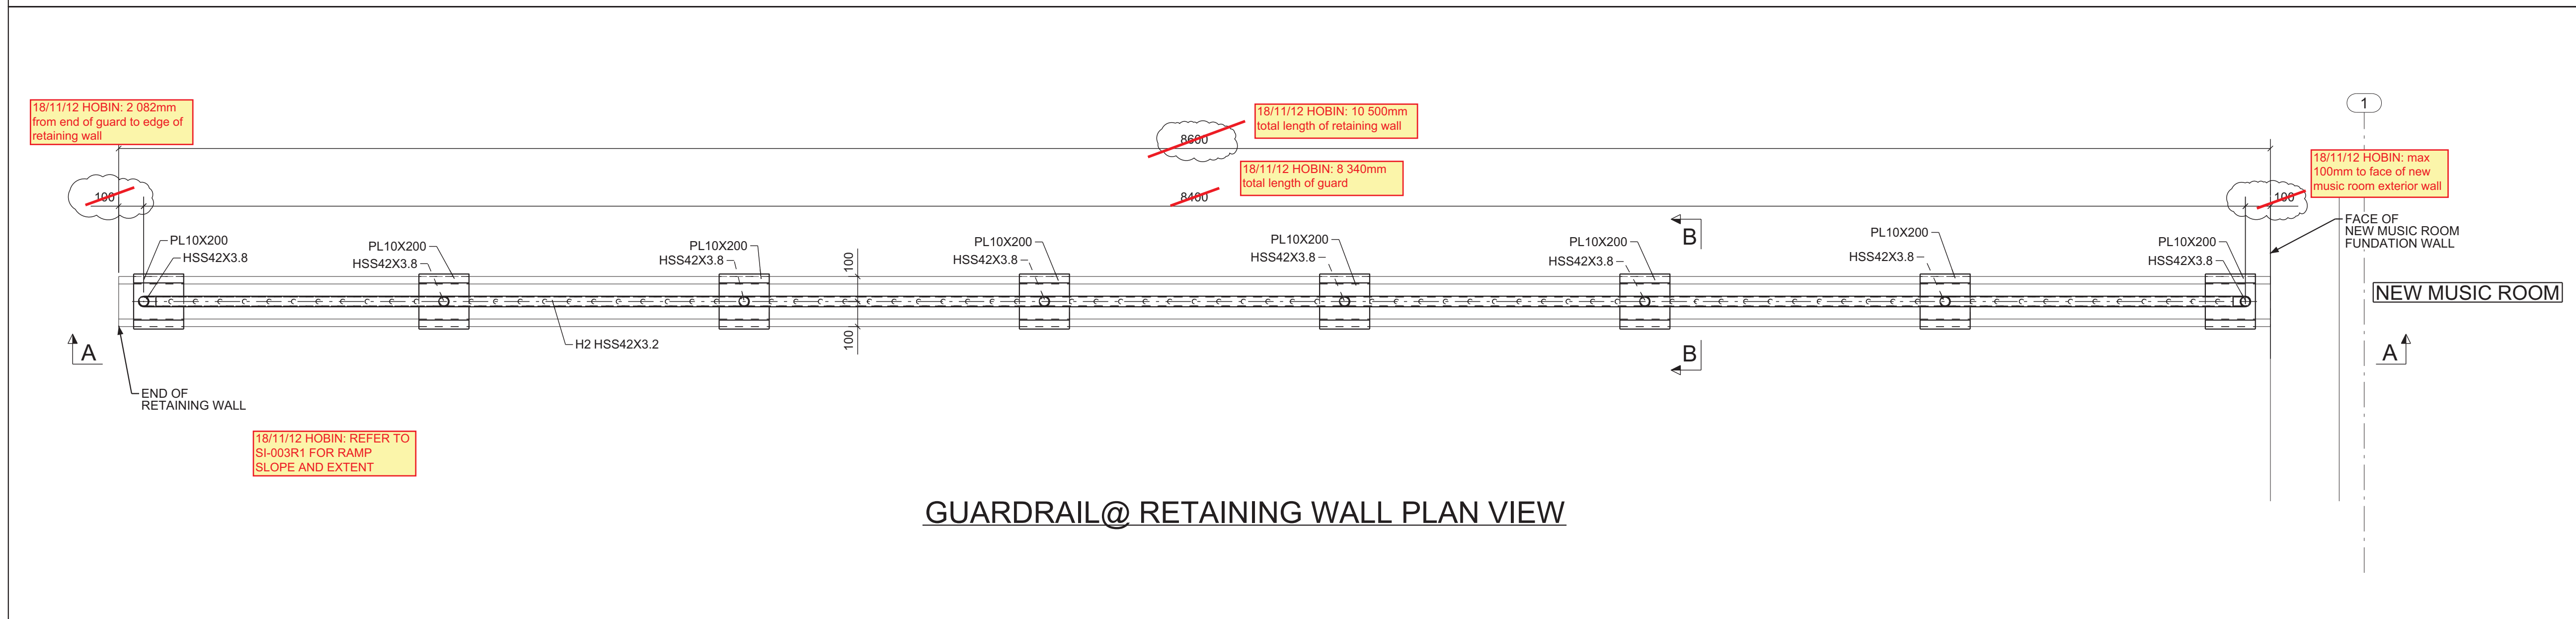

GUARDRAIL@ RETAINING WALL PLAN VIEW

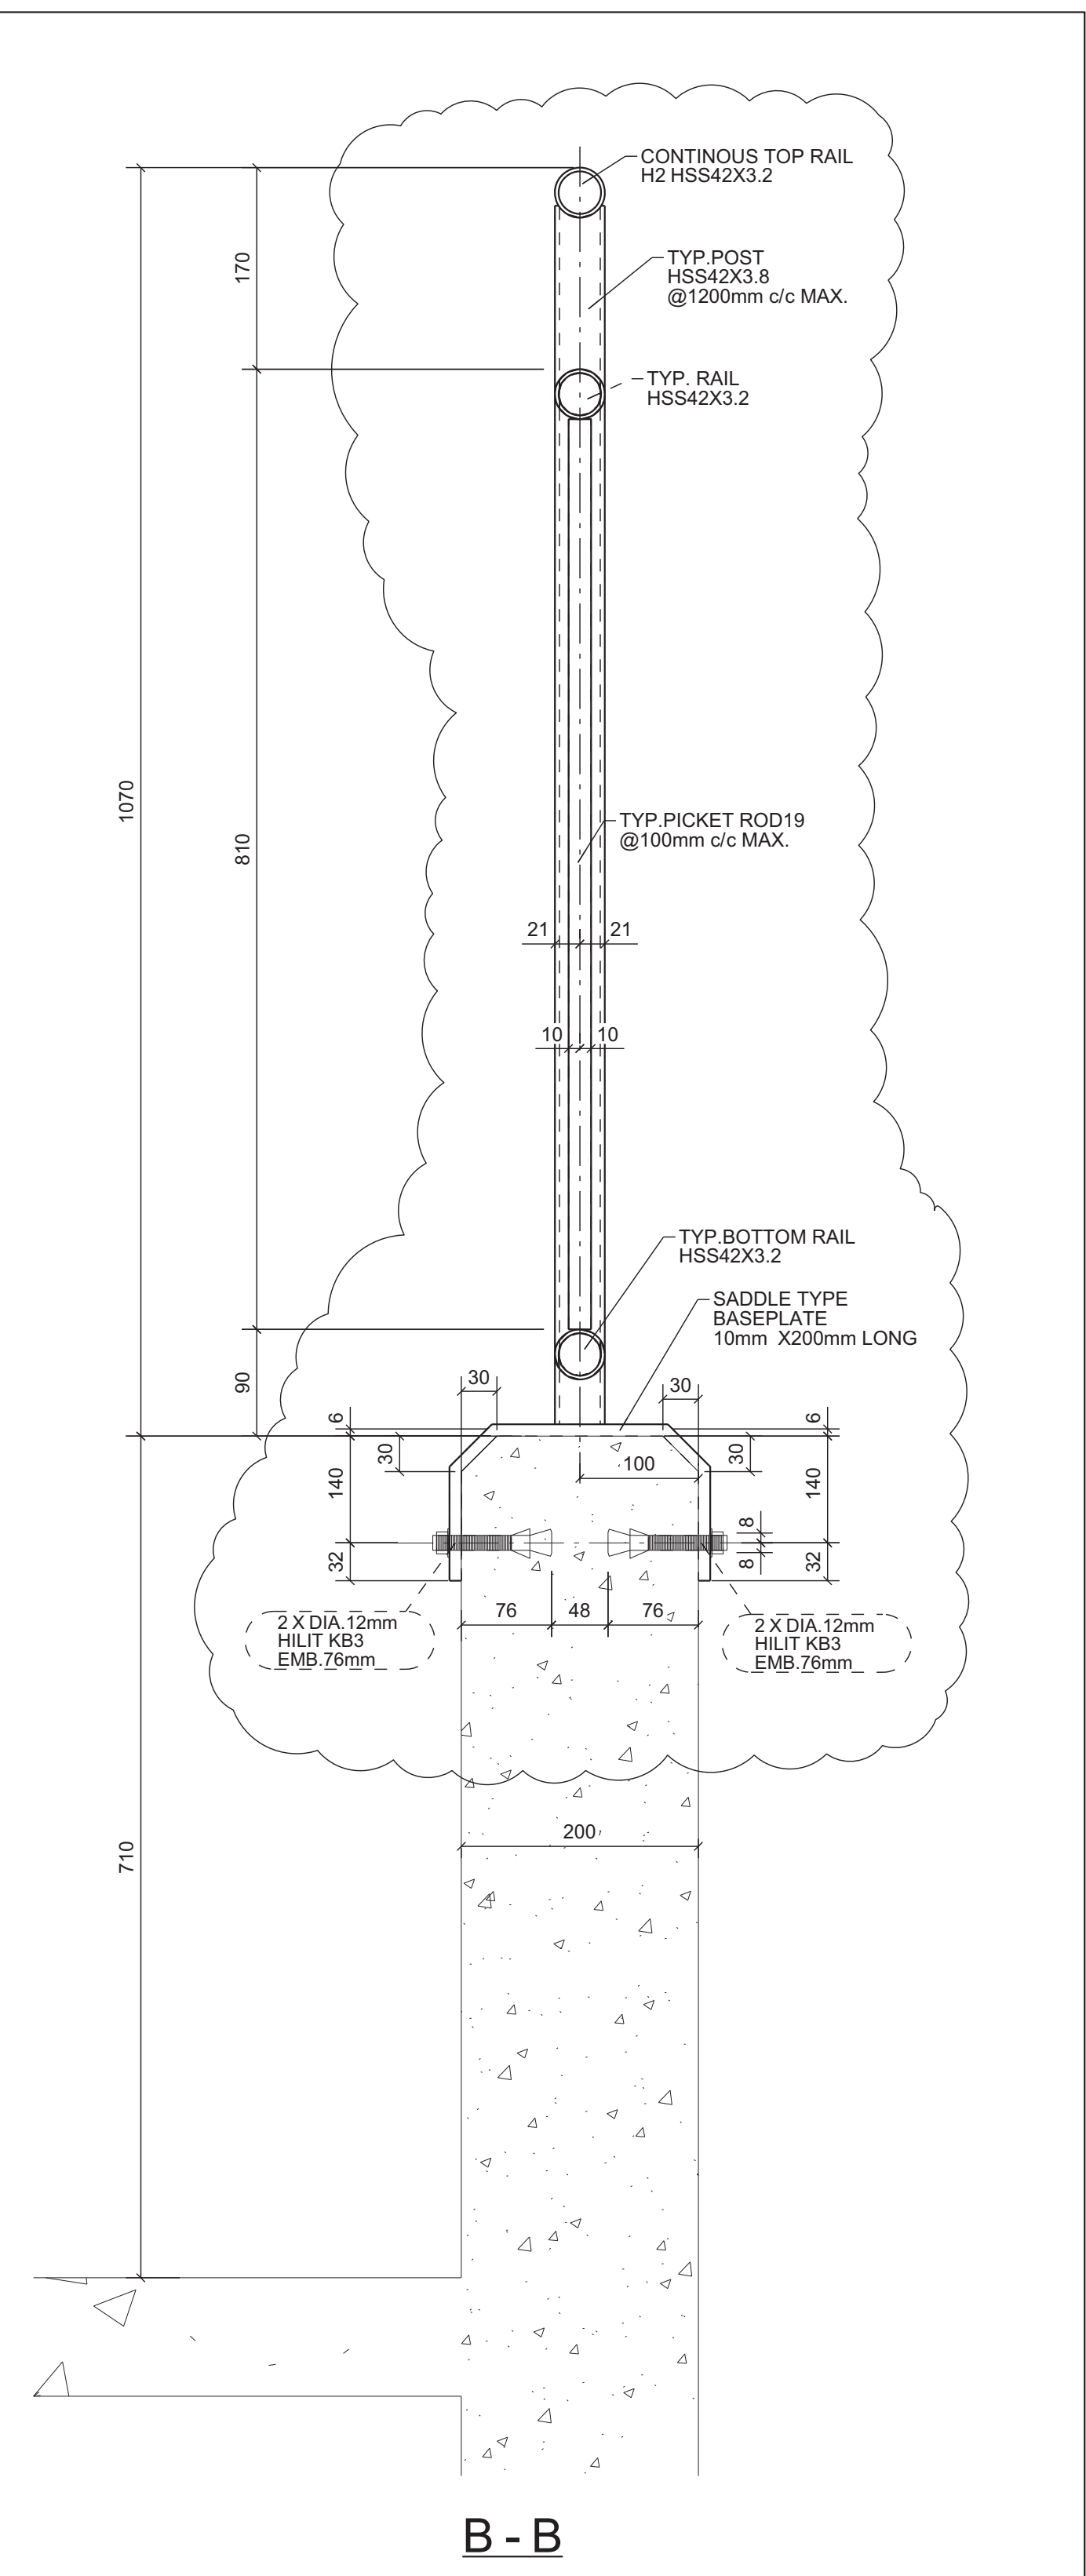

B - B

- NOTES:
1. ALL STEEL TO BE G40.21M 300W;
 2. ALL STEEL TO BE HOT DIP GALVANIZED.
 3. WELDING TO CSA W47.1& W59.3, CONNECTIONS AS PER CAN/CSA S16-09.
 4. STAIRS AND RAILS DESIGN REFERENCE TO OBC 2012 CLAUSE 4.1.5.14.

PLEASE CONFIRM ALL THE DIMENSIONS AND DETAILS

SHOP DRAWING REVIEW
 REVIEWED
 REVIEWED AS NOTED
 REVISE AND RESUBMIT



*This review is for the sole purpose of ascertaining conformance with the general design concept for architectural features only, and does not in any way constitute review of the design of engineering elements which form part of the Contract Documents prepared by others. This review shall not mean that the Architect approves the detail design inherent in the shop drawings. This responsibility shall remain with the Contractor submitting same, and such review shall not relieve the Contractor of his responsibility for errors or omissions in the shop drawings or of his responsibility for meeting all requirements of the Contract Documents. The Contractor is responsible for dimensions to be confirmed and controlled at the job site, for information that pertains solely to fabrication processes, or to techniques of construction and installation and for co-ordination for the work of all trades.

By: Michelle Cataldo Date: Nov. 12, 2018
 HOBIN ARCHITECTURE INCORPORATED

TBI Comment:
 Tender Addendum A02, item #3.01 asks for length of guardrail to match length of landing at the bottom of the +/- 6.4m-ramp.
 Hobin to clarify/confirm final guardrail length.

REVIEWED
 By Farah Bano at 3:54 pm, Nov 09, 2018



Guard Rails Only

FORTRAN STEEL CONTRACTING LTD.
 1340 COKER STREET, GREELEY, ONTARIO, K4P 1A1
 TEL: (613) - 821 - 4014, FAX: (613) - 821 - 4860
 EMAIL: DRAFTING@FORTANSTEEL.COM

PROJECT: TURNBULL SCHOOL MUSIC ROOM ADDITION
 LOCATION: 1132 FISHER AVE. OTTAWA ON

DWG. TITLE: GUARDRAIL@RETAINING WALL
 DRAWN BY: YANG DATE: 01/30/2017 JOB NUMBER: 19-18 DWG NUMBER: M01

REV	DATE	REMARKS
0	11/06/18	For Approval