

LANDSCAPE SITE INSTRUCTION 01



319 McRae Ave,
Suite 502
Ottawa, Ontario
CANADA, K1Z 0B9
TEL: 1(613) 729-4536

PROJECT NAME: The Meridian – Rooftop Landscape
PROJECT #: 2005-01


ISSUED TO:	(BB) Brian Bonell – Hobin Architecture (FB) Farah Bano – Tal-Co (DG) Doug Clunie – D&G	DATE ISSUED:	19 August 2019
		AUTHOR:	Sheri Edwards
COPIED:	(JW) Judi Wright – Meridian Board (SR) Scott Rolofs – ClaimsPro	REFERENCE ATTACHED:	Drawings: L1.0 Removals-mark-up

Site instructions are issued solely to ensure and facilitate compliance with the contract documents. These instructions are not intended to alter the contract price or contract time in any way. Proceeding with work in accordance with these instructions indicates the contractor's acknowledgement that there will be no change in the contract price and contract time. If the contractor believes this instruction affects the contract price or contract time, they shall notify the consultant immediately.

ITEM	DESCRIPTION	ACTION BY	DUE BY
1.0	Carry out soil testing in locations shown on attached mark-up of sheet L1.0 to determine if there are any contaminants / toxins in the soils that might prove harmful to human health for anyone carrying out future maintenance/weeding of the planting beds.	Contractor	As required

Note: soil test to advise if removal of top layer of mulch and approx. 25mm of soil from around plants would be sufficient to clear any contaminants.

END SITE INSTRUCTION 01

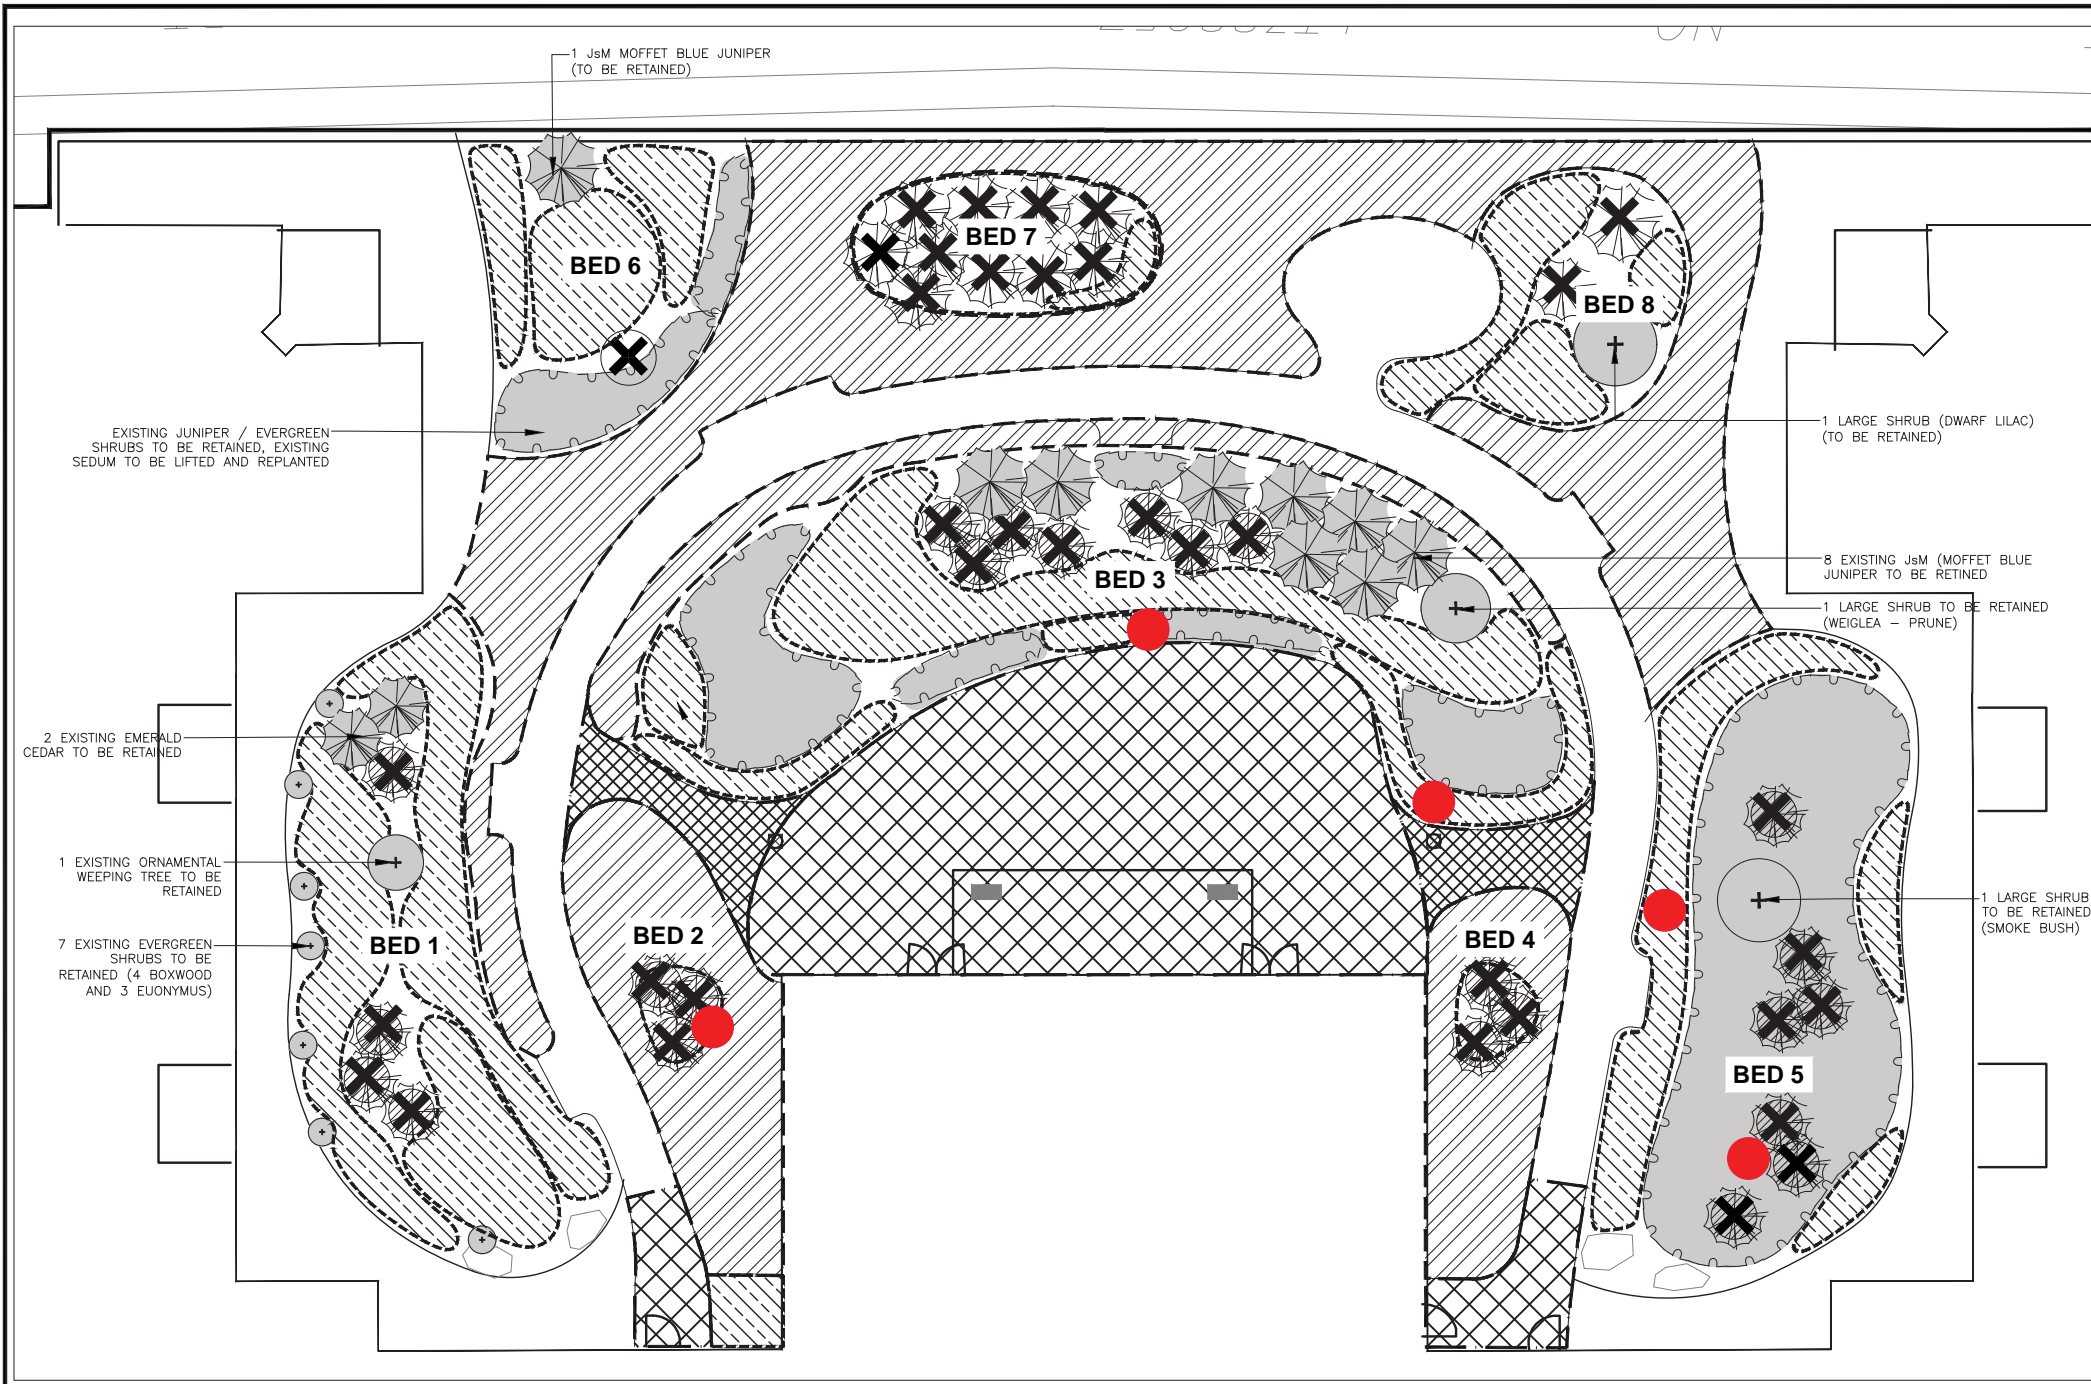


LEGEND

- REMOVE EXISTING PAVING
- LIFT AND SALVAGE EXISTING PAVING FOR RE-USE ON TERRACE
- REMOVE EXISTING SOD
- REMOVE EXISTING SHRUB / PERENNIAL PLANT MATERIAL INCLUDING ALL ROOT MASS
- EXISTING PLANTING TO BE RETAINED (WEED AND IMPROVE SOIL AS PER SPECIFICATIONS)
- REMOVE EXISTING AREA DRAIN (RETAIN PIPE)

● Locations for soil test, issued 2019.08.19

1 UPPER TERRACE -- REMOVALS Scale: 1:100

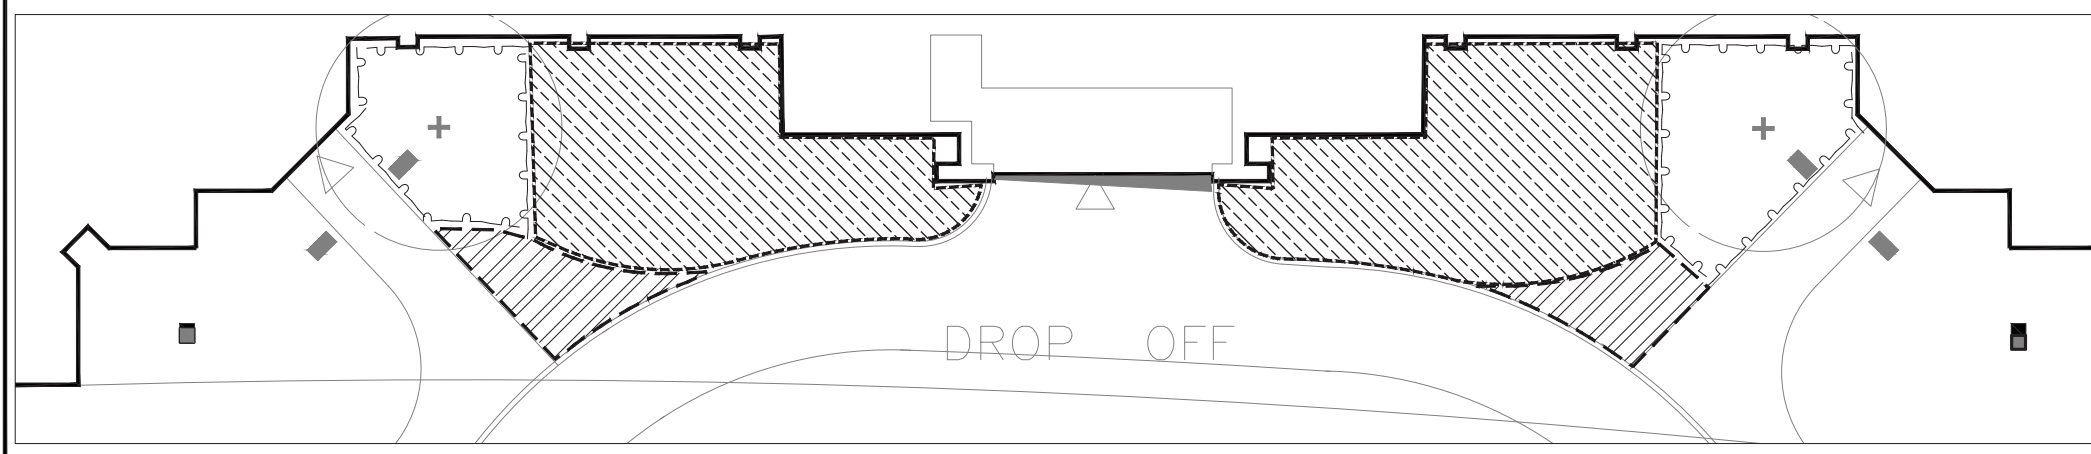

2 GROUND LEVEL -- REMOVALS Scale: 1:100



Key Plan

No.	Revision	Date
2	ISSUED FOR TENDER	08/03/2019
1	ISSUED FOR REVIEW	08/02/2019

North: Stamp:

CSW Landscape Architecture
Urban Design
Site Planning
Recreation and Park Planning
Project Management

319 McRae Avenue, Suite 502, Ottawa, Ontario, K1Z 0B9
Tel: (613) 729-4536

- All measurements in millimeters unless specified otherwise. Do not scale drawing. All drawings to be read in conjunction with written specifications.
- Copyright reserved. This drawing is the exclusive property of CSW Landscape Architects Ltd. and shall not be used without the consent thereof.
- This Drawing may not be used for construction until signed by the landscape architect. It is the responsibility of the contractor to:
 - check and verify all dimensions on site;
 - report all errors and/or omissions to the landscape architect;
 - comply with all pertinent codes and by-laws;
 - check and verify locations of all underground services with all local utilities prior to any digging.

Project: **MERIDIAN AT CENTREPOINTE**
NEPEAN, OTTAWA, ONTARIO

Drawing: **LANDSCAPE REMOVALS**

Scale: 1:100	Date: JANUARY 2019
Design By: SE	Drawn By: SE
Project Number: 2005-01	Sheet Number: L 1.0

Last Save: 2020/01/09 09:41 AM
 File Location: C:\Projects\2005-01-The Meridian\Drawings\TENDER\DOC\2005-01-The Meridian_Landscape Plan_Removals.dwg