


SIGN OFF REQUIRED

X

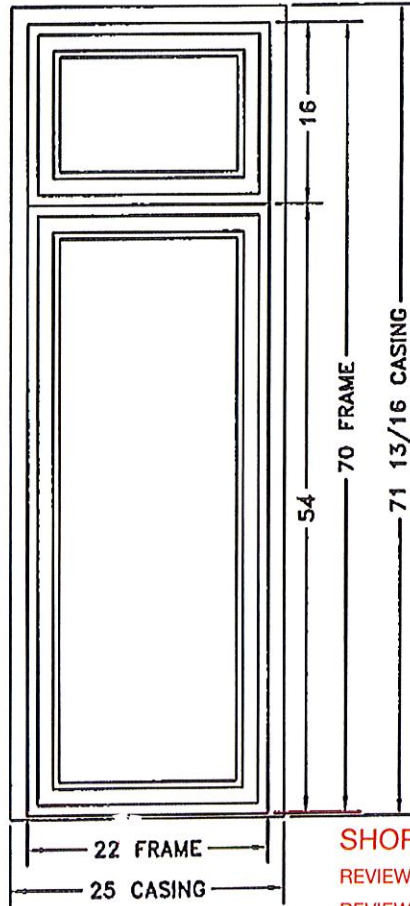

SHOP DRAWING REVIEW

- REVIEWED
- REVIEWED AS NOTED
- REVISE AND RESUBMIT



NOTES FOR PART 2 OF 2:
 DIMENSIONS TO BE CONFIRMED BY GENERAL CONTRACTOR.
 REFER TO NOTES ON PART 1 OF 2.

"This review is for the sole purpose of ascertaining conformance with the general design concept for architectural features only, and does not in any way constitute review of the design of engineering elements which form part of the Contract Documents prepared by others. This review shall not mean that the Architect approves the detail design inherent in the shop drawings. This responsibility shall remain with the Contractor submitting same, and such review shall not relieve the Contractor of his responsibility for errors or omissions in the shop drawings or of his responsibility for meeting all requirements of the Contract Documents. The Contractor is responsible for dimensions to be confirmed and correlated at the job site, for information that pertains solely to fabrication processes, or to techniques of construction and installation and for co-ordination for the work of all trades."

✓ Received : June 17/19
 ✓ Reviewed by FB(TBL)-June 18/19
 * REVISE ALL WINDOW DIMENSIONS AS NOTED ON PART 1 OF 2 SHOP DRAWINGS.

By: Bryan Bonell Date: July 3, 2019


HOBIN ARCHITECTURE INCORPORATED

SPECS:
 SITELINE CLAD CASEMENT
 LINES 1 & 2 - W37 & 37B

JELD-WEN. WINDOWS & DOORS		DATE	REVISION	BY:
PREMIUM CATALOG-HAWKINS		---	---	---
DEALER NAME:		---	---	---
JELD-WEN OF CANADA		---	---	---
DRAWING NO:	DATE	DRAWN FOR		SCALE
CPZ00351	06/13/19	JAIME		3/4" = 1'
DRAWINGS AND ILLUSTRATIONS ARE PROVIDED FOR REFERENCE ONLY. PRODUCT IS MANUFACTURED AS SPECIFIED BY THE CUSTOMER PURCHASE ORDER. APPROVED MODIFICATIONS OR USAGE APPLICATIONS MUST ALSO BE NOTED ON THE PURCHASE ORDER. IT IS THE PURCHASER'S RESPONSIBILITY TO VERIFY THAT ALL ITEMS SPECIFIED ON THE ORDER ARE CORRECT.				

SIGN OFF REQUIRED


X _____

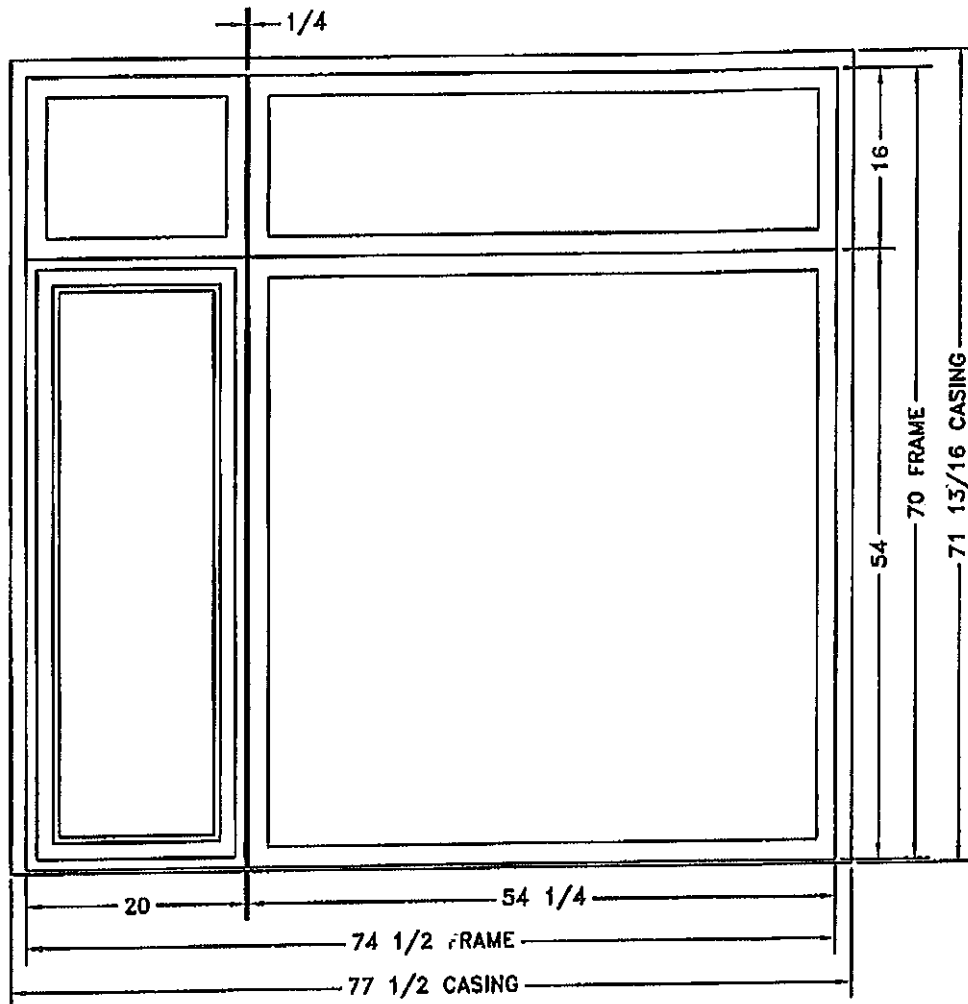

SPECS:
 SITELINE CLAD CASEMENT
 SITELINE CLAD DIRECT SET RECTANGLE
 VERTICAL STRUCTURAL MULL (1/4" WIDE)
 LINE 3 - W38

JELD-WEN. WINDOWS & DOORS		DATE:	REVISION:	BY:
PREMIUM CATALOG-HAWKINS		---	---	---
ORDER NAME: JELD-WEN OF CANADA		---	---	---
DRAWING NO: CPZ00352	DATE: 06/13/19	DRAWN FOR: JAIME	SCALE: 3/4" = 1'	
DRAWINGS AND ILLUSTRATIONS ARE PROVIDED FOR REFERENCE ONLY. PRODUCT IS MANUFACTURED AS SPECIFIED BY THE CUSTOMER PURCHASE ORDER. APPROVED MODIFICATIONS OR UNUSUAL APPLICATIONS MUST ALSO BE NOTED ON THE PURCHASE ORDER. IT IS THE PURCHASER'S RESPONSIBILITY TO VERIFY THAT ALL ITEMS SPECIFIED ON THE ORDER ARE CORRECT.				

SIGN OFF REQUIRED
X

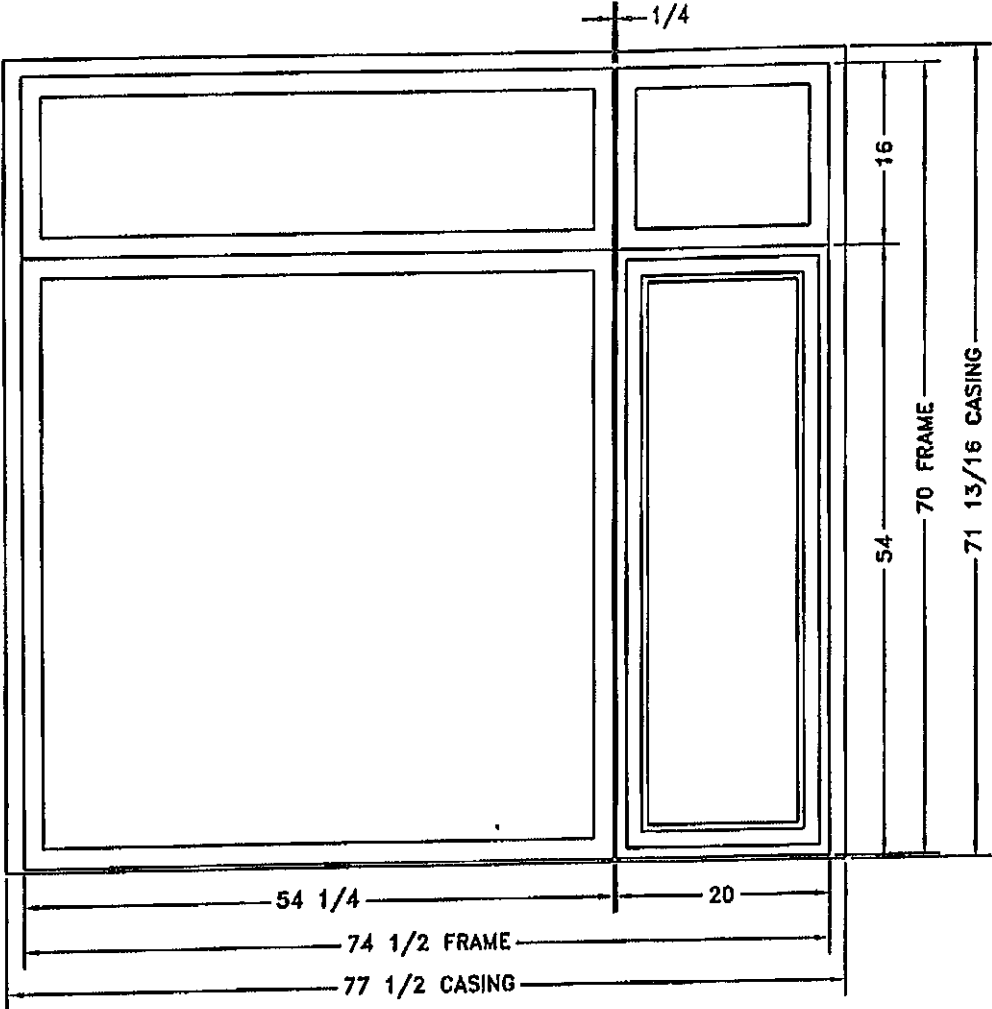


SPECS:
 SITELINE CLAD CASEMENT
 SITELINE CLAD DIRECT SET RECTANGLE
 VERTICAL STRUCTURAL MULL (1/4" WIDE)
 LINE 4 - W38R

JELD-WEN. WINDOWS & DOORS PREMIUM CATALOG-HAWKINS		DATE	REVISION	BY
		---	---	---
DEALER NAME:		---	---	---
JELD-WEN OF CANADA		---	---	---
DRAWING NO:	DATE	DRAWN FOR	SCALE	
CPZ00353	06/13/19	JAIME	3/4" = 1'	
<small> DRAWINGS AND ILLUSTRATIONS ARE PROVIDED FOR REFERENCE ONLY. PRODUCT IS MANUFACTURED AS SPECIFIED BY THE CUSTOMER PURCHASE ORDER. APPROVED MODIFICATIONS OR UNUSUAL APPLICATIONS MUST ALSO BE NOTED ON THE PURCHASE ORDER. IT IS THE PURCHASER'S RESPONSIBILITY TO VERIFY THAT ALL ITEMS SPECIFIED ON THE ORDER ARE CORRECT. </small>				

SIGN OFF REQUIRED

X _____

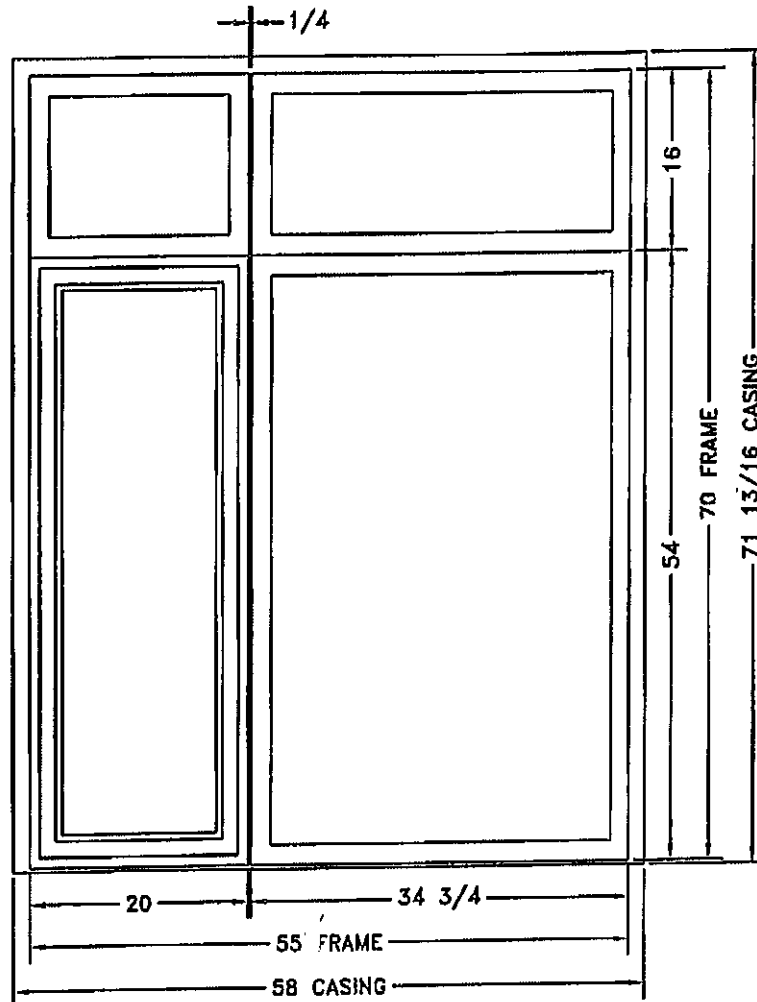


SPECS:
 SITELINE CLAD CASEMENT
 SITELINE CLAD DIRECT SET RECTANGLE
 VERTICAL STRUCTURAL MULL (1/4" WIDE)
 LINE 5 - W39

JELD-WEN. WINDOWS & DOORS		DATE:	REVISION:	BY:
PREMIUM CATALOG-HAWKINS		---	---	---
ORDER NO.:		---	---	---
JELD-WEN OF CANADA		---	---	---
DRAWING NO.:	DATE:	DRAWN FOR:	SCALE:	
CPZ00354	06/13/19	JAIME	3/4" = 1'	
DRAWINGS AND ILLUSTRATIONS ARE PROVIDED FOR REFERENCE ONLY. PRODUCT IS MANUFACTURED AS SPECIFIED BY THE CUSTOMER PURCHASE ORDER. APPROVED MODIFICATIONS OR USAGE APPLICATIONS MUST ALSO BE NOTED ON THE PURCHASE ORDER. IT IS THE PURCHASER'S RESPONSIBILITY TO VERIFY THAT ALL ITEMS SPECIFIED ON THE ORDER ARE CORRECT.				

SIGN OFF REQUIRED

X _____

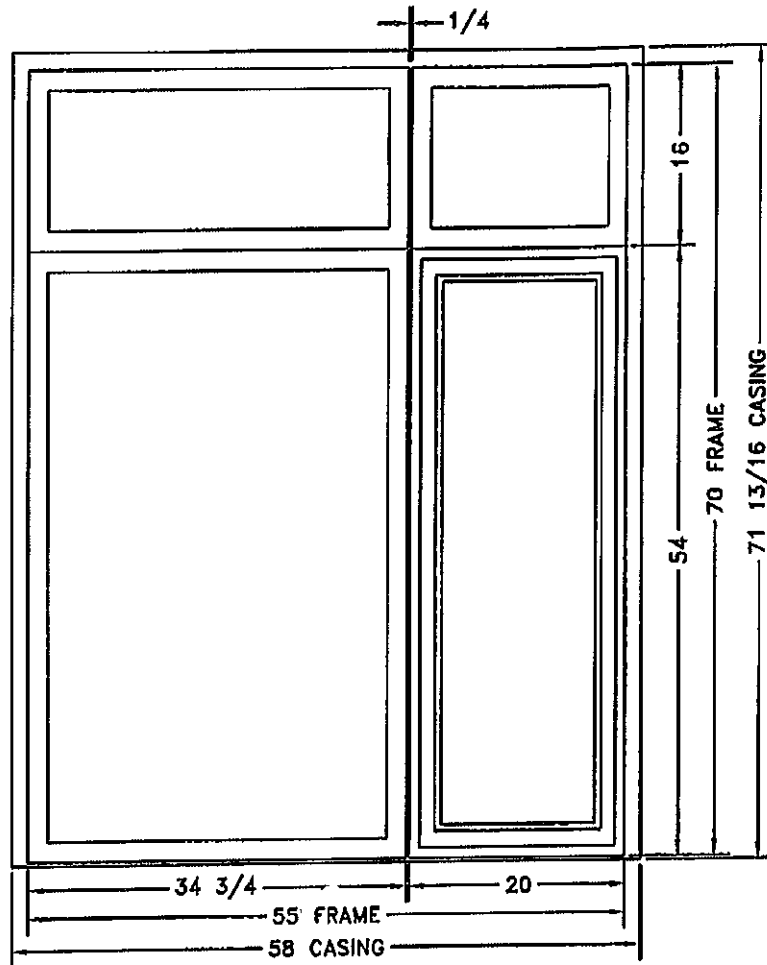


SPECS:
 SITELINE CLAD CASEMENT
 SITELINE CLAD DIRECT SET RECTANGLE
 VERTICAL STRUCTURAL MULL (1/4" WIDE)
 LINE 6 - W39R

JELD-WEN. WINDOWS & DOORS		DATE:	REVISION:	BY:
PREMIUM CATALOG-HAWKINS		---	---	---
DEALER NAME:		---	---	---
JELD-WEN OF CANADA		---	---	---
DRAWING NO:	DATE:	DRAWN FOR:	SCALE:	
CPZ00355	06/13/19	JAIME	3/4" = 1'	
<small>DRAWINGS AND ILLUSTRATIONS ARE PROVIDED FOR REFERENCE ONLY. PRODUCT IS MANUFACTURED AS SPECIFIED BY THE CUSTOMER PURCHASE ORDER. APPROVED MODIFICATIONS OR WAIVER APPLICATIONS MUST ALSO BE NOTED ON THE PURCHASE ORDER. IT IS THE PURCHASER'S RESPONSIBILITY TO VERIFY THAT ALL TERMS SPECIFIED ON THE ORDER ARE CORRECT.</small>				

SIGN OFF REQUIRED

X _____

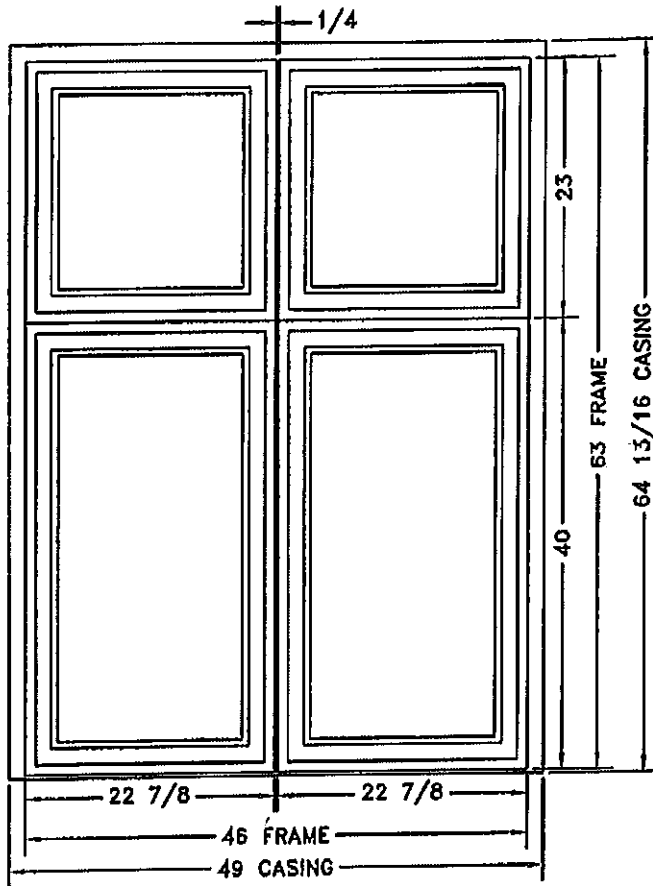


SPECS:
 SITELINE CLAD CASEMENT
 VERTICAL STRUCTURAL MULL (1/4" WIDE)
 LINE 7 - W40

JELD-WEN. WINDOWS & DOORS		DATE:	REVISION:	BY:
PREMIUM CATALOG-HAWKINS		---	---	---
DEALER NAME: JELD-WEN OF CANADA		---	---	---
DRAWING NO: CPZ00356	DATE: 06/13/19	DRAWN FOR: JAIME	SCALE: 3/4" = 1'	
<small>DRAWINGS AND ILLUSTRATIONS ARE PROVIDED FOR REFERENCE ONLY. PRODUCT IS MANUFACTURED AS SPECIFIED BY THE CUSTOMER PURCHASE ORDER. APPROVED MODIFICATIONS OR OTHER APPLICABLES MUST ALSO BE NOTED ON THE PURCHASE ORDER. IT IS THE PURCHASER'S RESPONSIBILITY TO VERIFY THAT ALL ITEMS SPECIFIED ON THE ORDER ARE CORRECT.</small>				

SIGN OFF REQUIRED


X _____

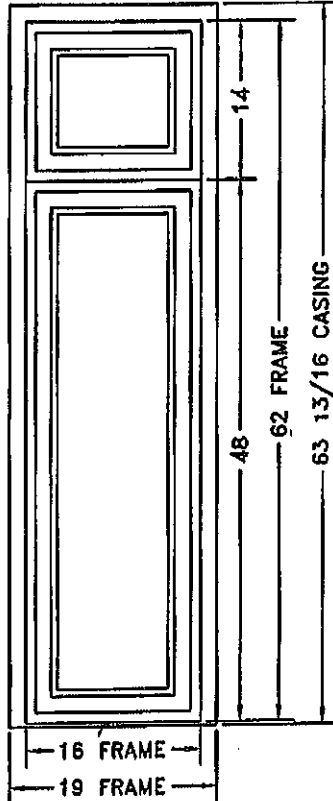

SPECS:
 SITELINE CLAD CASEMENT
 LINE 8 - W41

JELD-WEN. WINDOWS & DOORS		DATE:	REVISION:	BY:
PREMIUM CATALOG-HAWKINS		---	---	---
DEALER NAME:		---	---	---
JELD-WEN OF CANADA		---	---	---
DRAWING NO.:	DATE:	DRAWN FOR:	SCALE:	
CPZ00357	06/13/19	JAIME	3/4" = 1'	
<small> DRAWINGS AND ILLUSTRATIONS ARE PROVIDED FOR REFERENCE ONLY. PRODUCT IS MANUFACTURED AS SPECIFIED BY THE CUSTOMER PURCHASE ORDER. APPROVED MODIFICATIONS OR UNUSUAL APPLICATIONS MUST ALSO BE NOTED ON THE PURCHASE ORDER. IT IS THE PURCHASER'S RESPONSIBILITY TO VERIFY THAT ALL ITEMS SPECIFIED ON THE ORDER ARE CORRECT. </small>				


SIGN OFF REQUIRED
 X _____

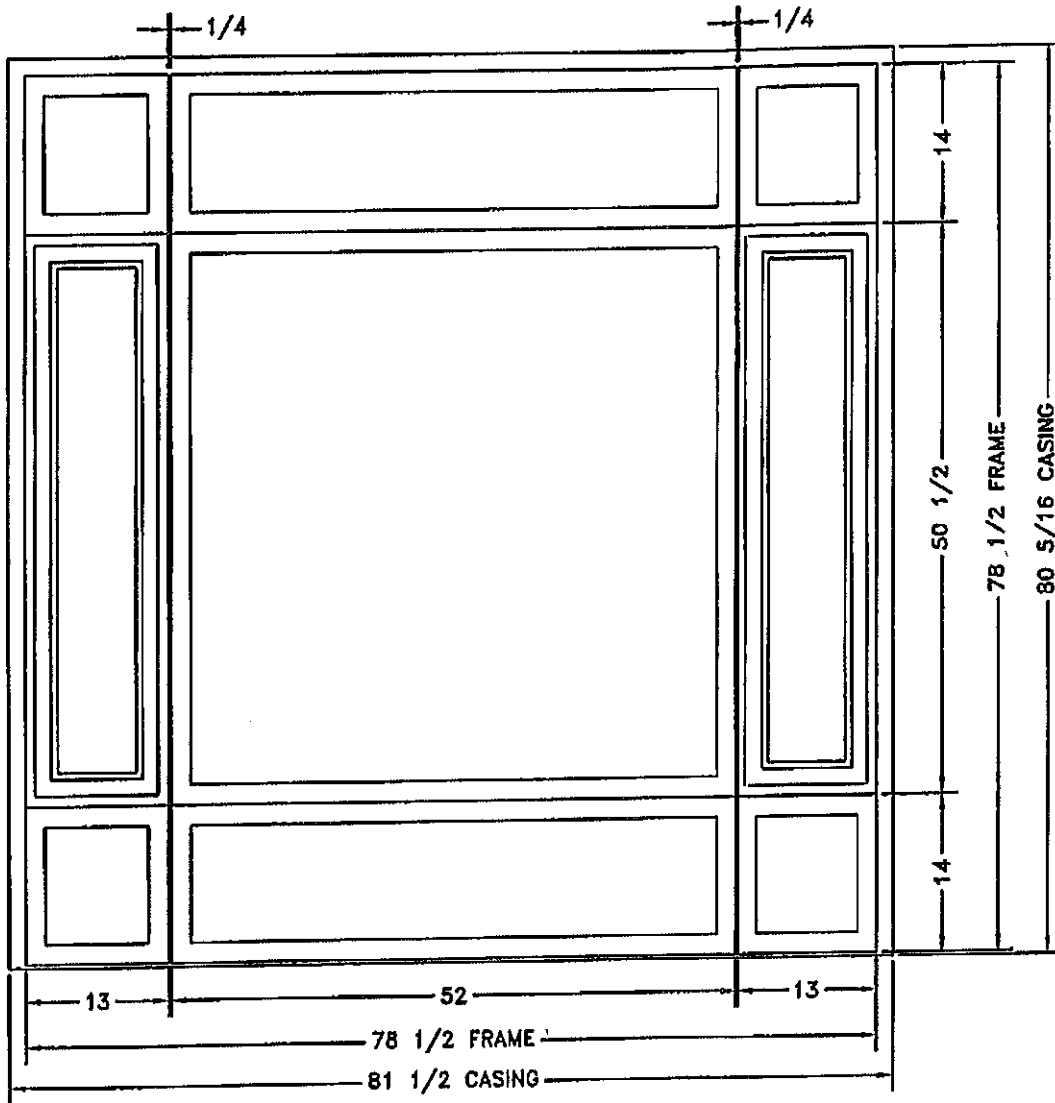

SPECS:
 SITELINE CLAD CASEMENT
 SITELINE CLAD DIRECT SET RECTANGLE
 2 VERTICAL STRUCTURAL MULLS (1/4" WIDE)
 LINE 9 - W42

JELD-WEN. WINDOWS & DOORS		DATE:	REVISION:	BY:
PREMIUM CATALOG-HAWKINS		---	---	---
DEALER NAME: JELD-WEN OF CANADA		---	---	---
DRAWING NO: CPZ00358	DATE: 08/14/19	DRAWN FOR: JAIME		SCALE: 3/4" = 1'
<small>DRAWINGS AND ILLUSTRATIONS ARE PROVIDED FOR REFERENCE ONLY. PRODUCT IS MANUFACTURED AS SPECIFIED BY THE CUSTOMER PURCHASE ORDER. APPROVED MODIFICATIONS OR USAGE APPLICATIONS MUST ALSO BE NOTED ON THE PURCHASE ORDER. IT IS THE PURCHASER'S RESPONSIBILITY TO VERIFY THAT ALL ITEMS SPECIFIED ON THE ORDER ARE CORRECT.</small>				

SIGN OFF REQUIRED
 X

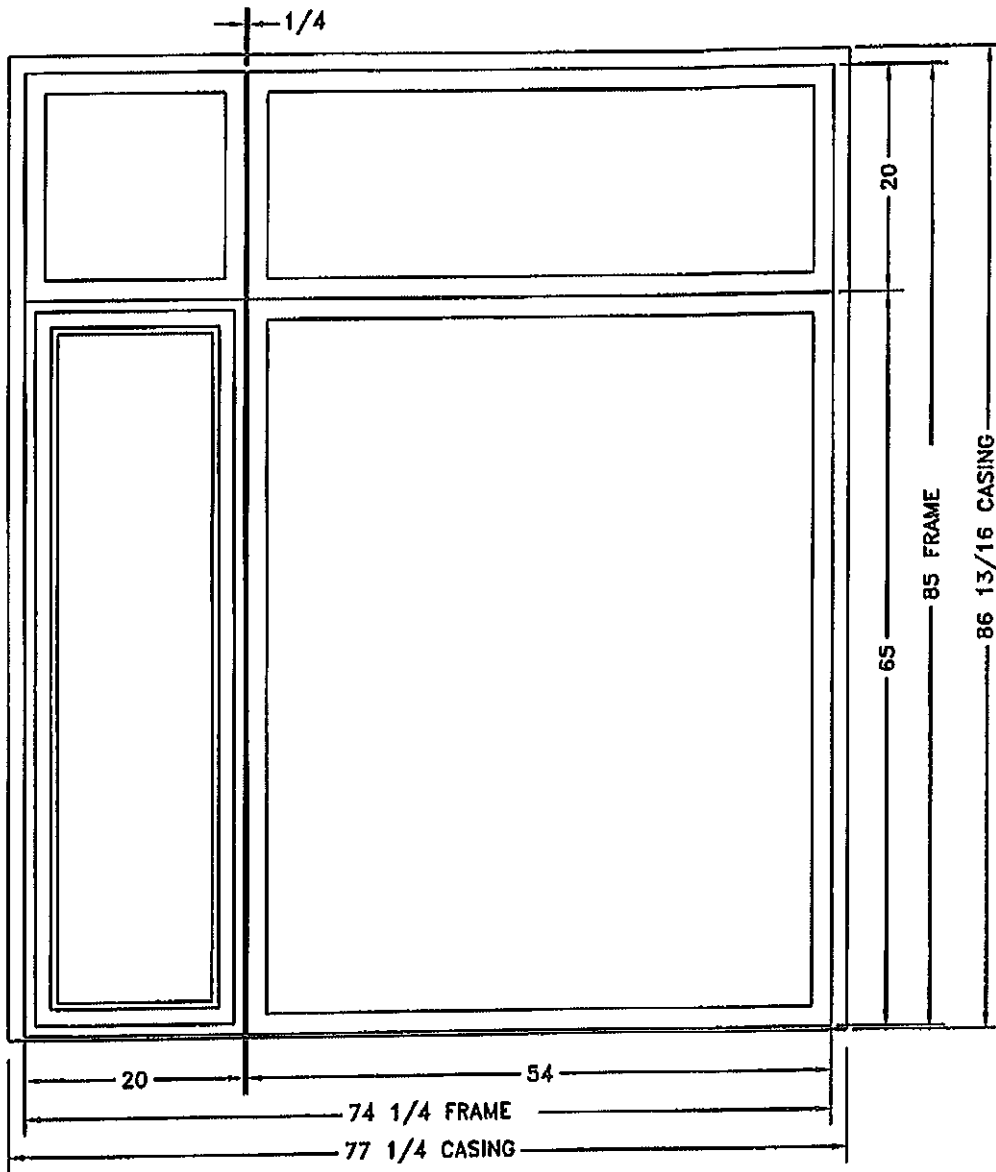


SPECS:
 SITELINE CLAD CASEMENT
 SITELINE CLAD DIRECT SET RECTANGLE
 VERTICAL STRUCTURAL MULL (1/4" WIDE)
 LINE 10 - W43

JELD-WEN. WINDOWS & DOORS		DATE	REVISION	BY
PREMIUM CATALOG-HAWKINS		---	---	---
DEALER NAME		---	---	---
JELD-WEN OF CANADA		---	---	---
DRAWING NO.	DATE	DRAWN FOR	SCALE	
CPZ00359	06/14/19	JAIME	3/4" = 1'	
DRAWINGS AND ILLUSTRATIONS ARE PROVIDED FOR REFERENCE ONLY. PRODUCT IS MANUFACTURED AS SPECIFIED BY THE CUSTOMER PURCHASE ORDER. APPROVED MODIFICATIONS OR USAGE APPLICATIONS MUST ALSO BE NOTED ON THE PURCHASE ORDER. IT IS THE PURCHASER'S RESPONSIBILITY TO VERIFY THAT ALL ITEMS SPECIFIED ON THE ORDER ARE CORRECT.				

SIGN OFF REQUIRED

X _____

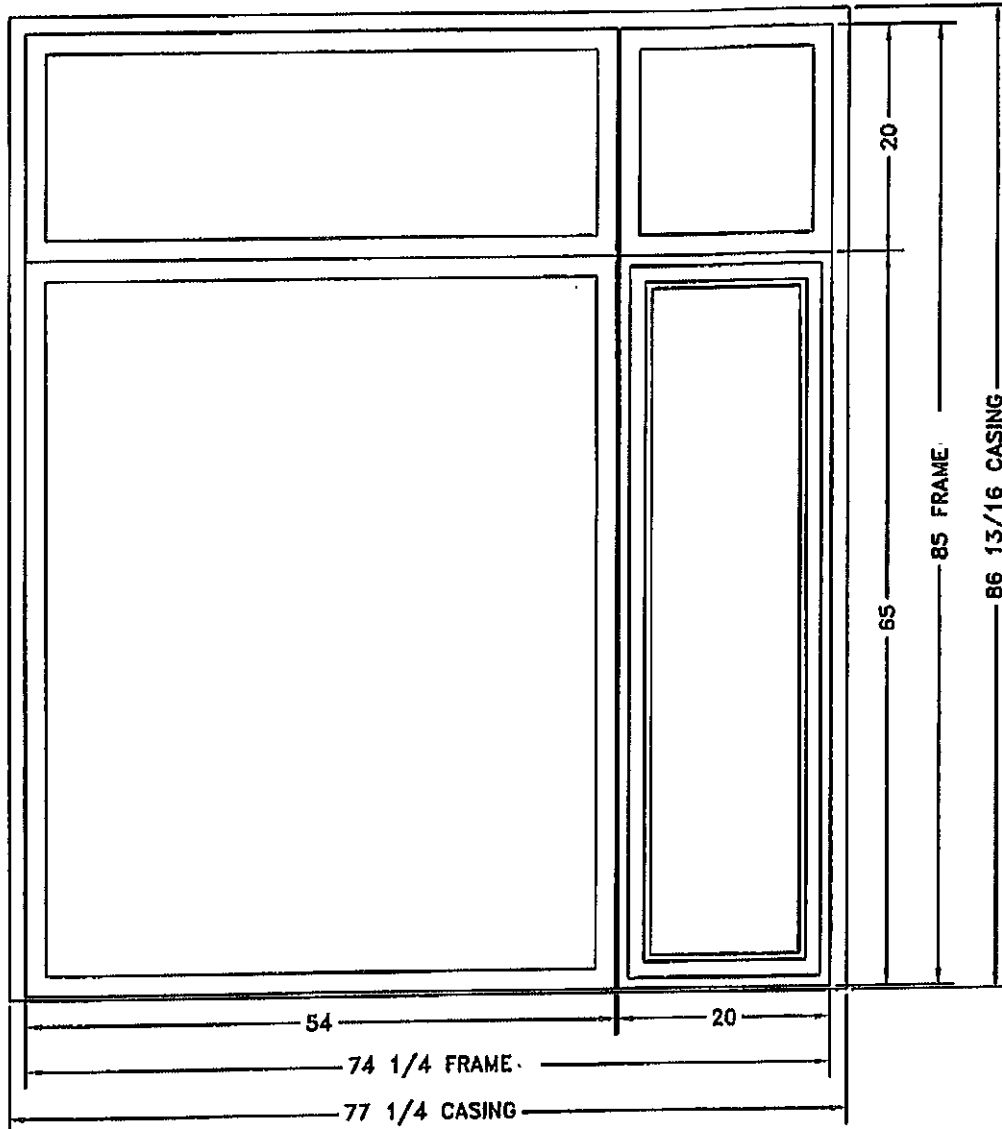


SPECS:
 SITELINE CLAD CASEMENT
 SITELINE CLAD DIRECT SET RECTANGLE
 VERTICAL STRUCTURAL MULL (1/4" WIDE)
 LINE 11 - W43R

JELD-WEN. WINDOWS & DOORS		DATE:	REVISION:	BY:
PREMIUM CATALOG-HAWKINS		---	---	---
DEALER NAME: JELD-WEN OF CANADA		---	---	---
DRAWING NO: CPZ00360	DATE: 06/14/19	DRAWN FOR: JAIME		SCALE: 3/4" = 1'
<small> DRAWINGS AND ILLUSTRATIONS ARE PROVIDED FOR REFERENCE ONLY. PRODUCT IS MANUFACTURED AS SPECIFIED BY THE CUSTOMER PURCHASE ORDER. APPROVED MODIFICATIONS OR USAGE APPLICATIONS MUST ALSO BE NOTED ON THE PURCHASE ORDER. IT IS THE PURCHASER'S RESPONSIBILITY TO VERIFY THAT ALL ITEMS SPECIFIED ON THE ORDER ARE CORRECT. </small>				

SIGN OFF REQUIRED

X _____

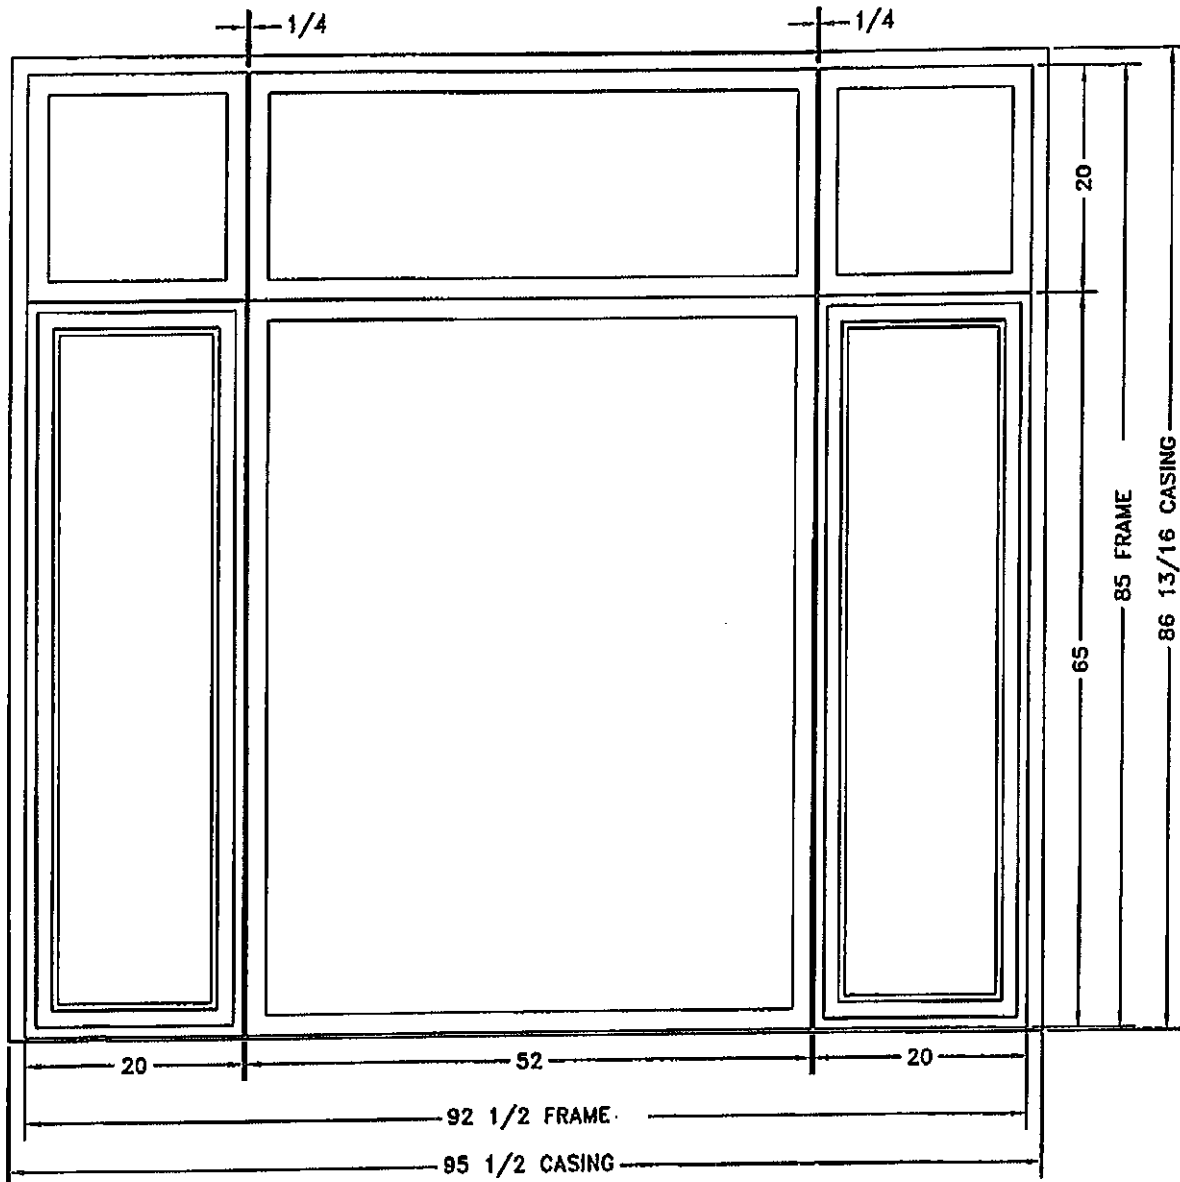


SPECS:

SITELINE CLAD CASEMENT
 SITELINE CLAD DIRECT SET RECTANGLE
 2 VERTICAL STRUCTURAL MULLS (1/4" WIDE)
 LINE 12 - W44

JELD-WEN. WINDOWS & DOORS PREMIUM CATALOG-HAWKINS		DATE:	REVISION:	BT:
		---	---	---
ORDER NO.:		---	---	---
JELD-WEN OF CANADA		---	---	---
DRAWING NO.:	DATE:	DRAWN FOR:	SCALE:	
CPZ00361	06/14/19	JAIME	3/4" = 1'	
<small>DRAWINGS AND ILLUSTRATIONS ARE PROVIDED FOR REFERENCE ONLY. PRODUCT IS MANUFACTURED AS SPECIFIED BY THE CUSTOMER PURCHASE ORDER. APPROVED MODIFIERS OR LOCAL APPLICATIONS MUST ALSO BE NOTED ON THE PURCHASE ORDER. IT IS THE PURCHASER'S RESPONSIBILITY TO VERIFY THAT ALL ITEMS SPECIFIED ON THE ORDER ARE CORRECT.</small>				

SIGN OFF REQUIRED

X _____

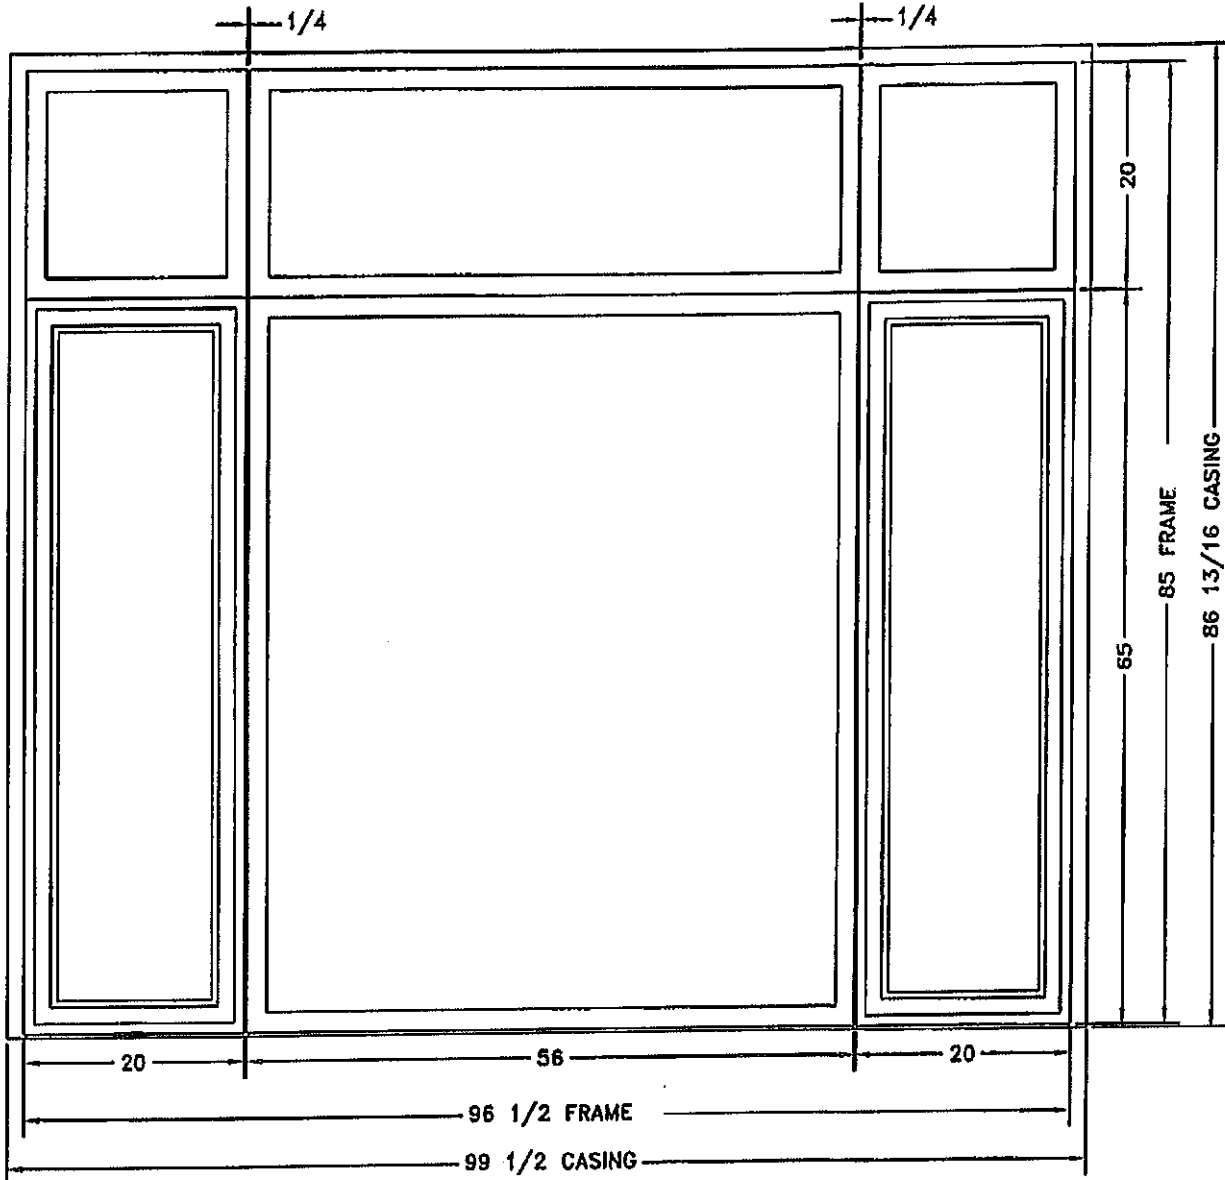


SPECS:

SITELINE CLAD CASEMENT
 SITELINE CLAD DIRECT SET RECTANGLE
 2 VERTICAL STRUCTURAL MULLS (1/4" WIDE)
 LINE 13 - W45

JELD-WEN. WINDOWS & DOORS		DATE:	REVISIONS:	BY:
PREMIUM CATALOG-HAWKINS		---	---	---
DEALER NAME: JELD-WEN OF CANADA		---	---	---
DRAWING NO: CPZ00362	DATE: 06/14/19	DRAWN FOR: JAIME	SCALE: 3/4" = 1'	
DRAWINGS AND ILLUSTRATIONS ARE PROVIDED FOR REFERENCE ONLY. PRODUCT IS MANUFACTURED AS SPECIFIED BY THE DISTRICT PURCHASE ORDER. APPROVED MODIFICATIONS OR UNIQUE APPLICATIONS MUST ALSO BE NOTED ON THE PURCHASE ORDER. IT IS THE PURCHASER'S RESPONSIBILITY TO VERIFY THAT ALL ITEMS SPECIFIED ON THE ORDER ARE CORRECT.				

SIGN OFF REQUIRED

X _____

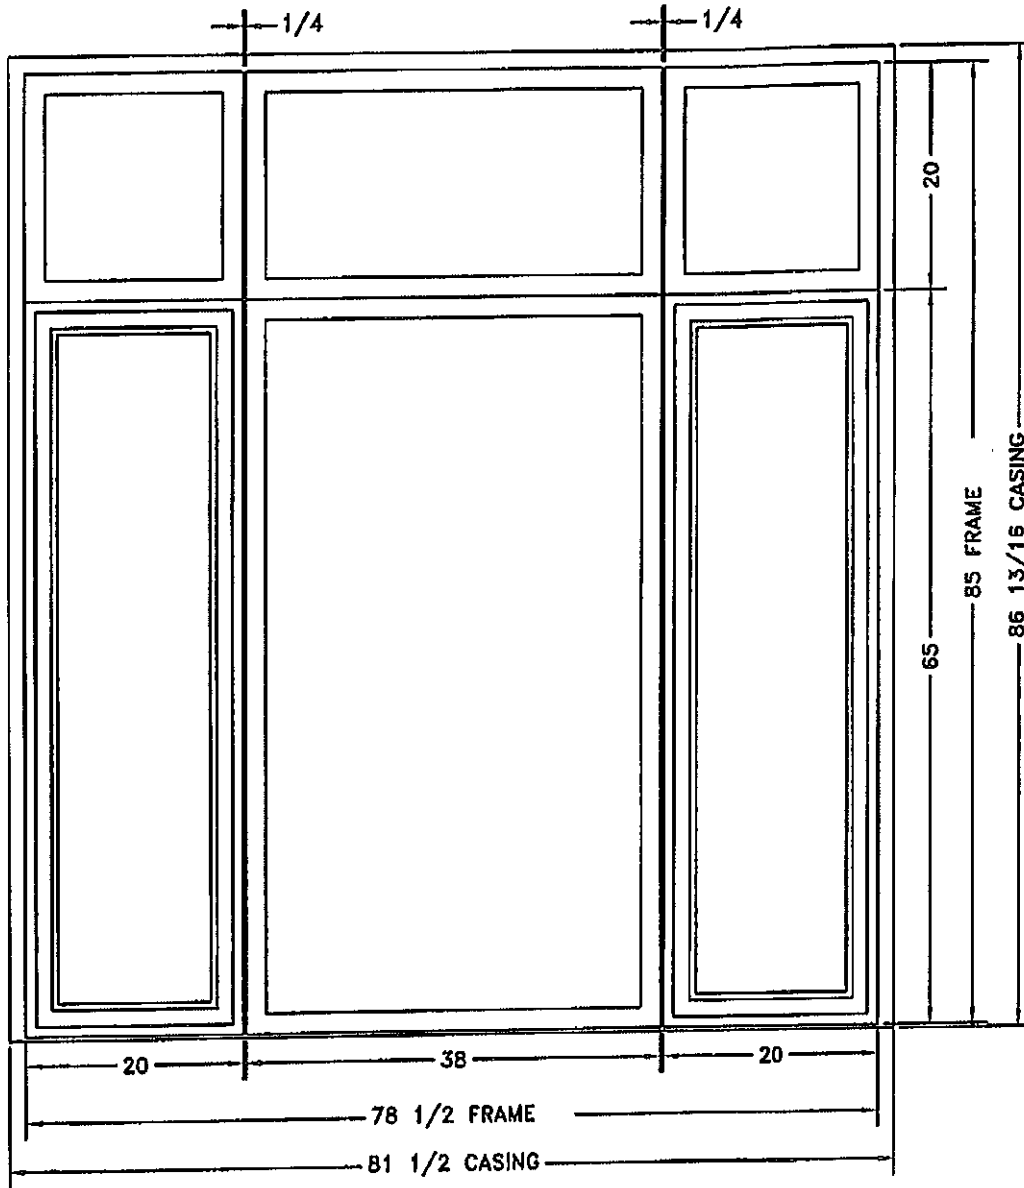

SPECS:

SITELINE CLAD CASEMENT
 SITELINE CLAD DIRECT SET RECTANGLE
 2 VERTICAL STRUCTURAL MULLS (1/4" WIDE)
 LINE 14 - W46

JELD-WEN. WINDOWS & DOORS		DATE:	REVISION:	BY:
PREMIUM CATALOG-HAWKINS		---	---	---
DEALER NAME: JELD-WEN OF CANADA		---	---	---
DRAWING NO: CPZ00363	DATE: 06/14/19	DRAWN FOR: JAIME	SCALE: 3/4" = 1'	
DRAWINGS AND ILLUSTRATIONS ARE PROVIDED FOR REFERENCE ONLY. PRODUCT IS MANUFACTURED AS SPECIFIED BY THE CUSTOMER PURCHASE ORDER. APPROVED MODIFICATIONS OR USAGE APPLICATIONS MUST ALSO BE NOTED ON THE PURCHASE ORDER. IT IS THE PURCHASER'S RESPONSIBILITY TO VERIFY THAT ALL ITEMS SPECIFIED ON THE ORDER ARE CORRECT.				