


For lengths of retaining wall <600mm refer to separate document. "RB-SE-RI 2.4 kPa Surcharge" for walls with <600 mm height difference.

**Wall Reinforcement Layout**

N/A Fence and sono tube.

Applicable for lengths of retaining wall where height difference exceeds 600mm and is less than 750mm.

Coordinate tree relocation with Landscape Architect where interference with geogrid and granular backfill occurs. Verify with civil engineer where site conditions differ from drawings in a manner which would allow retaining wall to be reduced to 600mm.

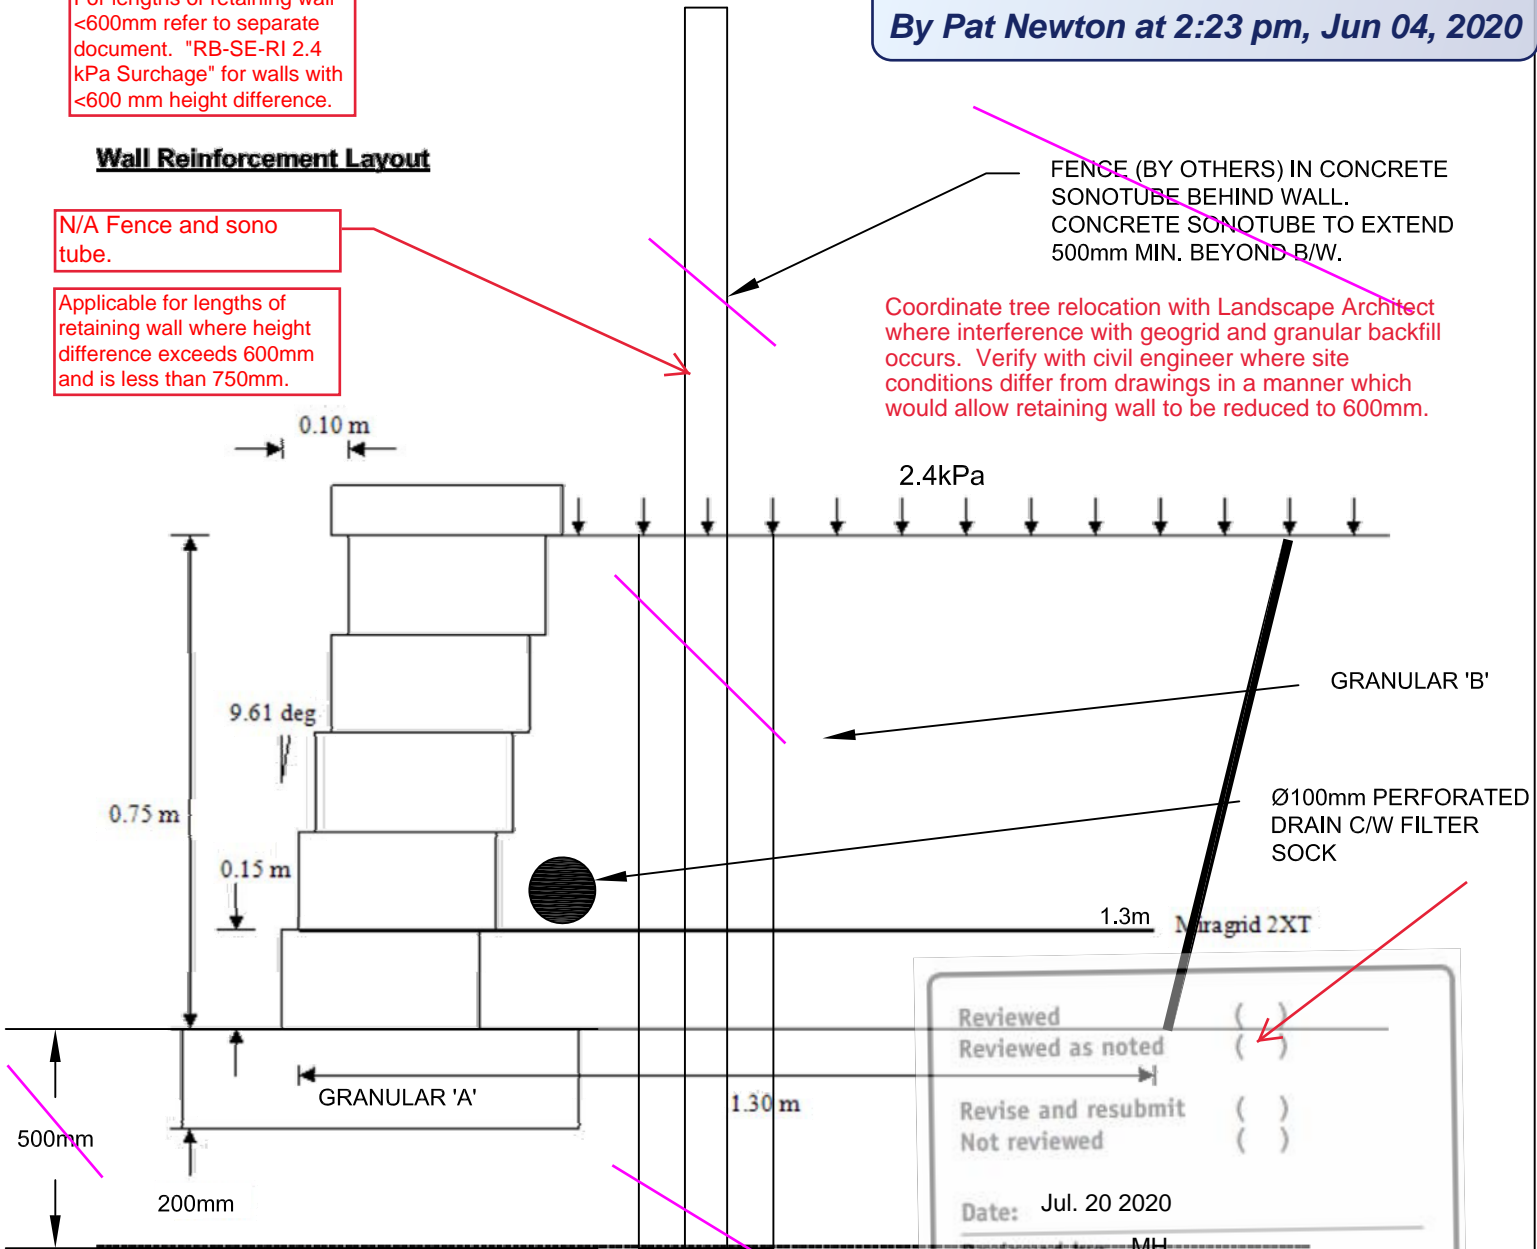

Reviewed	( )
Reviewed as noted	( )
Revise and resubmit	( )
Not reviewed	( )

Date: Jul. 20 2020

Reviewed by: MH

This review by J.C.F.A.Inc. is for the sole purpose of ascertaining conformance with the general design concept for architectural features only, and does not in any way constitute review of the design of engineering elements which form part of the contract documents prepared by others. This review shall not mean that J.C.F.A.Inc. approves the detailed design inherent in the shop drawings, responsibility for which shall remain with the Contractor submitting same, and such review shall not release J.C.F.A.Inc. from liability for errors or omissions in the drawings or of the Contractor in meeting all requirements of the contract documents. J.C.F.A.Inc. is responsible for dimensions to be confirmed and correlated at the job site, for information that pertains solely to fabrication processes or to techniques of construction and installation, and for coordination of the work of all trades.

Jason C. Flynn Arcitect Inc. (J.C.F.A.Inc.)

**Project Identification**

Project ID : ON16420  
 Project Name : Enterprise Holdings  
 Owner :  
 Client :  
 Prepared By : Domenic Di Nino  
 Company : Hanson Hardscapes  
 Address :  
 Telephone :  
 Section : 0.75m  
 Vendor Data File :  
 Project File : RB Wall.prj  
 Date and Time : 06/09/2012 09:24:10

PRELIMINARY DESIGN  
 NOT FOR CONSTRUCTION

**PRELIMINARY DESIGN - NOT FOR CONSTRUCTION**

DATE: 6/3/2020

PAGE: 1 OF 7

RB Wall SYSTEM ESTIMATING SHEET					
JOB NAME	ENTERPRISE HOLDINGS		FACE AREA	11.74m <sup>2</sup>	
ADDRESS	225 HUNTMAR DRIVE OTTAWA, ONTARIO		LENGTH	18.0m	
PROJECT No:	ON16420		MAX. HEIGHT	0.75m	
SCALE = 1:50 (11x17 SHEET)	SOIL PROPERTIES:	UNIT WEIGHT	21kN/m <sup>3</sup>	BATTER	9.6°
		ANGLE OF I.F	34°	SURCHARGE	2.4kPa
				TOE SLOPE	FLAT

NUMBER OF PIECES	
RB Wall	
RB Wall 10" COPING =	0 UNITS
RB Wall 24" COPING =	30 UNITS
RB Wall TAPERED COPING =	--
RB Wall =	392 UNITS
RB Wall Double Sided =	--
RB Wall TAPERED UNIT =	--
2XT = X+X=m <sup>2</sup>	3XT = X+X=9m <sup>2</sup>



DESIGN PROFILE  EXCAVATION GRADES  HANDRAIL  FENCE  TYPE BEHIND/BELOW HEIGHT --

RB WALL 24" COPING = 29.5 UNITS




WALL #

RB WALL STANDARD = 391.5 UNITS



WALL AREA = 11.74m<sup>2</sup>

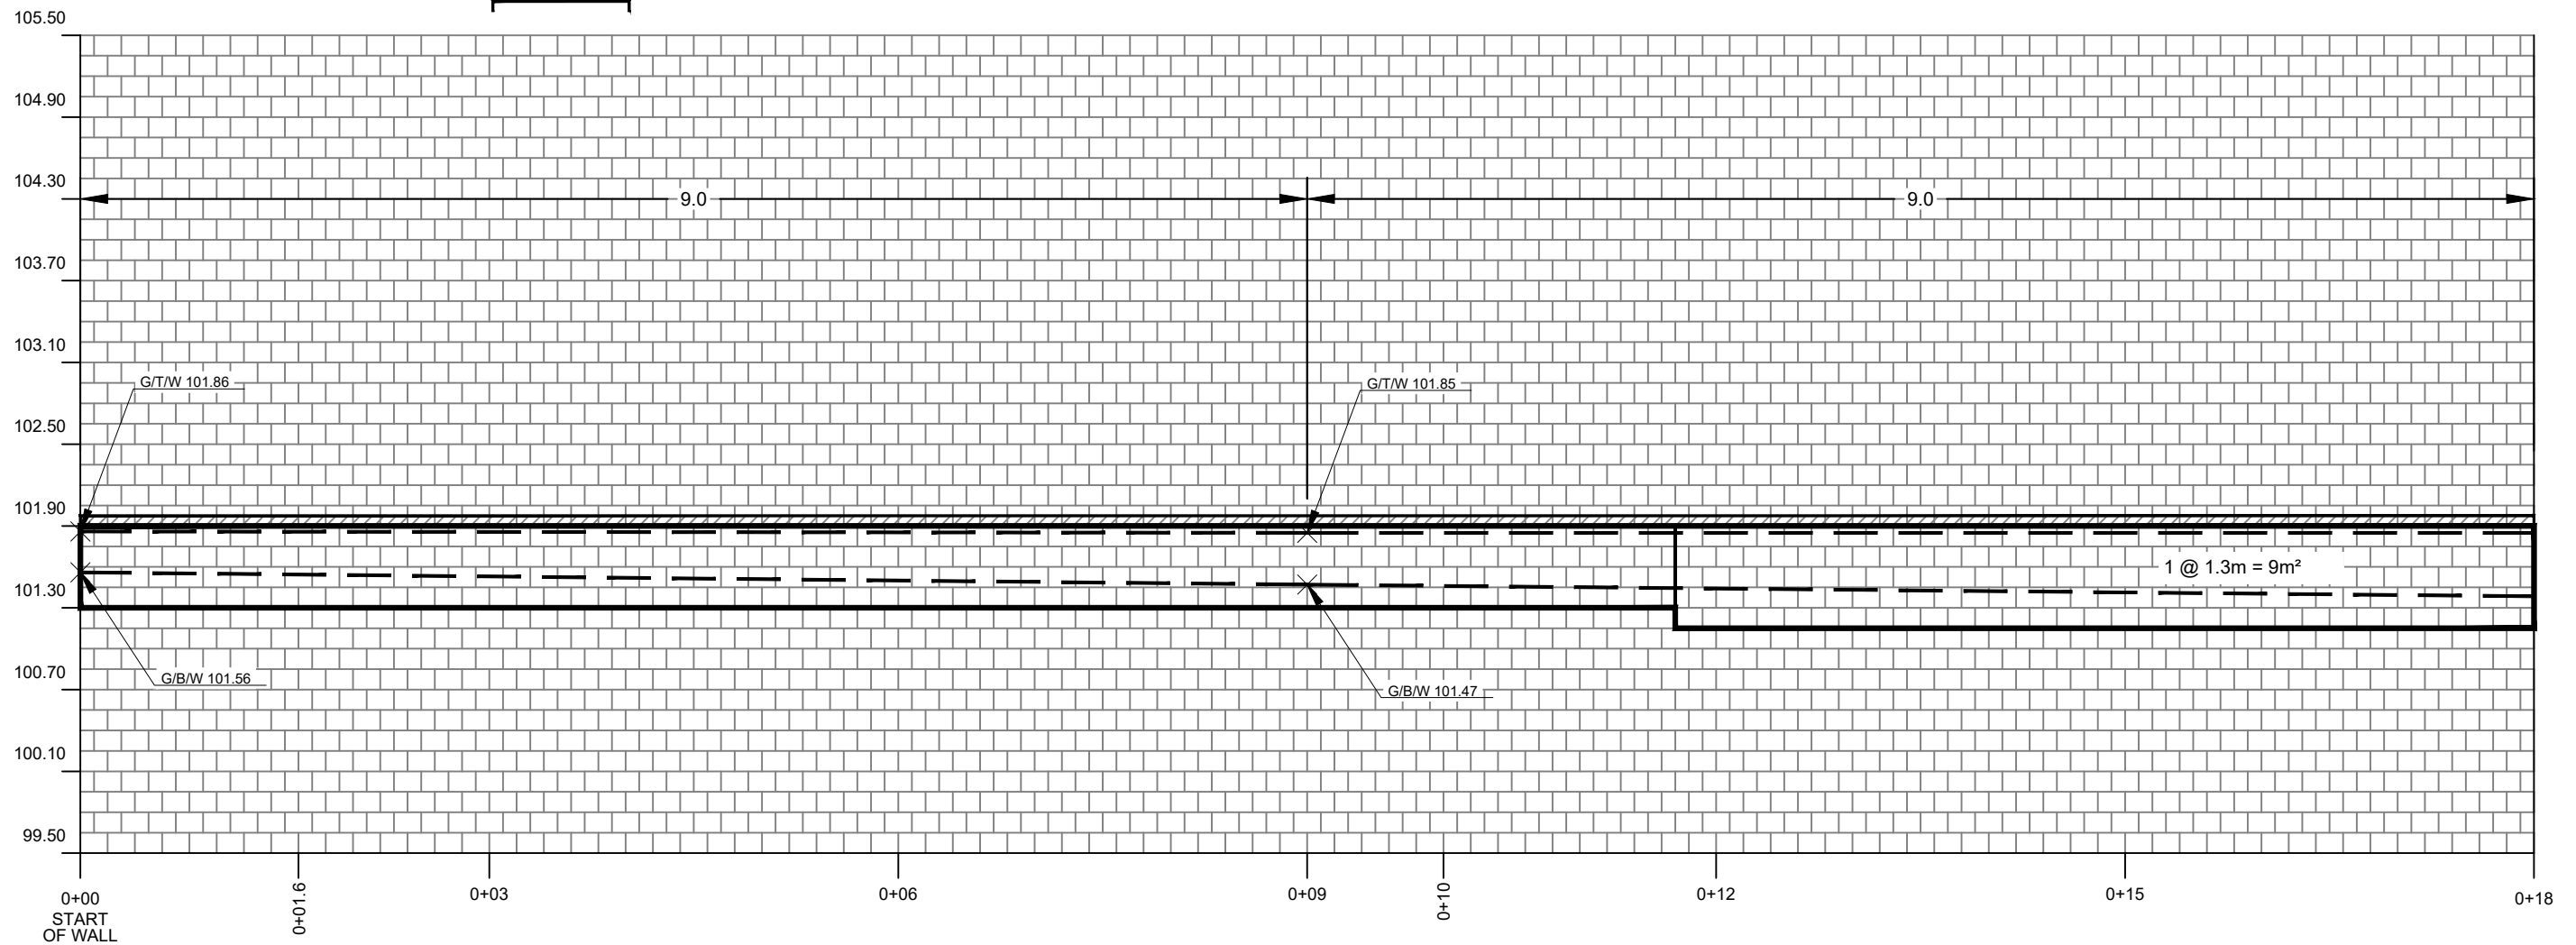

**PRELIMINARY DESIGN - NOT FOR CONSTRUCTION**

DATE: 6/3/2020

PAGE: 2 OF 7

RB Wall SYSTEM ESTIMATING SHEET					
JOB NAME	ENTERPRISE HOLDINGS		FACE AREA	13.50m <sup>2</sup>	
ADDRESS	225 HUNTMAR DRIVE OTTAWA, ONTARIO		LENGTH	18.0m	
PROJECT No:	ON16420		MAX. HEIGHT	0.75m	
SCALE = 1:50 (11x17 SHEET)	SOIL PROPERTIES:	UNIT WEIGHT	21kN/m <sup>3</sup>	BATTER	9.6°
		ANGLE OF I.F	34°	SURCHARGE	2.4kPa
				TOE SLOPE	FLAT

NUMBER OF PIECES	
RB Wall	
RB Wall 10" COPING =	0 UNITS
RB Wall 24" COPING =	30 UNITS
RB Wall TAPERED COPING =	--
RB Wall =	450 UNITS
RB Wall Double Sided =	--
RB Wall TAPERED UNIT =	--
2XT = X+X=m <sup>2</sup>	3XT = X+X=24m <sup>2</sup>




DESIGN PROFILE  EXCAVATION GRADES  HANDRAIL  FENCE  TYPE BEHIND/BELOW HEIGHT --

RB WALL 24" COPING = 29.5 UNITS

WALL #

RB WALL STANDARD = 450.0 UNITS

WALL AREA = 13.50m<sup>2</sup>

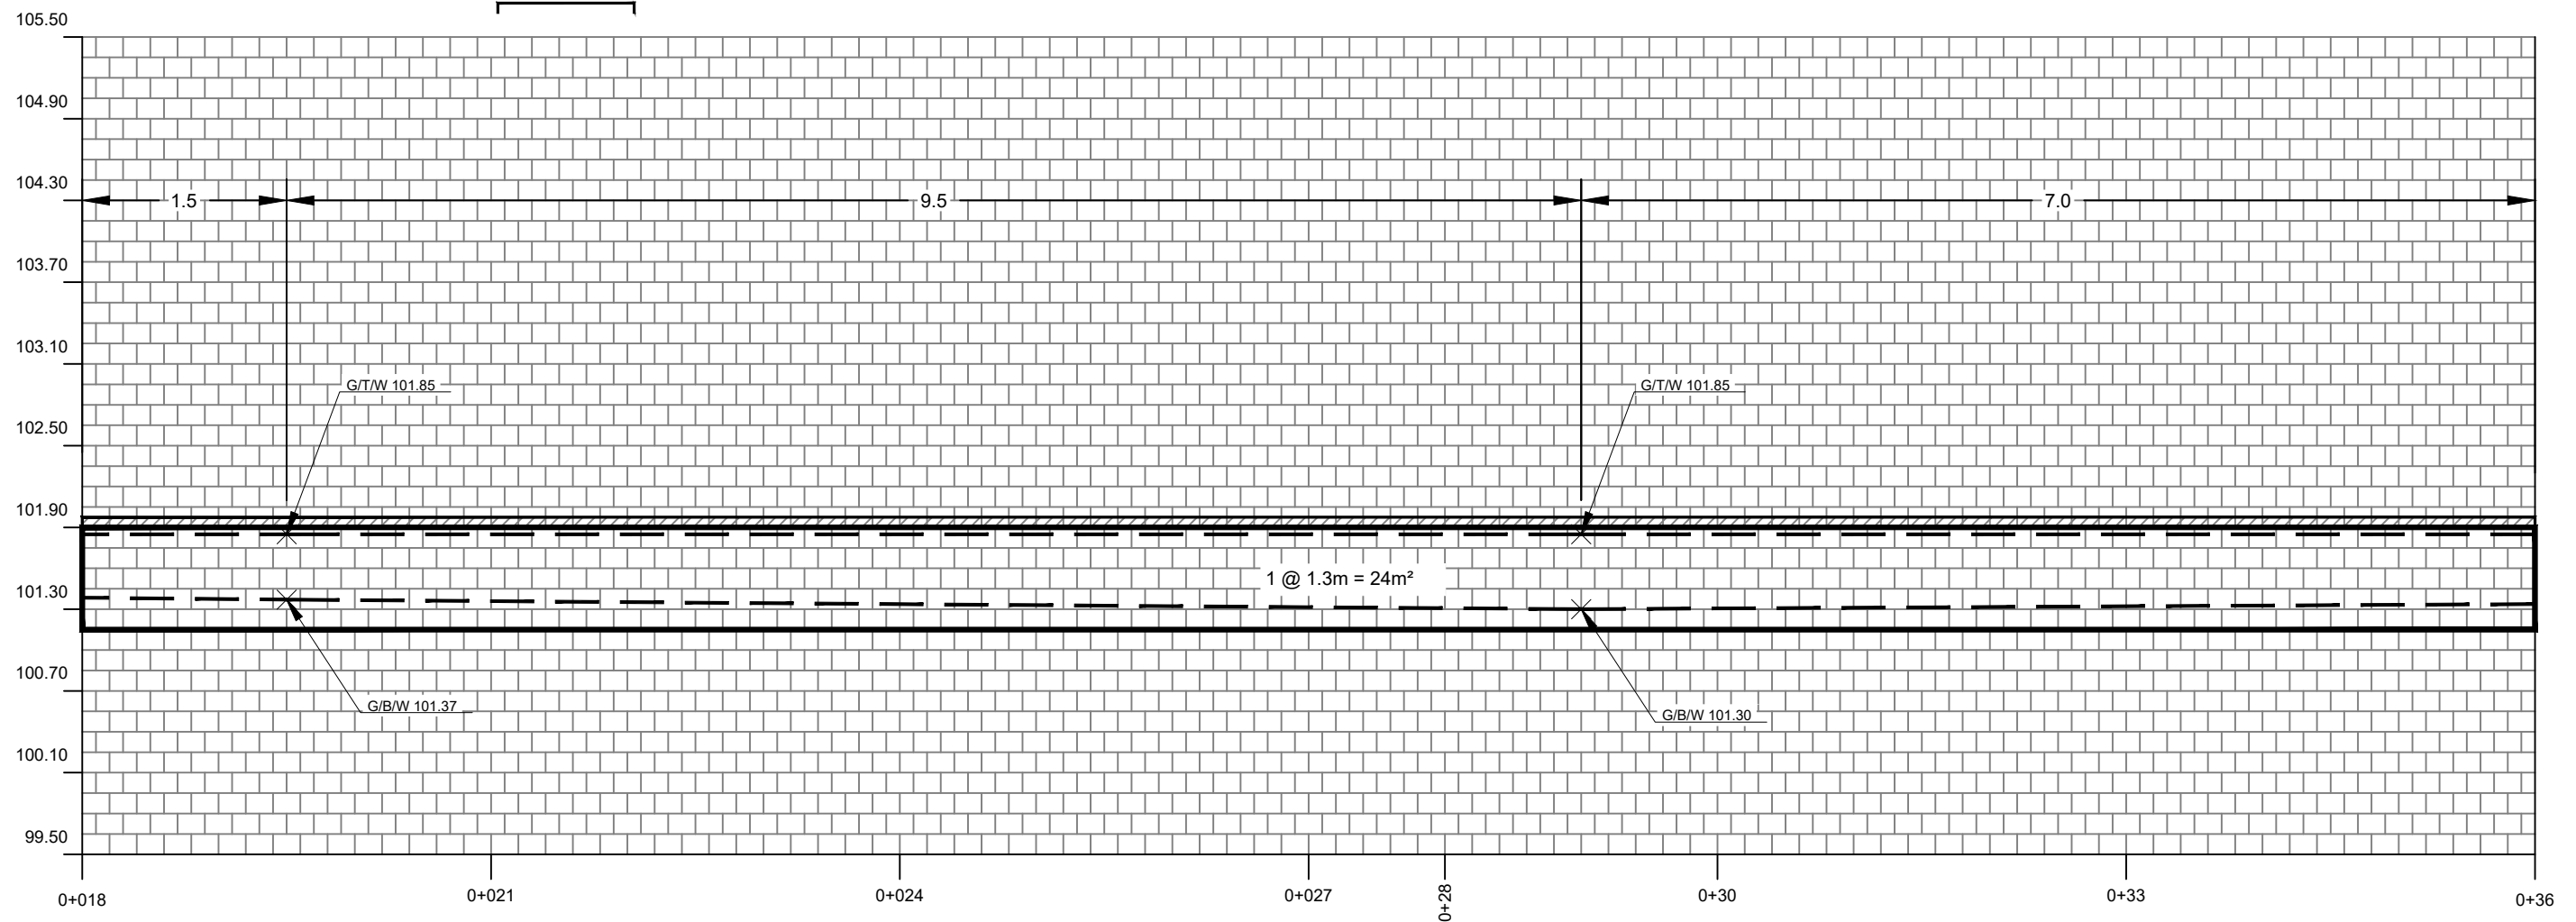

**PRELIMINARY DESIGN - NOT FOR CONSTRUCTION**

DATE: 6/3/2020

PAGE: 3 OF 7

RB Wall SYSTEM ESTIMATING SHEET					
JOB NAME	ENTERPRISE HOLDINGS		FACE AREA	13.50m <sup>2</sup>	
ADDRESS	225 HUNTMAR DRIVE OTTAWA, ONTARIO		LENGTH	18.0m	
PROJECT No:	ON16420		MAX. HEIGHT	0.75m	
SCALE = 1:50 (11x17 SHEET)	SOIL PROPERTIES:	UNIT WEIGHT	21kN/m <sup>3</sup>	BATTER	9.6°
		ANGLE OF I.F	34°	SURCHARGE	2.4kPa
				TOE SLOPE	FLAT

NUMBER OF PIECES	
RB Wall	
RB Wall 10" COPING =	0 UNITS
RB Wall 24" COPING =	30 UNITS
RB Wall TAPERED COPING =	--
RB Wall =	450 UNITS
RB Wall Double Sided =	--
RB Wall TAPERED UNIT =	--
2XT = X+X=m <sup>2</sup>	3XT = X+X=24m <sup>2</sup>



DESIGN PROFILE  EXCAVATION GRADES  HANDRAIL  FENCE  TYPE BEHIND/BELOW HEIGHT --


RB WALL 24" COPING = 29.5 UNITS



WALL #

RB WALL STANDARD = 450.0 UNITS

WALL AREA = 13.50m<sup>2</sup>

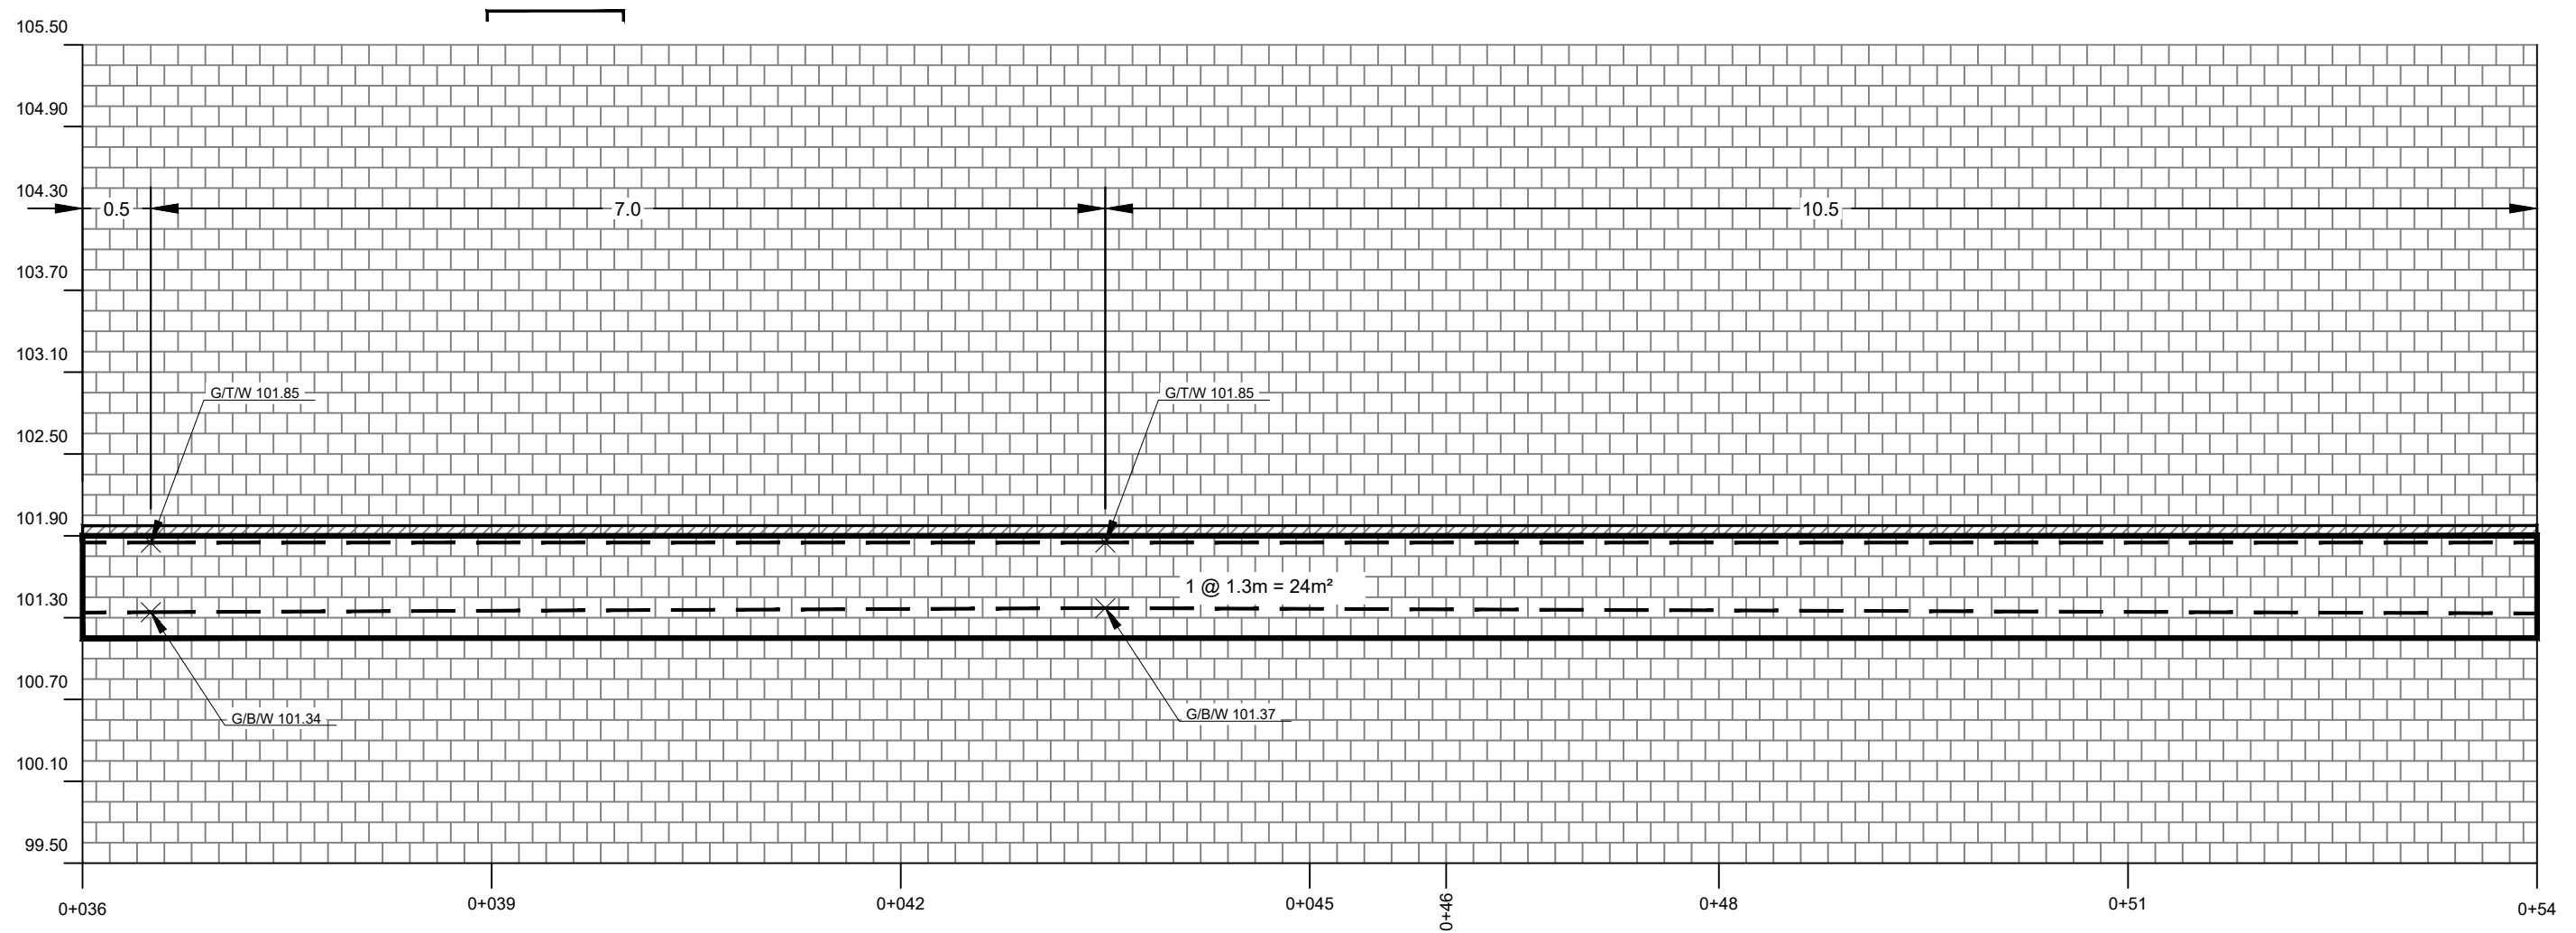

**PRELIMINARY DESIGN - NOT FOR CONSTRUCTION**

DATE: 6/3/2020

PAGE: 4 OF 7

RB Wall SYSTEM ESTIMATING SHEET					
JOB NAME	ENTERPRISE HOLDINGS		FACE AREA	12.95m <sup>2</sup>	
ADDRESS	225 HUNTMAR DRIVE OTTAWA, ONTARIO		LENGTH	18.0m	
PROJECT No:	ON16420		MAX. HEIGHT	0.75m	
SCALE = 1:50 (11x17 SHEET)	SOIL PROPERTIES:	UNIT WEIGHT	21kN/m <sup>3</sup>	BATTER	9.6°
		ANGLE OF I.F	34°	SURCHARGE	2.4kPa
				TOE SLOPE	FLAT

NUMBER OF PIECES	
RB Wall	
RB Wall 10" COPING =	0 UNITS
RB Wall 24" COPING =	30 UNITS
RB Wall TAPERED COPING =	--
RB Wall =	432 UNITS
RB Wall Double Sided =	--
RB Wall TAPERED UNIT =	--
2XT = X+X=m <sup>2</sup>	3XT = X+X=19m <sup>2</sup>



DESIGN PROFILE  EXCAVATION GRADES  HANDRAIL  FENCE  TYPE BEHIND/BELOW HEIGHT --


RB WALL 24" COPING = 29.5 UNITS



WALL #

RB WALL STANDARD = 431.5 UNITS

WALL AREA = 12.95m<sup>2</sup>

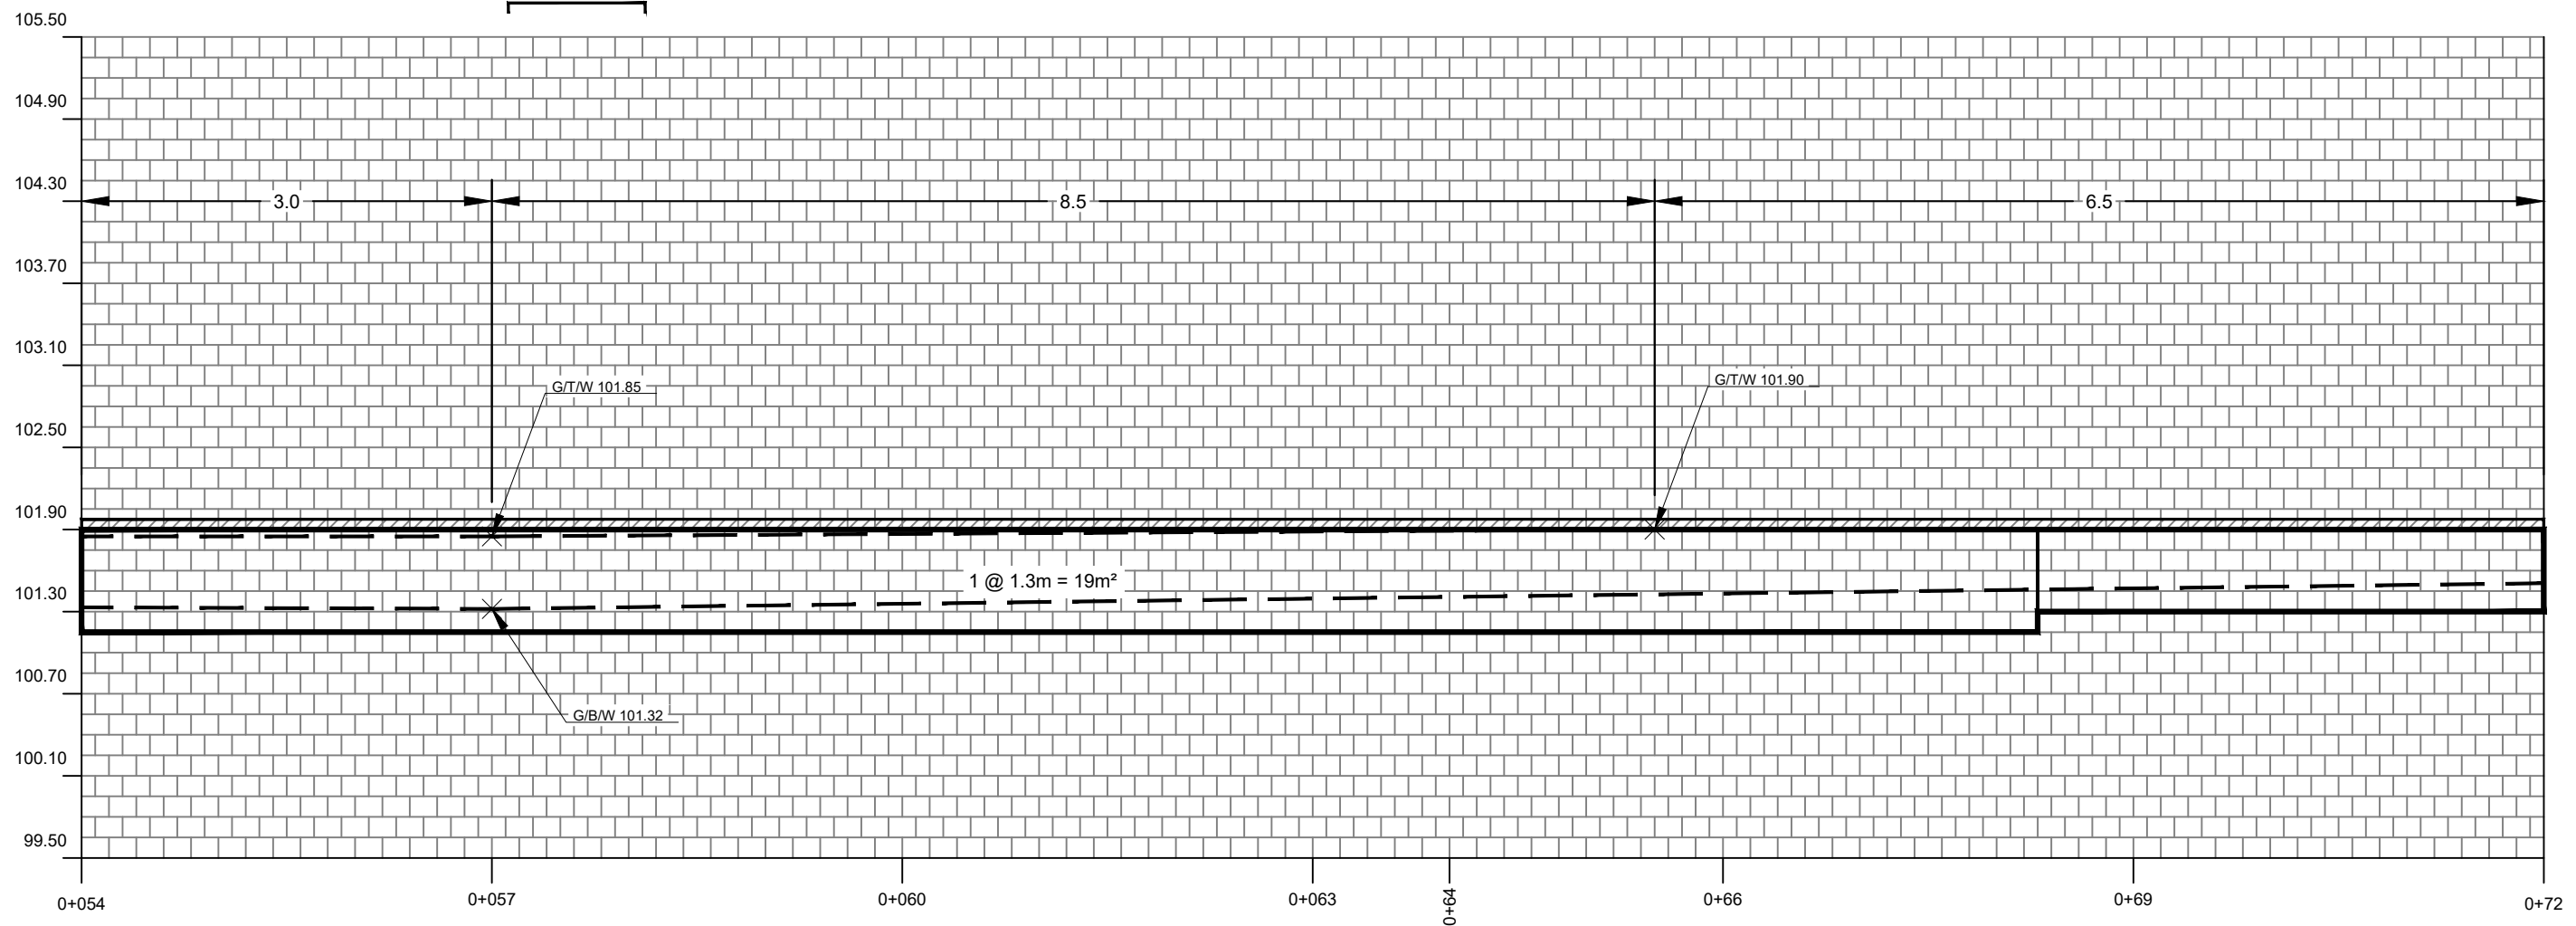

**PRELIMINARY DESIGN - NOT FOR CONSTRUCTION**

DATE: 6/3/2020

PAGE: 5 OF 7

RB Wall SYSTEM ESTIMATING SHEET					
JOB NAME	ENTERPRISE HOLDINGS		FACE AREA	10.80m <sup>2</sup>	
ADDRESS	225 HUNTMAR DRIVE OTTAWA, ONTARIO		LENGTH	18.0m	
PROJECT No:	ON16420		MAX. HEIGHT	0.6m	
SCALE = 1:50 (11x17 SHEET)	SOIL PROPERTIES:	UNIT WEIGHT	21kN/m <sup>3</sup>	BATTER	9.6°
		ANGLE OF I.F	34°	SURCHARGE	2.4kPa
				TOE SLOPE	FLAT

NUMBER OF PIECES	
RB Wall	
RB Wall 10" COPING =	0 UNITS
RB Wall 24" COPING =	30 UNITS
RB Wall TAPERED COPING =	--
RB Wall =	360 UNITS
RB Wall Double Sided =	--
RB Wall TAPERED UNIT =	--
2XT = X+X=m <sup>2</sup>	3XT = X+X=m <sup>2</sup>



DESIGN PROFILE  EXCAVATION GRADES  HANDRAIL  FENCE  TYPE -- HEIGHT --


RB WALL 24" COPING = 29.5 UNITS



WALL #

RB WALL STANDARD = 360.0 UNITS

WALL AREA = 10.80m<sup>2</sup>

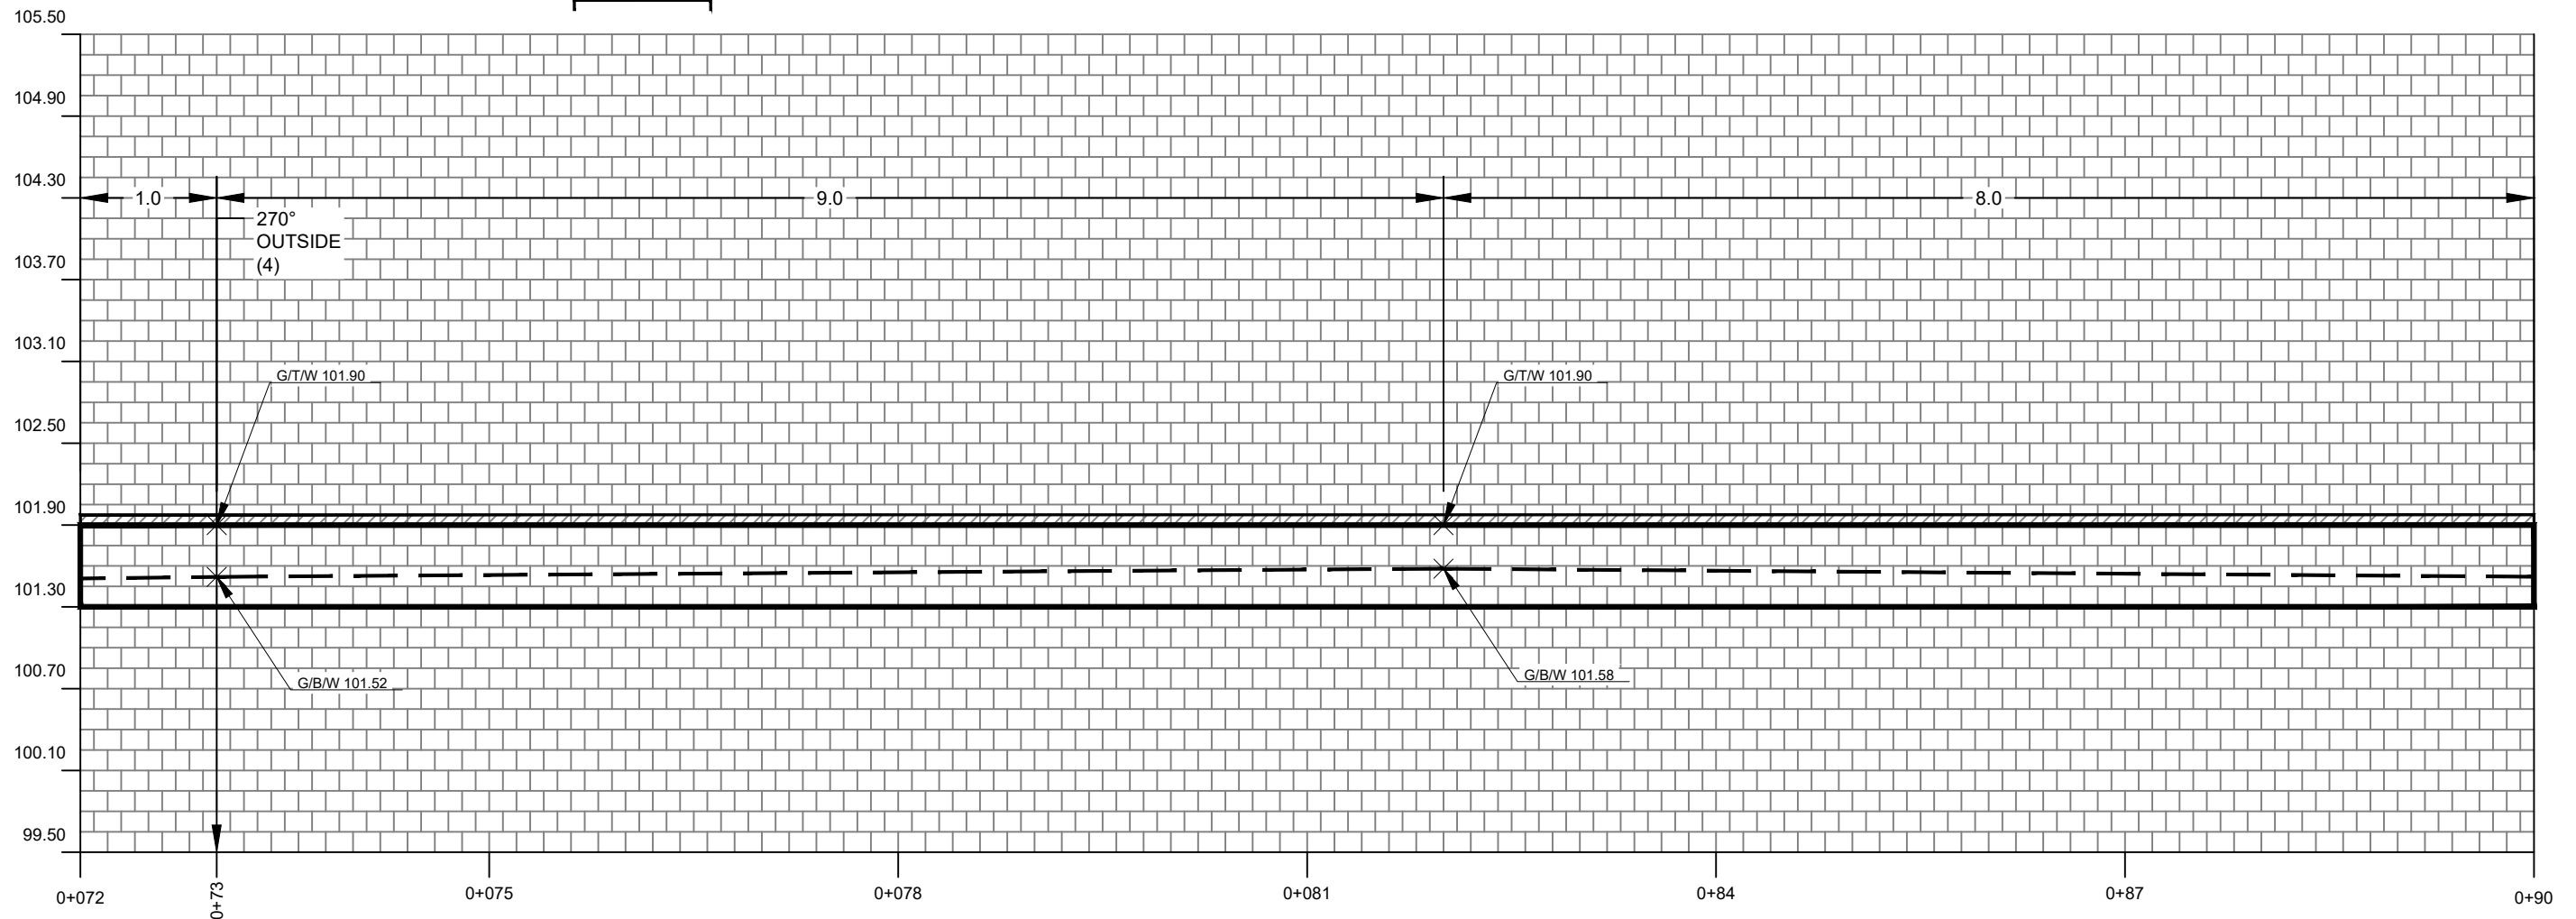

**PRELIMINARY DESIGN - NOT FOR CONSTRUCTION**

DATE: 8/10/2016

PAGE: 6 OF 7

RB Wall SYSTEM ESTIMATING SHEET			
JOB NAME	-----	FACE AREA	0.00m <sup>2</sup>
ADDRESS	-----	LENGTH	18.0m
	-----	MAX. HEIGHT	0.75m
PROJECT No:	ON -----	BATTER	9.6°
		SURCHARGE	2.4kPa
		TOE SLOPE	FLAT
SCALE = 1:50 (11x17 SHEET)	SOIL PROPERTIES:	UNIT WEIGHT	-- kN/m <sup>3</sup>
		ANGLE OF I.F	-- °

NUMBER OF PIECES	
RB Wall	
RB Wall 10" COPING =	22 UNITS
RB Wall 24" COPING =	9 UNITS
RB Wall TAPERED COPING =	--
RB Wall =	0 UNITS
RB Wall Double Sided =	--
RB Wall TAPERED UNIT =	--
2XT = X+X=m <sup>2</sup>	3XT = X+X=12m <sup>2</sup>



DESIGN PROFILE  EXCAVATION GRADES  HANDRAIL  FENCE  TYPE BEHIND/BELOW HEIGHT --


RB WALL 24" COPING = 29.5 UNITS



WALL #

RB WALL STANDARD = 405.5 UNITS

WALL AREA = 12.17m<sup>2</sup>

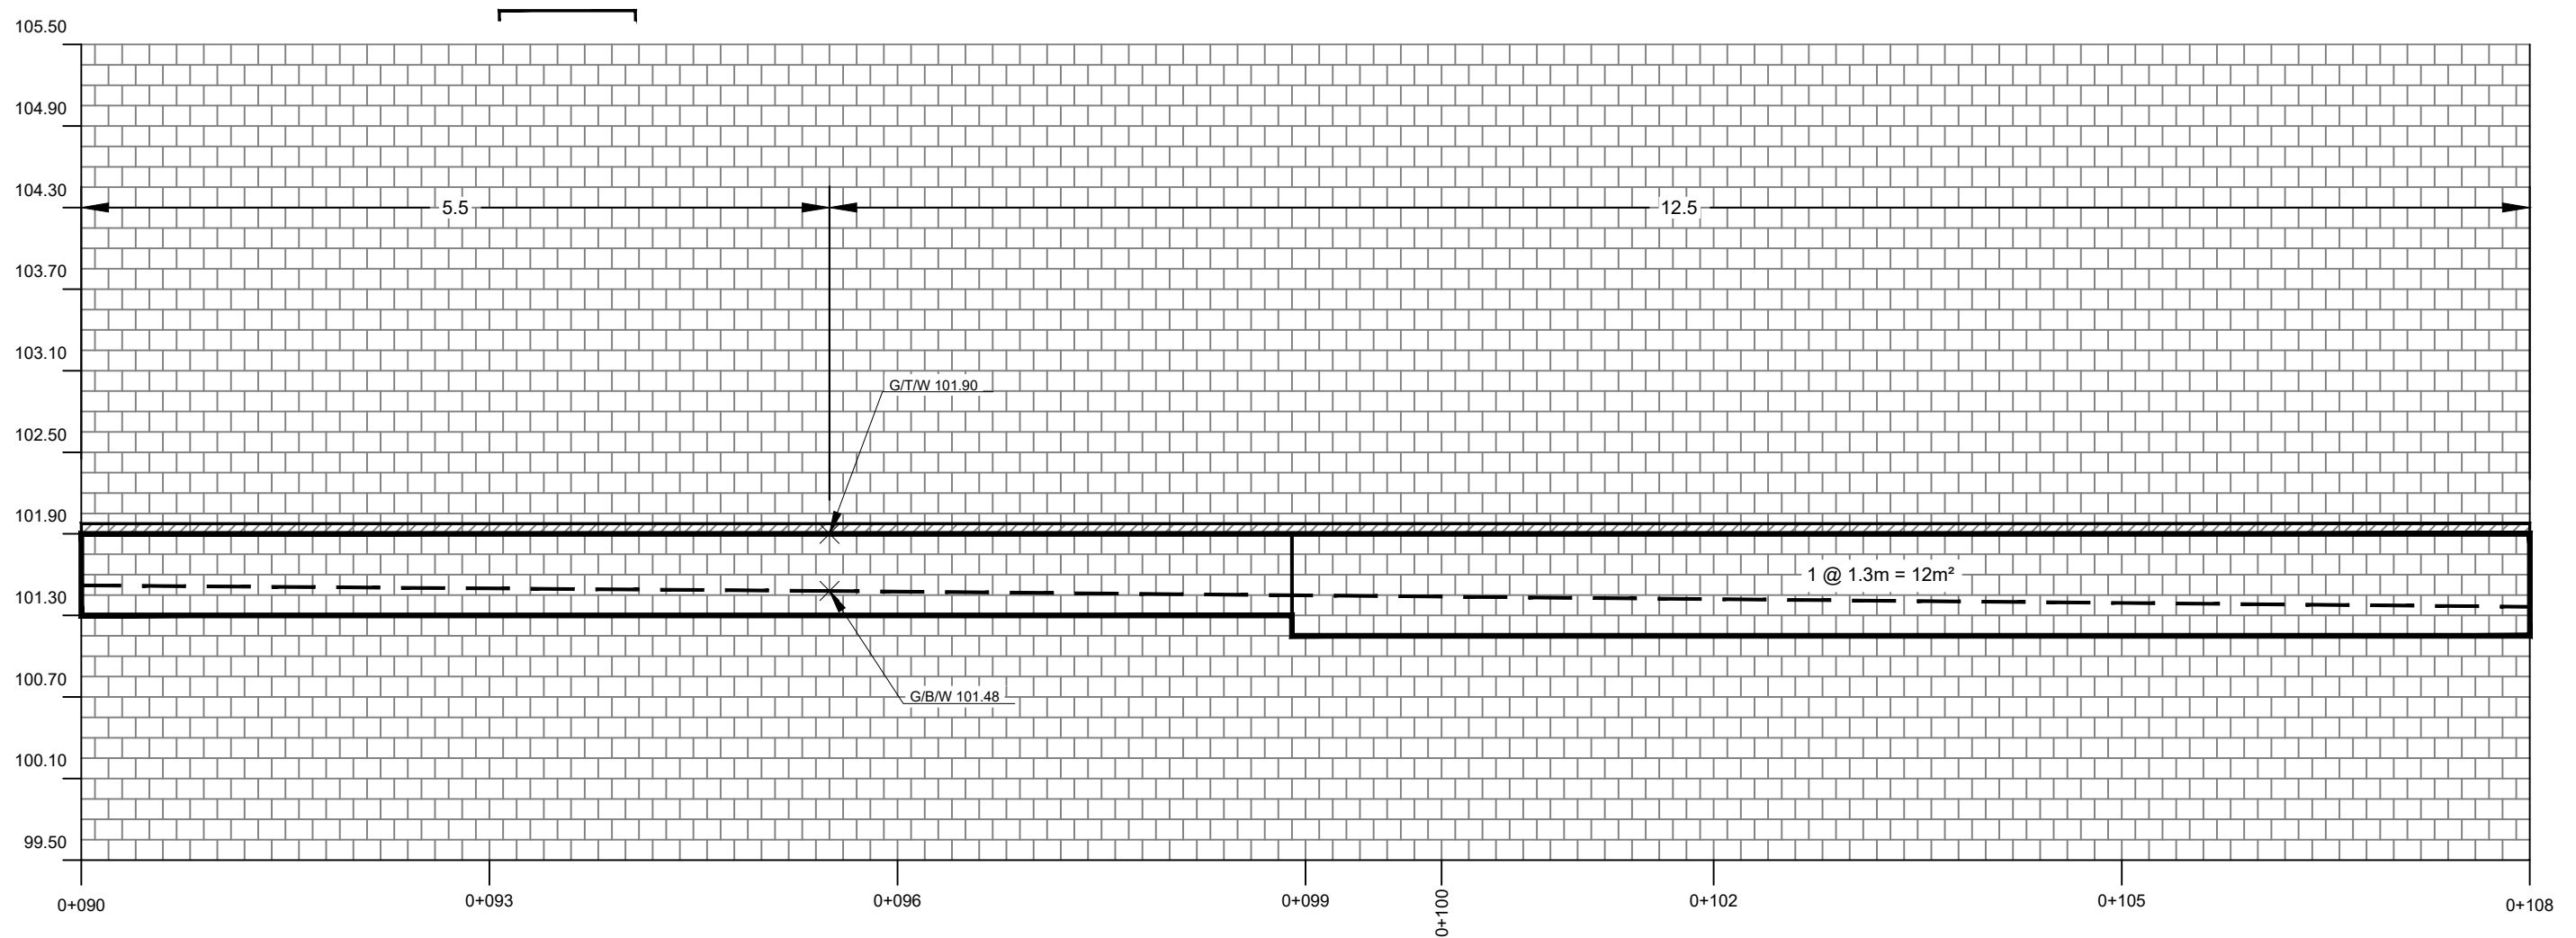

**PRELIMINARY DESIGN - NOT FOR CONSTRUCTION**

DATE: 6/3/2020

PAGE: 7 OF 7

RB Wall SYSTEM ESTIMATING SHEET					
JOB NAME	ENTERPRISE HOLDINGS		FACE AREA	6.75m <sup>2</sup>	
ADDRESS	225 HUNTMAR DRIVE		LENGTH	18.0m	
	OTTAWA, ONTARIO		MAX. HEIGHT	0.75m	
PROJECT No:	ON16420		BATTER	9.6°	
SCALE = 1:50 (11x17 SHEET)	SOIL PROPERTIES:	UNIT WEIGHT	21kN/m <sup>3</sup>	SURCHARGE	2.4kPa
		ANGLE OF I.F	34°	TOE SLOPE	FLAT

NUMBER OF PIECES	
RB Wall	
RB Wall 10" COPING =	RB Wall 24" COPING = 14.75
RB Wall TAPERED COPING = --	
RB Wall = 225 UNITS	RB Wall Double Sided = --
RB Wall TAPERED UNIT = --	
2XT = X+X=m <sup>2</sup>	3XT = X+X=12m <sup>2</sup>



DESIGN PROFILE  EXCAVATION GRADES  HANDRAIL  FENCE  TYPE BEHIND/BELOW HEIGHT --


RB WALL 24" COPING = 14.8 UNITS






WALL #

RB WALL STANDARD = 225.0 UNITS

WALL AREA = 6.75m<sup>2</sup>

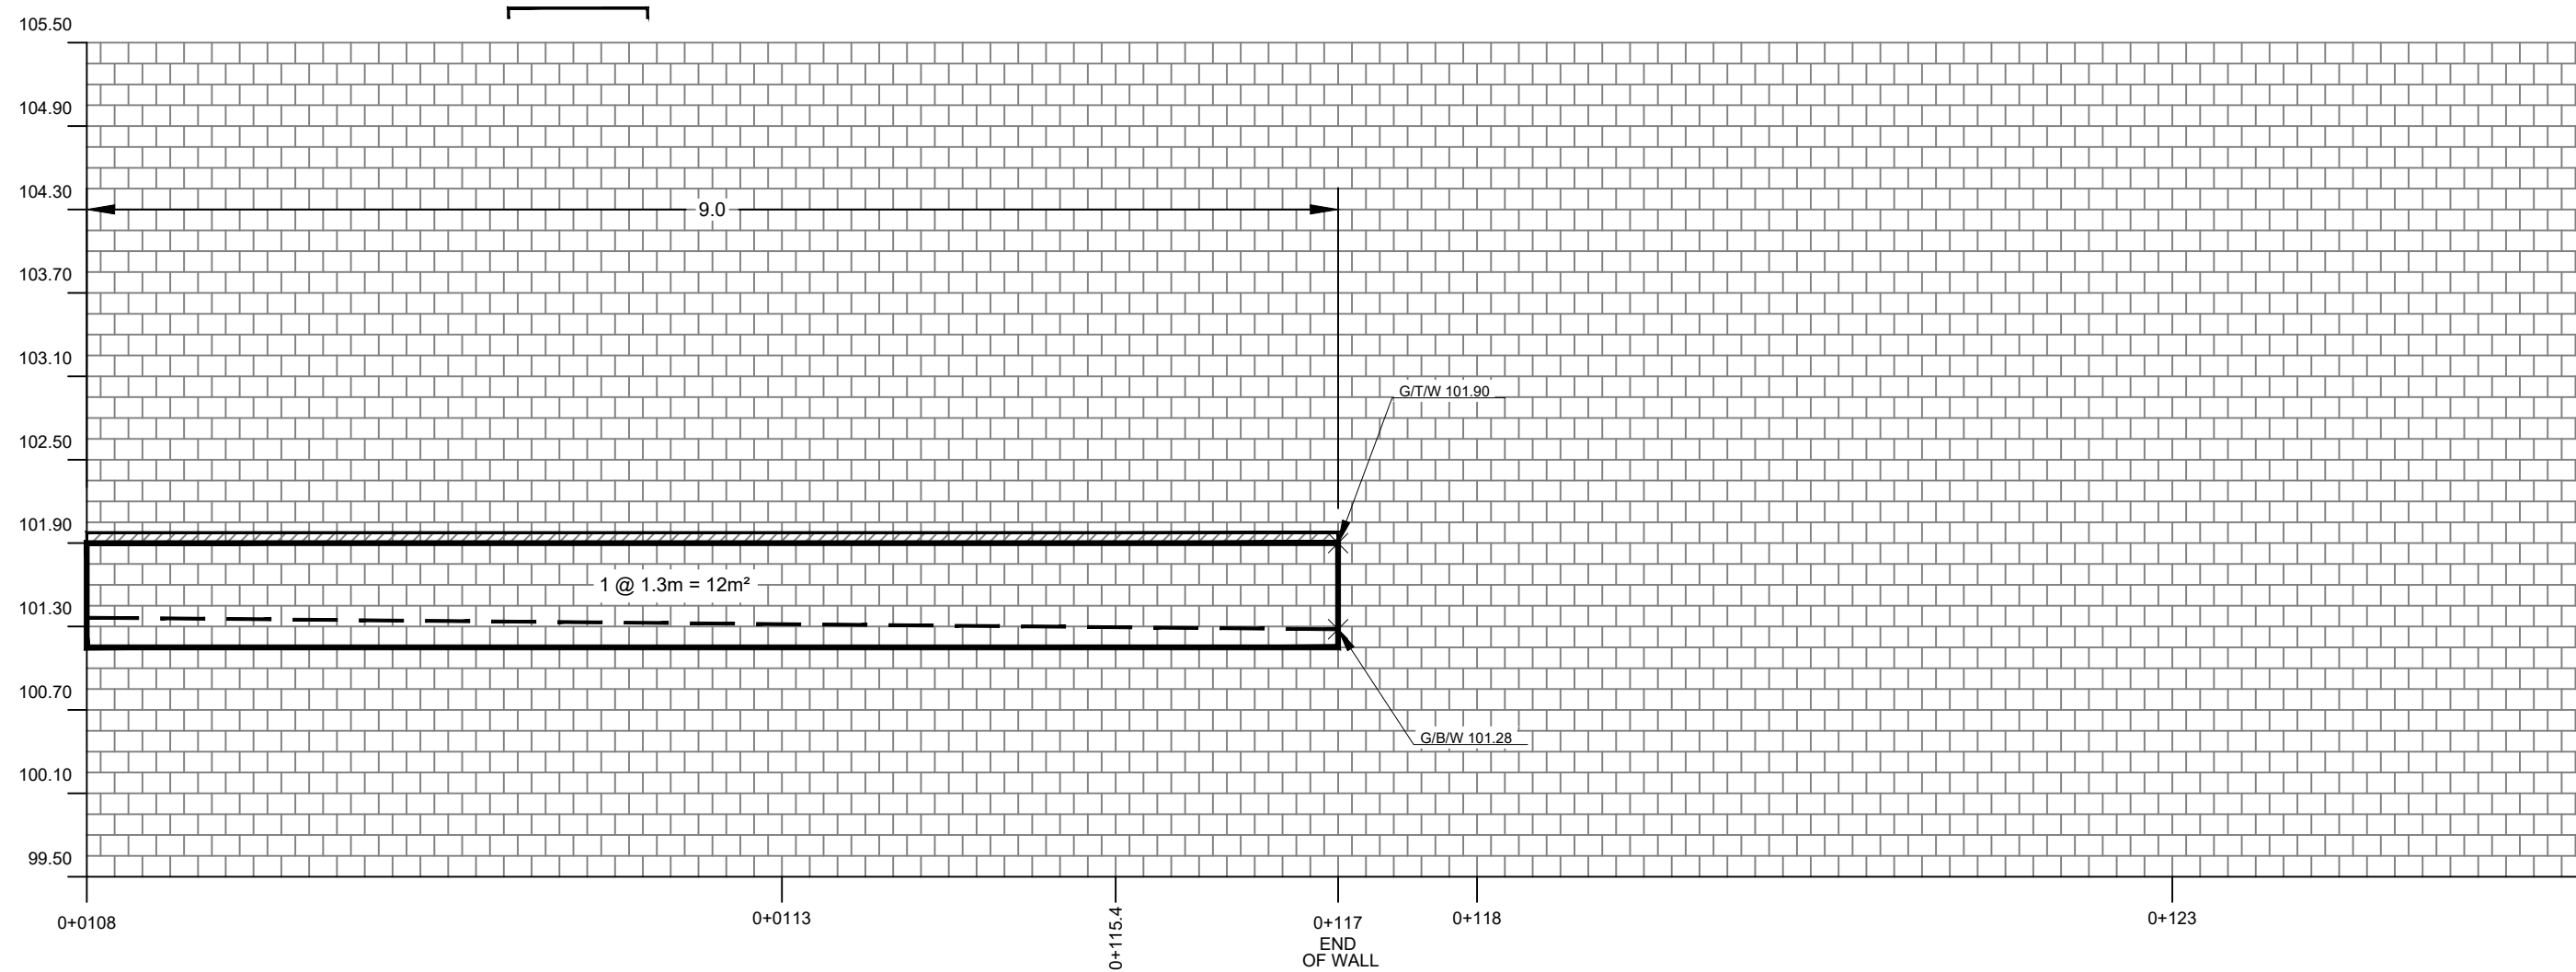

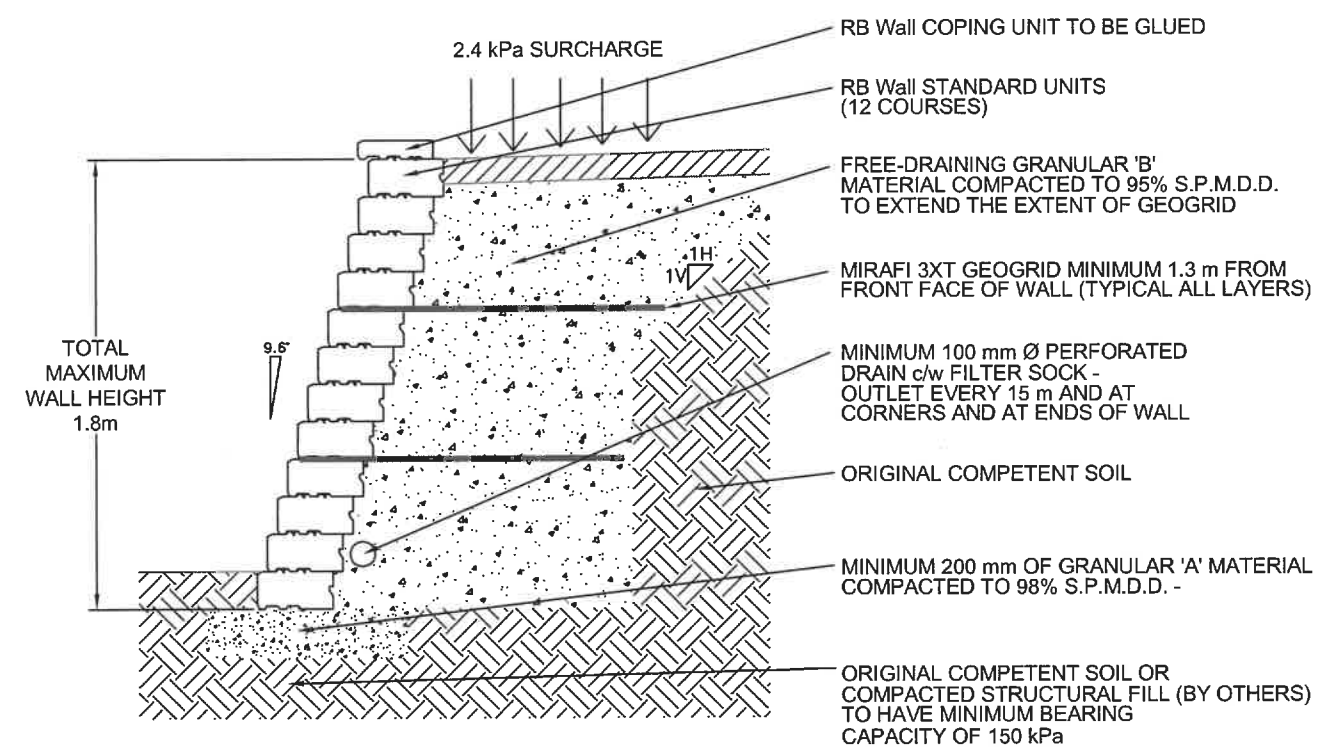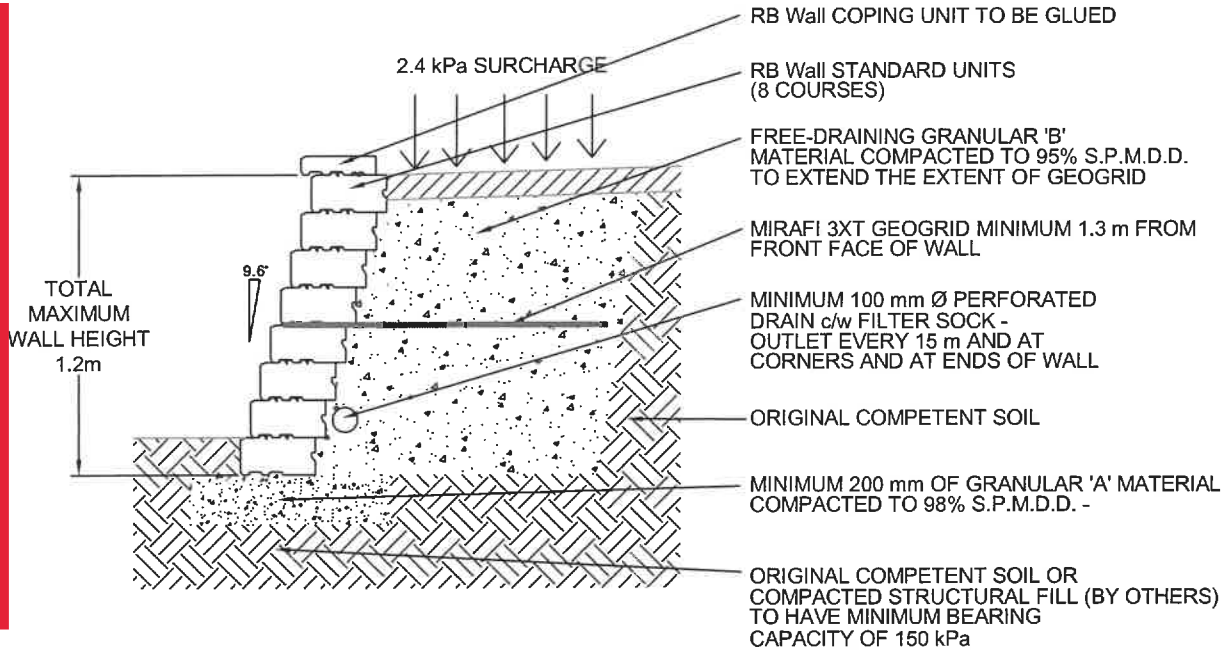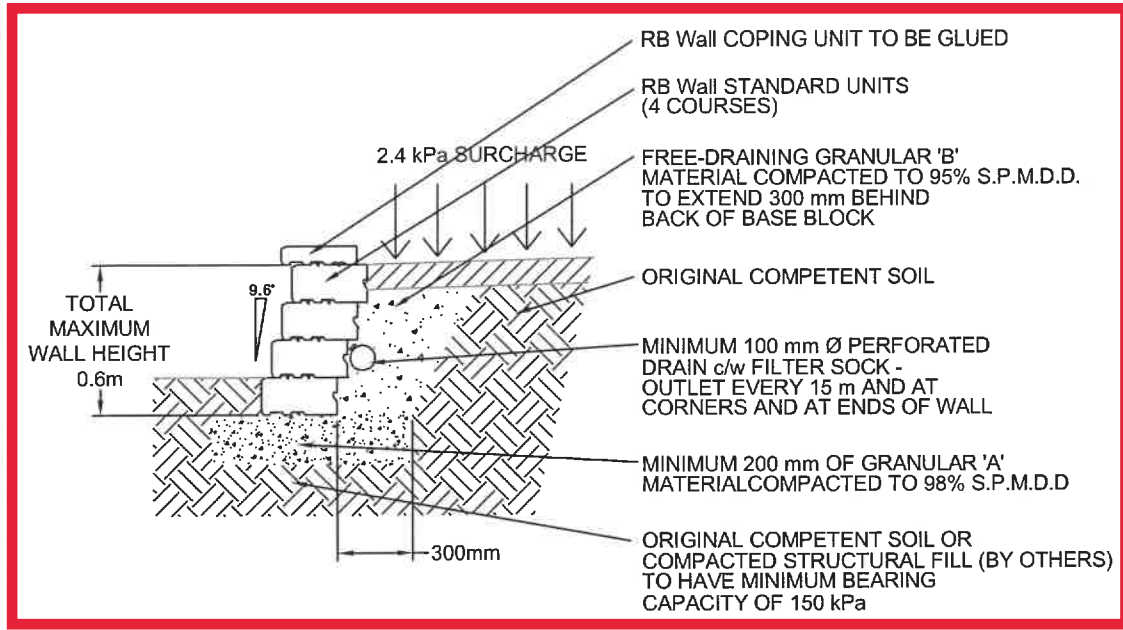

- GENERAL NOTES:**
- EXCAVATE FOR FOOTING TO MINIMUM DEPTH OF 300 mm (12 in), OR UNTIL COMPETENT SOIL IS REACHED OR FILL WITH COMPACTED STRUCTURAL FILL (BY OTHERS). THE FOUNDING SOIL MUST BE INSPECTED BY THE GEOTECHNICAL ENGINEER TO CONFIRM ADEQUATE BEARING CAPACITY AND SLOPE STABILITY. WHERE REQUIRED BY GEOTECHNICAL ENGINEER, PLACE ENGINEERED FILL COMPRISING OF APPROVED GRANULAR MATERIAL PLACED IN 250 mm (10") LIFTS AND COMPACTED TO 98% S.P.M.D.D. BACKFILLING AND COMPACTION TO BE CARRIED OUT UNDER GEOTECHNICAL SUPERVISION. PERMACON INC. IS NOT RESPONSIBLE FOR RETAINING A GEOTECHNICAL ENGINEER TO OVERSEE CONSTRUCTION OF RETAINING WALL.
  - EXCAVATION TO ALLOW FOR THE THICKNESS OF THE WALL PLUS A SUFFICIENT DISTANCE TO ALLOW FOR COMPACTED GRANULAR BACKFILL BEHIND THE WALL. EXCAVATE ON A SUITABLE BACK ANGLE DEEP ENOUGH TO REACH ORIGINAL COMPETENT SOIL.
  - PLACE 200 mm OF GRANULAR 'A' MATERIAL WITHIN FOOTING EXCAVATION AND COMPACT TO 98% STANDARD PROCTOR MAXIMUM DRY DENSITY.
  - LEVEL THE FIRST COURSE AND PLACE TOP FLUSH WITH THE DESIRED FINISHED GRADE IN FRONT OF THE WALL. SLOPE AT TOE OF WALL MAY REQUIRE INCREASE EMBEDMENT DEPTH (CONSULT A QUALIFIED PROFESSIONAL ENGINEER FOR GUIDANCE).
  - WALL APPEARANCE TO BE SPLIT FACE AND COLOR TO BE DETERMINED BY OWNER.
  - BACKFILL THE WALL WITH GRANULAR 'B' MATERIAL AS THE HEIGHT INCREASES, IDEALLY EVERY ONE OR TWO COURSES. AT NO TIME SHOULD THE HEIGHT EXCEED 2 COURSES WITHOUT BACKFILLING UNLESS OTHERWISE DIRECTED BY THE ENGINEER. BACKFILL MUST BE COMPACTED TO 95% S.P.M.D.D.
  - PLACE THE GEOGRID LAYERS AS THE BACKFILL PROCEEDS, AT THE LOCATIONS SPECIFIED. COMPACT BACKFILL AS THE GEOGRID IS PLACED.
  - THE GEOGRID SHOULD BE CUT TO EXTEND BETWEEN THE UNITS PLUS THE SPECIFIED DISTANCE BEHIND THE WALL AS SHOWN. NO SPLICES PARALLEL TO THE WALL FACE ARE ALLOWED WITHOUT THE PERMISSION FROM THE ENGINEER.
  - ORIENTATION OF THE GEOGRIDS IS OF EXTREME IMPORTANCE. THE STRONGER STRAND OF THE GEOGRID SHOULD BE PERPENDICULAR TO THE WALL FACE. ENSURE THAT THE GEOGRID EXTENDS BETWEEN THE UNITS TO THE FRONT FACE OF THE WALL.
  - AFTER BEING ROLLED OUT, THE SHOULD BE TENSIONED BY HAND UNTIL IT IS TIGHT, FREE OF WRINKLES AND LYING FLAT. THE GEOGRID SHOULD BE HELD FLAT WHILE BACKFILLING. CARE SHOULD BE TAKEN TO AVOID DAMAGING THE GEOGRID DURING BACKFILLING.
  - ADJACENT ROLL WIDTHS SHOULD BE BUTT TIGHT TOGETHER.
  - ALL CONSTRUCTION OPERATIONS INCLUDING BLOCK AND GEOGRID PLACEMENT, BACKFILLING AND COMPACTION TO BE COMPLETED UNDER GEOTECHNICAL SUPERVISION.
  - POOR SOIL CONDITIONS AND EXCESSIVE MOISTURE MAY REQUIRE ALTERNATE DRAINAGE REQUIREMENTS AND DESIGN MODIFICATIONS.
  - TO ACHIEVE A 9.6° BATTER, STEP EVERY COURSE BACK.
  - THE TOP MUST BE LANDSCAPED TO PROMOTE SURFACE RUNOFF OVER THE TOP OF THE WALL. NO UNUSUAL SURCHARGE LOADING SHOULD BE ADJACENT TO THE TOP OF THE WALL.
  - APPROPRIATE RESTRAINT MUST BE PROVIDED TO ENSURE PEDESTRIANS CANNOT ACCESS THE TOP OF THE WALL. OTHERWISE AN ENGINEERED HANDRAIL SYSTEM WILL BE REQUIRED ON THE TOP OF THE WALL. PROVISION OF A HANDRAIL ON TOP OF THE WALL MAY REQUIRE DESIGN MODIFICATIONS.
  - ALL PRODUCT NAMES AND STYLIZED REPRESENTATIONS ARE TRADEMARKS OF PERMACON, OR APPROVED FOR USE BY PERMACON COMPANIES.
  - ALL PRODUCTS ILLUSTRATED ARE SUBJECT TO PATENTS AS FOLLOWS:  
RB Wall - CANADA 1,307,675  
- USA 4,860,505
  - THE APPLICABILITY OF THESE RETAINING WALL SECTIONS MUST BE REVIEWED ON A SITE SPECIFIC BASIS BY A QUALIFIED PROFESSIONAL ENGINEER.
  - FOR OTHER WALL HEIGHTS, SOIL PARAMETERS AND SURCHARGE LOADING NOT REPRESENTED ON THIS DRAWING, PLEASE CONTACT PERMACON FOR SITE SPECIFIC DESIGN.
- SOIL PARAMETERS USED IN DESIGNS:  
REINFORCED SOIL:  $\phi = 34$  DEGREES,  $\gamma = 21$  kN/m<sup>3</sup>  
RETAINED SOIL:  $\phi = 28$  DEGREES,  $\gamma = 19$  kN/m<sup>3</sup>



REV.	DATE	DESCRIPTION	BY
2	11/15/19	ISSUED FOR USE	DAD
1	JUN 8/18	REVISED BRAND	DPS
0	JAN 01/08	ISSUED FOR USE	PAS

**DRAWING:** GEOGRID REINFORCED DESIGN  
9.6 DEGREE BATTER  
TO 1.8 m  
2.4 kPa SURCHARGE  
(RESIDENTIAL PEDESTRIAN LOADING)

**PROJECT:** RB Wall  
STANDARD ENGINEERING



**DESIGN ENGINEER:**  
PML Peto MacCallum Ltd.  
CONSULTING ENGINEERS

**DRAWN BY:** DS  
**CH'D BY:** gh

**DATE:** JANUARY 1, 2008

**SCALE:** NOT TO SCALE

**FILE NAME:** RB-SE-RI-2.4 kPa SURCHARGE.dwg

**DRAWING No.:** RB-SE-RI-2.4 kPa SURCHARGE