



**CARLETON PLACE ARENA  
ADDITION AND RENOVATIONS  
75 Neelin Street Carleton Place, Ontario**

TAL-CO Building Innovations Limited  
4728 Bank Street, Suite A  
Gloucester, Ontario K1T 3W7  
Tel: 613-821-3959  
Fax: 613-821-2938



Issue date: 4-Sep-20  
Revision date: N/A  
Revision #: N/A



---

**CIR #8 Detailed Summary**

**Questions:**

1. Elevation depth clarifications are required for Footing Pad **6a-F1/F2** on GL-2. According to the drawing details and cross sections, it appears that Footing Pad **6a-F1/F2** remains at the same typical 5'-0" frost-wall elevation as the rest of the new foundation wall systems. However, the actual detail indicates that this new footing pad is to be constructed on "*undisturbed soils or solid bedrock*" and not Engineered Backfill. Additionally, this new footing pad is extremely close to the existing building and detail **6-F1/F2** appears to indicate a tie-in at the existing footing depth.
  - a. Does the foundation wall system step down along GL-2 from GL-A towards the existing building so that Footing Pad **6a-F1/F2** is at the same depth elevation as the existing footings or does this wall system including this new footing pad stay at the typical 5'-0" frost wall depth and the foundation wall system past this new footing pad get tied into the existing foundations as per detail **6-F1/F2** at the existing footing depth?
  - b. Note, there does not appear to be any step footings indicated for the foundations on GL-2, but there are for GL-4. Is the arrow on Drawing F1 pointing to the incorrect GL? If not, please clarify the requirement of step footings along GL-4 as these foundations do not tie-in to the existing foundations. As well, provide details of exactly where the foundations step down and then step back up again to meet with the typical 5'-0" frost wall foundations along GL-B (Detail 7-F1/F2).
2. Does the "L-shape" component at the bottom of Detail 6-F1/F2 represent the strip footing of the existing building foundations?

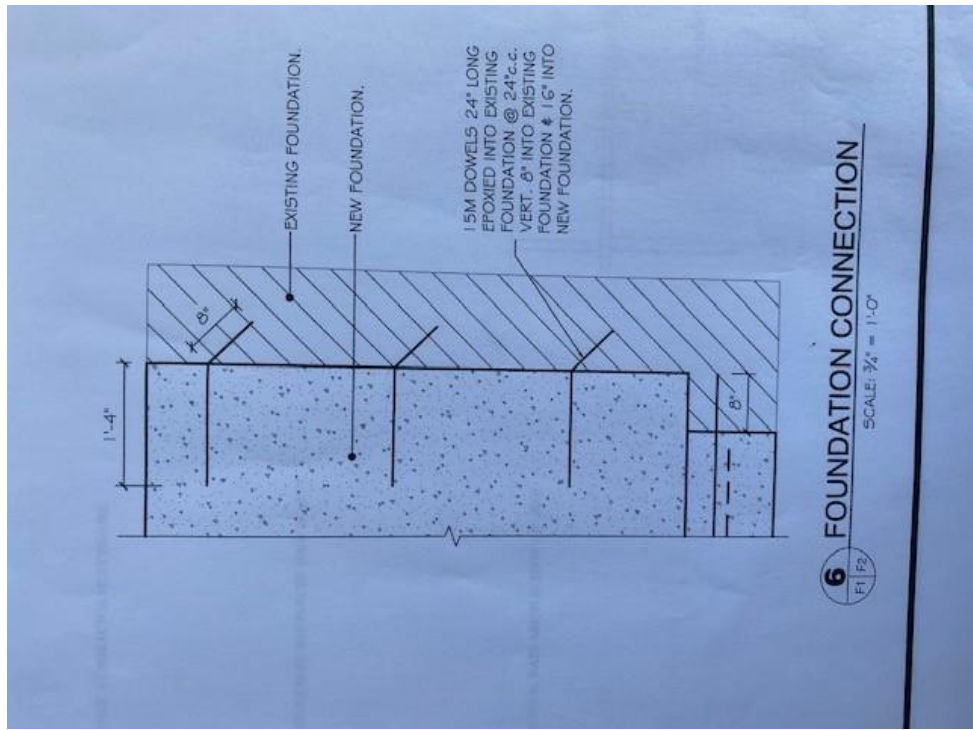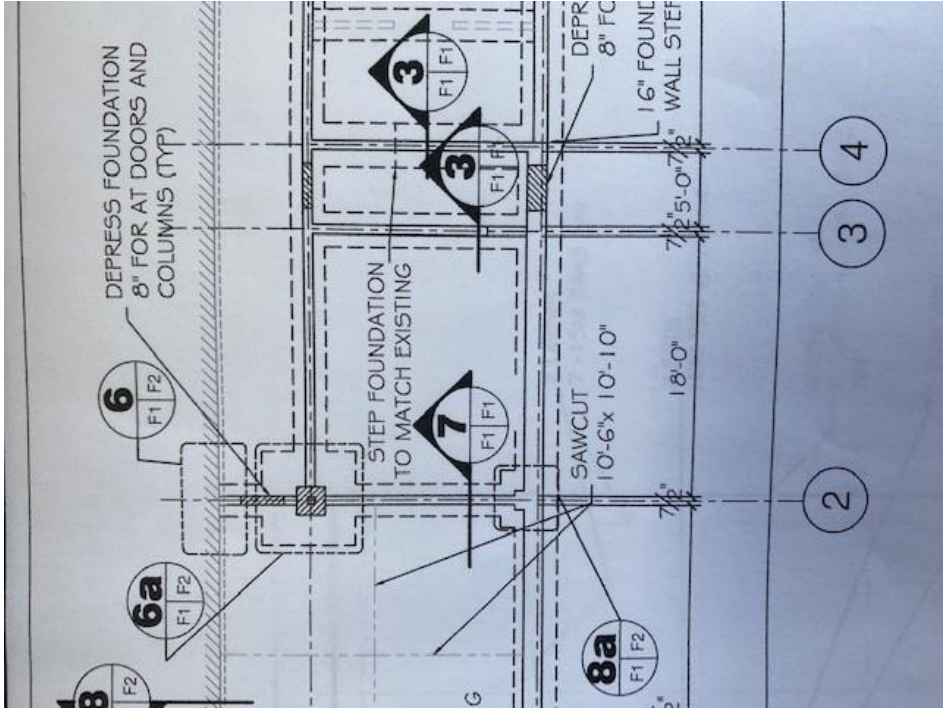

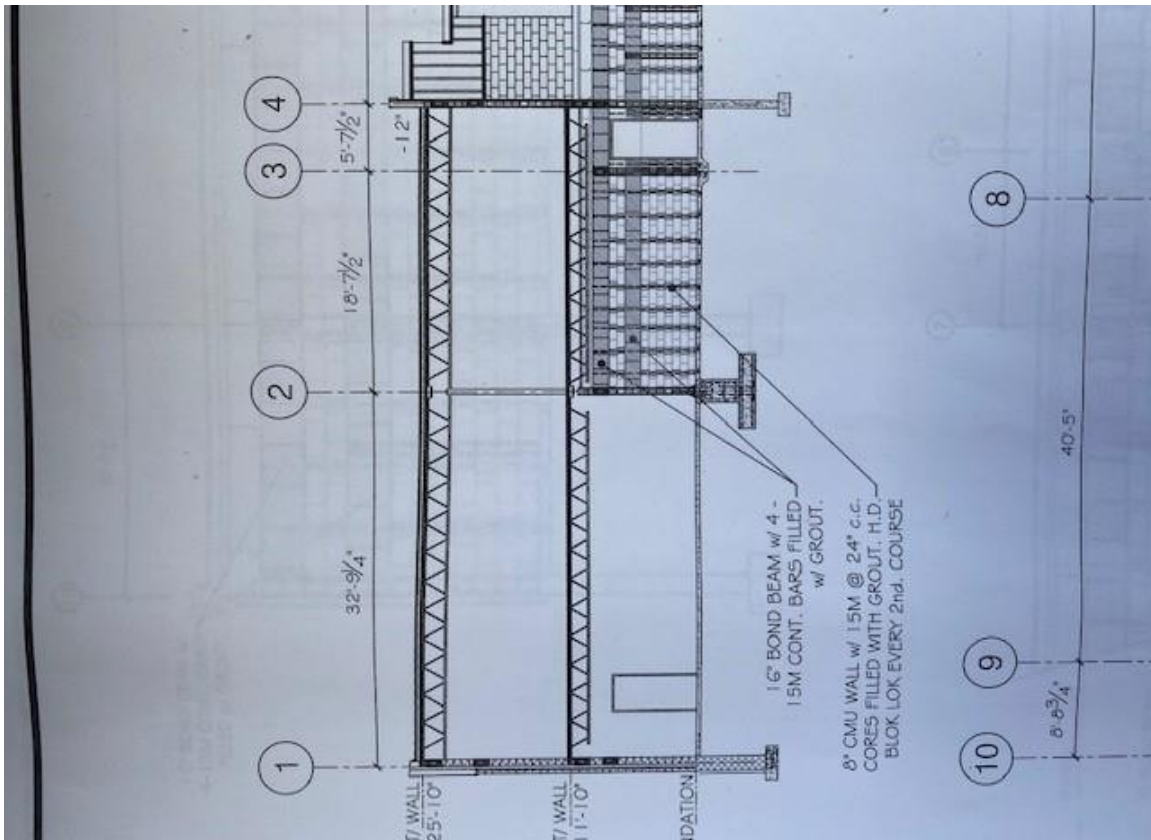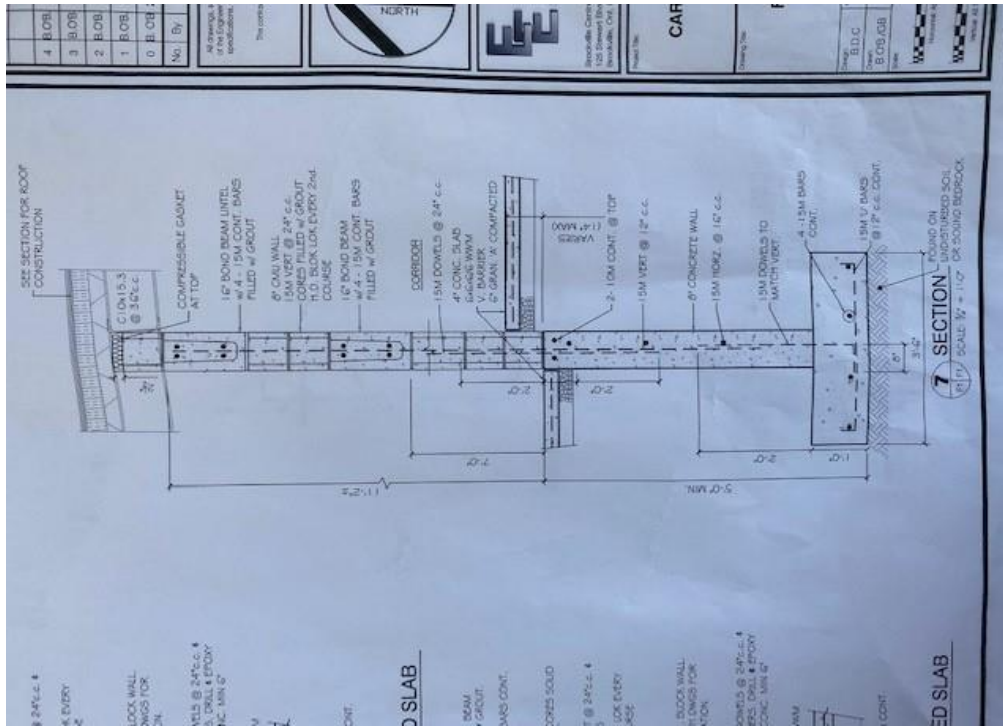

End of CIR No. 8

# LARRY GAINES • ARCHITECT

Old Town Hall  
14 Bridge Street, PO 706  
Almonte, Ontario  
K0A 1A0

T: 613-256-3630  
gaines@bellnet.ca

## CIR Response

CIR #08

**To:**

TALCO BUILDING INNOVATIONS LTD.  
4728 Bank Street, Suite A  
Ottawa, Ontario

**Project:**

Carleton Place Arena  
Renovation and Addition

**Date:**

September 09, 2020

---

CIR Responses are issued only for the purpose of recording any clarification or interpretation of the contract documents or giving direction on problems resulting from field conditions. These instructions are subject to the provisions of the contract documents and unless stated herein and specifically co-authorized by the Client, will not affect the contract

---

**REFERENCES:**

CIR #07 submitted Sept. 04, 2020

**PER:**

Larry Gaines

Architect

1. Elevation depth clarifications are required for Footing Pad **6a-F1/F2** on GL-2. According to the drawing details and cross sections, it appears that Footing Pad **6a-F1/F2** remains at the same typical 5'-0" frost-wall elevation as the rest of the new foundation wall systems. However, the actual detail indicates that this new footing pad is to be constructed on "*undisturbed soils or solid bedrock*" and not Engineered Backfill. Additionally, this new footing pad is extremely close to the existing building and detail **6-F1/F2** appears to indicate a tie-in at the existing footing depth.

The detail requires 5'-0" minimum, it can be deeper than this to suit the existing foundations. 5'-0" is the minimum frost depth but can go lower.

a. Does the foundation wall system step down along GL-2 from GL-A towards the existing building so that Footing Pad **6a-F1/F2** is at the same depth elevation as the existing footings or does this wall system including this new footing pad stay at the typical 5'-0" frost wall depth and the foundation wall system past this new footing pad get tied into the existing foundations as per detail **6-F1/F2** at the existing footing depth?


Foundation steps are arbitrarily shown near the existing foundation to indicate to the concrete that the footing must be stepped to match the existing footing elevation. The footing must be found on undisturbed native soil which will only be encountered at the existing footing elevation. The contractor can shift the location of the steps to accommodate how they would like to execute the pour, however the maximum 24"x24" step must be maintained. We expect that Pier 6a will need to be lower.

b. Note, there does not appear to be any step footings indicated for the foundations on GL-2, but there are for GL-4. Is the arrow on Drawing F1 pointing to the incorrect GL? If not, please clarify the requirement of step footings along GL-4 as these foundations do not tie-in to the existing foundations. As well, provide details of exactly where the foundations step down and then step back up again to meet with the typical 5'-0" frost wall foundations along GL-B (Detail 7-F1/F2).


All foundations that must be over excavated to encounter native soil or tie into the existing foundation will need to be steeped. It is likely that the original foundation excavation included portions of the building receiving new foundation wall. Undisturbed soil will likely be at the existing footing elevation.

2. Does the "L-shape" component at the bottom of Detail 6-F1/F2 represent the strip footing of the existing building foundations?

Yes. The "bump out" at the bottom would represent the existing foundation strip footing.

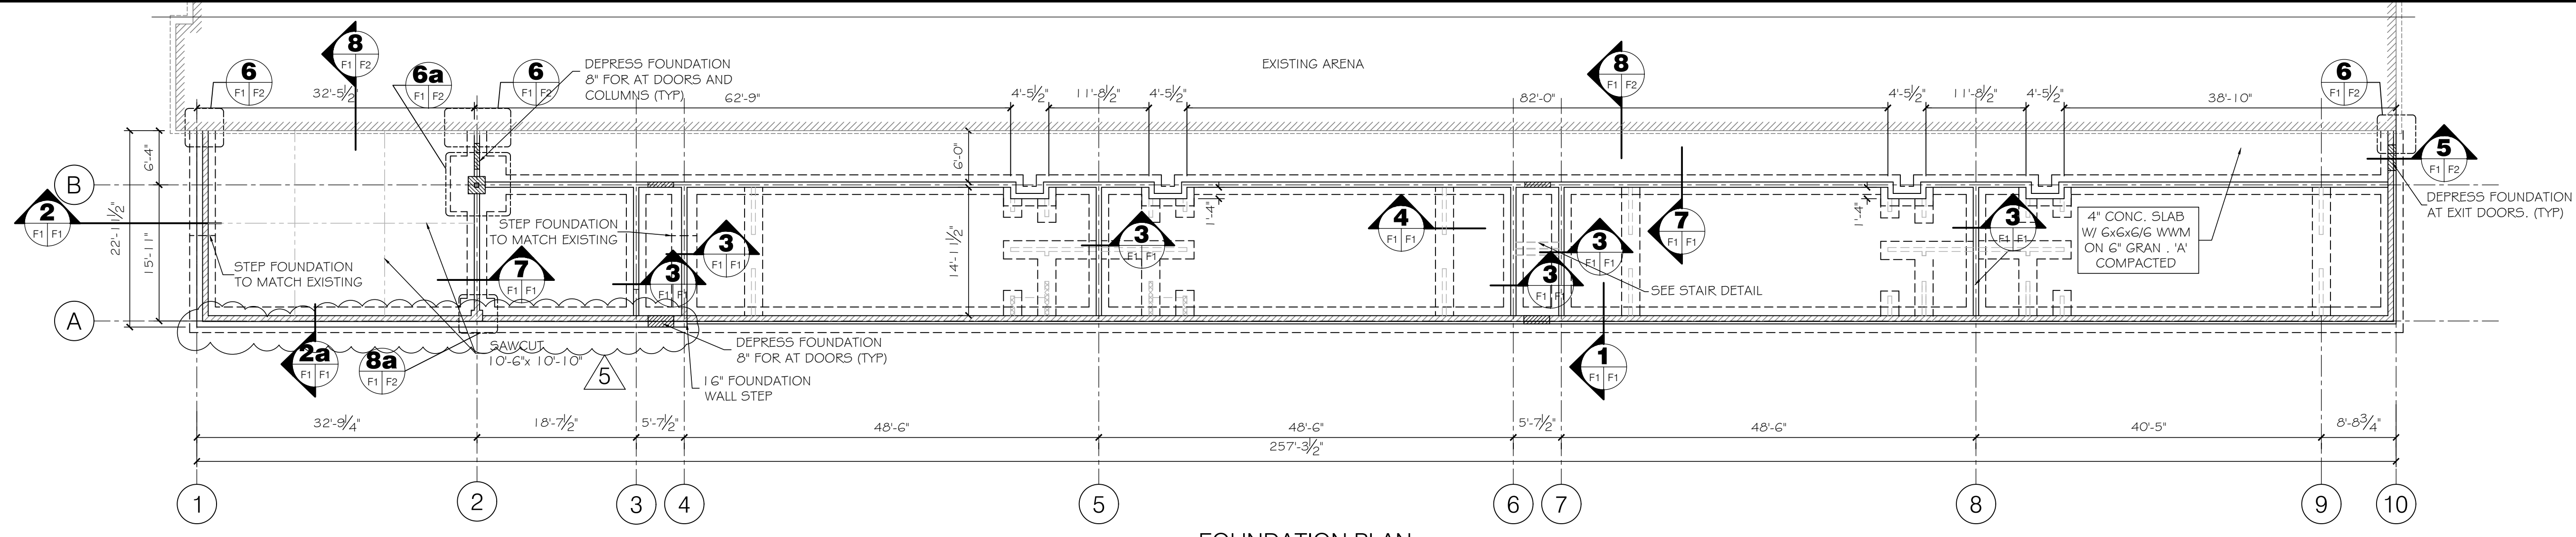


**FOUNDATION PLAN**  
 SCALE: 3/8" = 1'-0"

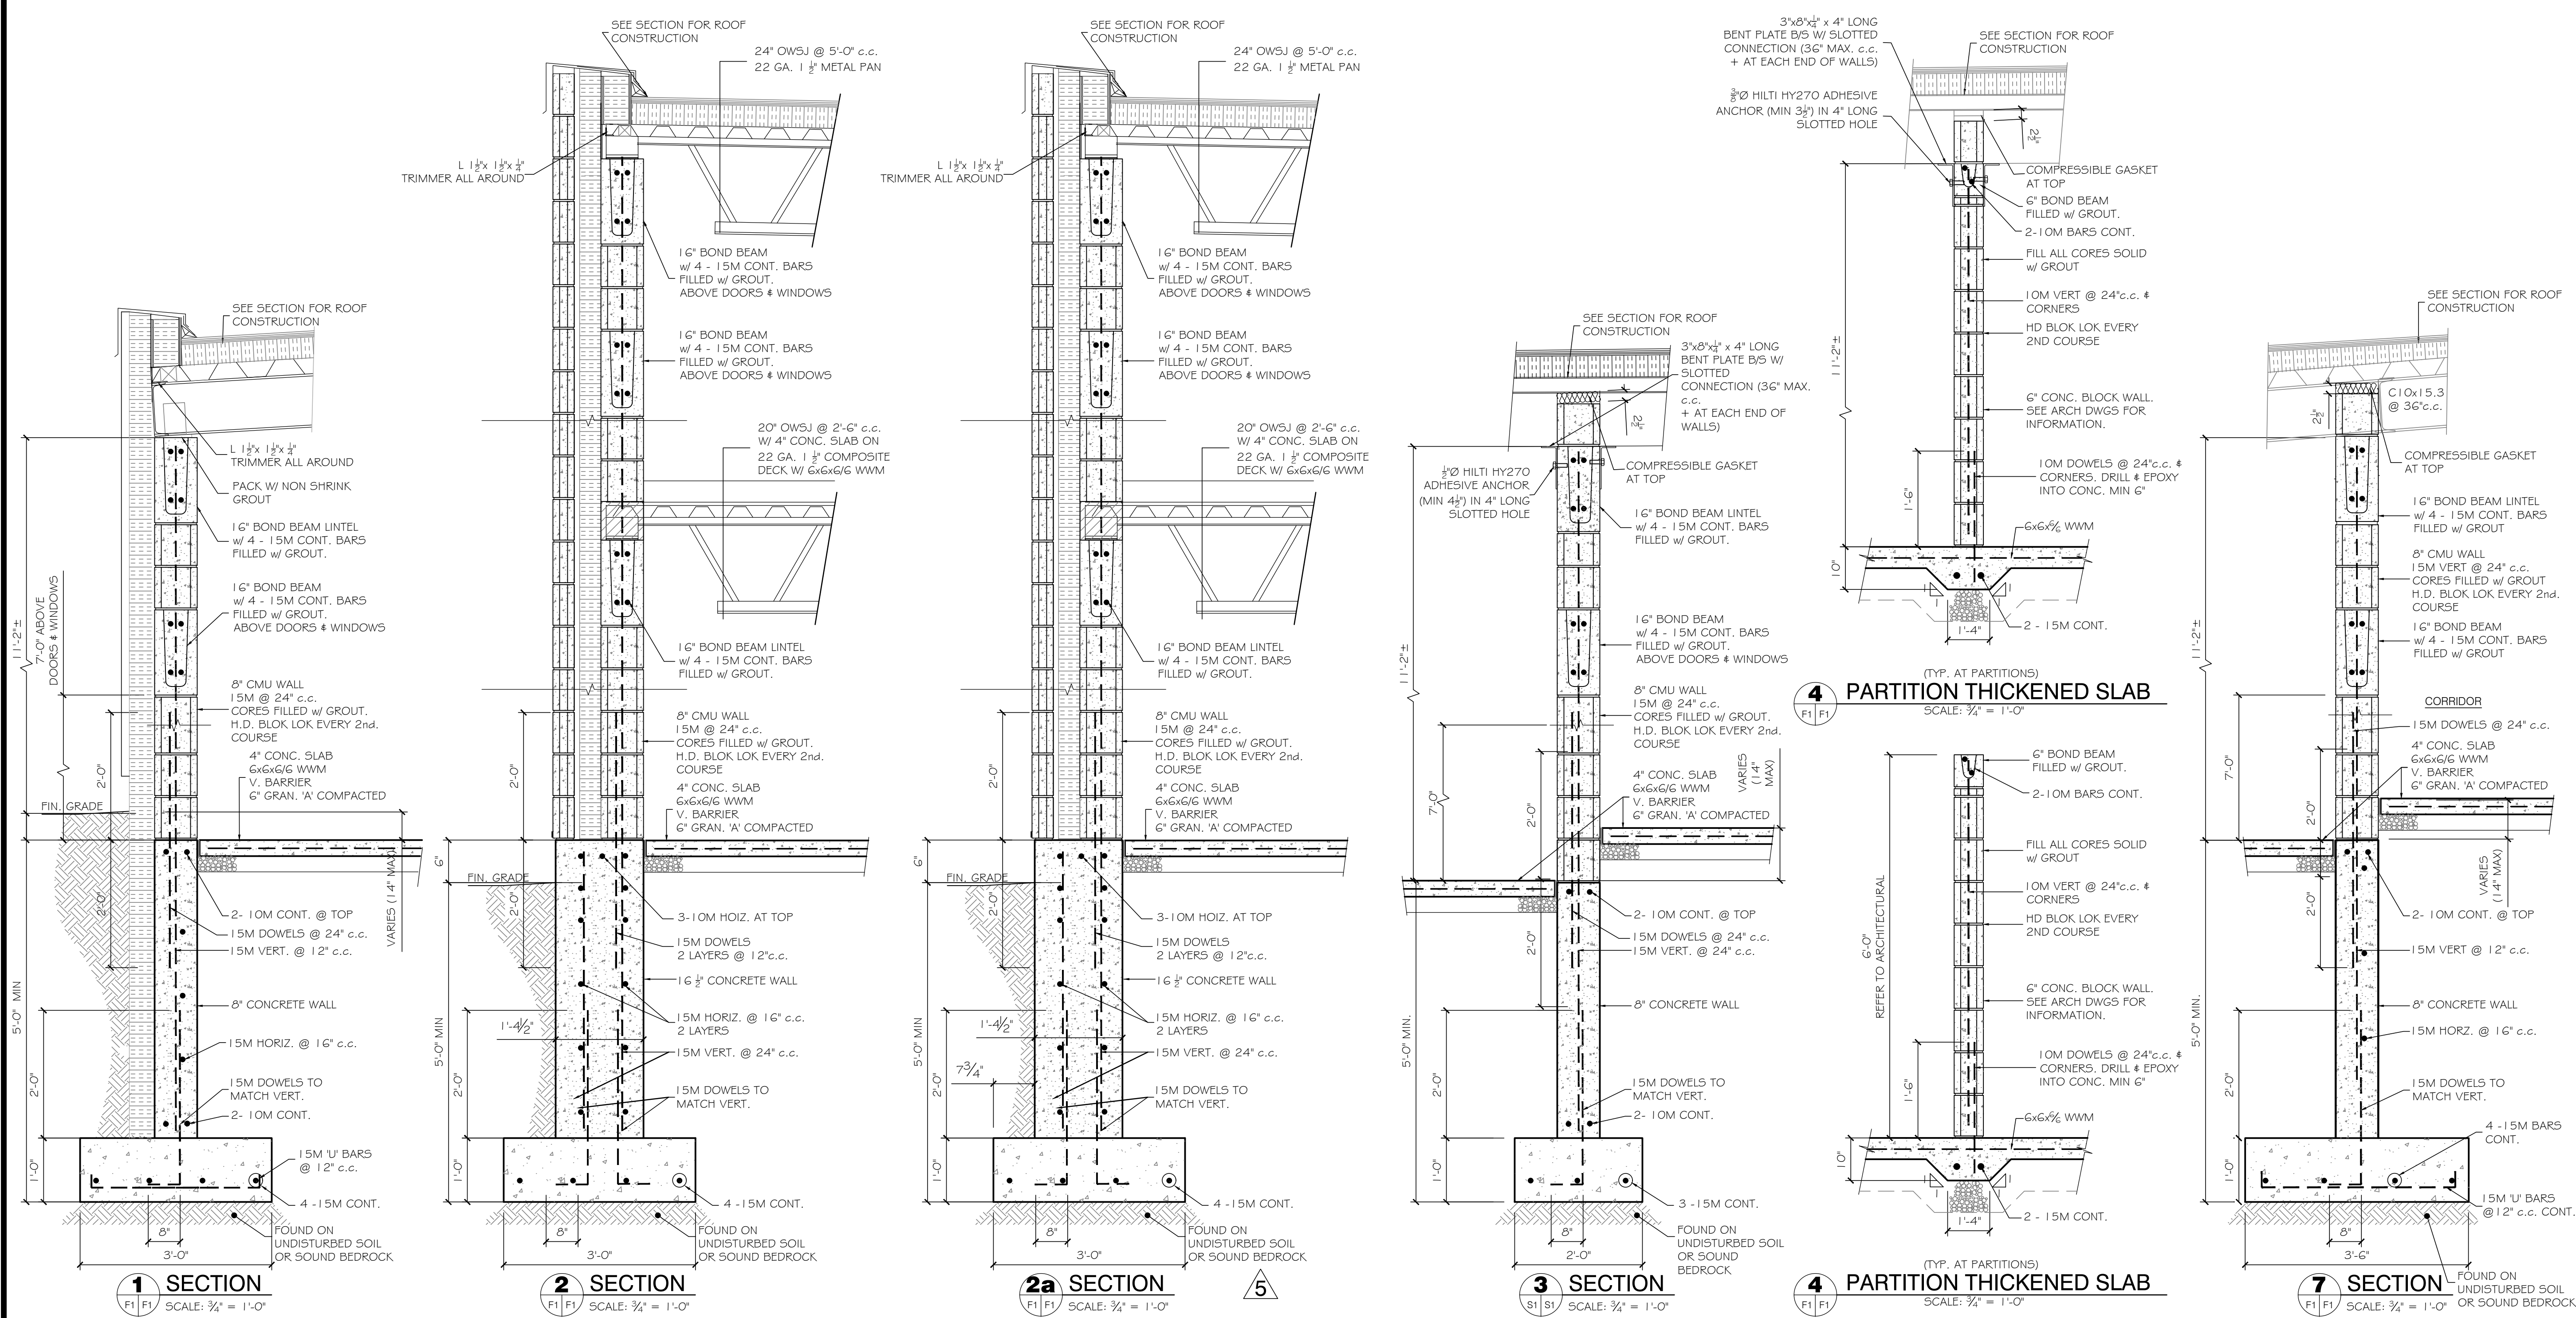

No.	By	Date	Revisions
5	B.O.B	2020 09 09	FOR CONSTRUCTION
4	B.O.B	2020 04 28	CONSULTANT CO-ORDINATION
3	B.O.B	2020 03 25	FOR TENDER/PERMIT
2	B.O.B	2020 03 10	REVISED JOIST DIRECTION
1	B.O.B	2020 02 27	66% FOR PRICING
0	B.O.B	2016-12-09	FOR REVIEW

All drawings, specifications and related documents are the copyright property of the Engineer and must be returned upon request. Reproduction of drawings, specifications, and related documents in part or whole is forbidden without the Engineer's written permission.  
 The contractor must check and verify all dimensions on the job prior to start of construction.  
 DRAWINGS ARE NOT TO BE SCALED

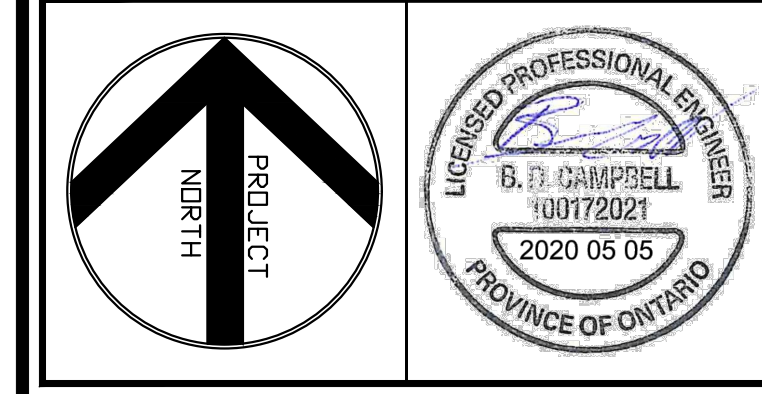

**EASTERN ENGINEERING GROUP INC.**  
 CONSULTING ENGINEERS  
 Brockville Centre  
 125 Stewart Blvd. Suite 212  
 Brockville, Ont. K6V 4W4  
 Telephone: (613) 345-0400  
 Facsimile: (613) 345-0008  
 www.EastEng.com

Project Title:  
**CARLETON PLACE ARENA**  
 75 Neelin Street,  
 Carleton Place, Ontario

Drawing Title:  
**FOUNDATION PLAN & DETAILS**

Design: B.D.C.	Checked: L.A.F.	Approved: L.A.F.	Project No.: 7558
Drawn: B.O.B./GB	Checked:	Date: 2016-12-09	Contract No.:

Scale: Horizontal: AS SHOWN  
 Vertical: AS SHOWN

REV DATE: 09/2020

**F1**